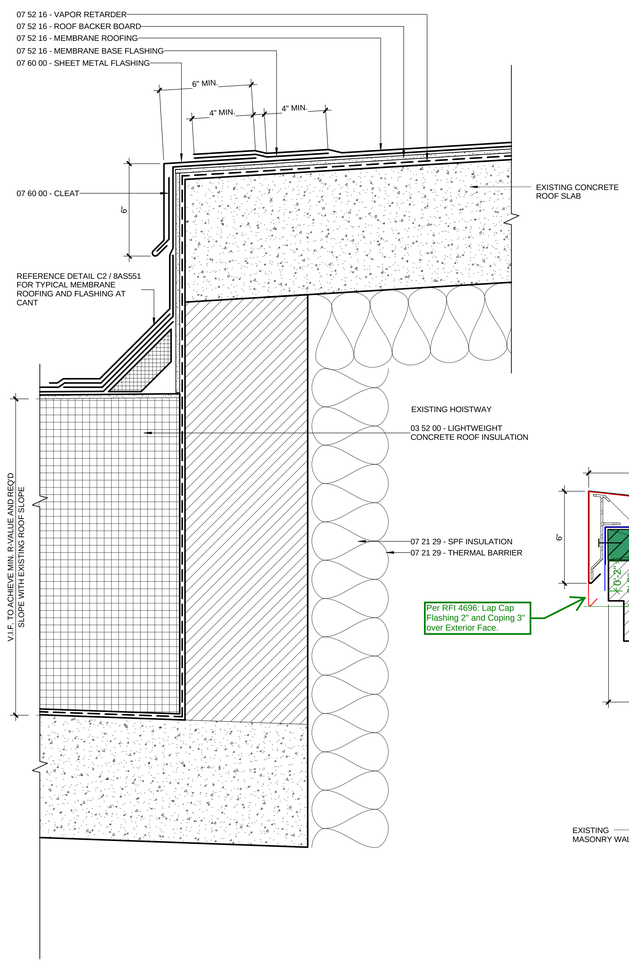

E6 SECTION THRU MASONRY WALL AT HOISTWAY ROOF LOOKING SOUTH

SCALE: 3" = 1'-0"

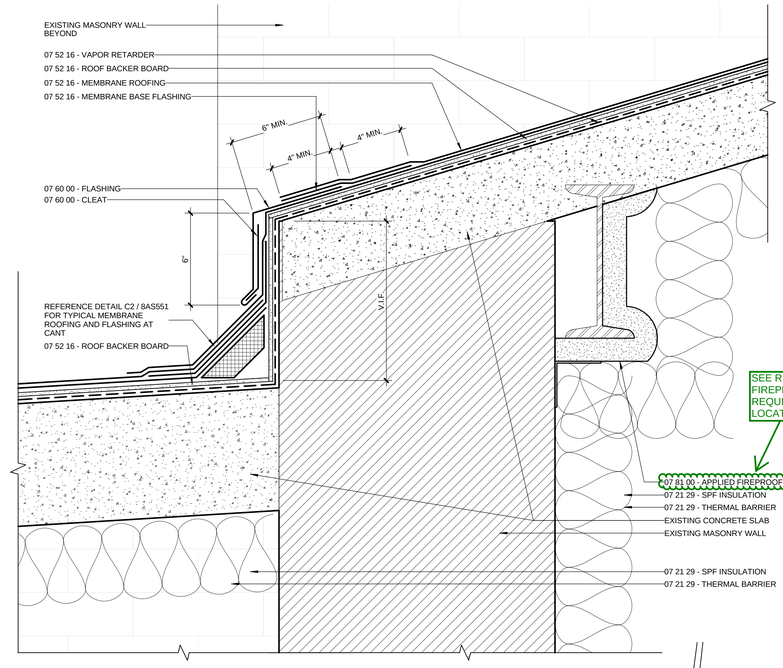

C5 SECTION THRU ROOF TRANSITION LOOKING SOUTH

SCALE: 3" = 1'-0"

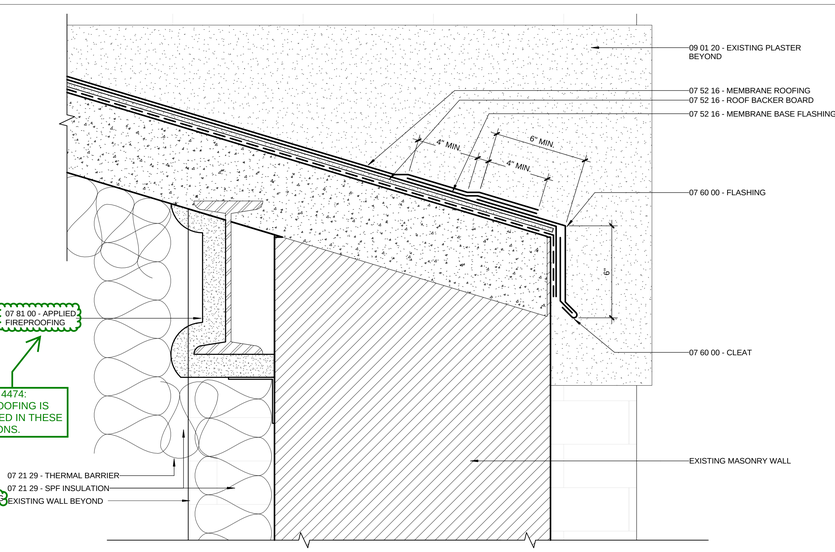

C2 SECTION THRU CONCRETE SLAB ROOF LOOKING SOUTH

SCALE: 3" = 1'-0"

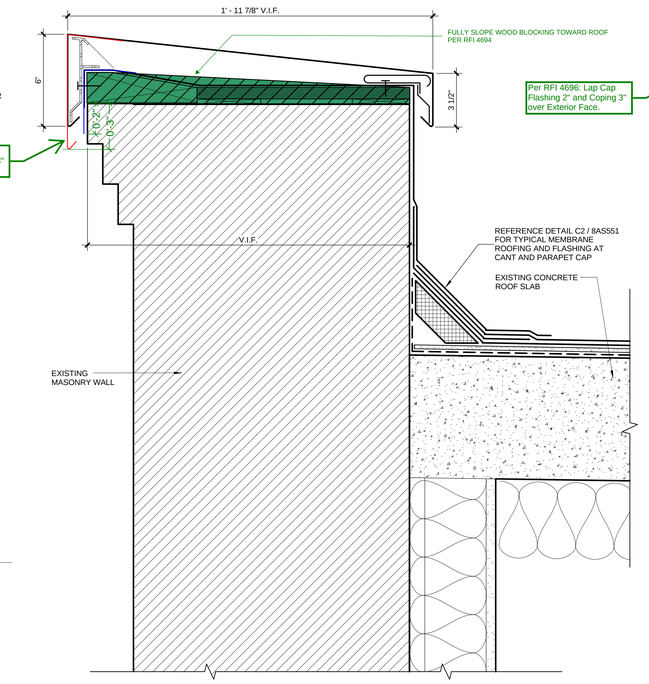

F5 SECTION THRU MASONRY WALL AT HOISTWAY ROOF LOOKING EAST

SCALE: 3" = 1'-0"

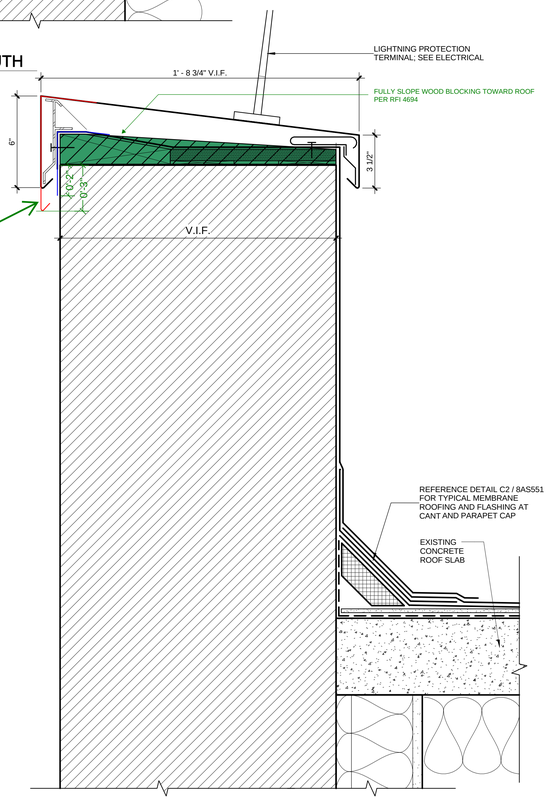

F4 SECTION THRU ROOF AT CONCRETE SLAB ROOF LOOKING EAST

SCALE: 3" = 1'-0"

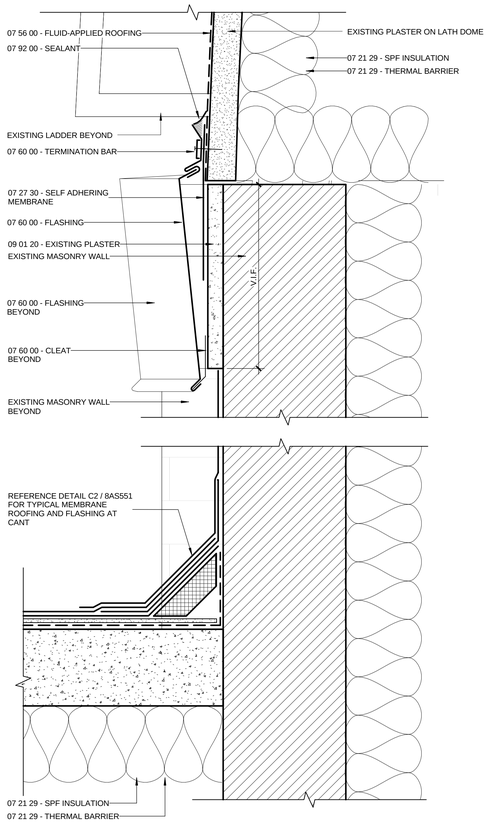

F2 SECTION THRU ROOF AT DOME AND CONCRETE SLAB ROOF LOOKING EAST

SCALE: 3" = 1'-0"

CONSTRUCTION DOCUMENTS 1
FULLY SPRINKLERED

REVISIONS:	DATE

CONSULTANTS:

DESMAN ASSOCIATES / PARKING
CODE CONSULTANTS, INC / CODE CONSULTANT
THE SEXTANT GROUP / AV & ACOUSTICAL
HAMMER DESIGN ASSOCIATES / FOOD SERVICE
PYBURN & ODOM / ABATEMENT
TATA & HOWARD / TANK CONSULTANT
I.S.C. GROUP, INC / IRRIGATION
DAN EUSER WATER ARCHITECTURE, INC / WATER FEATURE

MARK J. RIPPLE REG. NO. 3454 REGISTERED ARCHITECT

ARCHITECT/ENGINEERS:

studioNOVA

SCHRENK & PETERSON CONSULTING ENGINEERS / CIVIL
KORDA/NEMETH ENGINEERING / STRUCTURAL
BR+A CONSULTING ENGINEERS / MECH & ELEC
ARCHITECTURAL ENGINEERING / PLUMBING
SCALES ASSOCIATES / FIRE PROTECTION
COMMUNICATIONS DESIGN GROUP / LOW VOLTAGE

DRAWING TITLE: BLDG 8 EXTERIOR WALL DETAILS

APPROVED: PROJECT DIRECTOR: Todd Sanders

PROJECT TITLE: SLVHCS REPLACEMENT MEDICAL CENTER PROJECT

LOCATION: NEW ORLEANS, LOUISIANA

DATE: July 16, 2012 | CHECKED: CD | DRAWN: AM

PROJECT NUMBER: 629-HS2-401 | BUILDING NUMBER: 8

DOCUMENT SET PACKAGE: WP_9B

DRAWING NUMBER: 8AS553

OFFICE OF CONSTRUCTION AND FACILITIES MANAGEMENT

Department of Veterans Affairs

VA FORM 08-6231