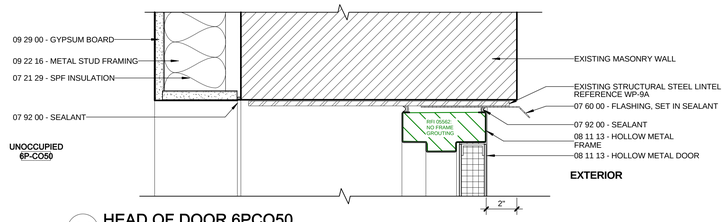

C6 HEAD OF DOOR 6PCO50
SCALE: 3" = 1'-0"

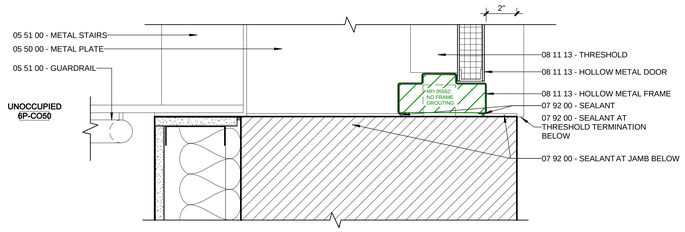

D6 JAMB OF DOOR 6PCO50
SCALE: 3" = 1'-0"

B3 HEAD OF DOOR 1P113
SCALE: 3" = 1'-0"

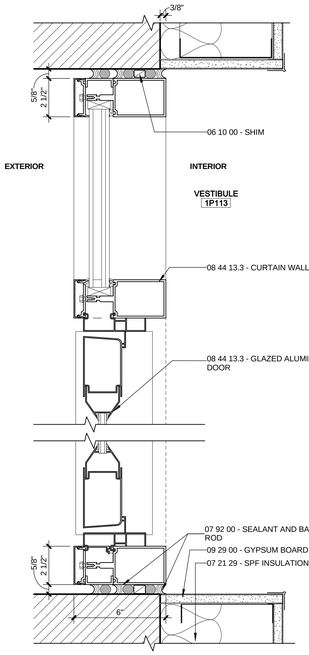

D3 JAMB OF DOOR 1P113
SCALE: 3" = 1'-0"

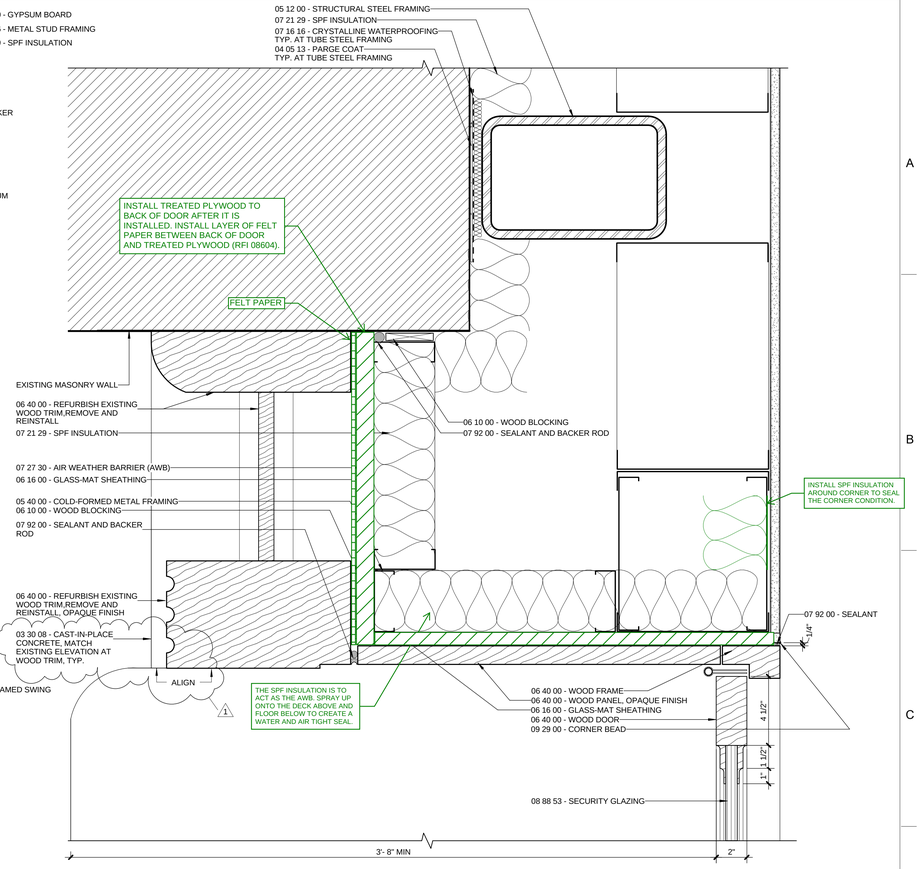

D1 JAMB OF EXISTING ENTRANCE 1P113A.1
SCALE: 3" = 1'-0"

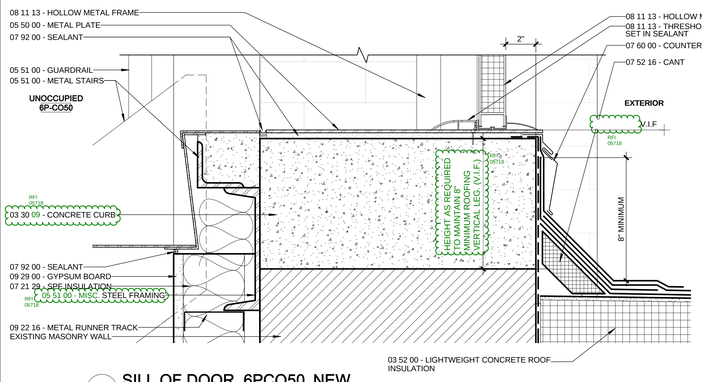

F6 SILL OF DOOR 6PCO50_NEW
SCALE: 3" = 1'-0"

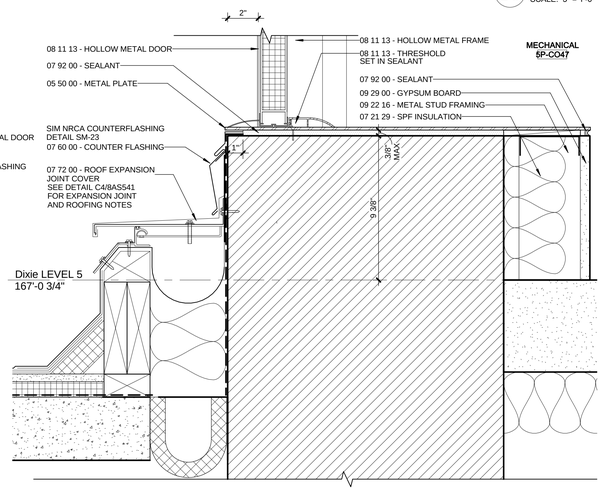

F4 SILL OF DOOR 5PCO47
SCALE: 3" = 1'-0"

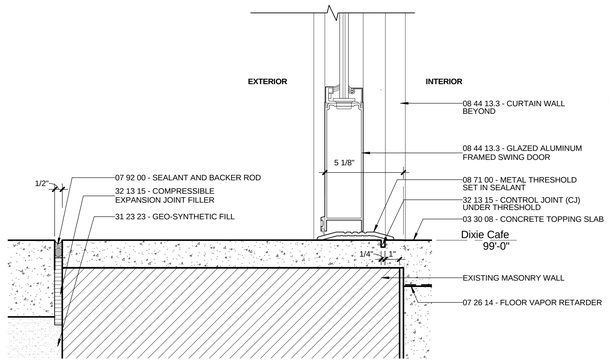

F2 SILL OF DOOR 1P113
SCALE: 3" = 1'-0"

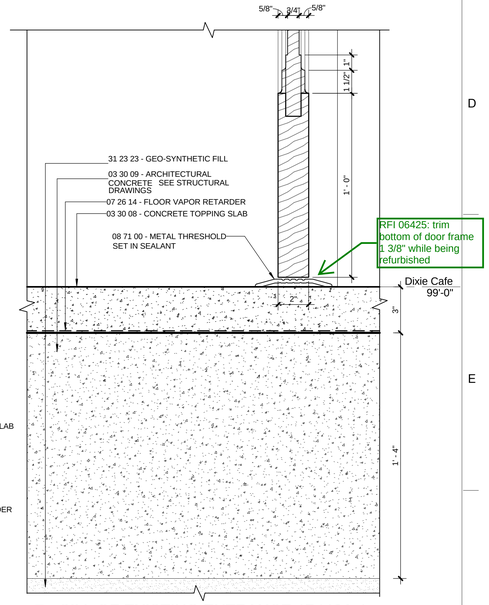

F1 SILL OF EXISTING ENTRANCE 1P113A.1
SCALE: 3" = 1'-0"

CONSTRUCTION DOCUMENTS 1
FULLY SPRINKLERED

1	Addendum #1	9/21/12
REVISIONS:		DATE

CONSULTANTS:

DESMAN ASSOCIATES / PARKING
CODE CONSULTANTS, INC / CODE CONSULTANT
THE SEXTANT GROUP / AV & ACOUSTICAL
HAMMER DESIGN ASSOCIATES / FOOD SERVICE
PYBURN & ODOM / ABATEMENT
TATA & HOWARD / TANK CONSULTANT
I.S.C. GROUP, INC / IRRIGATION
DAN EUSER WATER ARCHITECTURE, INC / WATER FEATURE

MARK J. RIPPLE
REG. NO. 3454
STATE REGISTERED ARCHITECT

ARCHITECT/ENGINEERS:

studioNOVA

SCHRENK & PETERSON CONSULTING ENGINEERS / CIVIL
KORDA/NEMETH ENGINEERING / STRUCTURAL
BR+A CONSULTING ENGINEERS / MECH & ELEC
ARCHITECTURAL ENGINEERING / PLUMBING
SCALES ASSOCIATES / FIRE PROTECTION
COMMUNICATIONS DESIGN GROUP / LOW VOLTAGE

DRAWING TITLE: BLDG 8 EXTERIOR DOOR FRAME DETAILS

APPROVED: PROJECT DIRECTOR: Todd Sanders

PROJECT TITLE: SLVHCS REPLACEMENT MEDICAL CENTER PROJECT

LOCATION: NEW ORLEANS, LOUISIANA

DATE: July 16, 2012 | CHECKED: CD | DRAWN: AM

PROJECT NUMBER: 629-HS2-401 | BUILDING NUMBER: 8

DOCUMENT SET PACKAGE: WP_9B

DRAWING NUMBER: 8AS576

OFFICE OF CONSTRUCTION AND FACILITIES MANAGEMENT

Department of Veterans Affairs

VA FORM 08-6231

ONE INCH = FORTY FEET (1" = 40')
THREE INCHES = ONE FOOT
ONE AND ONE HALF INCHES = ONE FOOT
THREE QUARTERS INCH = ONE FOOT
ONE HALF INCH = ONE FOOT
ONE QUARTER INCH = ONE FOOT
ONE EIGHT INCH = ONE FOOT
ONE SIXTEENTH INCH = ONE FOOT