




ONE INCH = FORTY FEET  
 ONE AND ONE HALF INCHES = ONE FOOT  
 THREE INCHES = ONE FOOT  
 ONE AND ONE HALF INCHES = ONE FOOT  
 THREE QUARTERS INCH = ONE FOOT  
 ONE HALF INCH = ONE FOOT  
 ONE QUARTER INCH = ONE FOOT  
 ONE QUARTER INCH = ONE FOOT  
 ONE EIGHT INCH = ONE FOOT  
 ONE SIXTEENTH INCH = ONE FOOT

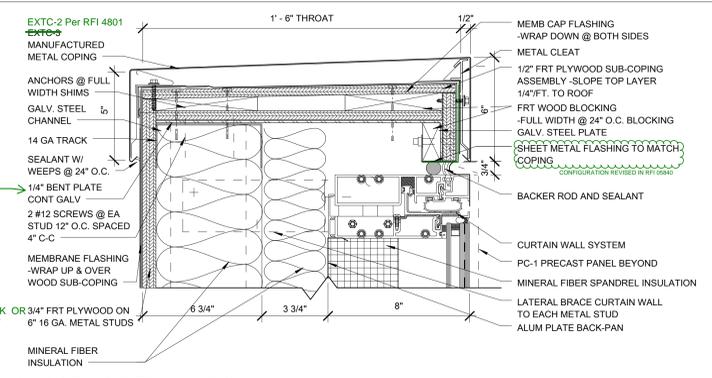


**A6 COPING DETAIL AT CW**  
 SCALE: 3" = 1'-0"

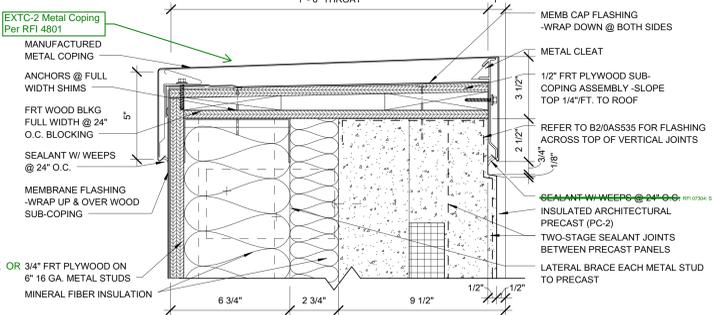


**B6 COPING DETAIL @ PC-1**  
 SCALE: 3" = 1'-0"

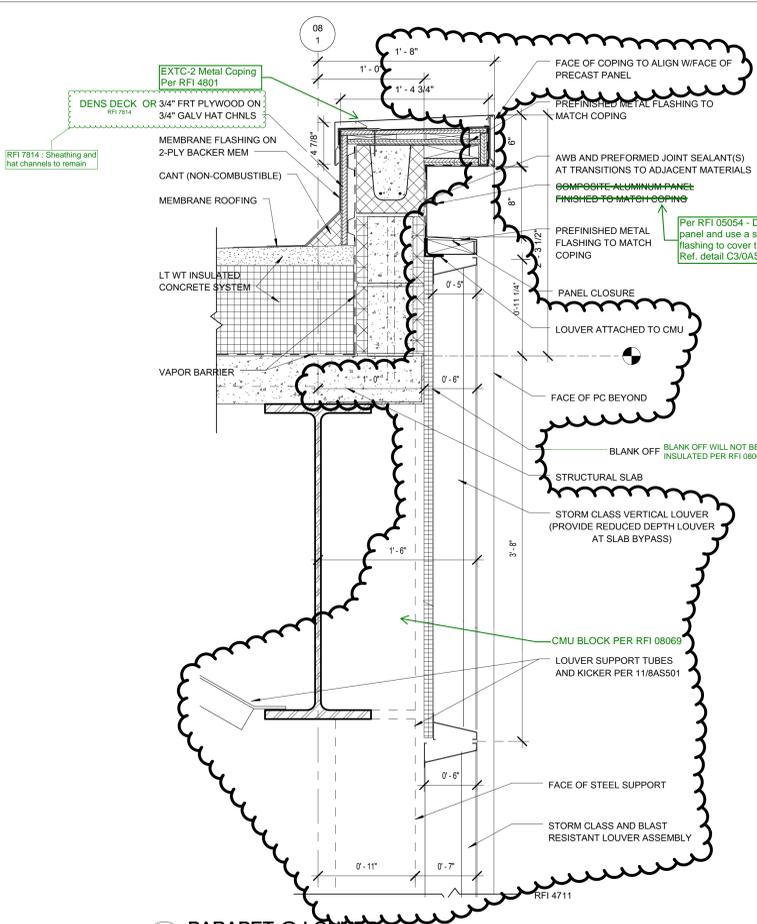


**B2 PARAPET @ LOUVER**  
 SCALE: 1 1/2" = 1'-0"

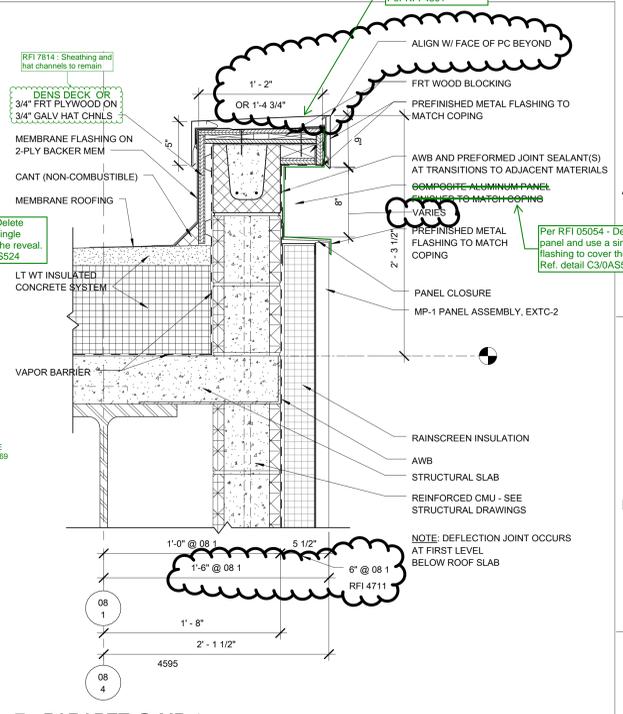

**B1 PARAPET @ MP-1**  
 SCALE: 1 1/2" = 1'-0"

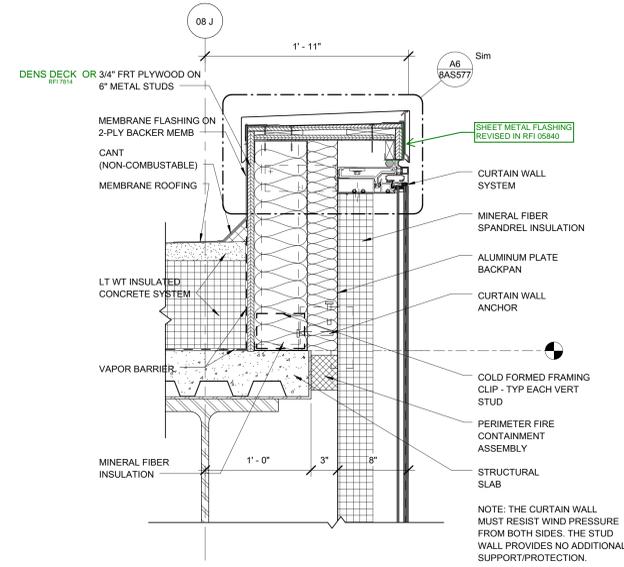


**B4 PARAPET @ CW-1 ADJ TO PC-1**  
 SCALE: 1 1/2" = 1'-0"

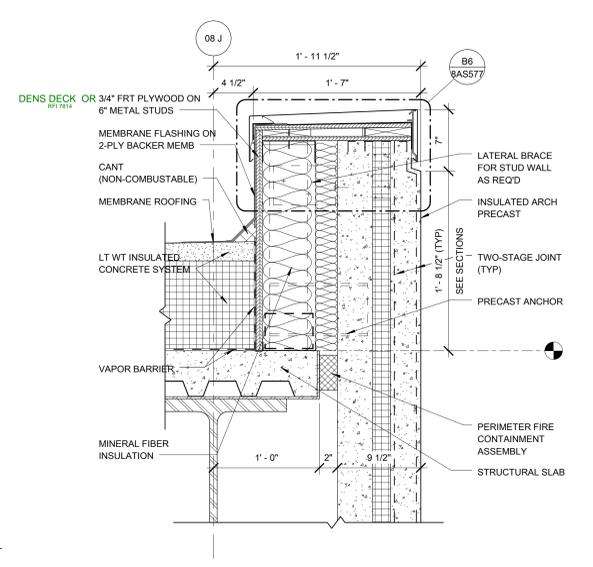

**B3 PARAPET @ PC-1**  
 SCALE: 1 1/2" = 1'-0"

RFI 4711	1-7-2015
REVISIONS:	DATE

**CONSULTANTS:**  
 DESMAN ASSOCIATES / PARKING  
 CODE CONSULTANTS, INC. / CODE CONSULTANT  
 THE SEXTANT GROUP / AV & ACOUSTICAL  
 HAMMER DESIGN ASSOCIATES / FOOD SERVICE  
 PYBURN & ODOM / ABATEMENT  
 TATA & HOWARD / TANK CONSULTANT  
 I.S.C. GROUP, INC. / IRRIGATION  
 DAN EUSER WATER ARCHITECTURE, INC. / WATER FEATURE

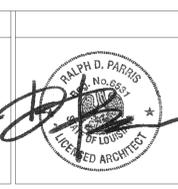

**ARCHITECT/ENGINEERS:**  
 studio **NOVA**  
 SCHRENK & PETERSON CONSULTING ENGINEERS / CIVIL  
 KORDA/NEMETH ENGINEERING / STRUCTURAL  
 BR+A CONSULTING ENGINEERS / MECH. ELECT, PLUMBING, LOW VOLTAGE  
 ARCHITECTURAL ENGINEERING / PLUMBING  
 SCALES ASSOCIATES / FIRE PROTECTION

DRAWING TITLE  
 EXTERIOR DETAILS-ROOF PARAPET

APPROVED: PROJECT DIRECTOR

PROJECT TITLE  
 SLV/HCS REPLACEMENT MEDICAL CENTER PROJECT

LOCATION  
 NEW ORLEANS, LOUISIANA

DATE  
 July 16, 2012

CHECKED  
 JR

DRAWN  
 DS/CN

PROJECT NUMBER  
 100342.00

BUILDING NUMBER  
 8

DOCUMENT SET PACKAGE  
 WP\_09B

DRAWING NUMBER  
**8AS577**

CONSTRUCTION DOCUMENTS 1  
 FULLY SPRINKLERED

**OFFICE OF CONSTRUCTION AND FACILITIES MANAGEMENT**

Department of Veterans Affairs