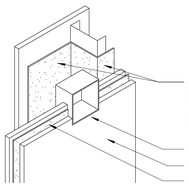

AXO, LEAD PROTECTION AT WALL PENETRATIONS

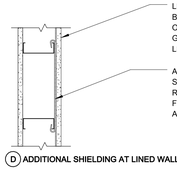

D **ADDITIONAL SHIELDING AT LINED WALLS**

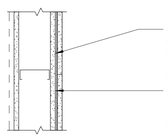

C **GYP BOARD JOINT**

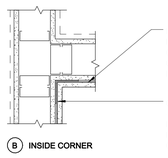

B **INSIDE CORNER**

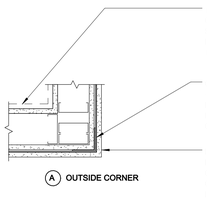

A **OUTSIDE CORNER**

E5 TYP LEAD SHIELDING DETAILS
SCALE: 1 1/2" = 1'-0"
F1031-LEAD-LINED_PARTITIONS-01

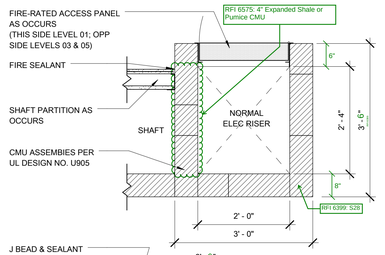

C3 ELEC RISER SHAFT PLANS
SCALE: 3/4" = 1'-0"
C1014-ELEC SHAFT

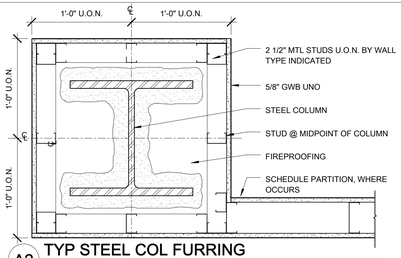

A2 TYP STEEL COL FURRING
SCALE: 1 1/2" = 1'-0"
C1011-COL_STL_FURR_PLAN-01

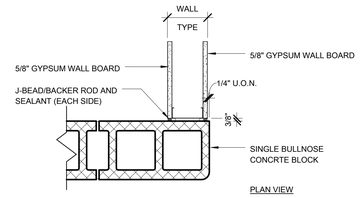

RFI 7890 detail B2/8AI505 is typical at all GYP BD/ CMU wall intersection

B2 TYP. GYP BD/CMU CORNER
SCALE: 1 1/2" = 1'-0"
C1225-CNR_GWB/CMU-01

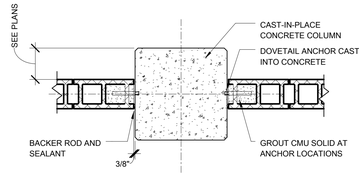

C2 TYP. CMU @ CONC COLUMN
SCALE: 3/4" = 1'-0"
C1011-COL-MAS_ANCHOR-01

RFI 06305: Fire-stopping is to remain exposed. Use STI ES gray sealant

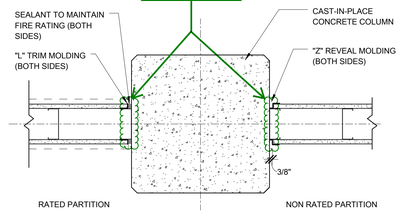

A1 TYP PARTITION @ CONC. COLUMN
SCALE: 1 1/2" = 1'-0"
C1011-COL_STL_PART_PLAN-01

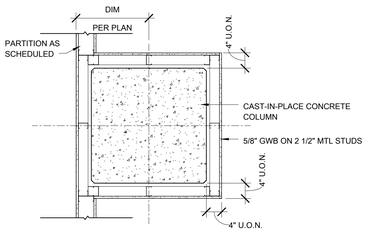

B1 TYP CONC. COL FURRING
SCALE: 3/4" = 1'-0"
C1011-COL_STL_FURR_PLAN-01

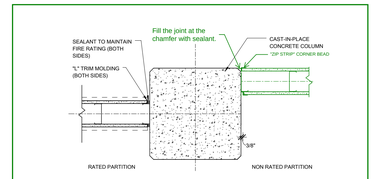

RFI 8186 - Drywall to concrete column detail

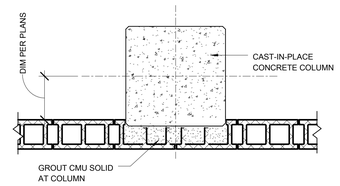

D2 TYP. CMU @ CONC COLUMN BYPASS
SCALE: 3/4" = 1'-0"
C1011-COL-MAS_ANCHOR-02

CONSTRUCTION DOCUMENTS 1
FULLY SPRINKLERED

REVISIONS:	DATE

CONSULTANTS:
DESMAN ASSOCIATES / PARKING
CODE CONSULTANTS, INC. / CODE CONSULTANT
THE SEXTANT GROUP / AV & ACOUSTICAL
HAMMER DESIGN ASSOCIATES / FOOD SERVICE
PYBURN & ODOM / ABATEMENT
TATA & HOWARD / TANK CONSULTANT
I.S.C. GROUP, INC. / IRRIGATION
DAN EUSER WATER ARCHITECTURE, INC. / WATER FEATURE

RALPH D. PARRIS No.6231 STATE OF LOUISIANA LICENSED ARCHITECT

ARCHITECT/ENGINEERS:
studioNOVA
SCHRENK & PETERSON CONSULTING ENGINEERS / CIVIL
KORDA/NEMETH ENGINEERING / STRUCTURAL
BR+A CONSULTING ENGINEERS / MECH, ELECT, PLUMBING, LOW VOLTAGE
ARCHITECTURAL ENGINEERING / PLUMBING
SCALES ASSOCIATES / FIRE PROTECTION

DRAWING TITLE: PARTITION & MISC. DETAILS

APPROVED: PROJECT DIRECTOR: Todd Sanders

PROJECT TITLE: SLVHCS REPLACEMENT MEDICAL CENTER PROJECT

LOCATION: NEW ORLEANS, LOUISIANA

DATE: July 16, 2012 | CHECKED: DMK/JK | DRAWN: ML

PROJECT NUMBER: 100342.00 | BUILDING NUMBER: 08

DOCUMENT SET PACKAGE: WP_09B

DRAWING NUMBER: 8AI505

OFFICE OF CONSTRUCTION AND FACILITIES MANAGEMENT

Department of Veterans Affairs

VA FORM 08-6231