

ONE INCH = FORTY FEET (1" = 40')

0' 15' 30"

0' 6"

THREE INCHES = ONE FOOT

0' 6"

ONE AND ONE HALF INCHES = ONE FOOT

0' 6"

THREE QUARTERS INCH = ONE FOOT

0' 6"

ONE HALF INCH = ONE FOOT

0' 6"

ONE QUARTER INCH = ONE FOOT


0' 6"

ONE EIGHT INCH = ONE FOOT

0' 4' 8"

ONE SIXTEENTH INCH = ONE FOOT

0' 4' 8"

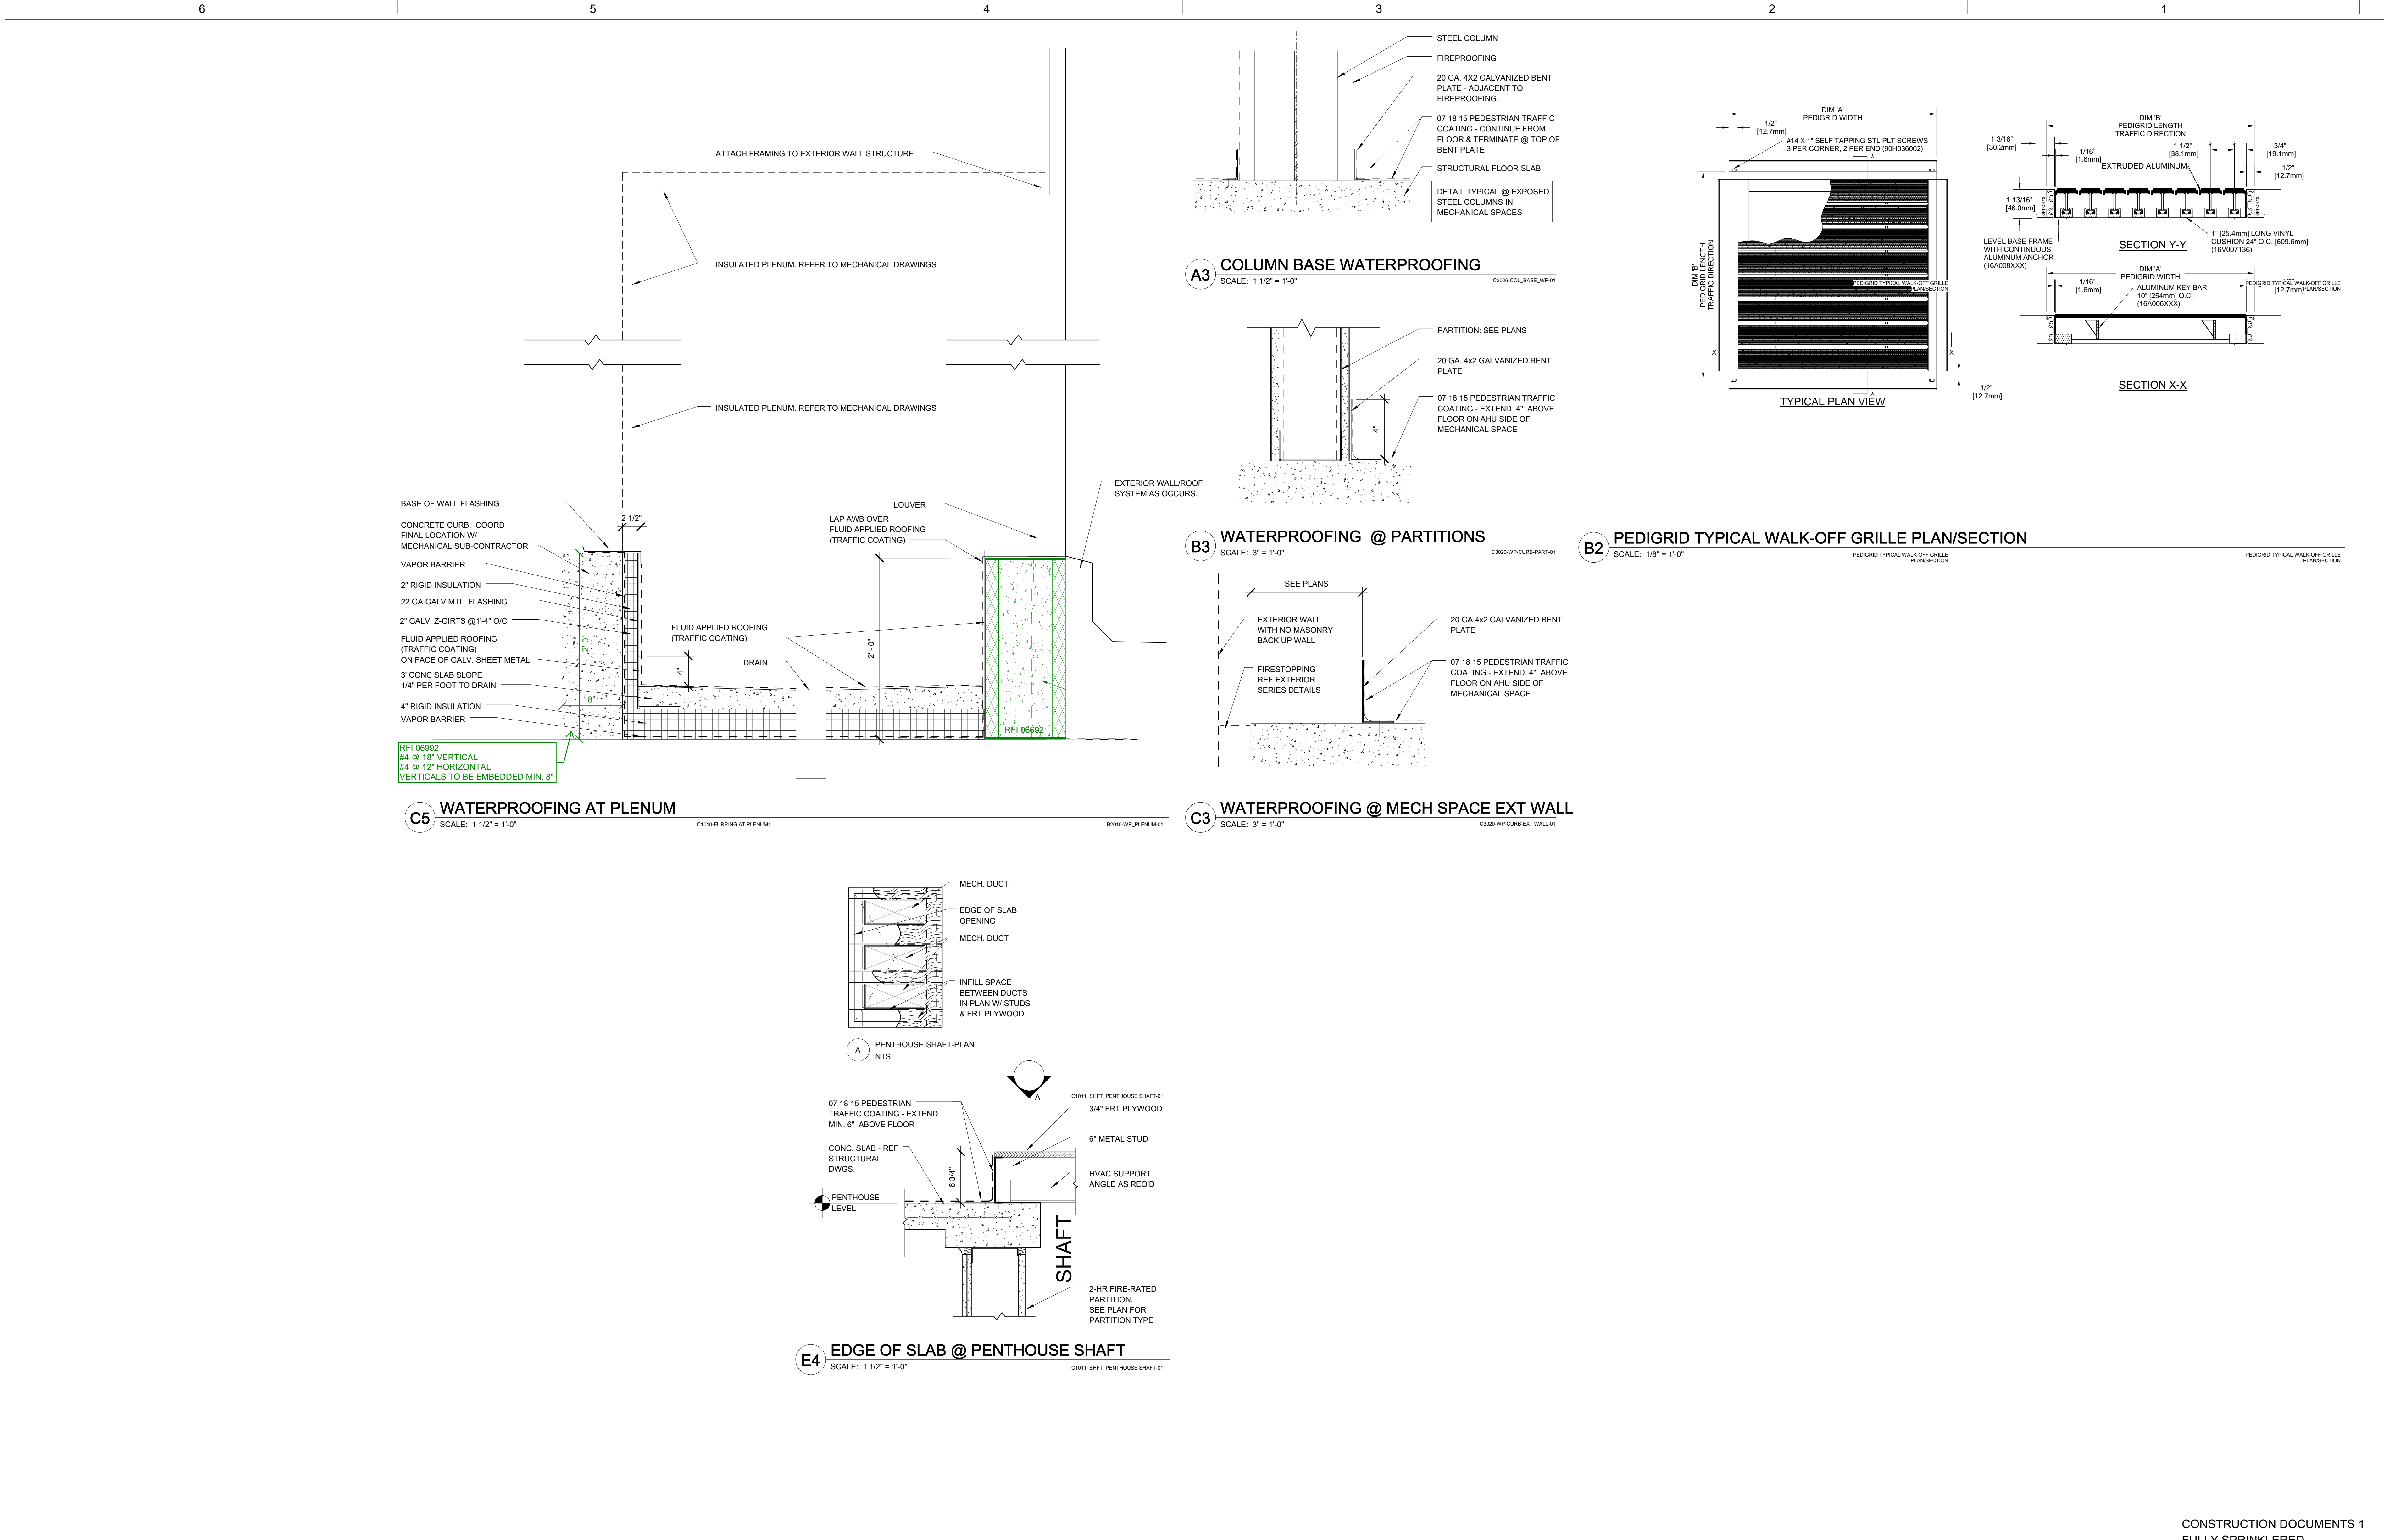

--	--	