

ONE INCH = FORTY FEET (1"=40')

THREE INCHES = ONE FOOT

ONE AND ONE HALF INCHES = ONE FOOT



THREE QUARTERS INCH = ONE FOOT

ONE HALF INCH = ONE FOOT

ONE QUARTER INCH = ONE FOOT

ONE EIGHT INCH = ONE FOOT

ONE SIXTEENTH INCH = ONE FOOT

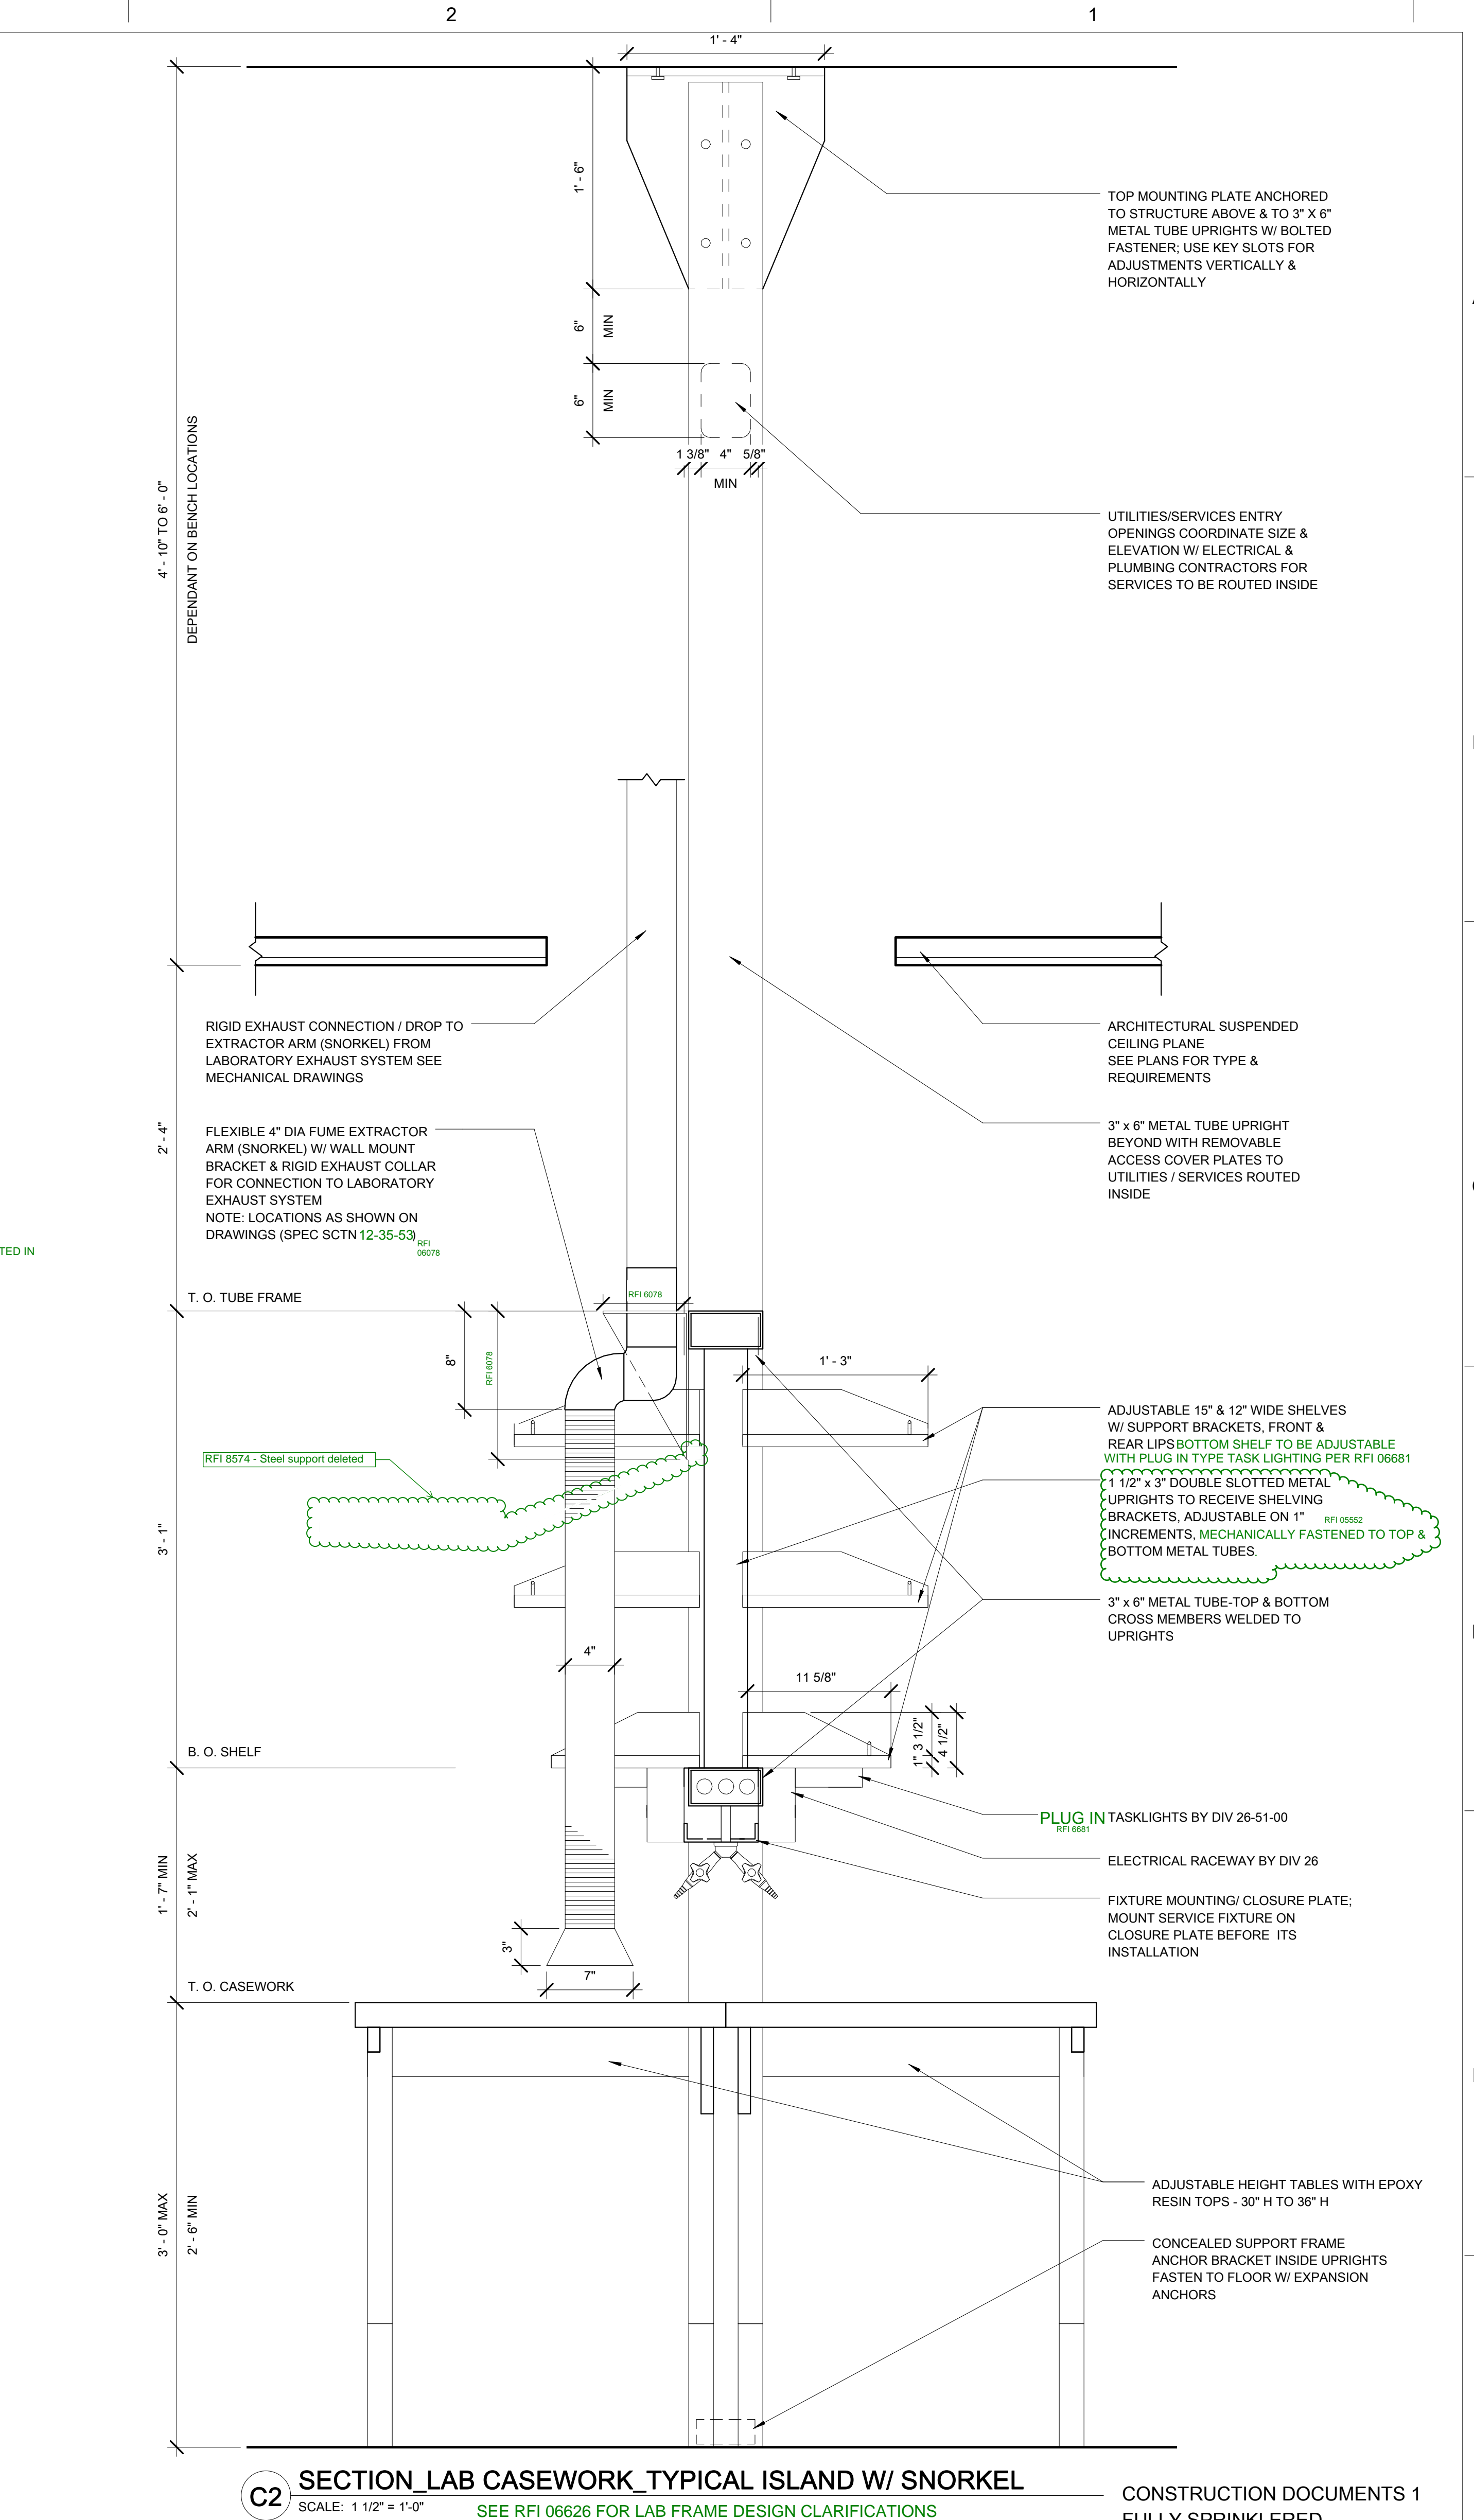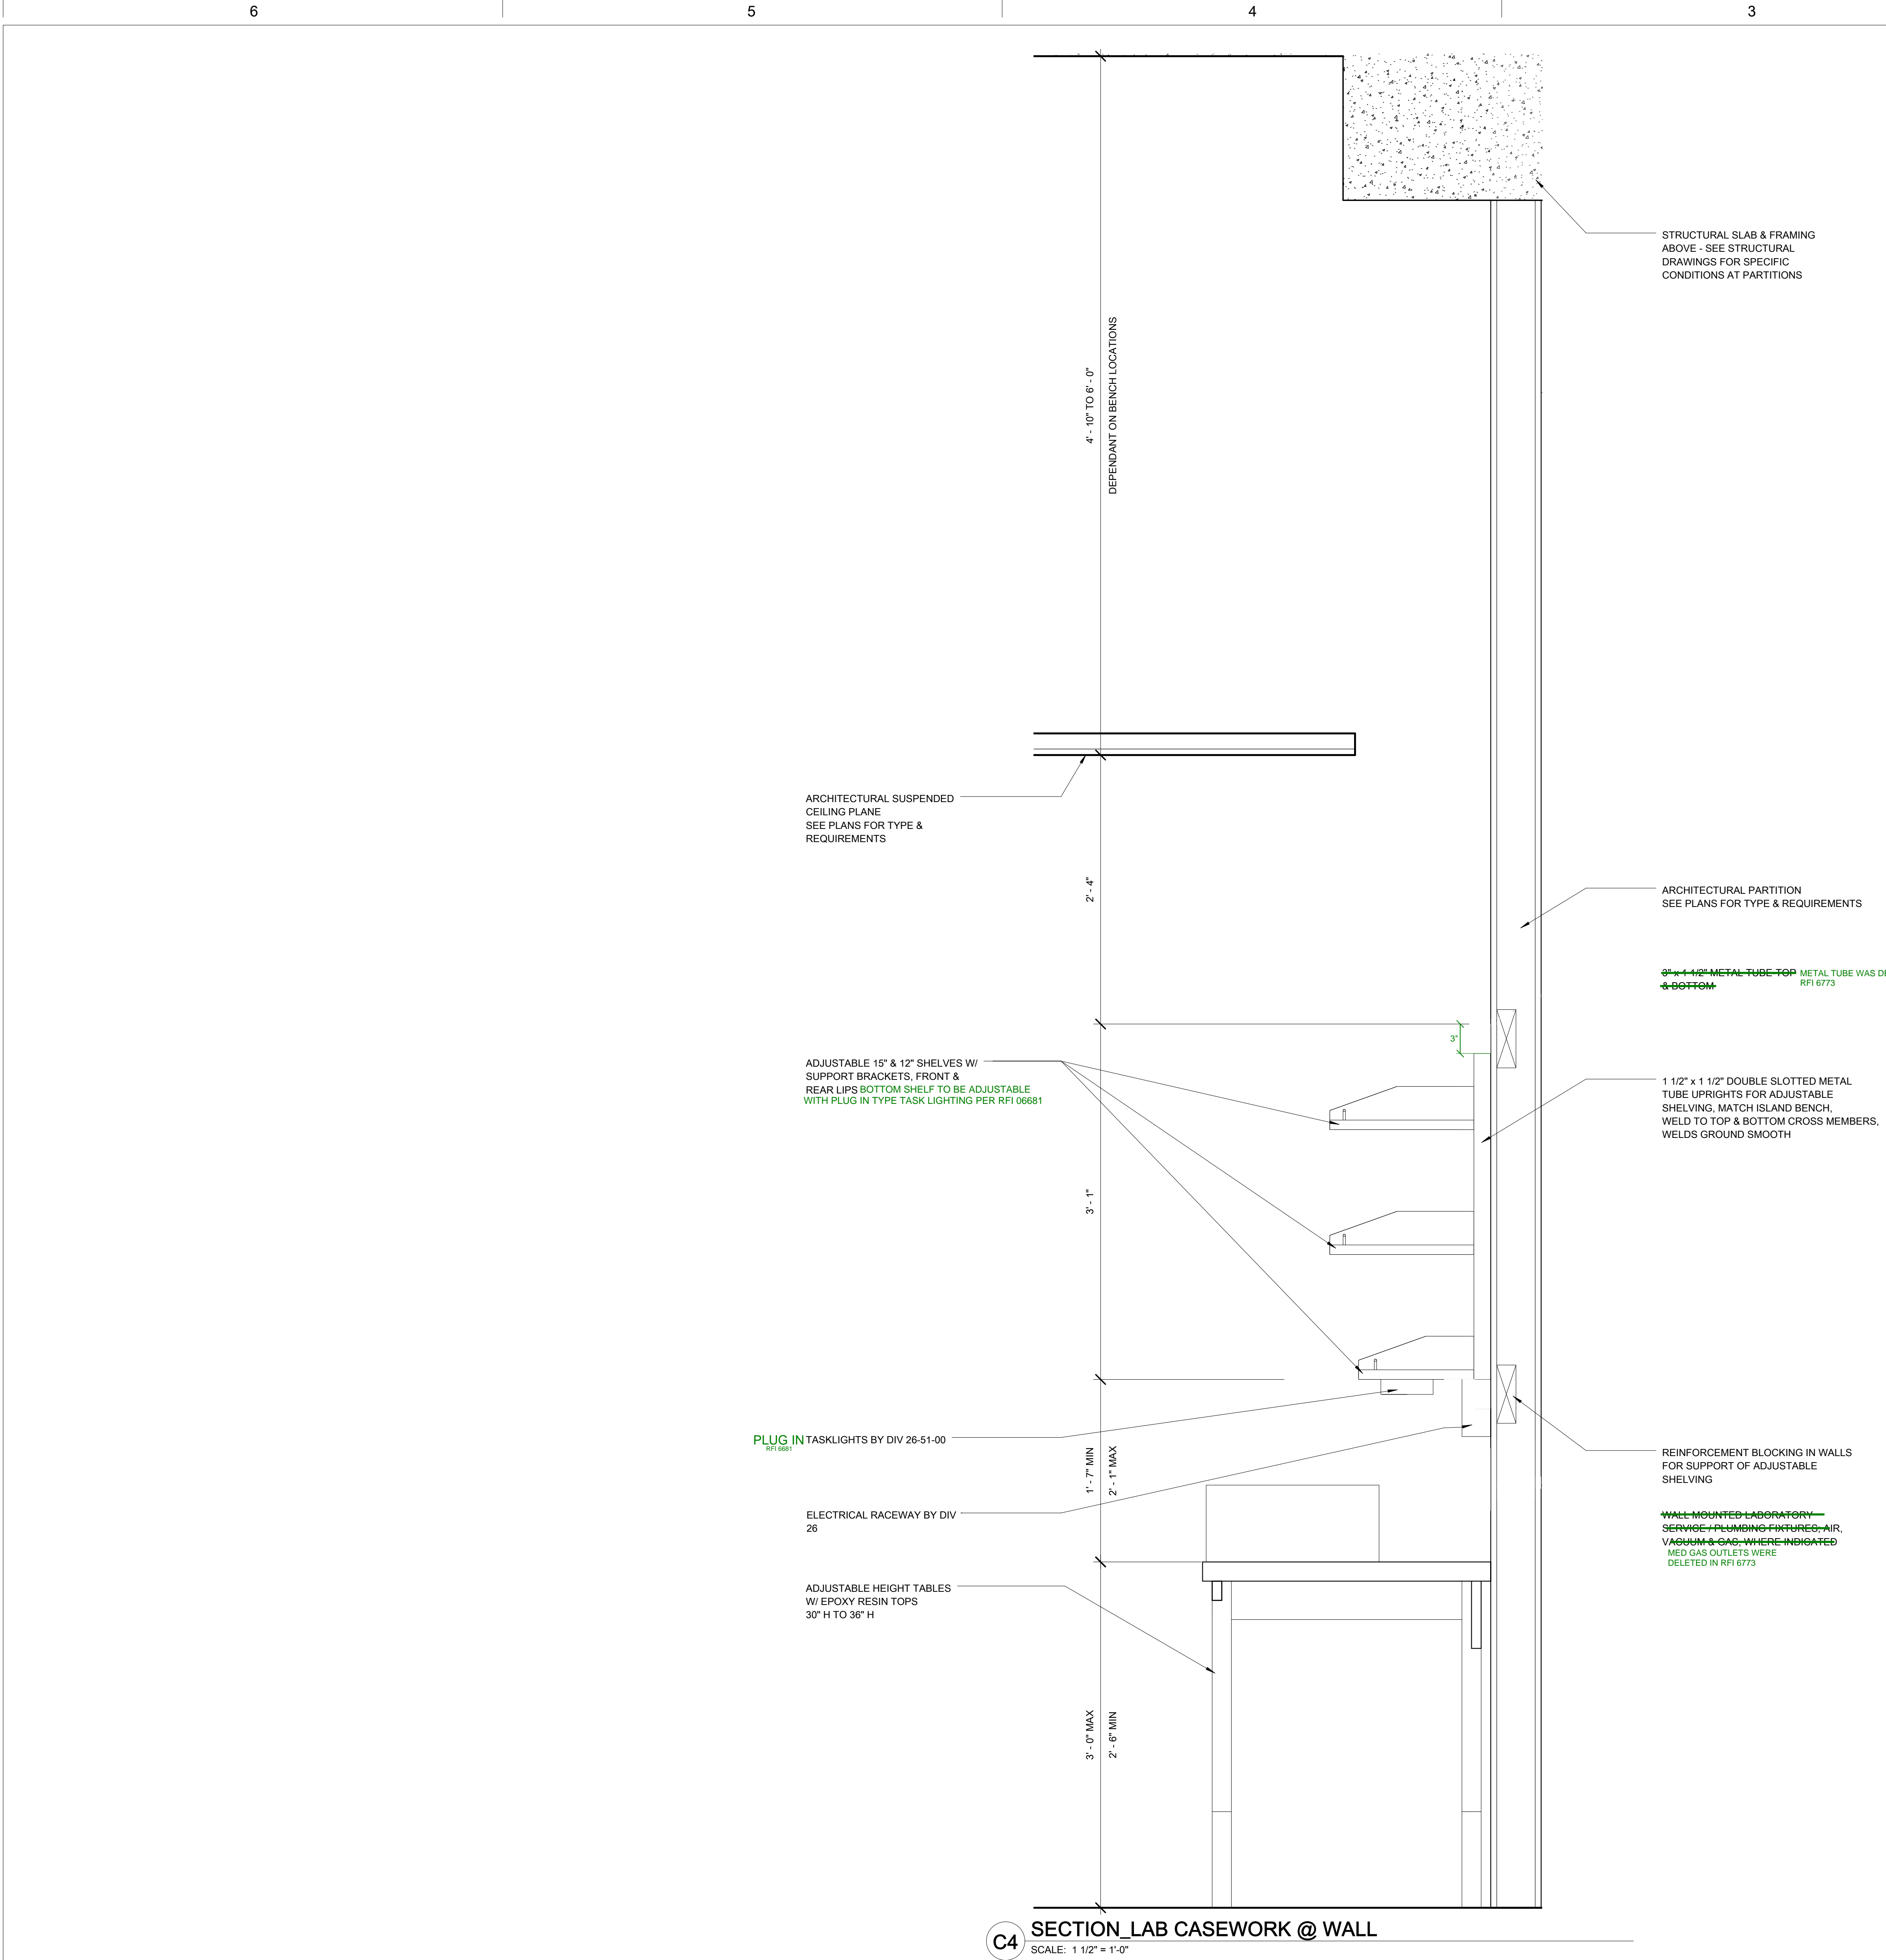

CONSULTANTS:	
DESMAN ASSOCIATES / PARKING	
CODE CONSULTANTS, INC. / CODE CONSULTANT	
THE SEXTANT GROUP / AV & ACOUSTICAL	
HAMMER DESIGN ASSOCIATES / FOOD SERVICE	
PYBURN & ODOM / ABATEMENT	
TATA & HOWARD / TANK CONSULTANT	
I.S.C. GROUP, INC. / IRRIGATION	
DAN EUSER WATER ARCHITECTURE, INC. / WATER FEATURE	
REVISIONS:	DATE

ARCHITECT/ENGINEERS:

studio **NOVA**

SCHRENK & PETERSON CONSULTING ENGINEERS / CIVIL

KORDA/NEMETH ENGINEERING / STRUCTURAL

BR+A CONSULTING ENGINEERS / MECH, ELECT, PLUMBING, LOW VOLTAGE

ARCHITECTURAL ENGINEERING / PLUMBING

SCALES ASSOCIATES / FIRE PROTECTION

RALPH D. PARIS

No. 6587

OF LOUISIANA

LICENSED ARCHITECT

DRAWING TITLE	PROJECT TITLE	PROJECT NUMBER	BUILDING NUMBER
TYPICAL LAB CASEWORK DETAILS	SLVHCS REPLACEMENT MEDICAL CENTER PROJECT	100342.00	08
APPROVED: PROJECT DIRECTOR	LOCATION	DOCUMENT SET PACKAGE	DRAWING NUMBER
<i>John Sanders</i>	NEW ORLEANS, LOUISIANA	WP_09B	8A1533
	DATE	CHECKED	DRAWN
	July 16, 2012	JJ	AL

CONSTRUCTION DOCUMENTS 1  
FULLY SPRINKLERED

OFFICE OF  
CONSTRUCTION  
AND FACILITIES  
MANAGEMENT

Department of  
Veterans Affairs