



RFI 06217 ALL SHEET NOTES ON THE ENLARGED STAIR PLANS ARE TO REFERENCE THE SHEET NOTES ON 8AS700

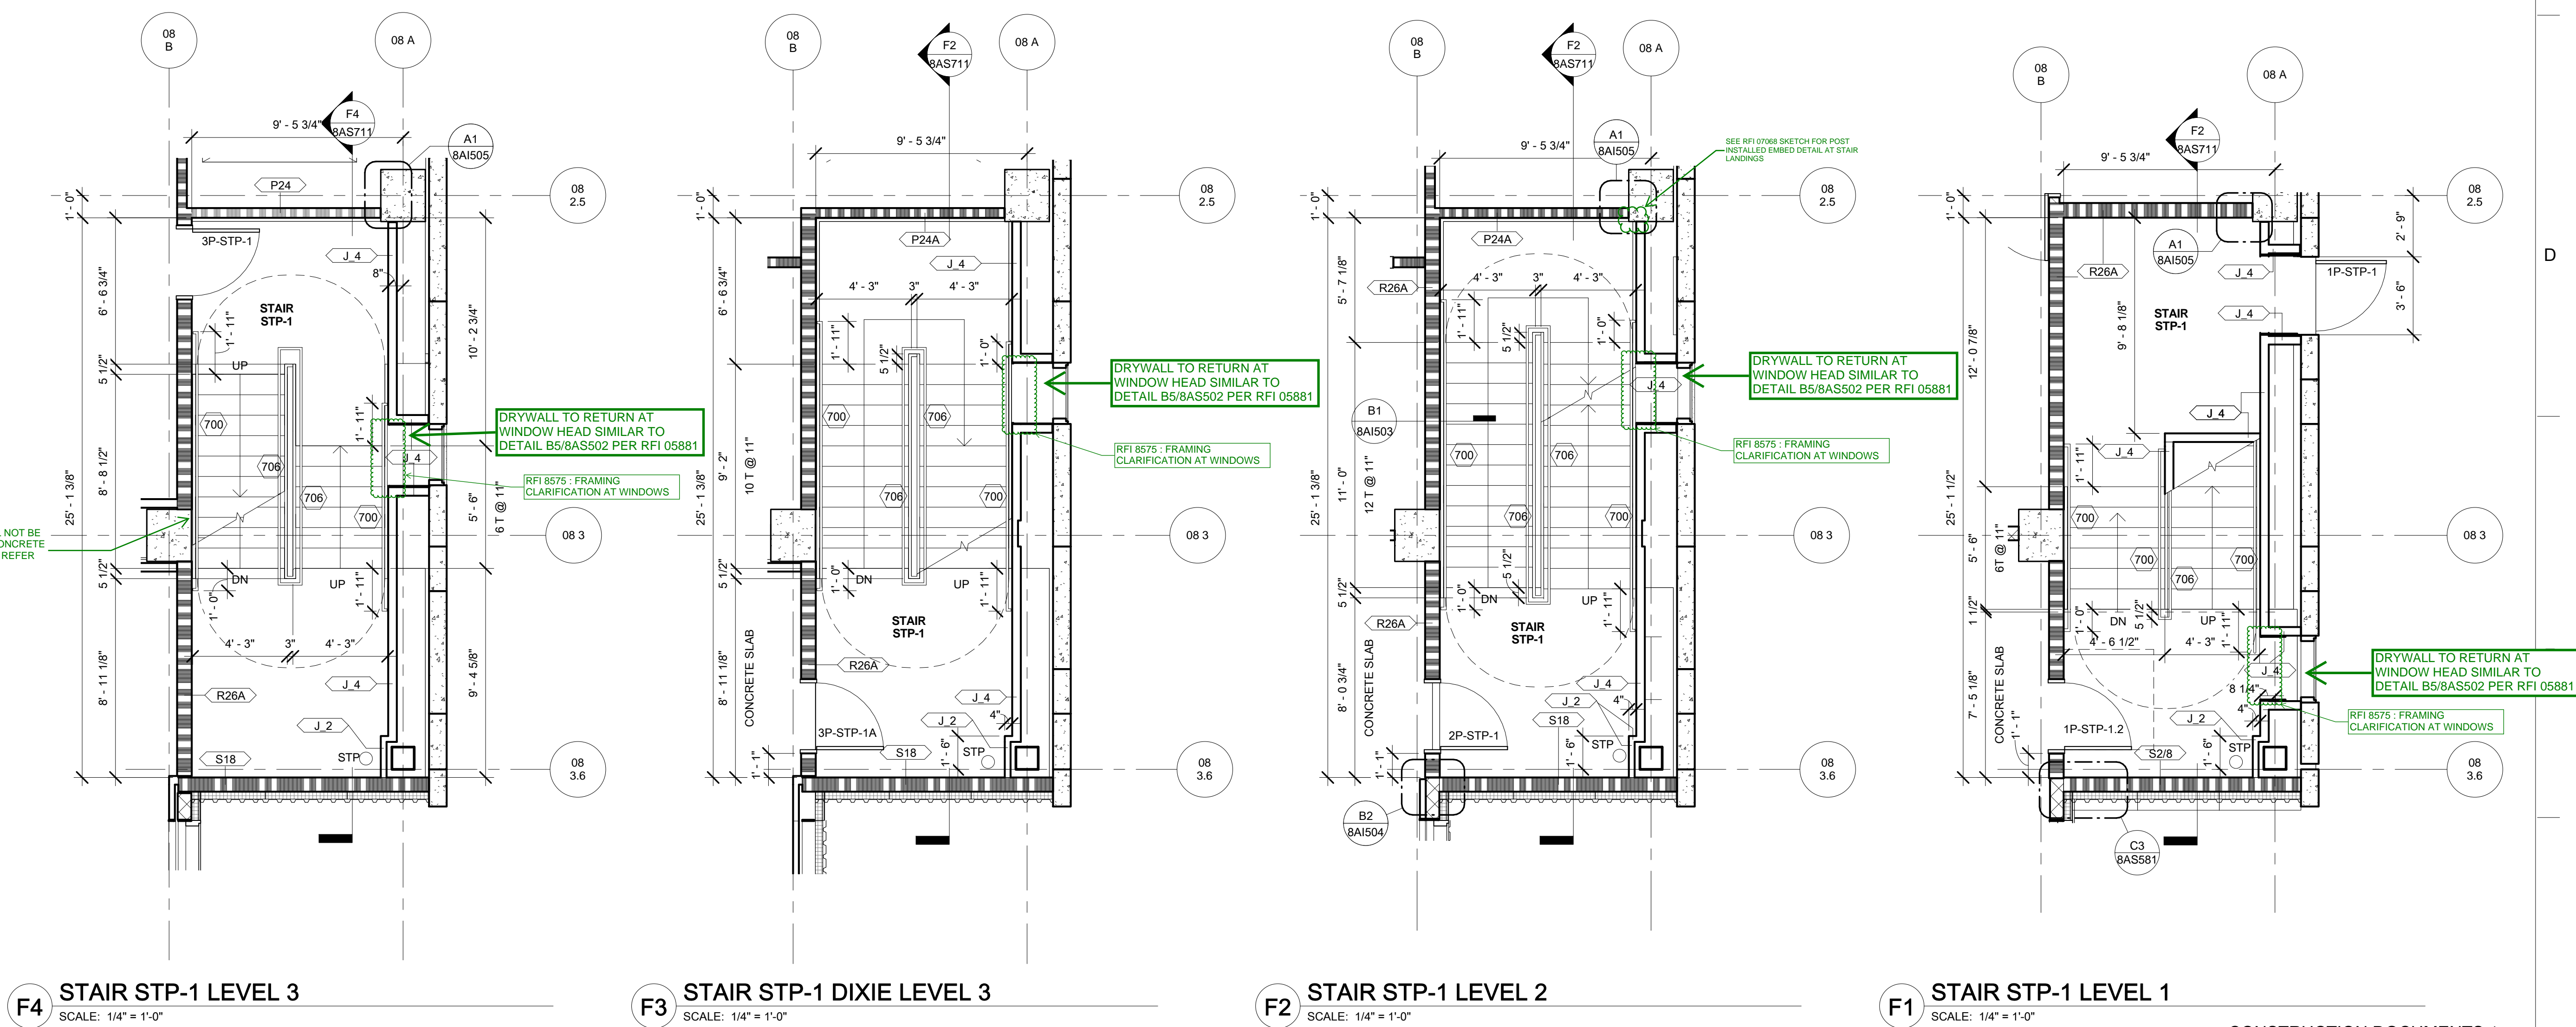

CONSULTANTS:	
DESIGN ASSOCIATES / PARKING	
CODE CONSULTANTS, INC. / CODE CONSULTANT	
THE SEXTANT GROUP / AV & ACOUSTICAL	
HAMMER DESIGN ASSOCIATES / FOOD SERVICE	
PYBURN & ODOM / ABATEMENT	
TATA & HOWARD / TANK CONSULTANT	
I.S.C. GROUP, INC. / IRRIGATION	
DAN EUSER WATER ARCHITECTURE, INC. / WATER FEATURE	
REVISIONS:	
DATE	

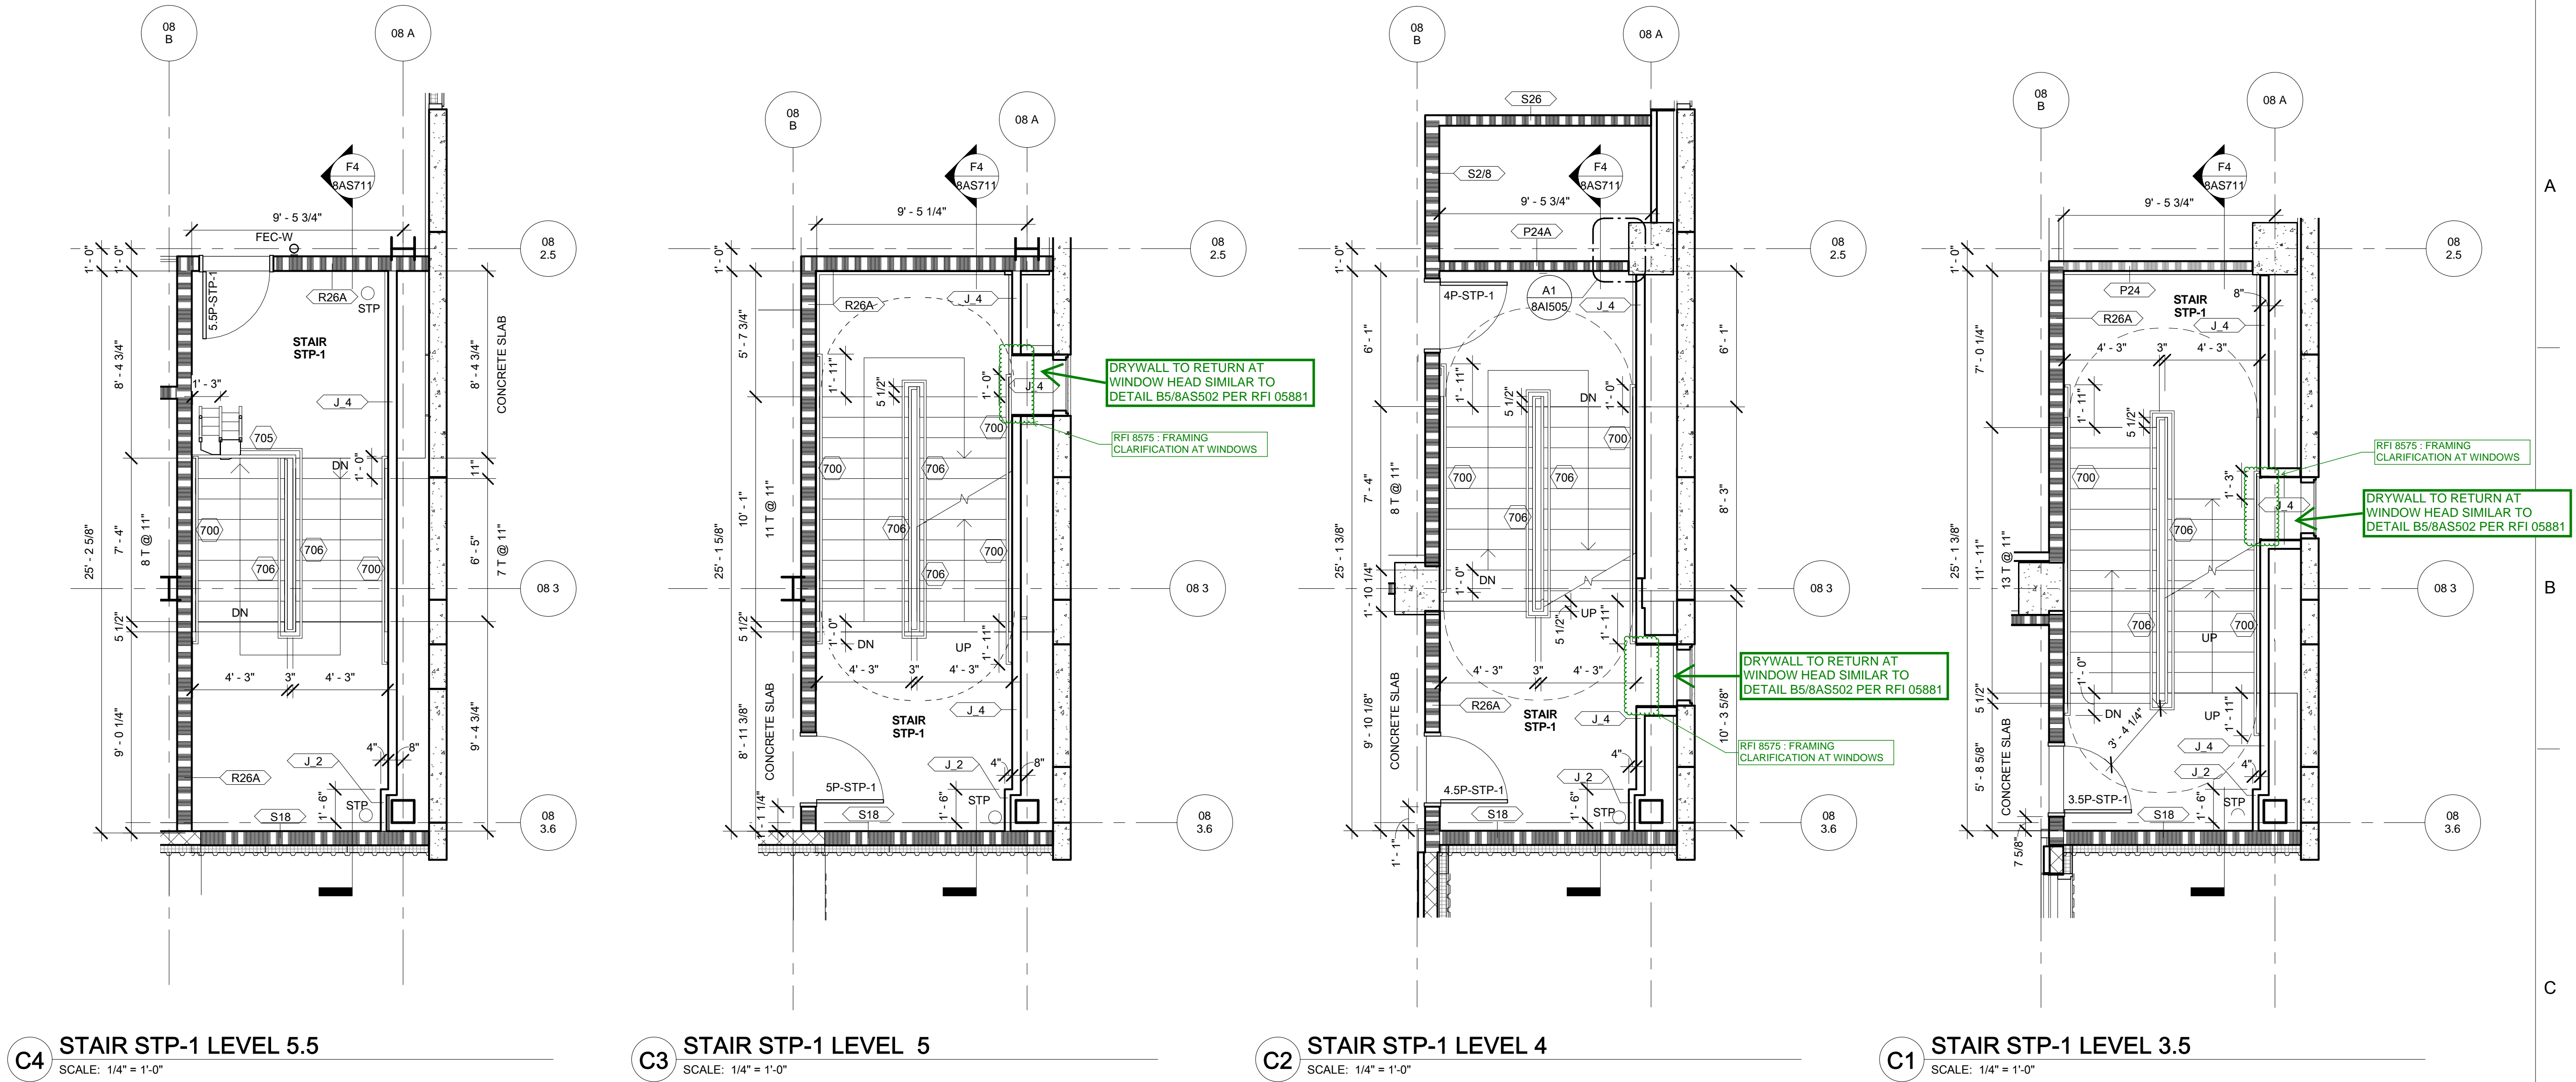

ARCHITECT/ENGINEERS:
studio **NOVA**
SCHRENK & PETERSON CONSULTING ENGINEERS / CIVIL
KORDA/NEMETH ENGINEERING / STRUCTURAL
BR+A CONSULTING ENGINEERS / MECH. ELECT. PLUMBING, LOW VOLTAGE
ARCHITECTURAL ENGINEERING / PLUMBING
SCALES ASSOCIATES / FIRE PROTECTION

DRAWING TITLE
BLDG 8 STAIR P1 ENLARGED PLANS
APPROVED: PROJECT DIRECTOR
Judd Sanders

PROJECT TITLE
SLVHCS REPLACEMENT MEDICAL
CENTER PROJECT
LOCATION
NEW ORLEANS, LOUISIANA
DATE
July 16, 2012
CHECKED
DV
DRAWN
DMK

PROJECT NUMBER
100342.00
BUILDING NUMBER
08
DOCUMENT SET PACKAGE
WP_09B
DRAWING NUMBER
8AS710

CONSTRUCTION DOCUMENTS 1
FULLY SPRINKLERED
OFFICE OF
CONSTRUCTION
AND FACILITIES
MANAGEMENT
Department of
Veterans Affairs