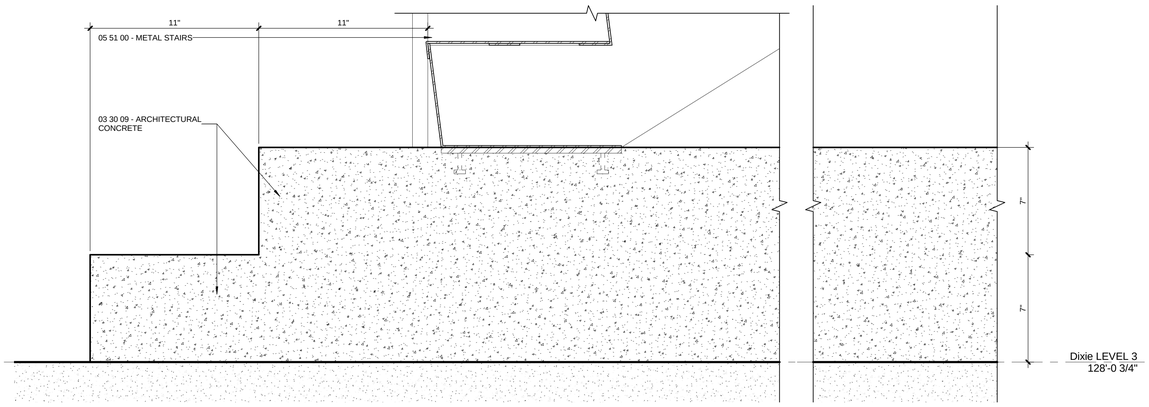

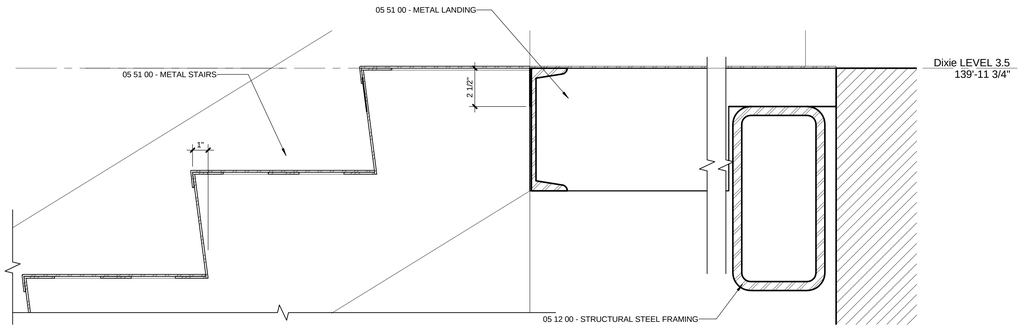

B6 SECTION THRU STAIR 8M08 AT LEVEL 3

SCALE: 3" = 1'-0"

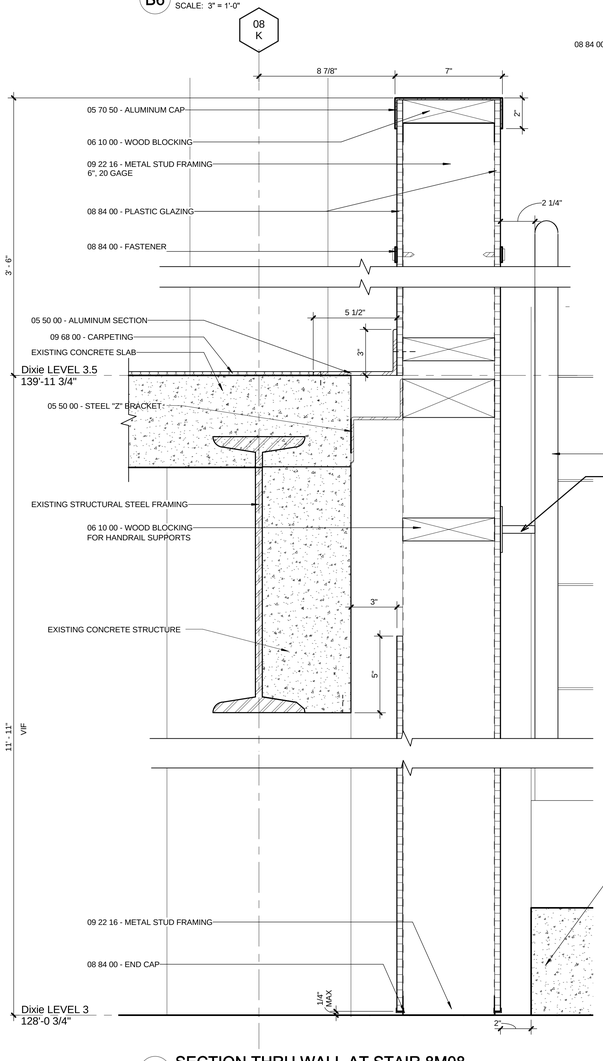

C5 JAMB THRU WALL BEHIND STAIR

SCALE: 3" = 1'-0"

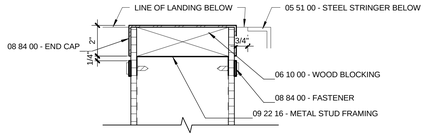

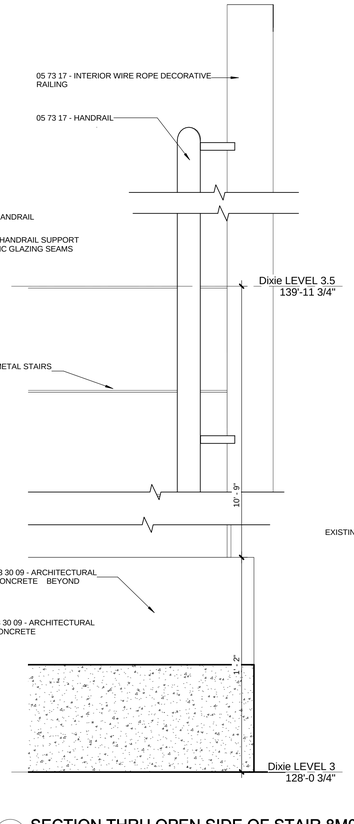

B3 SECTION THRU STAIR 8M08 AT LEVEL 3.5

SCALE: 3" = 1'-0"

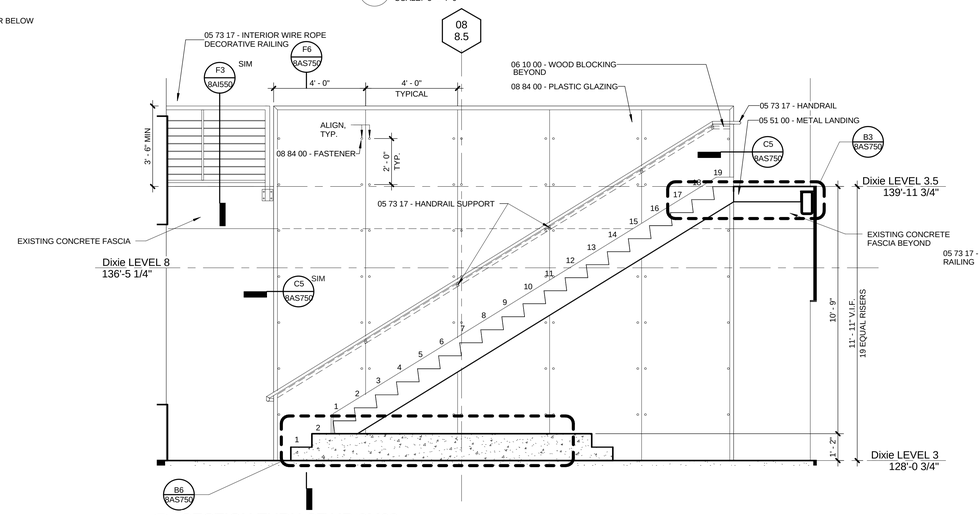

D3 SECTION THRU STAIR 8M08

SCALE: 3/8" = 1'-0"

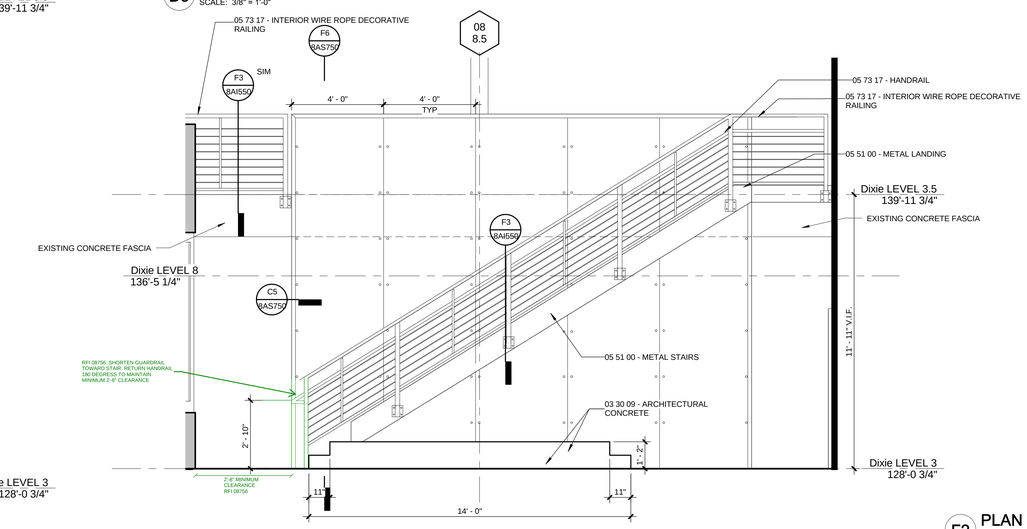

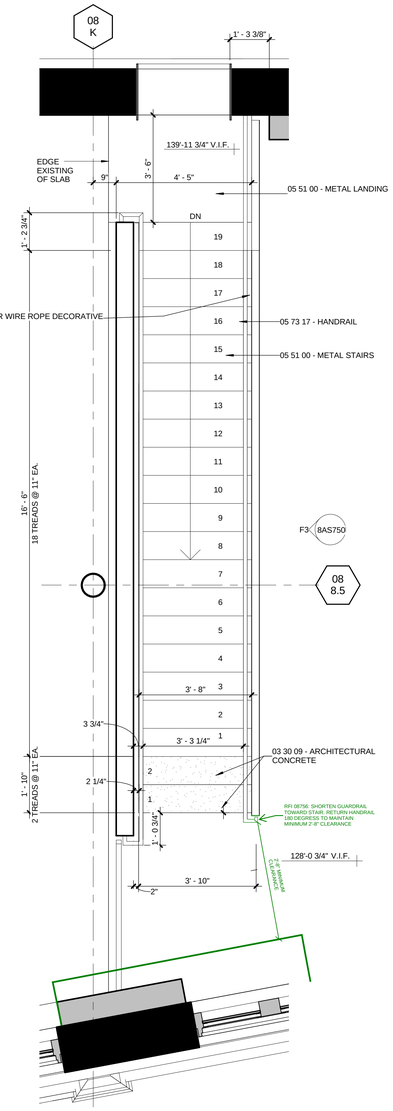

F6 SECTION THRU WALL AT STAIR 8M08

SCALE: 3" = 1'-0"

F5 SECTION THRU OPEN SIDE OF STAIR 8M08

SCALE: 3" = 1'-0"

F3 ELEVATION OF STAIR 8M08

SCALE: 3/8" = 1'-0"

F2 PLAN OF DIXIE STAIR 8M08 - LEVEL 3 TO LEVEL 3.5

SCALE: 1/2" = 1'-0"

CONSTRUCTION DOCUMENTS 1
FULLY SPRINKLERED

REVISIONS:	DATE

CONSULTANTS:

DESMAN ASSOCIATES / PARKING
CODE CONSULTANTS, INC / CODE CONSULTANT
THE SEXTANT GROUP / AV & ACOUSTICAL
HAMMER DESIGN ASSOCIATES / FOOD SERVICE
PYBURN & ODOM / ABATEMENT
TATA & HOWARD / TANK CONSULTANT
I.S.C. GROUP, INC / IRRIGATION
DAN EUSER WATER ARCHITECTURE, INC / WATER FEATURE

MARK J. RYDALE
REG. NO. 3454
REGISTERED ARCHITECT

ARCHITECT/ENGINEERS:

studioNOVA
SCHRENK & PETERSON CONSULTING ENGINEERS / CIVIL
KORDA/NEMETH ENGINEERING / STRUCTURAL
BR+A CONSULTING ENGINEERS / MECH & ELEC
ARCHITECTURAL ENGINEERING / PLUMBING
SCALES ASSOCIATES / FIRE PROTECTION
COMMUNICATIONS DESIGN GROUP / LOW VOLTAGE

DRAWING TITLE: BLDG 8 DIXIE STAIR DETAILS

APPROVED: PROJECT DIRECTOR

PROJECT TITLE: SLVHCS REPLACEMENT MEDICAL CENTER PROJECT

LOCATION: NEW ORLEANS, LOUISIANA

DATE: July 16, 2012 | CHECKED: CD | DRAWN: DL

PROJECT NUMBER: 629-HS2-401 | BUILDING NUMBER: 8

DOCUMENT SET PACKAGE: WP_9B

DRAWING NUMBER: 8AS750

OFFICE OF CONSTRUCTION AND FACILITIES MANAGEMENT
Department of Veterans Affairs

VA FORM 08-6231