

A


B

C


D

E

F

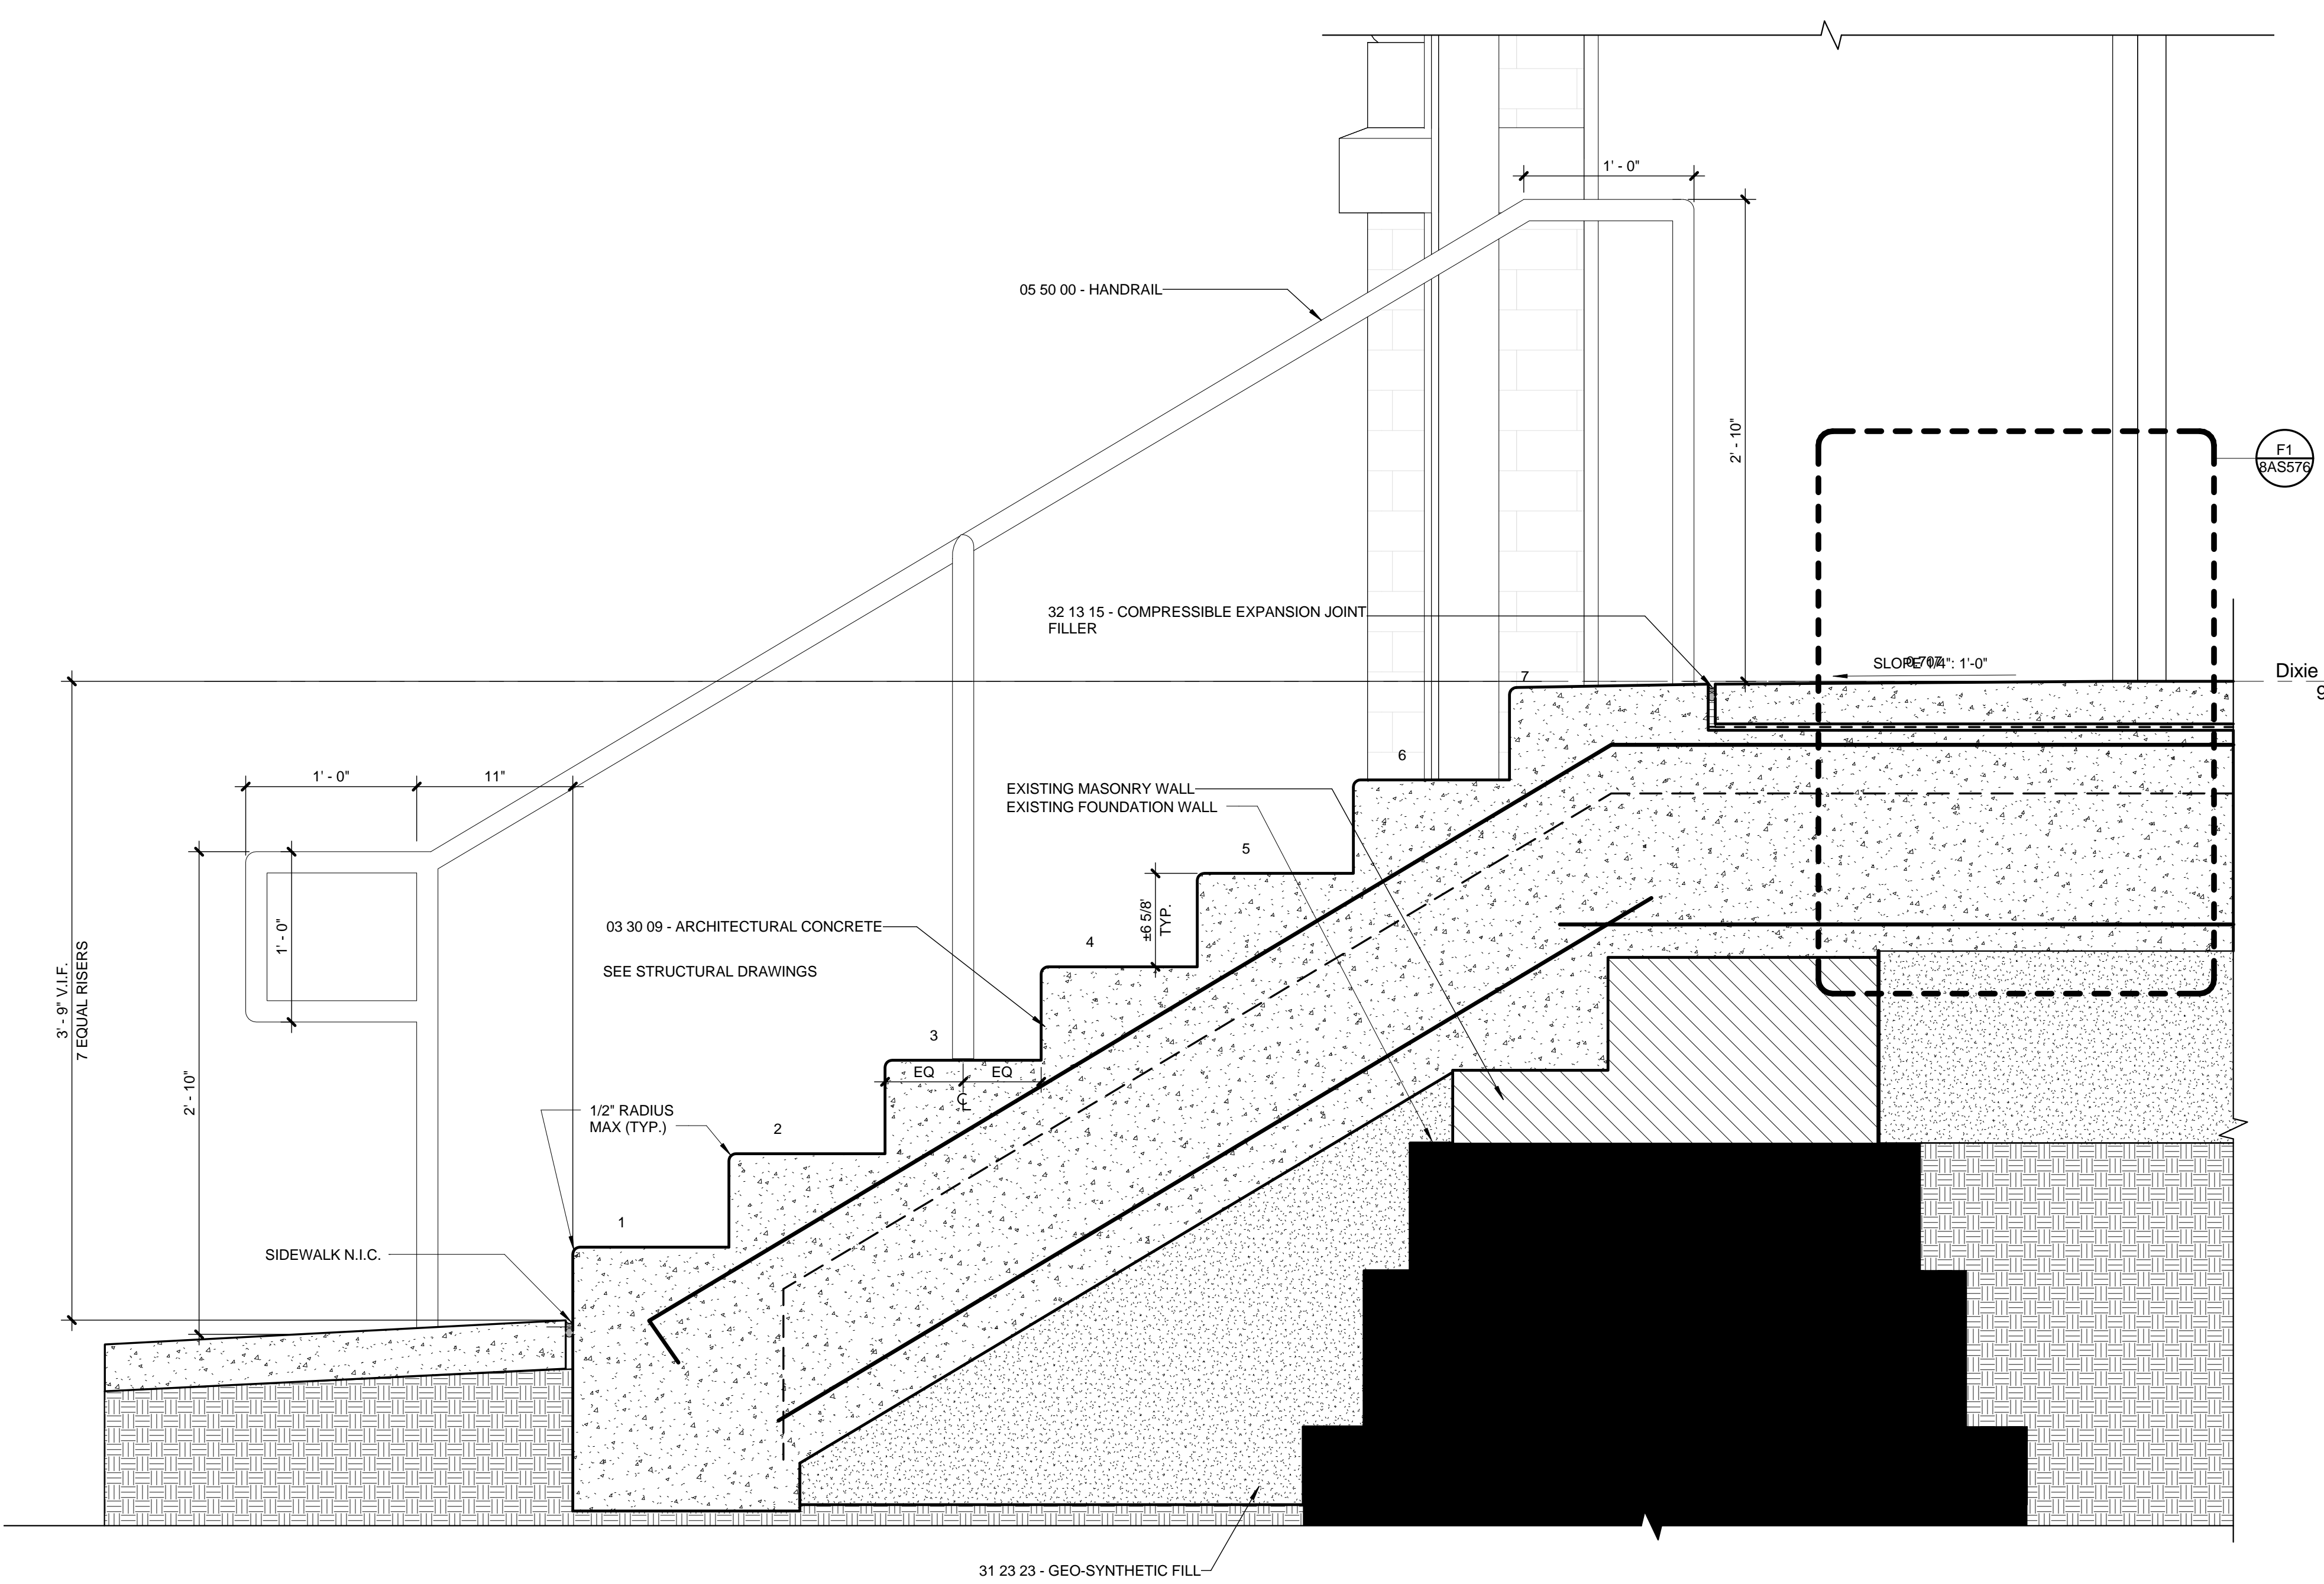

D2 TRANSVERSE SECTION THRU TULANE AVE. STAIR
SCALE: 1 1/2\"/>

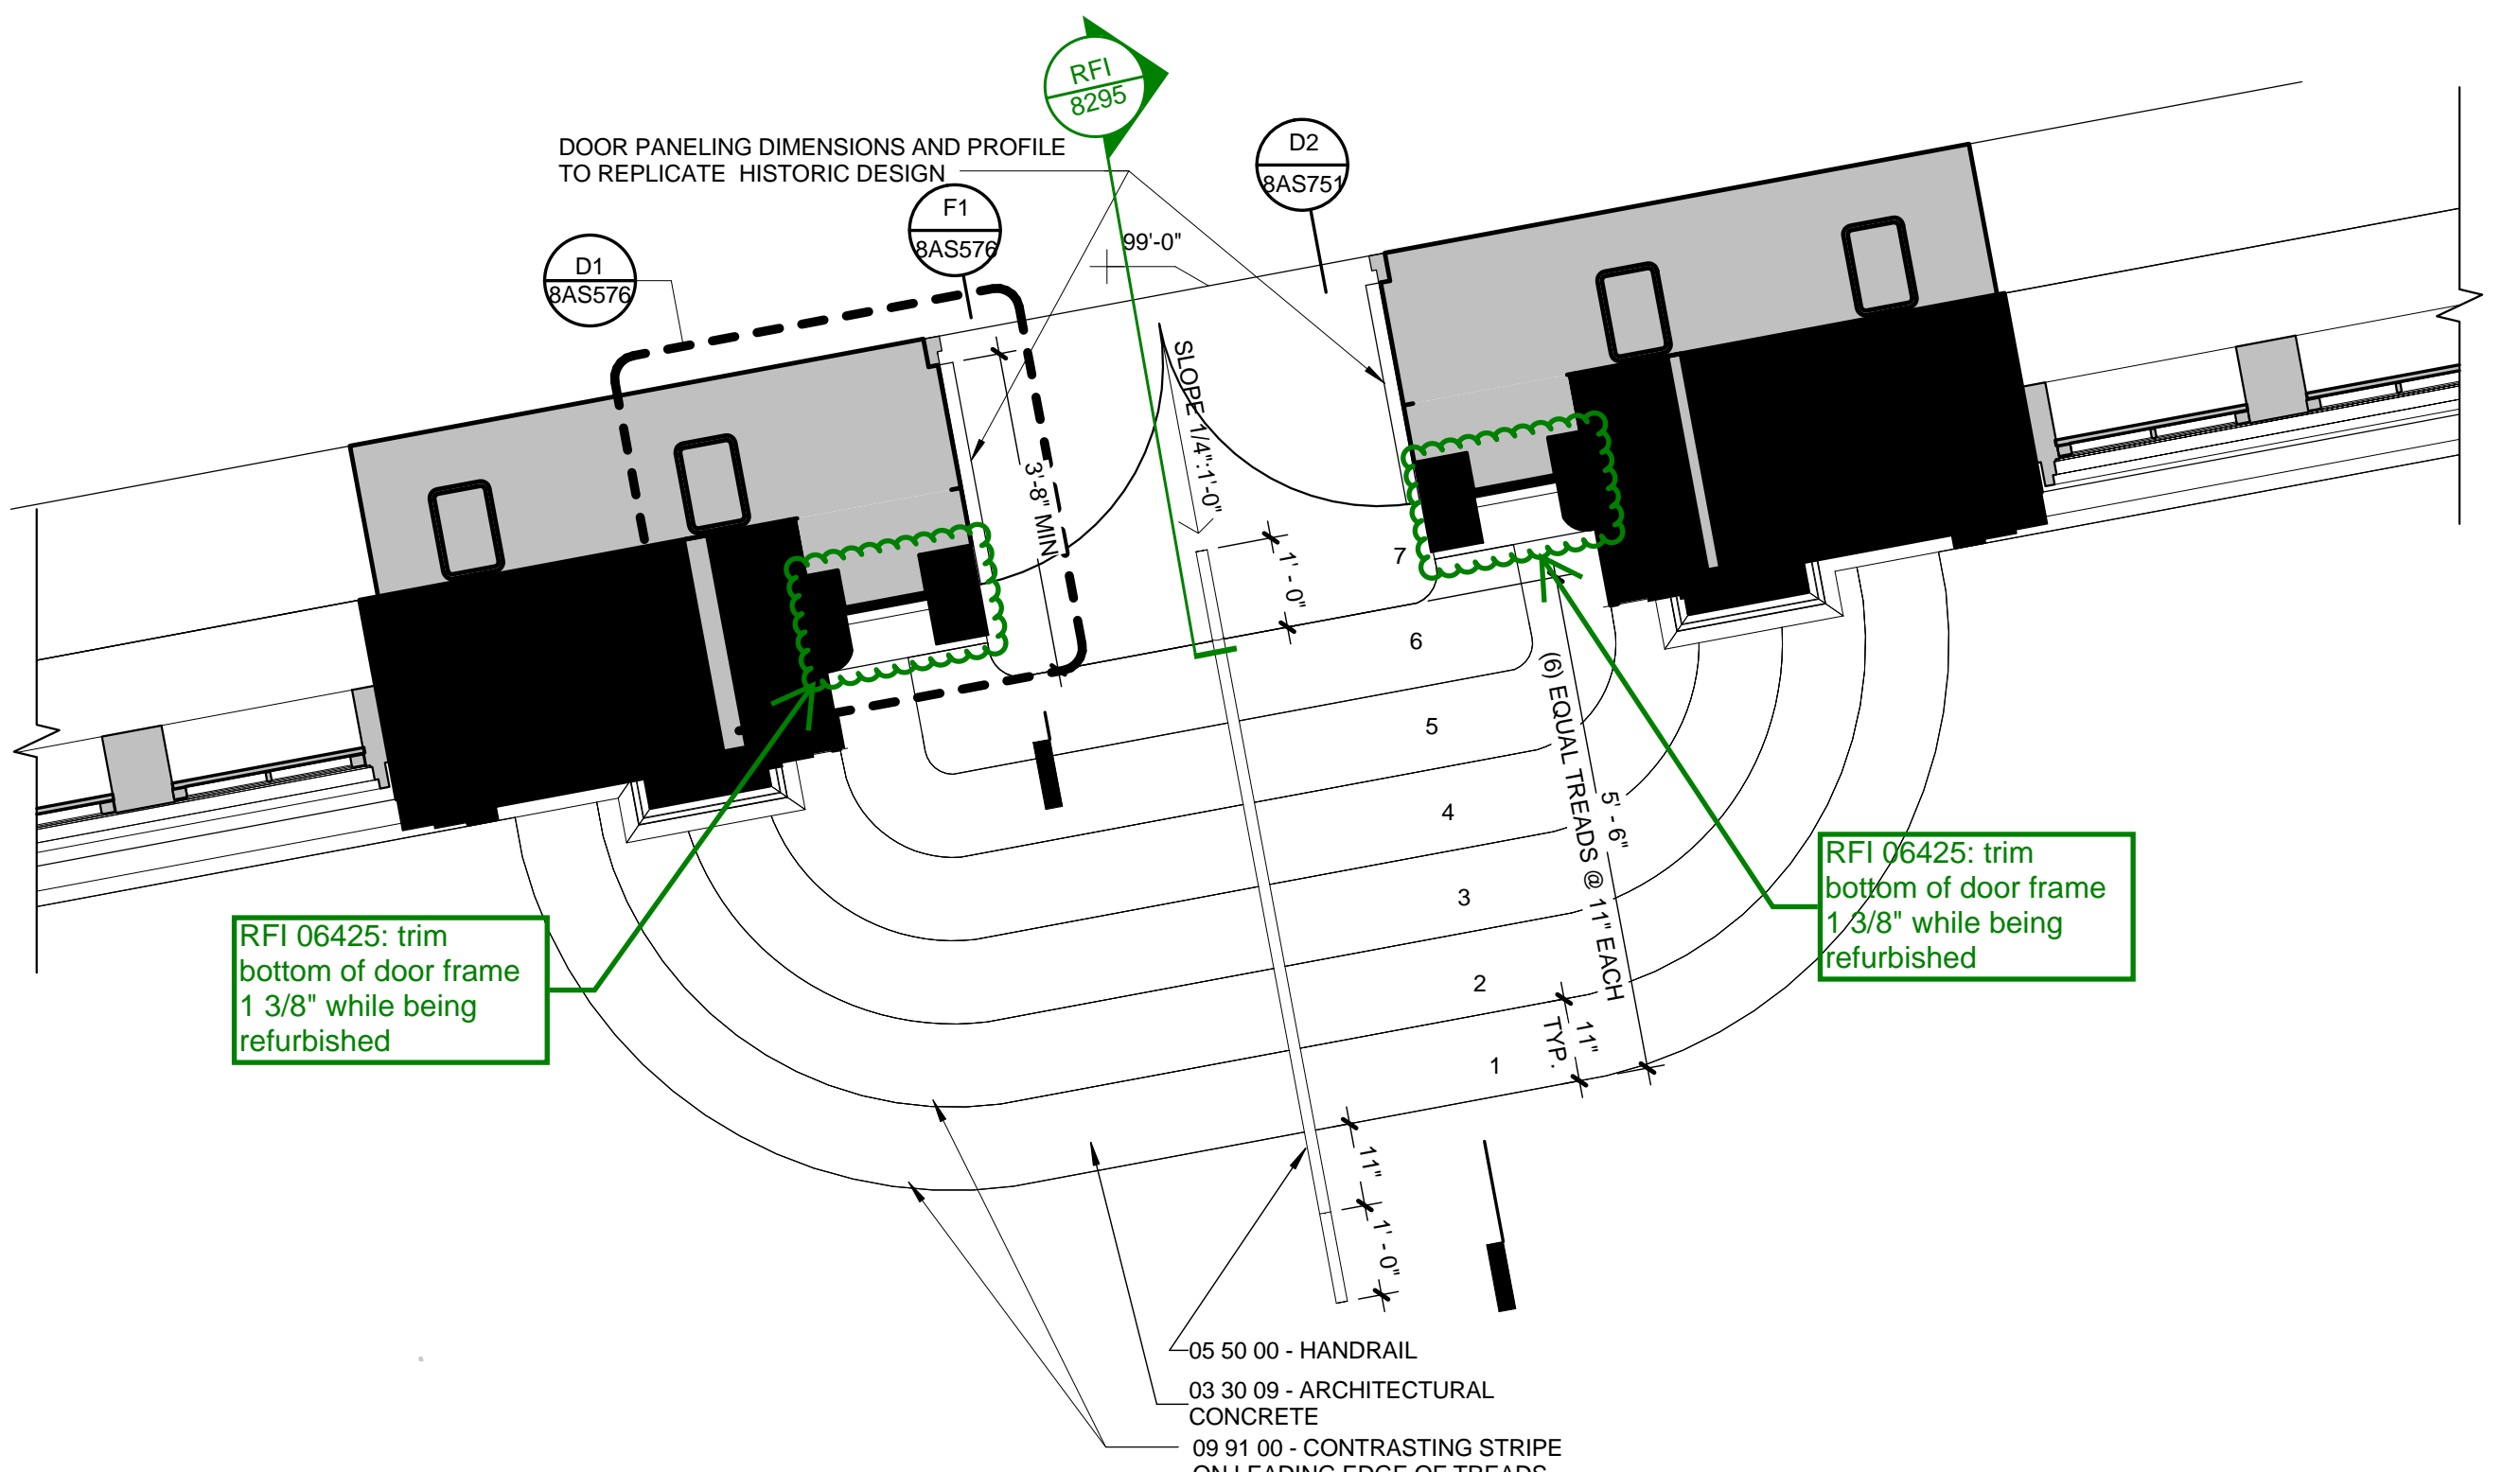

F2 PLAN OF EXTERIOR DIXIE STAIR AT TULANE AVE.
SCALE: 1/2\"/>

		CONSULTANTS: DESMAN ASSOCIATES / PARKING CODE CONSULTANTS, INC / CODE CONSULTANT THE SEXTANT GROUP / AV & ACOUSTICAL HAMMER DESIGN ASSOCIATES / FOOD SERVICE PYBURN & ODOM / ABATEMENT TATA & HOWARD / TANK CONSULTANT I.S.C. GROUP, INC / IRRIGATION DAN EUSER WATER ARCHITECTURE, INC / WATER FEATURE
REVISIONS:	DATE	

ARCHITECT/ENGINEERS:
studio **NOVA**
SCHRENK & PETERSON CONSULTING ENGINEERS / CIVIL
KORDA/NEMETH ENGINEERING / STRUCTURAL
BR+A CONSULTING ENGINEERS / MECH & ELEC
ARCHITECTURAL ENGINEERING / PLUMBING
SCALES ASSOCIATES / FIRE PROTECTION
COMMUNICATIONS DESIGN GROUP / LOW VOLTAGE

DRAWING TITLE
BLDG 8 DIXIE STAIR DETAILS

APPROVED: PROJECT DIRECTOR

PROJECT TITLE
SLV/HCS REPLACEMENT MEDICAL
CENTER PROJECT

LOCATION
NEW ORLEANS, LOUISIANA

DATE
July 16, 2012

CHECKED
CD

DRAWN
AM

PROJECT NUMBER
629-HS2-401
BUILDING NUMBER
8

DOCUMENT SET PACKAGE
WP_9B

DRAWING NUMBER
8AS751

CONSTRUCTION DOCUMENTS 1
FULLY SPRINKLERED

**OFFICE OF
CONSTRUCTION
AND FACILITIES
MANAGEMENT**

 Department of
Veterans Affairs