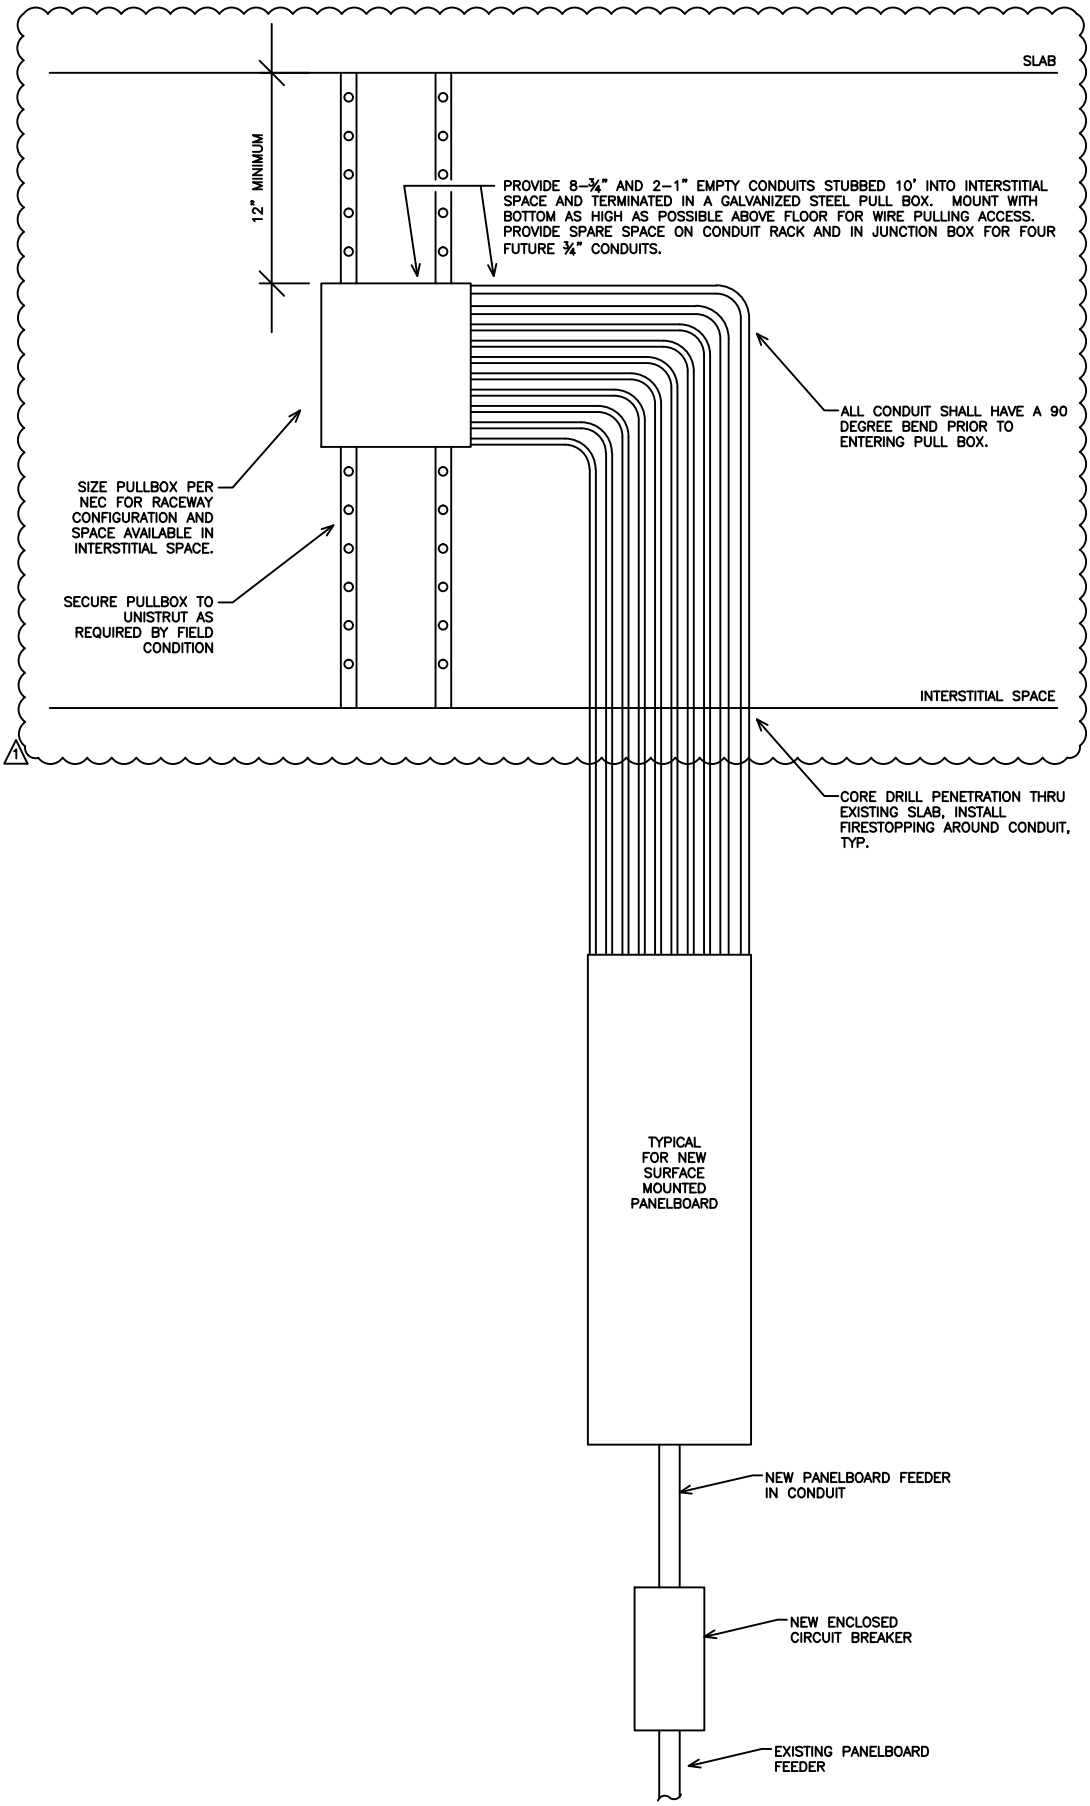

NOTE

A. SEE FLOOR PLANS FOR EXACT LOCATIONS AND CONFIGURATIONS

1 B. NO SPICES SHALL BE MADE INSIDE PULL BOX INDICATED ABOVE.

ELECTRICAL ROOM FLOOR