



Work is to be performed in this area.

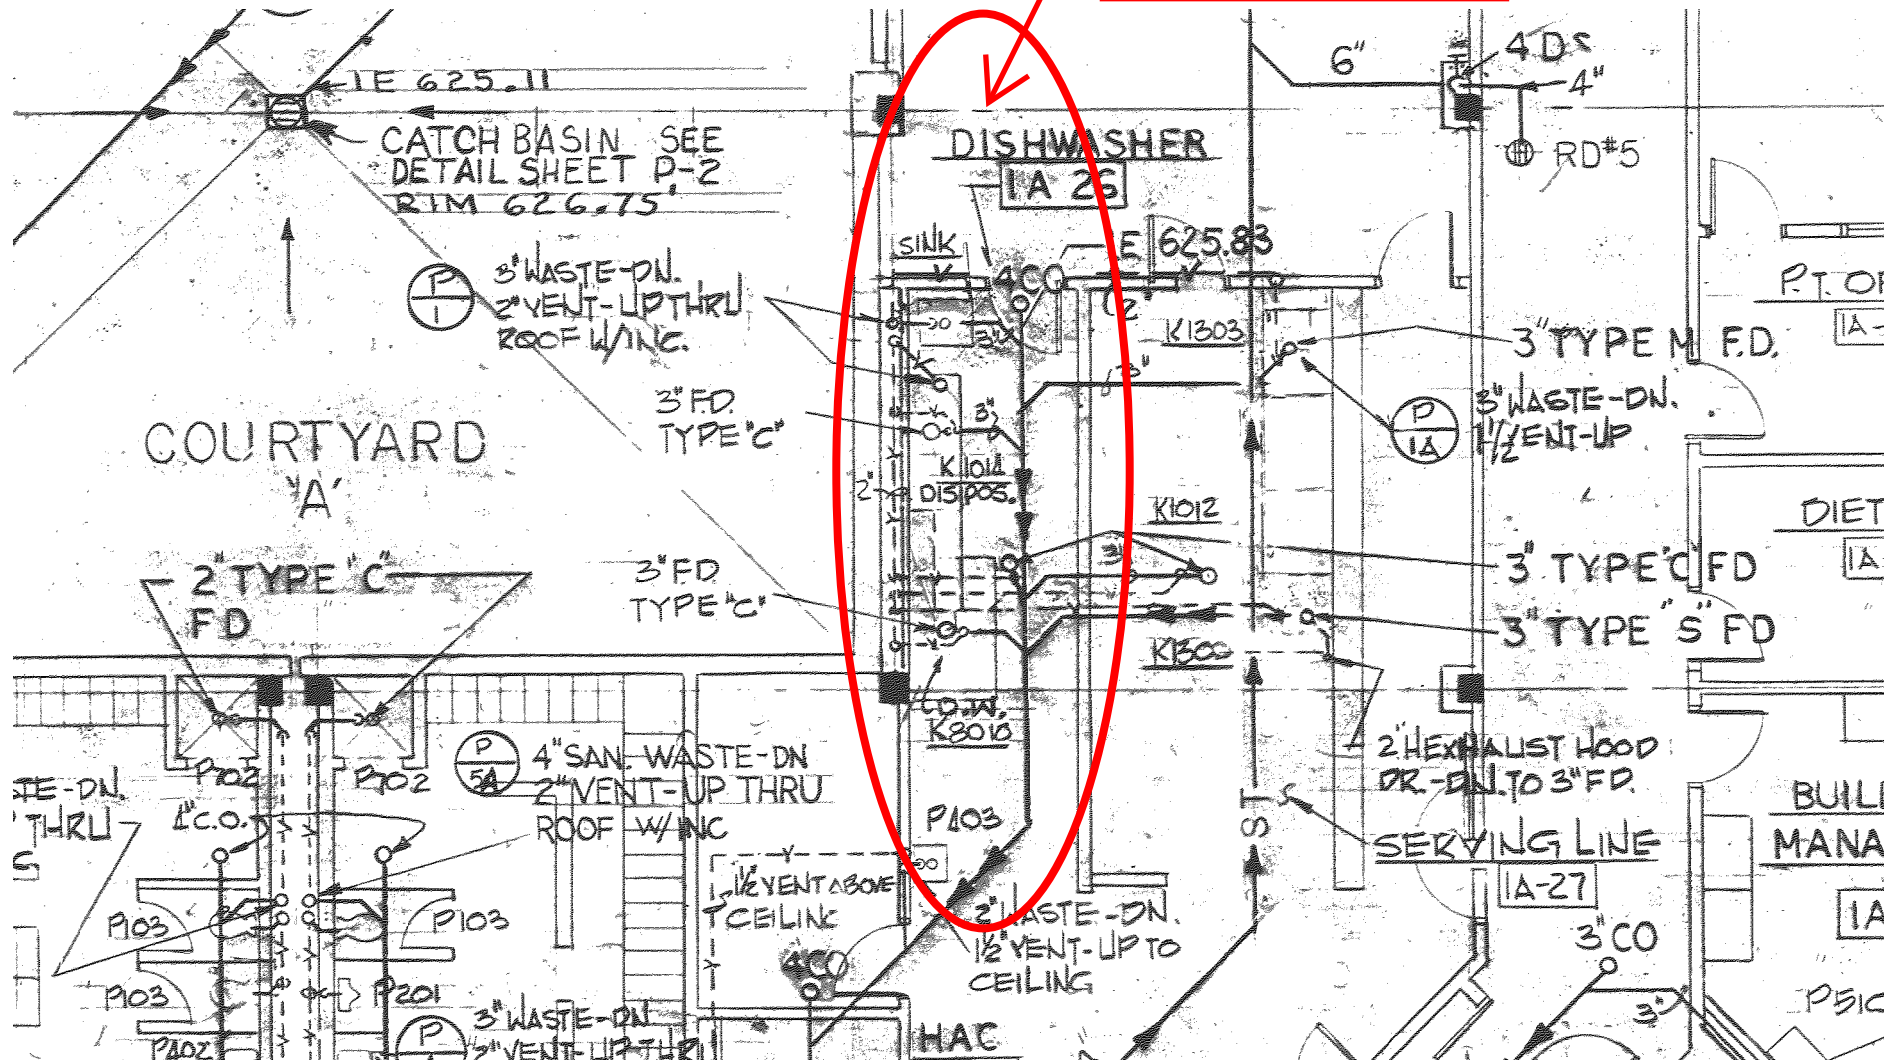

578-16-036 Install Grease Interceptor in Kitchen of Building 217

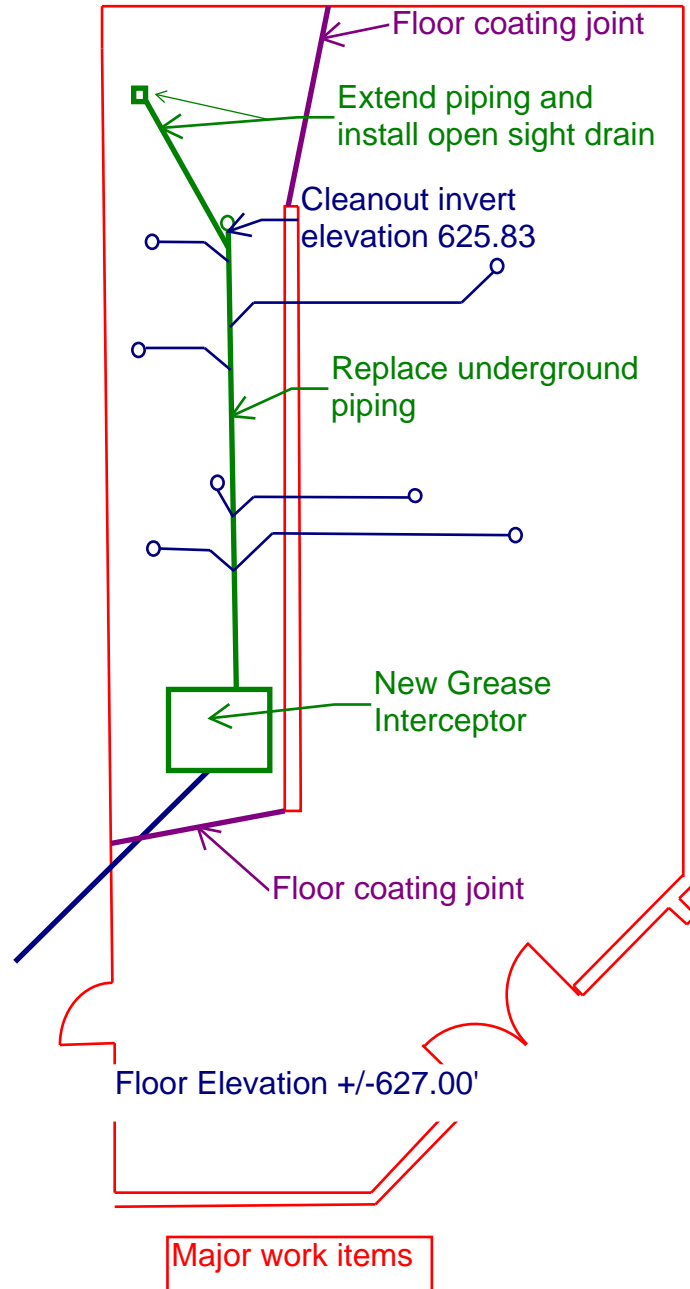



578-16-036 Install Grease Interceptor in Kitchen of Building 217