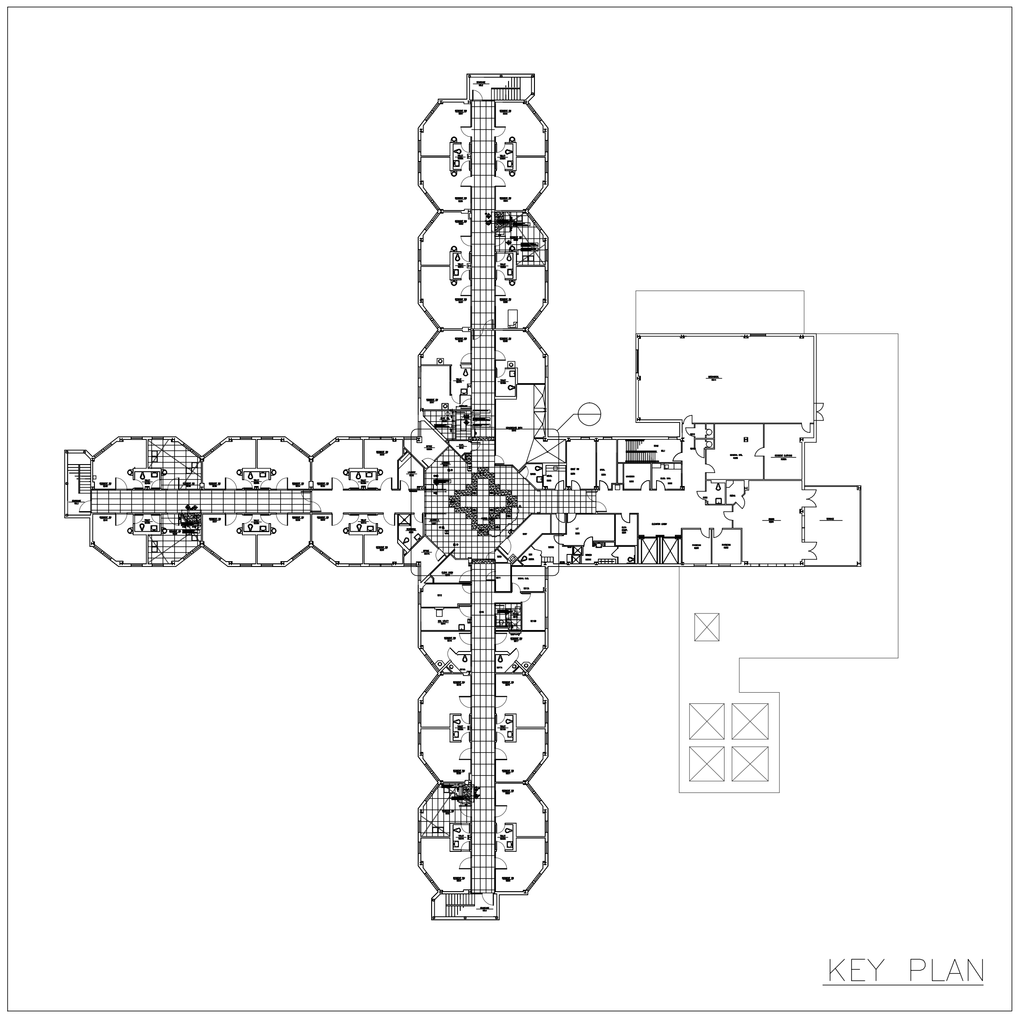

KEY PLAN

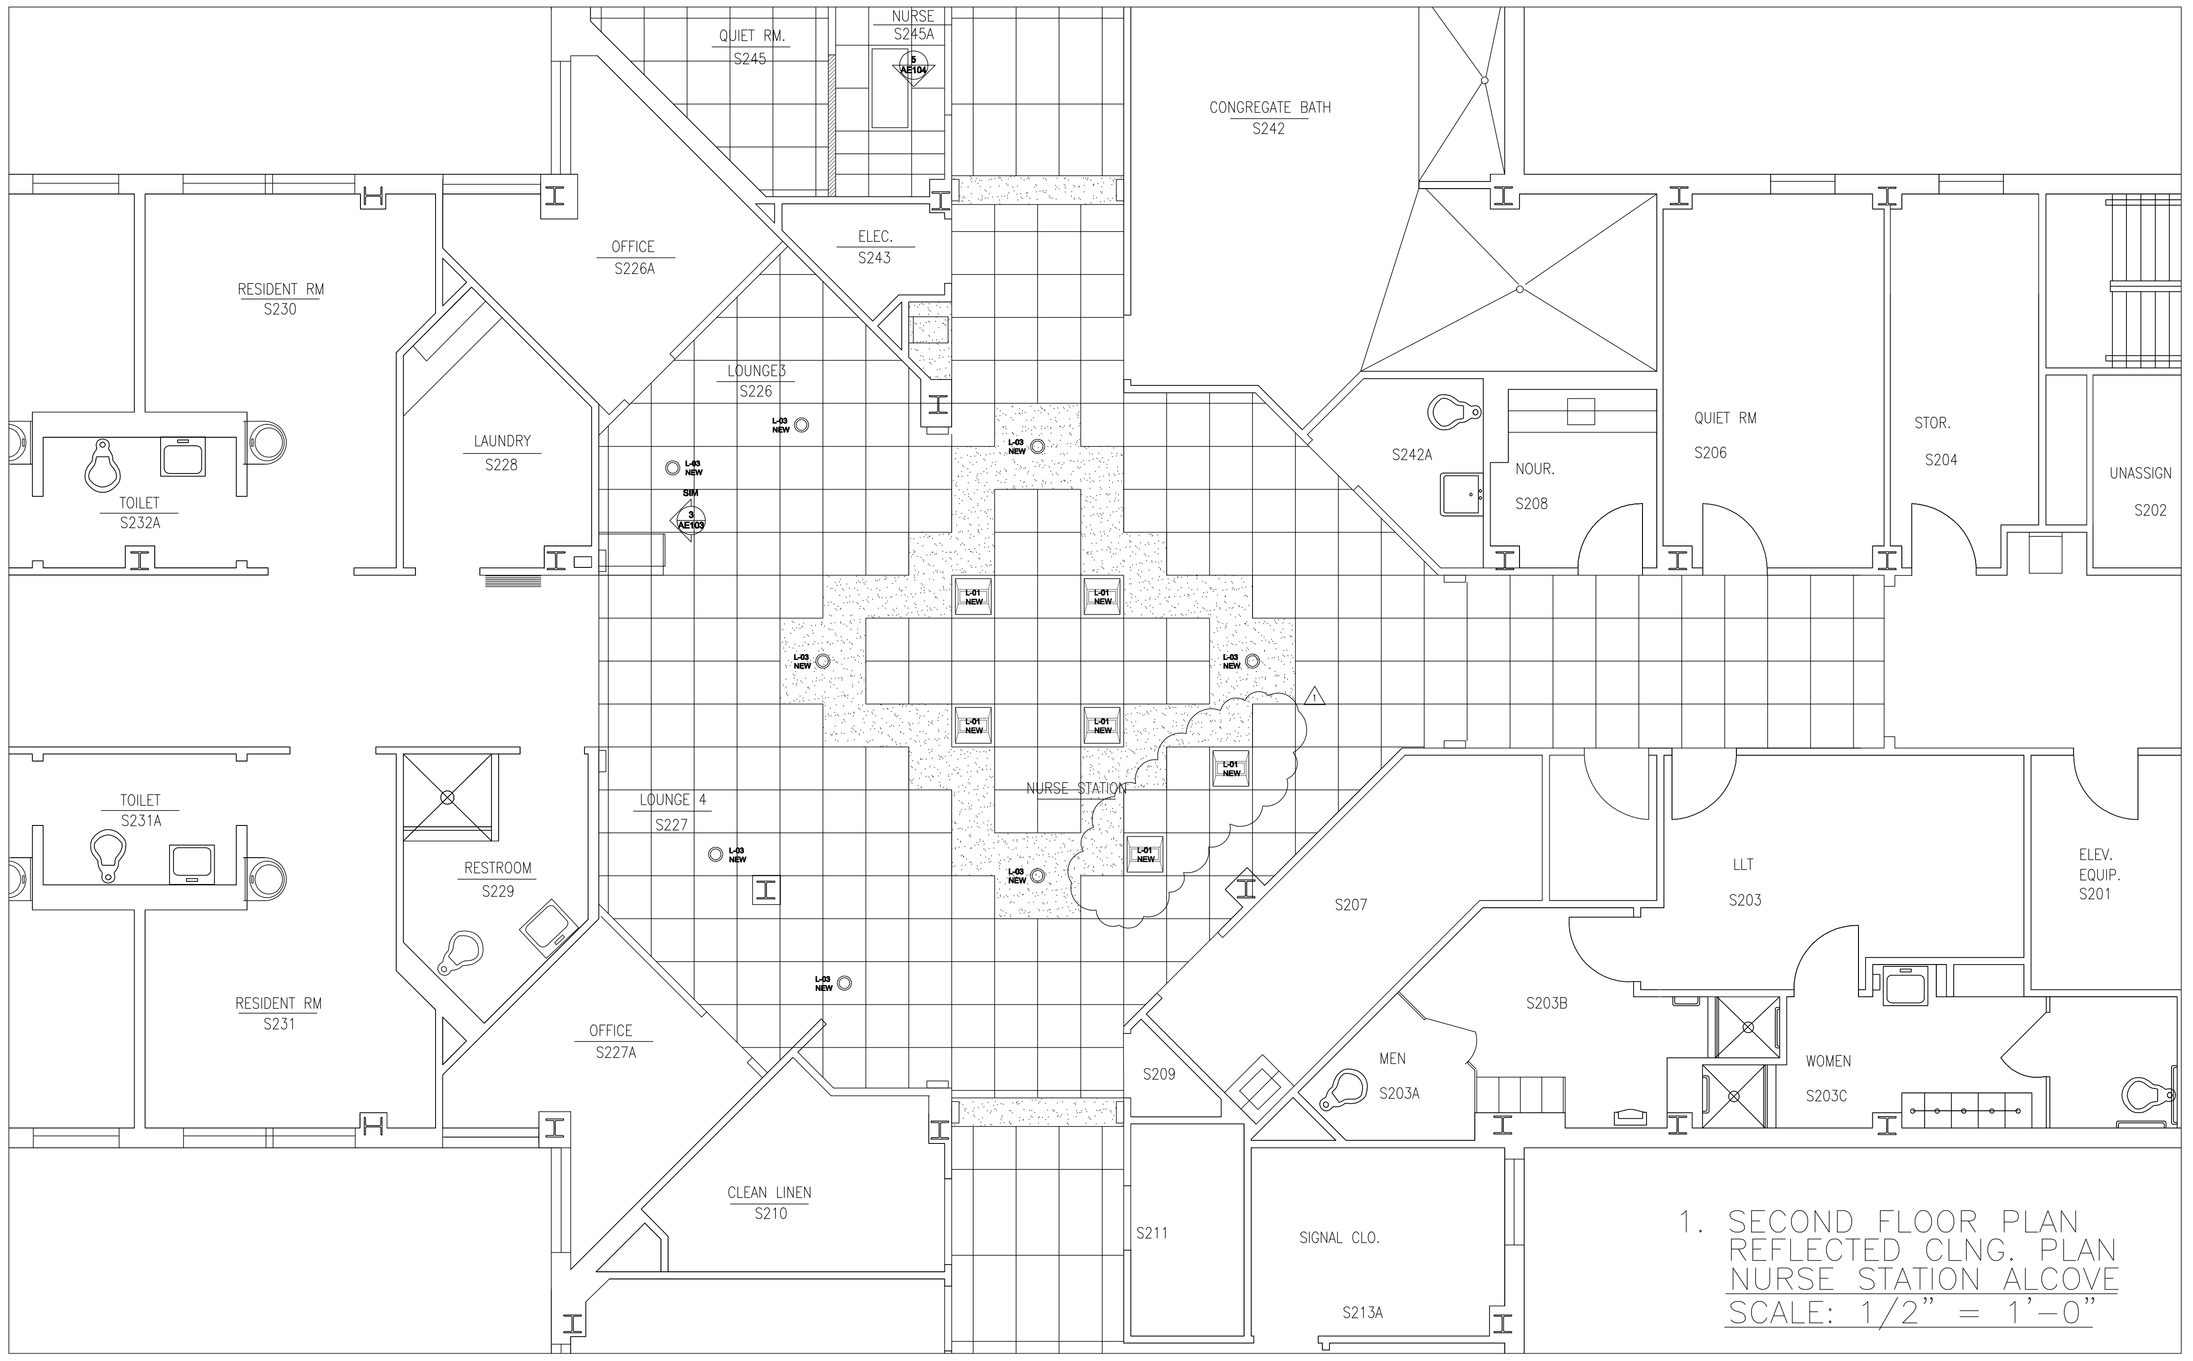

1. SECOND FLOOR PLAN
REFLECTED CLNG. PLAN
NURSE STATION ALCOVE
SCALE: 1/2" = 1'-0"

CEILING SYMBOL LEGEND

SYMBOL	DESCRIPTION
	L-01: NEW 2'x2' – RECESSED FLUORESCENT LIGHT FIXTURE, DIRECT/INDIRECT F32T8 LAMPS
	L-02: NEW 2'x4' – RECESSED FLUORESCENT LIGHT FIXTURE, PARABOLIC LOUVER F32T8 LAMPS
	L-03: NEW 6" RECESSED COMPACT FLUORESCENT DOWNLIGHT. COMPACT FLUORESCENT LAMPS
	L-04: NOT USED
	L-05: NOT USED
	L-06: NOT USED

SCHEMATIC DESIGN - NOT FOR CONSTRUCTION

Revisions:	Date
1 100% CONSTRUCTION DOCUMENTS	15 AUGUST 2011
VAMC -- 95% REVIEW	02 AUGUST 2011

ARCHITECT/ENGINEERS:

GURLITZ ARCHITECTURAL

5310 South Alston Ave
Durham, NC 27713
919.489.9000 phone
919.493.8937 fax
gurlitzarchitects.com

Professional Stamp/Seal: NATHAN HARMS REGISTERED ARCHITECT AGRICULTURE COMMERCE No. 107396 STATE OF TENNESSEE

Drawing Title: SECOND FLOOR REFLECTED CEILING PLAN

Approved Project Director

Project Title: James H. Quillen - VA Medical Center
Building 162 - Renovation

Location: Mountain Home, TN

Date: 15 AUG 2011 | Checked: NMH

Project Number: 621-11-140

Building Number: Building 162

Drawing Number: AE-102
Dwg. 4 of 8

Office of Construction and Facilities Management

Department of Veterans Affairs

VA FORM 08-6231