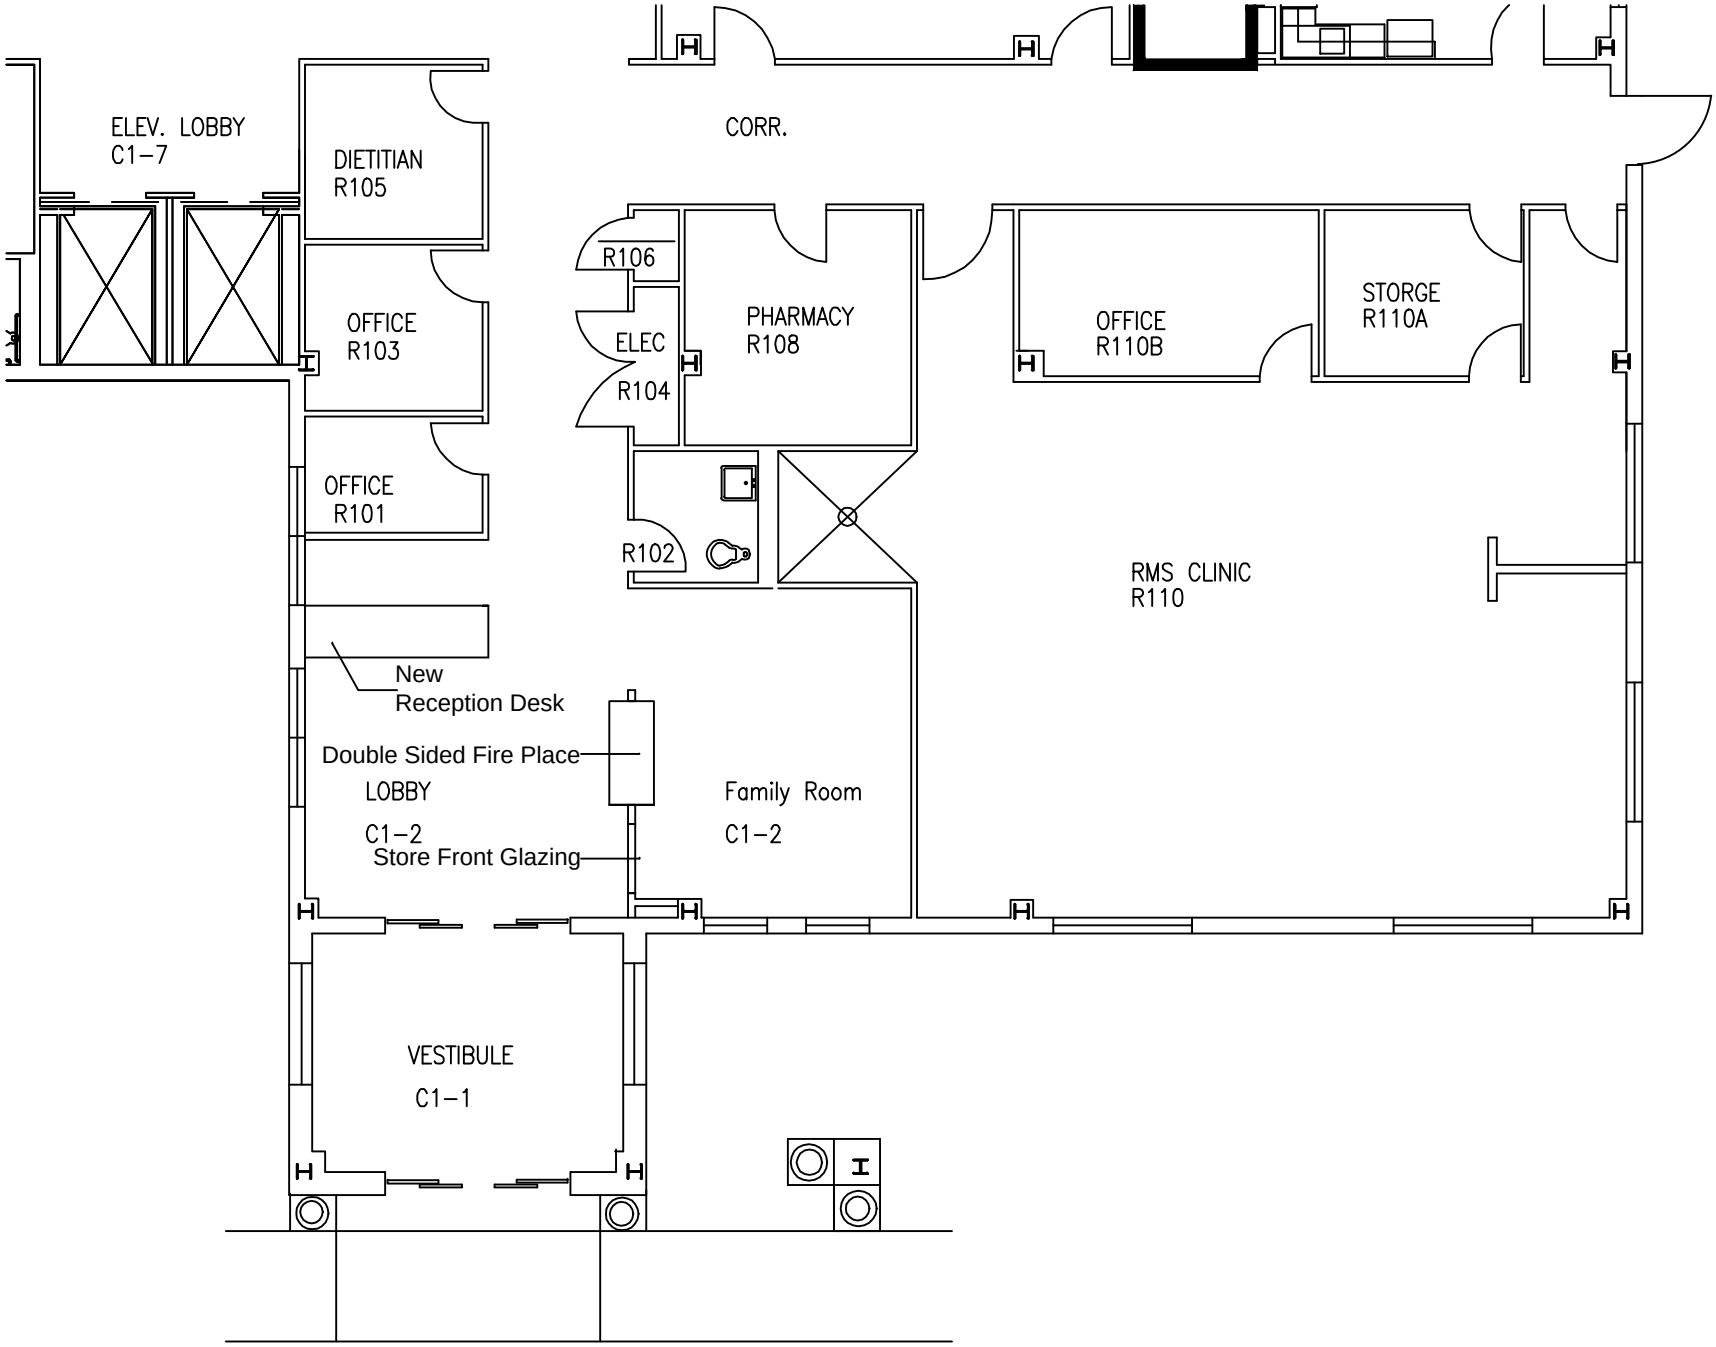
ELEV. LOBBY
C1-7
DIETITIAN
R105
CORR.
OFFICE
R103
R106
ELEC
R104
PHARMACY
R108
OFFICE
R110B
STORGE
R110A
OFFICE
R101
R102
RMS CLINIC
R110
New
Reception Desk
Double Sided Fire Place
LOBBY
C1-2
Store Front Glazing
Family Room
C1-2
VESTIBULE
C1-1