

one eighth inch = one foot  
one quarter inch = one foot  
one eighth inch = one foot  
three eighths inch = one foot  
one half inch = one foot  
three quarters inch = one foot  
one inch = one foot  
one and one half inches = one foot  
two inches = one foot  
three inches = one foot

6-23-17 11:55:39 AM dcastilloj

No.	Revision	Date
1	ADDENDUM No. 01	06/22/17

CONSULTANTS:

TTG

222 South Harbor Boulevard, Suite 800  
Anaheim, California 92805  
Phone: 714.490.5555 Fax: 714.490.5560  
www.ttgcorp.com

• STRUCTURAL  
• MECHANICAL  
• ELECTRICAL  
• CIVIL

No. 22542  
Exp. 12/31/17  
REGISTERED PROFESSIONAL  
MECHANICAL  
STATE OF CALIFORNIA

LICENSED ARCHITECT  
CHARLES M. EYBERG  
NO. C-18699  
REN. 02-28-17  
STATE OF CALIFORNIA

ARCHITECT/ENGINEERS:

HMC ARCHITECTS

3546 CONCOURS STREET  
ONTARIO, CALIFORNIA 91764  
Telephone: 909.989.9979  
Fax: 909.980.8558  
www.hmcarchitects.com

HMC Project #2269071-000

Drawing Title

THIRD FLOOR MECHANICAL  
DEMOLITION PLAN  
AREA O

Approved Project Director

Project Title

Canteen Services (2nd Floor)  
Ventilation Upgrade

Location

VA LOMA LINDA HEALTHCARE SYSTEM  
11201 BENTON STREET  
LOMA LINDA, CALIFORNIA 92357

Date

03/30/16

Checked

A. Yuson

Drawn

S. Chen

Project Number

605-15-425

Building Number

Drawing Number

MD2.30

Drawn by


Office of Construction and Facilities Management

## SHEET NOTES

- CONTRACTOR SHALL FIELD VERIFY ALL EXISTING CONSTRUCTION RELATED CONDITIONS PRIOR TO STARTING DEMOLITION OR NEW CONSTRUCTION.
- ALL DEMOLITION AND CONSTRUCTION ACTIVITIES SHALL BE COORDINATED WITH VA PROJECT ENGINEER TO MINIMIZE DISRUPTION OF THE NORMAL DAILY FUNCTIONING OF THE BUILDING.

## DEMOLITION KEY NOTES

- REMOVE EXISTING KITCHEN HOOD EXHAUST DUCTWORK, SUPPORTS, AND ALL OTHER ACCESSORIES INSIDE THE SHAFT. SEE ARCHITECTURAL DRAWINGS FOR THE DETAIL OF SHAFT DEMOLITION.
- PORTION OF EXISTING WALL TO BE DEMOLISHED, INCLUDING ACCESS PANEL, FOR THE INSTALLATION OF NEW DUCT RISER IN SHAFT. SEE ARCHITECTURAL DRAWING NO. AD1-3 FOR THE EXTENT OF SHAFT DEMOLITION.

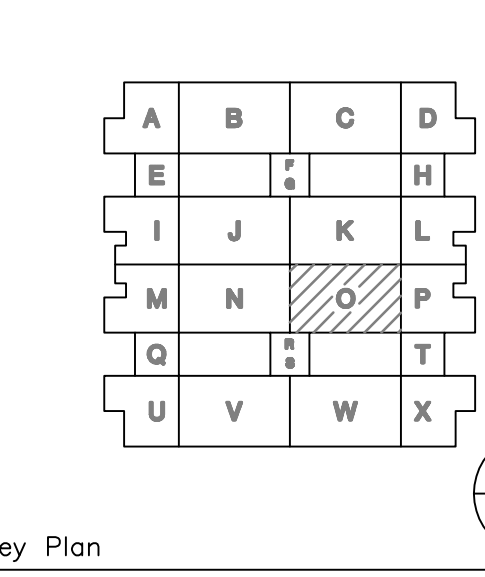

THIRD FLOOR DEMOLITION PLAN - AREA O

SCALE : 1/4"=1'-0"

1