

three inches = one foot
 one and one half inches = one foot
 one inch = one foot
 three quarters inch = one foot
 one half inch = one foot
 three eighths inch = one foot
 one quarter inch = one foot
 one eighth inch = one foot

GENERAL NOTES

- DIMENSIONS ARE TO FACE OF STUD OR CONCRETE. INTERIOR PARTITION DIMENSIONS ARE TO FACE OF STUDS, FACE OF CONCRETE, OR FACE OF MASONRY, UNLESS NOTED OTHERWISE.
- ELEVATIONS ARE TO TOP OF CONCRETE OR OTHER HARD SURFACE MATERIAL, NOT TO TOP OF FLOOR COVERING OR ROOFING.
- DO NOT SCALE DRAWINGS. USE DIMENSIONS INDICATED.
- DETAILS ARE INTENDED TO SHOW METHOD AND MANNER OF ACCOMPLISHING THE WORK. MINOR MODIFICATIONS MAY BE REQUIRED TO SUIT JOB DIMENSIONS OR CONDITIONS AND SHALL BE INCLUDED AS PART OF THE WORK.
- THE CONTRACTOR SHALL VERIFY ALL DIMENSIONS, ELEVATIONS, AND ALL EXISTING CONDITIONS AT THE SITE BEFORE COMMENCING WORK AND REPORT ANY DISCREPANCIES TO THE ARCHITECT PRIOR TO START OF WORK. IN CASE OF CONFLICT BETWEEN ARCHITECTURAL AND CONSULTANT DRAWINGS, THE ARCHITECT WILL DETERMINE THE CORRECT INTENT OF THE WORK.
- EXHAUST HOOD EQUIPMENT AND RELATED ITEMS ARE CONTRACTOR FURNISHED / CONTRACTOR INSTALLED.



LEGEND

	EXISTING FIRE WALL-1HR.		EXISTING OCCUPANCY SEPERATION-2HR.
	EXISTING FIRE WALL-2HR.		EXISTING CONSTRUCTION TO REMAIN.
	EXISTING SMOKE WALL.		EXISTING CONSTRUCTION TO BE DEMOLISHED.
			TEMPORARY CONSTRUCTION BARRIER. SEE DET. 1 AS-3
	EXISTING LIGHT FIXTURE		EXISTING LIGHT FIXTURE TO BE RELOCATED.
	RELOCATED LIGHT FIXTURE		EXISTING PENDANT LIGHT FIXTURE
	EXISTING RECESSED LIGHTING		EXISTING MECHANICAL DIFFUSER TO BE REPLACED.
	EXISTING MECHANICAL DIFFUSER		EXISTING SUSPENDED CEILING
	MECHANICAL DIFFUSER		SUSPENDED CEILING
	SHADED AREA INDICATES NOT WITHIN SCOPE OF WORK		

DEMOLITION KEYNOTES

- PROVIDE TEMPORARY CONSTRUCTION BARRIER (HEAVY DUTY PLASTIC SHEET) w/ ZIPPER ACCESS DOOR AS REQUIRED DURING CONSTRUCTION. PROVIDE NEGATIVE AIR PRESSURE w/ MONITOR DEVICE/DISPLAY. MAINTAIN BARRIER DURING CONSTRUCTION.
- PORTION OF EXISTING SHAFT WALL TO BE DEMOLISHED AS REQUIRED FOR (N) ACCESS PANEL. RESTORE LEAD SHIELDING AT SHAFT WALL. REFER TO MECHANICAL DWGS.
- EXISTING FLOOR FINISH TO REMAIN. PROTECT IN PLACE. PATCH & REPAIR ANY INCIDENTAL DAMAGES CAUSED BY WORK.
- EXISTING DUCT SHAFT. PROVIDE EXHAUST DUCT FROM LOWER FLOOR TO ROOF. SEE DET. 5 AS-7 REFER TO MECHANICAL DWGS.
- EXISTING ELECTRICAL PANEL. PROTECT IN PLACE.
- EXISTING DOOR TO BE TEMPORARILY REMOVED AND PLACED IN PROTECTIVE STORAGE. DOOR TO BE REINSTALLED AFTER WORK IS COMPLETED.
- PROVIDE DOOR TO BE USED AS TEMPORARY CONSTRUCTION BARRIER.


KEY PLAN

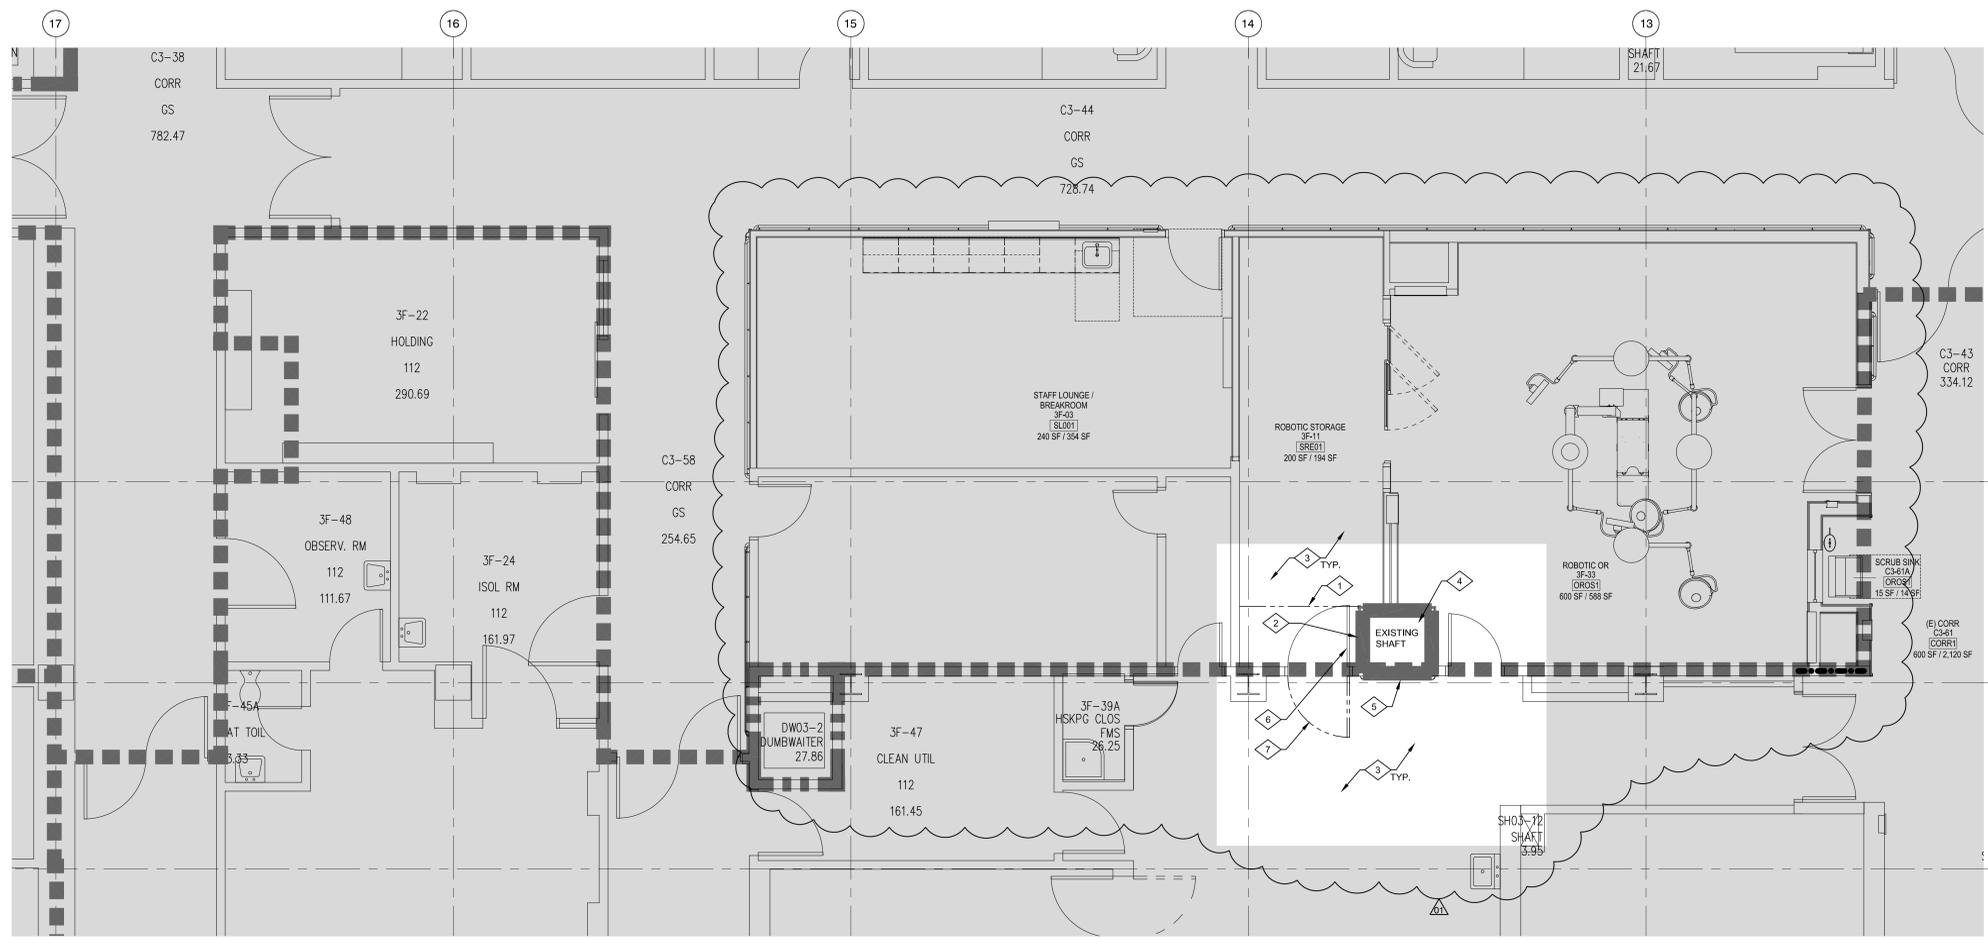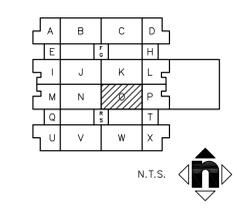

ENLARGED 3RD FLOOR DEMOLITION PLAN 1

No.	Revision	Date
1	ADDENDUM No. 01	06/22/17

CONSULTANTS:

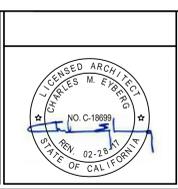

ARCHITECT/ENGINEERS:

HMC ARCHITECTS
 3546 CONCOURS STREET
 ONTARIO, CALIFORNIA 91764
 Telephone: 909.989.9979
 Fax: 909.980.8558
 www.hmcarchitects.com

HMC Project #2269071-000

Drawing Title
 ENLARGED 3RD FLOOR DEMOLITION PLAN

Approved Project Director

Project Title
 Canteen Services (2nd Floor) Ventilation Upgrade

Location
 VA LOMA LINDA HEALTHCARE SYSTEM
 11201 BENTON STREET
 LOMA LINDA, CALIFORNIA 92357

Date
 03/30/16

Checked
 A. Villa

Drawn
 A. Villa

Project Number
 605-15-425


Building Number

Drawing Number
AD1-3

Dwg. of

Office of Construction and Facilities Management

Department of Veterans Affairs

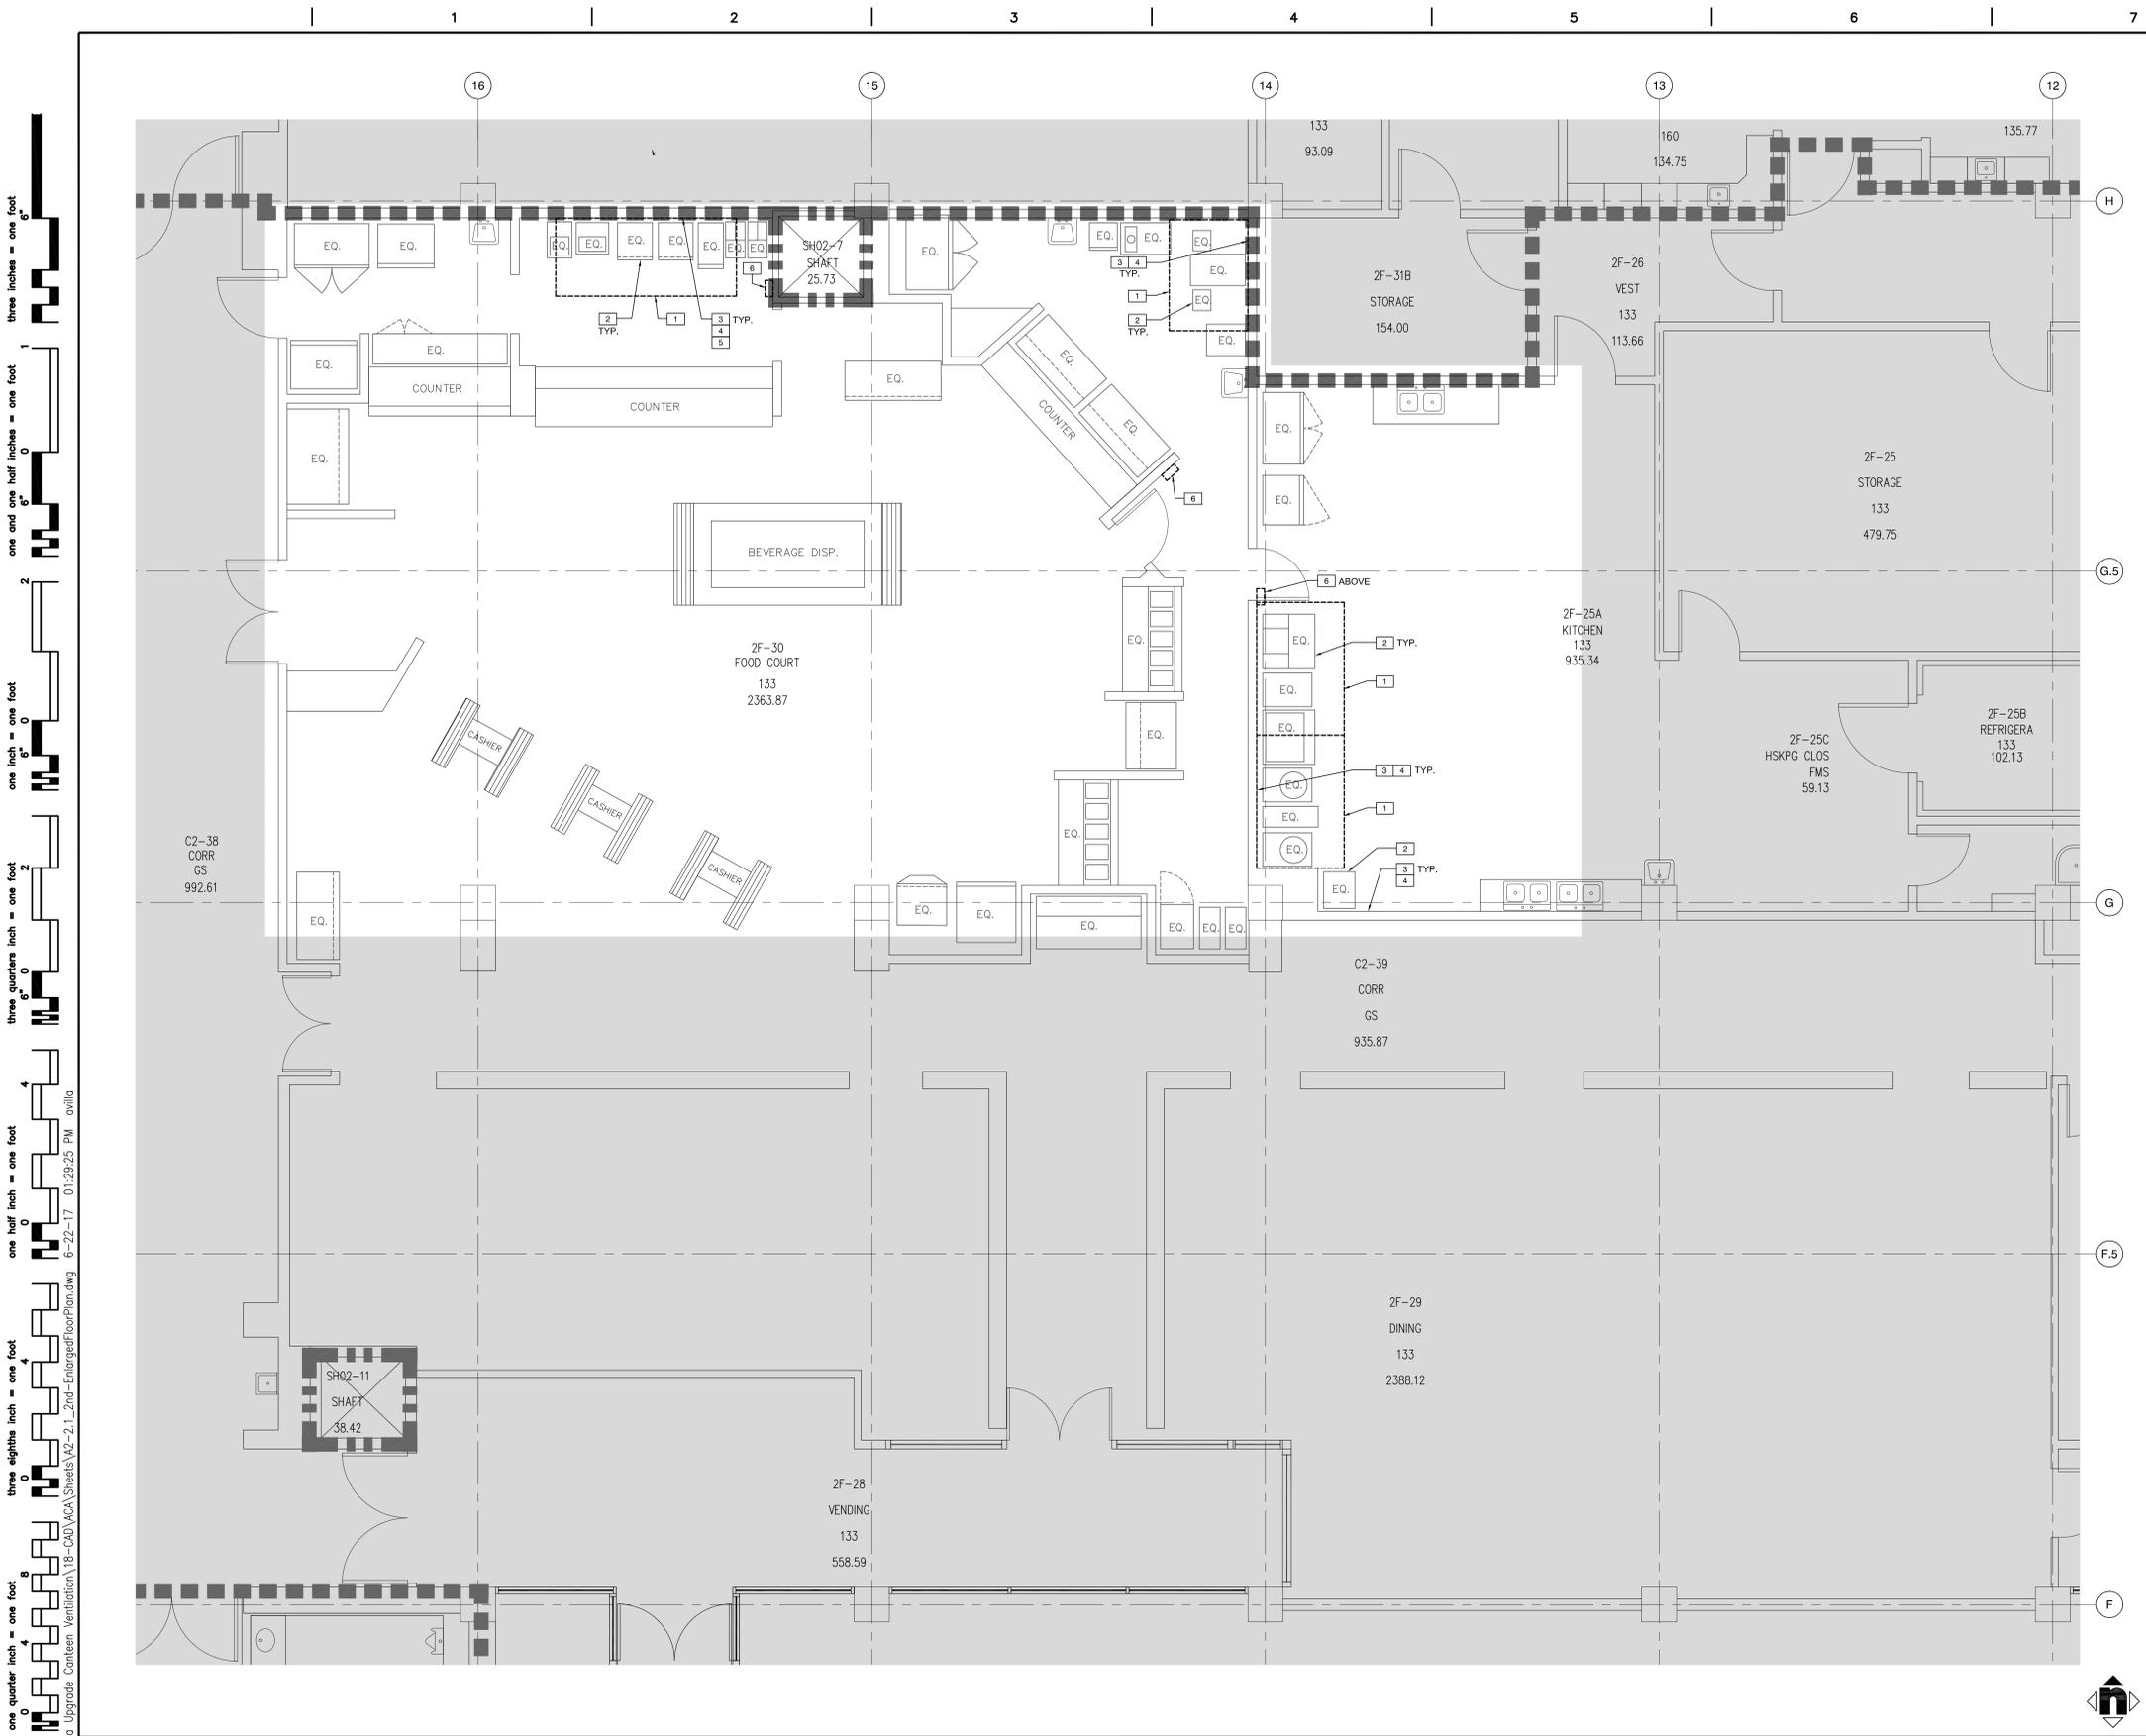

GENERAL NOTES

- DIMENSIONS ARE TO FACE OF STUD OR CONCRETE. INTERIOR PARTITION DIMENSIONS ARE TO FACE OF STUDS, FACE OF CONCRETE, OR FACE OF MASONRY, UNLESS NOTED OTHERWISE.
- ELEVATIONS ARE TO TOP OF CONCRETE OR OTHER HARD SURFACE MATERIAL, NOT TO TOP OF FLOOR COVERING OR ROOFING.
- DO NOT SCALE DRAWINGS. USE DIMENSIONS INDICATED.
- DETAILS ARE INTENDED TO SHOW METHOD AND MANNER OF ACCOMPLISHING THE WORK. MINOR MODIFICATIONS MAY BE REQUIRED TO SUIT JOB DIMENSIONS OR CONDITIONS AND SHALL BE INCLUDED AS PART OF THE WORK.
- THE CONTRACTOR SHALL VERIFY ALL DIMENSIONS, ELEVATIONS, AND ALL EXISTING CONDITIONS AT THE SITE BEFORE COMMENCING WORK AND REPORT ANY DISCREPANCIES TO THE ARCHITECT PRIOR TO START OF WORK. IN CASE OF CONFLICT BETWEEN ARCHITECTURAL AND CONSULTANT DRAWINGS, THE ARCHITECT WILL DETERMINE THE CORRECT INTENT OF THE WORK.
- FIRE STOPPING AT CONCRETE FLOOR/DECK.
 - PROVIDE FIRE STOP ASSEMBLY PER UL LISTING HNLJ-V-34 AT DUCT FLOOR/DECK PENETRATION.
- ALL DEMOLITION AND WORK THAT WILL CREATE EXCESSIVE NOISE SHALL BE PERFORMED AFTER HOURS. NOISE SHALL BE MINIMIZED TO THE LEAST POSSIBLE.


LEGEND

- EXISTING FIRE WALL-1HR
- EXISTING FIRE WALL-2HR
- EXISTING SMOKE WALL
- EXISTING OCCUPANCY SEPERATION-2HR
- EXISTING CONSTRUCTION TO REMAIN.
- EXISTING CONSTRUCTION TO BE DEMOLISHED.
- EXISTING CONSTRUCTION TO REMAIN.
- EXISTING CONSTRUCTION TO BE DEMOLISHED.
- SHADED AREA INDICATES NOT WITHIN SCOPE OF WORK
- EXISTING 2X4 LIGHT FIXTURE
- EXISTING RECESSED LIGHTING
- EXISTING PENDANT LIGHT FIXTURE
- EXISTING MECHANICAL DIFFUSER

REMODEL KEYNOTES

- EXHAUST HOOD ABOVE (CONTRACTOR FURNISHED / CONTRACTOR INSTALLED). REFER TO MECHANICAL AND EQUIPMENT DWGS. SEE MOUNTING DET. 3
S-2
- EXISTING FOOD SERVICE EQUIPMENT.
- PATCH & REPAIR EXISTING TILE WALL FINISH TO MATCH EXISTING. COORDINATE WITH HOSPITAL FACILITIES FOR TILE COLOR MATCH.
- REPAIR, PATCH, AND PAINT WALL TO MATCH EXISTING.
- STAINLESS STEEL BACKSPASH (CONTRACTOR FURNISHED / CONTRACTOR INSTALLED), FULL HEIGHT TO BOTTOM OF EXHAUST HOOD. INSTALL OVER EXISTING TILED WALL FINISH. REFER TO EQUIPMENT DWGS.
- FIRE SUPPRESSION SYSTEM CONTROL PANEL. REFER TO PLUMBING & ELECTRICAL DWGS.

KEY PLAN

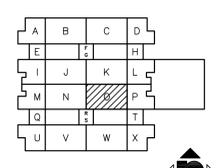

ENLARGED 2nd FLOOR PLAN
Scale: 1/4" = 1'-0"

No.	Revision	Date
1	ADDENDUM No. 01	06/22/17

CONSULTANTS:

ARCHITECT/ENGINEERS:

HMC ARCHITECTS
 3546 CONCOURS STREET
 ONTARIO, CALIFORNIA 91764
 Telephone: 909.989.9979
 Fax: 909.980.8558
 www.hmcarchitects.com

HMC Project #2269071-000

Drawing Title
ENLARGED 2ND FLOOR PLAN

Approved Project Director

Project Title
Canteen Services (2nd Floor)
Ventilation Upgrade

Project Number
605-15-425

Building Number

Location
VA LOMA LINDA HEALTHCARE SYSTEM
11201 BENTON STREET
LOMA LINDA, CALIFORNIA 92357

Date
03/30/16

Checked
A. Villa

Drawn
A. Villa

Drawing Number
A2-2.1
Dwg. of

Office of
Construction
and Facilities
Management


Department of
Veterans Affairs

three inches = one foot
 one and one half inches = one foot
 one inch = one foot
 three quarters inch = one foot
 one half inch = one foot
 three eighths inch = one foot
 one quarter inch = one foot
 one eighth inch = one foot

GENERAL NOTES

- DIMENSIONS ARE TO FACE OF STUD OR CONCRETE. INTERIOR PARTITION DIMENSIONS ARE TO FACE OF STUDS, FACE OF CONCRETE, OR FACE OF MASONRY, UNLESS NOTED OTHERWISE.
- ELEVATIONS ARE TO TOP OF CONCRETE OR OTHER HARD SURFACE MATERIAL, NOT TO TOP OF FLOOR COVERING OR FLOORING.
- DO NOT SCALE DRAWINGS. USE DIMENSIONS INDICATED.
- DETAILS ARE INTENDED TO SHOW METHOD AND MANNER OF ACCOMPLISHING THE WORK. MINOR MODIFICATIONS MAY BE REQUIRED TO SUIT JOB DIMENSIONS OR CONDITIONS AND SHALL BE INCLUDED AS PART OF THE WORK.
- THE CONTRACTOR SHALL VERIFY ALL DIMENSIONS, ELEVATIONS, AND ALL EXISTING CONDITIONS AT THE SITE BEFORE COMMENCING WORK AND REPORT ANY DISCREPANCIES TO THE ARCHITECT PRIOR TO START OF WORK. IN CASE OF CONFLICT BETWEEN ARCHITECTURAL AND CONSULTANT DRAWINGS, THE ARCHITECT WILL DETERMINE THE CORRECT INTENT OF THE WORK.
- EXHAUST HOOD EQUIPMENT AND RELATED ITEMS ARE CONTRACTOR FURNISHED / CONTRACTOR INSTALLED.



LEGEND

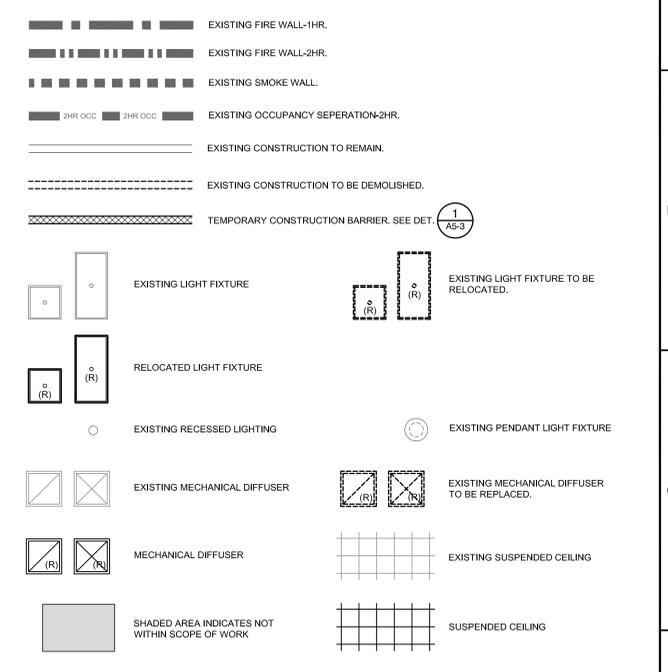

DEMOLITION KEYNOTES

- REINSTALL EXISTING DOOR & HARDWARE (TEMPORARILY REMOVED DURING DEMOLITION); CLEAN AND REPAIR ANY INCIDENTAL DAMAGES DURING CONSTRUCTION.
- PROVIDE AND INSTALL 22" x 22" MTL. ACCESS PANEL (WALL MOUNTED) AT EXISTING SHAFT ENCLOSURE. SEE DET. 8 AS-1 REFER TO MECHANICAL DWGS.
- EXISTING FLOOR FINISH TO REMAIN. PROTECT IN PLACE. PATCH & REPAIR ANY INCIDENTAL DAMAGES CAUSED BY WORK.
- EXISTING DUCT SHAFT. PROVIDE EXHAUST DUCT FROM LOWER FLOOR TO ROOF. SEE DET. 5 AS-1 REFER TO MECHANICAL DWGS.
- EXISTING ELECTRICAL PANEL. PROTECT IN PLACE.


KEY PLAN

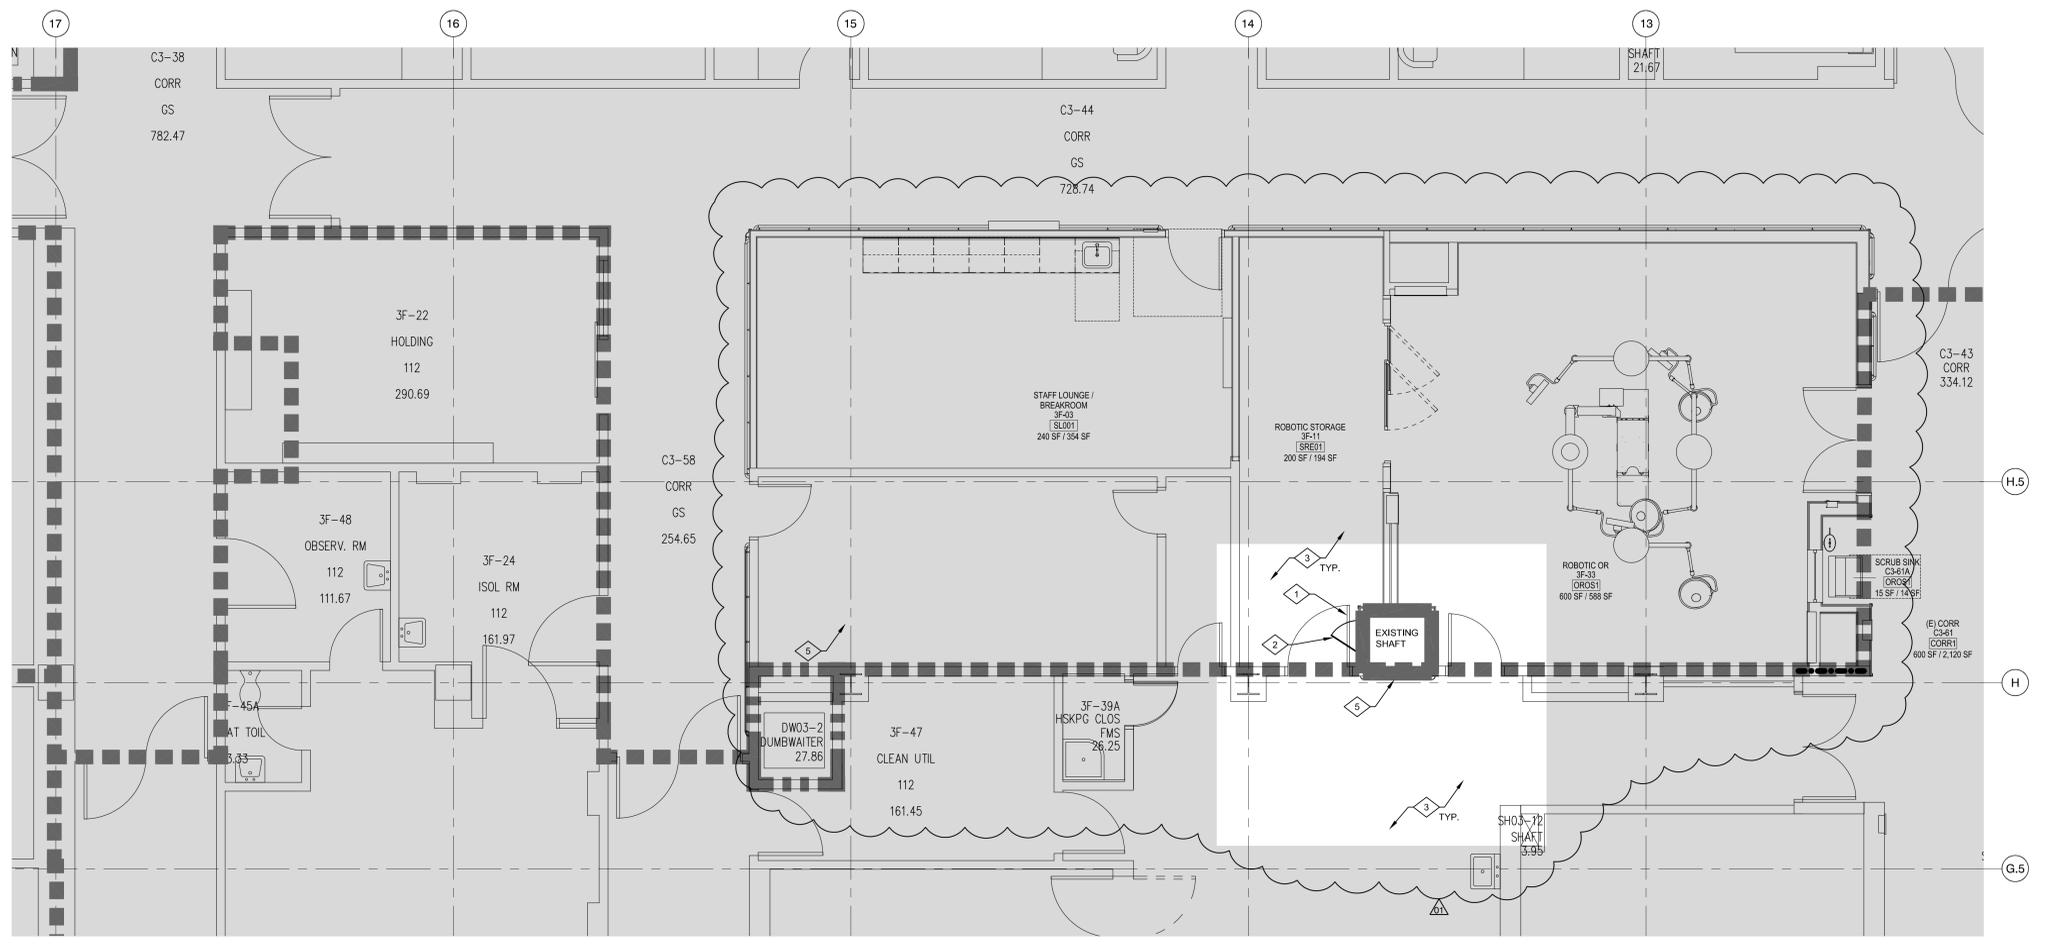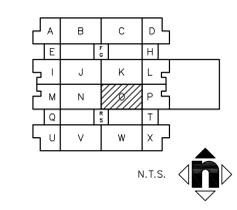

ENLARGED 3RD FLOOR PLAN 1/4" = 1'-0"

No.	Revision	Date
1	ADDENDUM No. 01	06/22/17

CONSULTANTS:

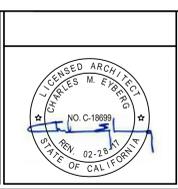

ARCHITECT/ENGINEERS:
HMC ARCHITECTS
 3546 CONCOURS STREET
 ONTARIO, CALIFORNIA 91764
 Telephone: 909.989.9979
 Fax: 909.980.8558
 www.hmcarchitects.com
 HMC Project #2269071-000

Drawing Title
 ENLARGED 3RD FLOOR PLAN
 Approved Project Director

Project Title
 Canteen Services (2nd Floor)
 Ventilation Upgrade
 Location
 VA LOMA LINDA HEALTHCARE SYSTEM
 11201 BENTON STREET
 LOMA LINDA, CALIFORNIA 92357
 Date
 03/30/16
 Checked
 A. Villa
 Drawn
 A. Villa
 Project Number
 605-15-425
 Building Number
 Drawing Number
A2-3
 Dwg. of

Office of
 Construction
 and Facilities
 Management
 Department of
 Veterans Affairs