

Low-voltage transformers

SUTRO
24900.0 V
SC 3P 3345.0 Amps
SC SLG 2385.0 Amps
X/R 3P 4.400

HOLCOMB
24900.0 V
SC 3P 4158.0 Amps
SC SLG 2385.0 Amps
X/R 3P 4.400

SUTRO F
AB CHANCE
T (Slow) Fuse Link
140A

HOLCOMB F
AB CHANCE
T (Slow) Fuse Link
140A

CBL-0001
1 - #10, 100 ft

CBL-0002
1 - #10, 100 ft
















SV-DIS
CUTLER-HAMMER
MVS


HR-DIS
CUTLER-HAMMER
MVS

(B.8) SPP-SWITCH
24900V
SCC 3P-4.206 kA

CBL-0003
1 - #10, 1 ft

SPCCO COOPER
Kyle Tri-Phase Control, VFI (OH) & SP6-Insulated
600A

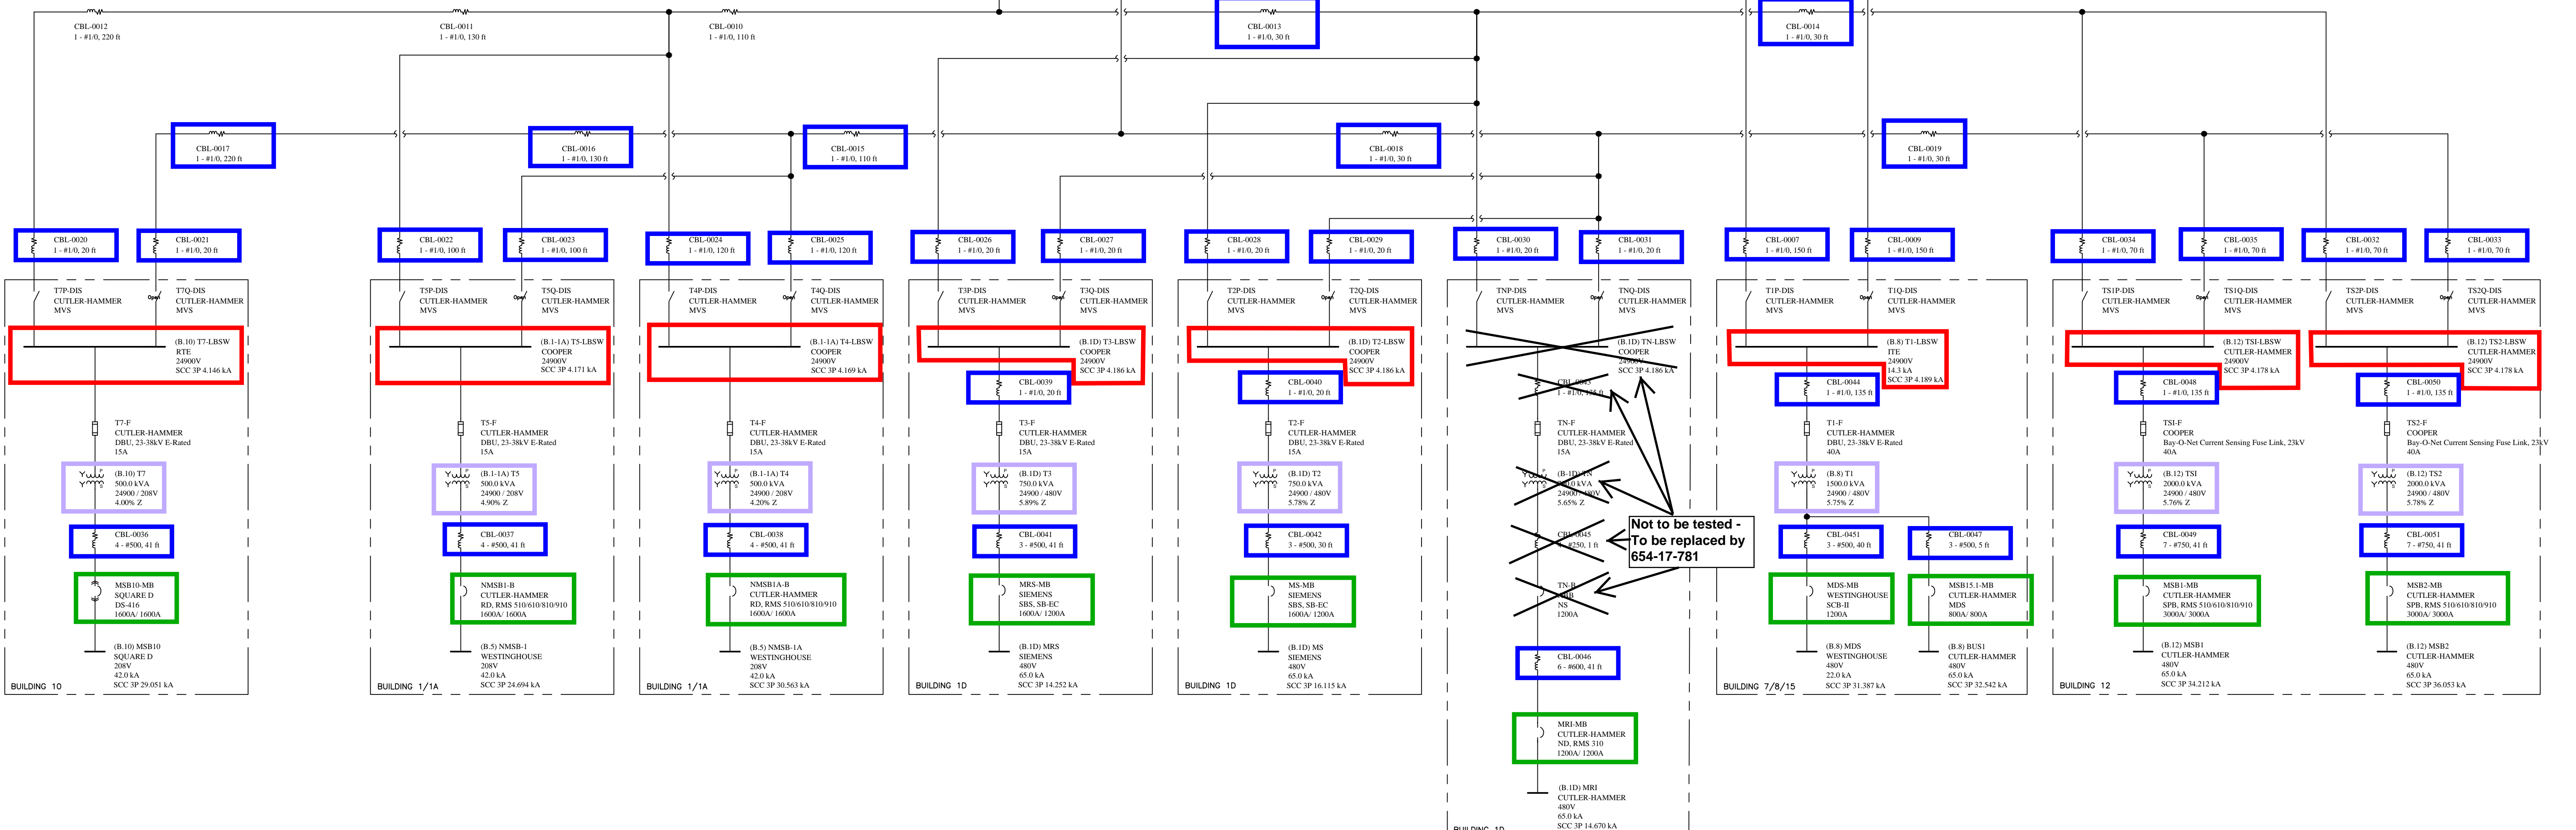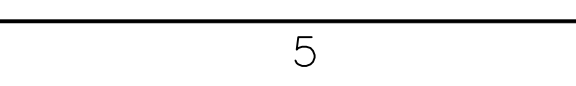 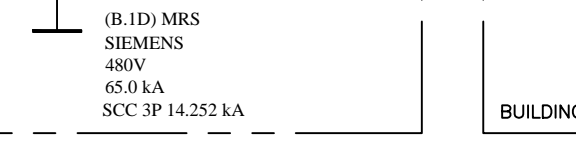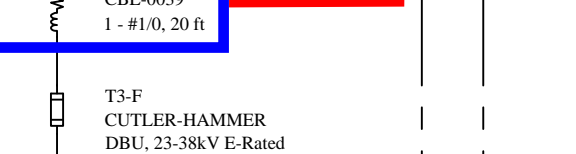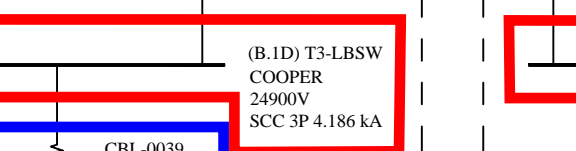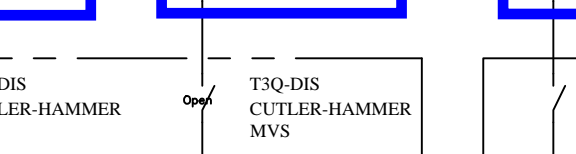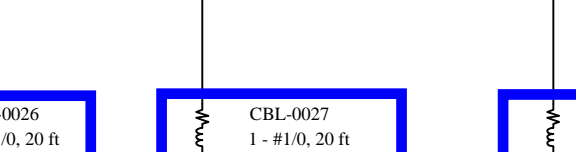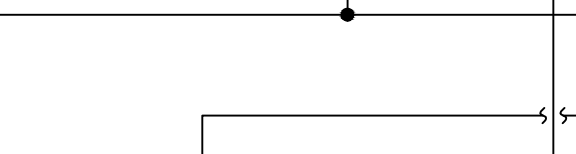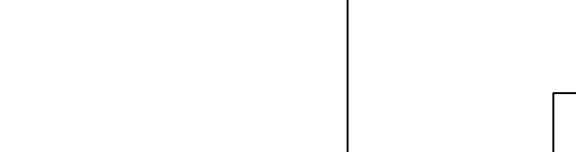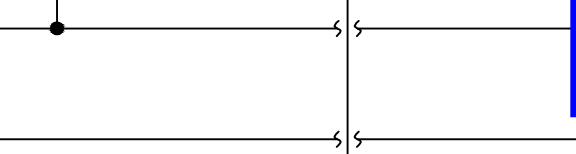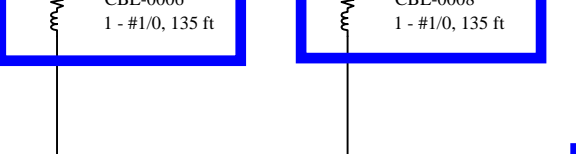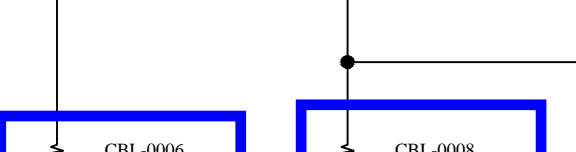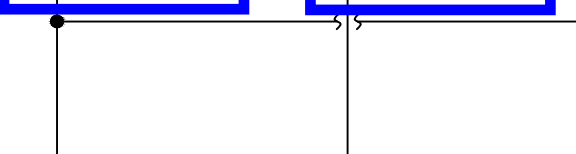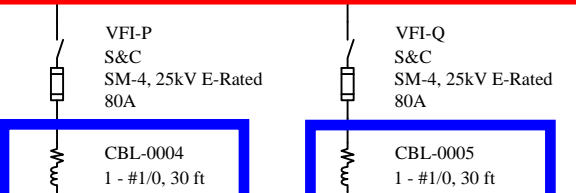


ft  **Not to be tested -
To be replaced by
654-17-781**

A	1	REVISION	<p>Original revision: 03/28/2017</p>	<p>THE INFORMATION ON THIS DOCUMENT WAS CREATED BY EATON ELECTRICAL. IT WAS DISCLOSED IN CONFIDENCE AND IS ONLY TO BE USED FOR THE PURPOSE IN WHICH IT WAS SUPPLIED.</p>	<p>CAD FILENAME EEU-0085</p>	<p>PRODUCT CODE U0160</p>	<p>REVISION 1</p>	<p>DWG IGS00001D</p>	<p>SHEET 1 OF 13</p>	<p>DATE 9/1/2012</p>	<p>DATE 6/12/2012</p>	<p>TYPE POWER SYSTEM ANALYSIS</p>	<p>ONE-LINE</p>	<p>EATON Electrical Services & Systems</p>	<p>TITLE VETERAN'S AFFAIRS MEDICAL CENTER - RENO MEDIUM VOLTAGE ONE LINE</p>

Low-voltage transformers


Bldg. 10
(Page 1 of 1)

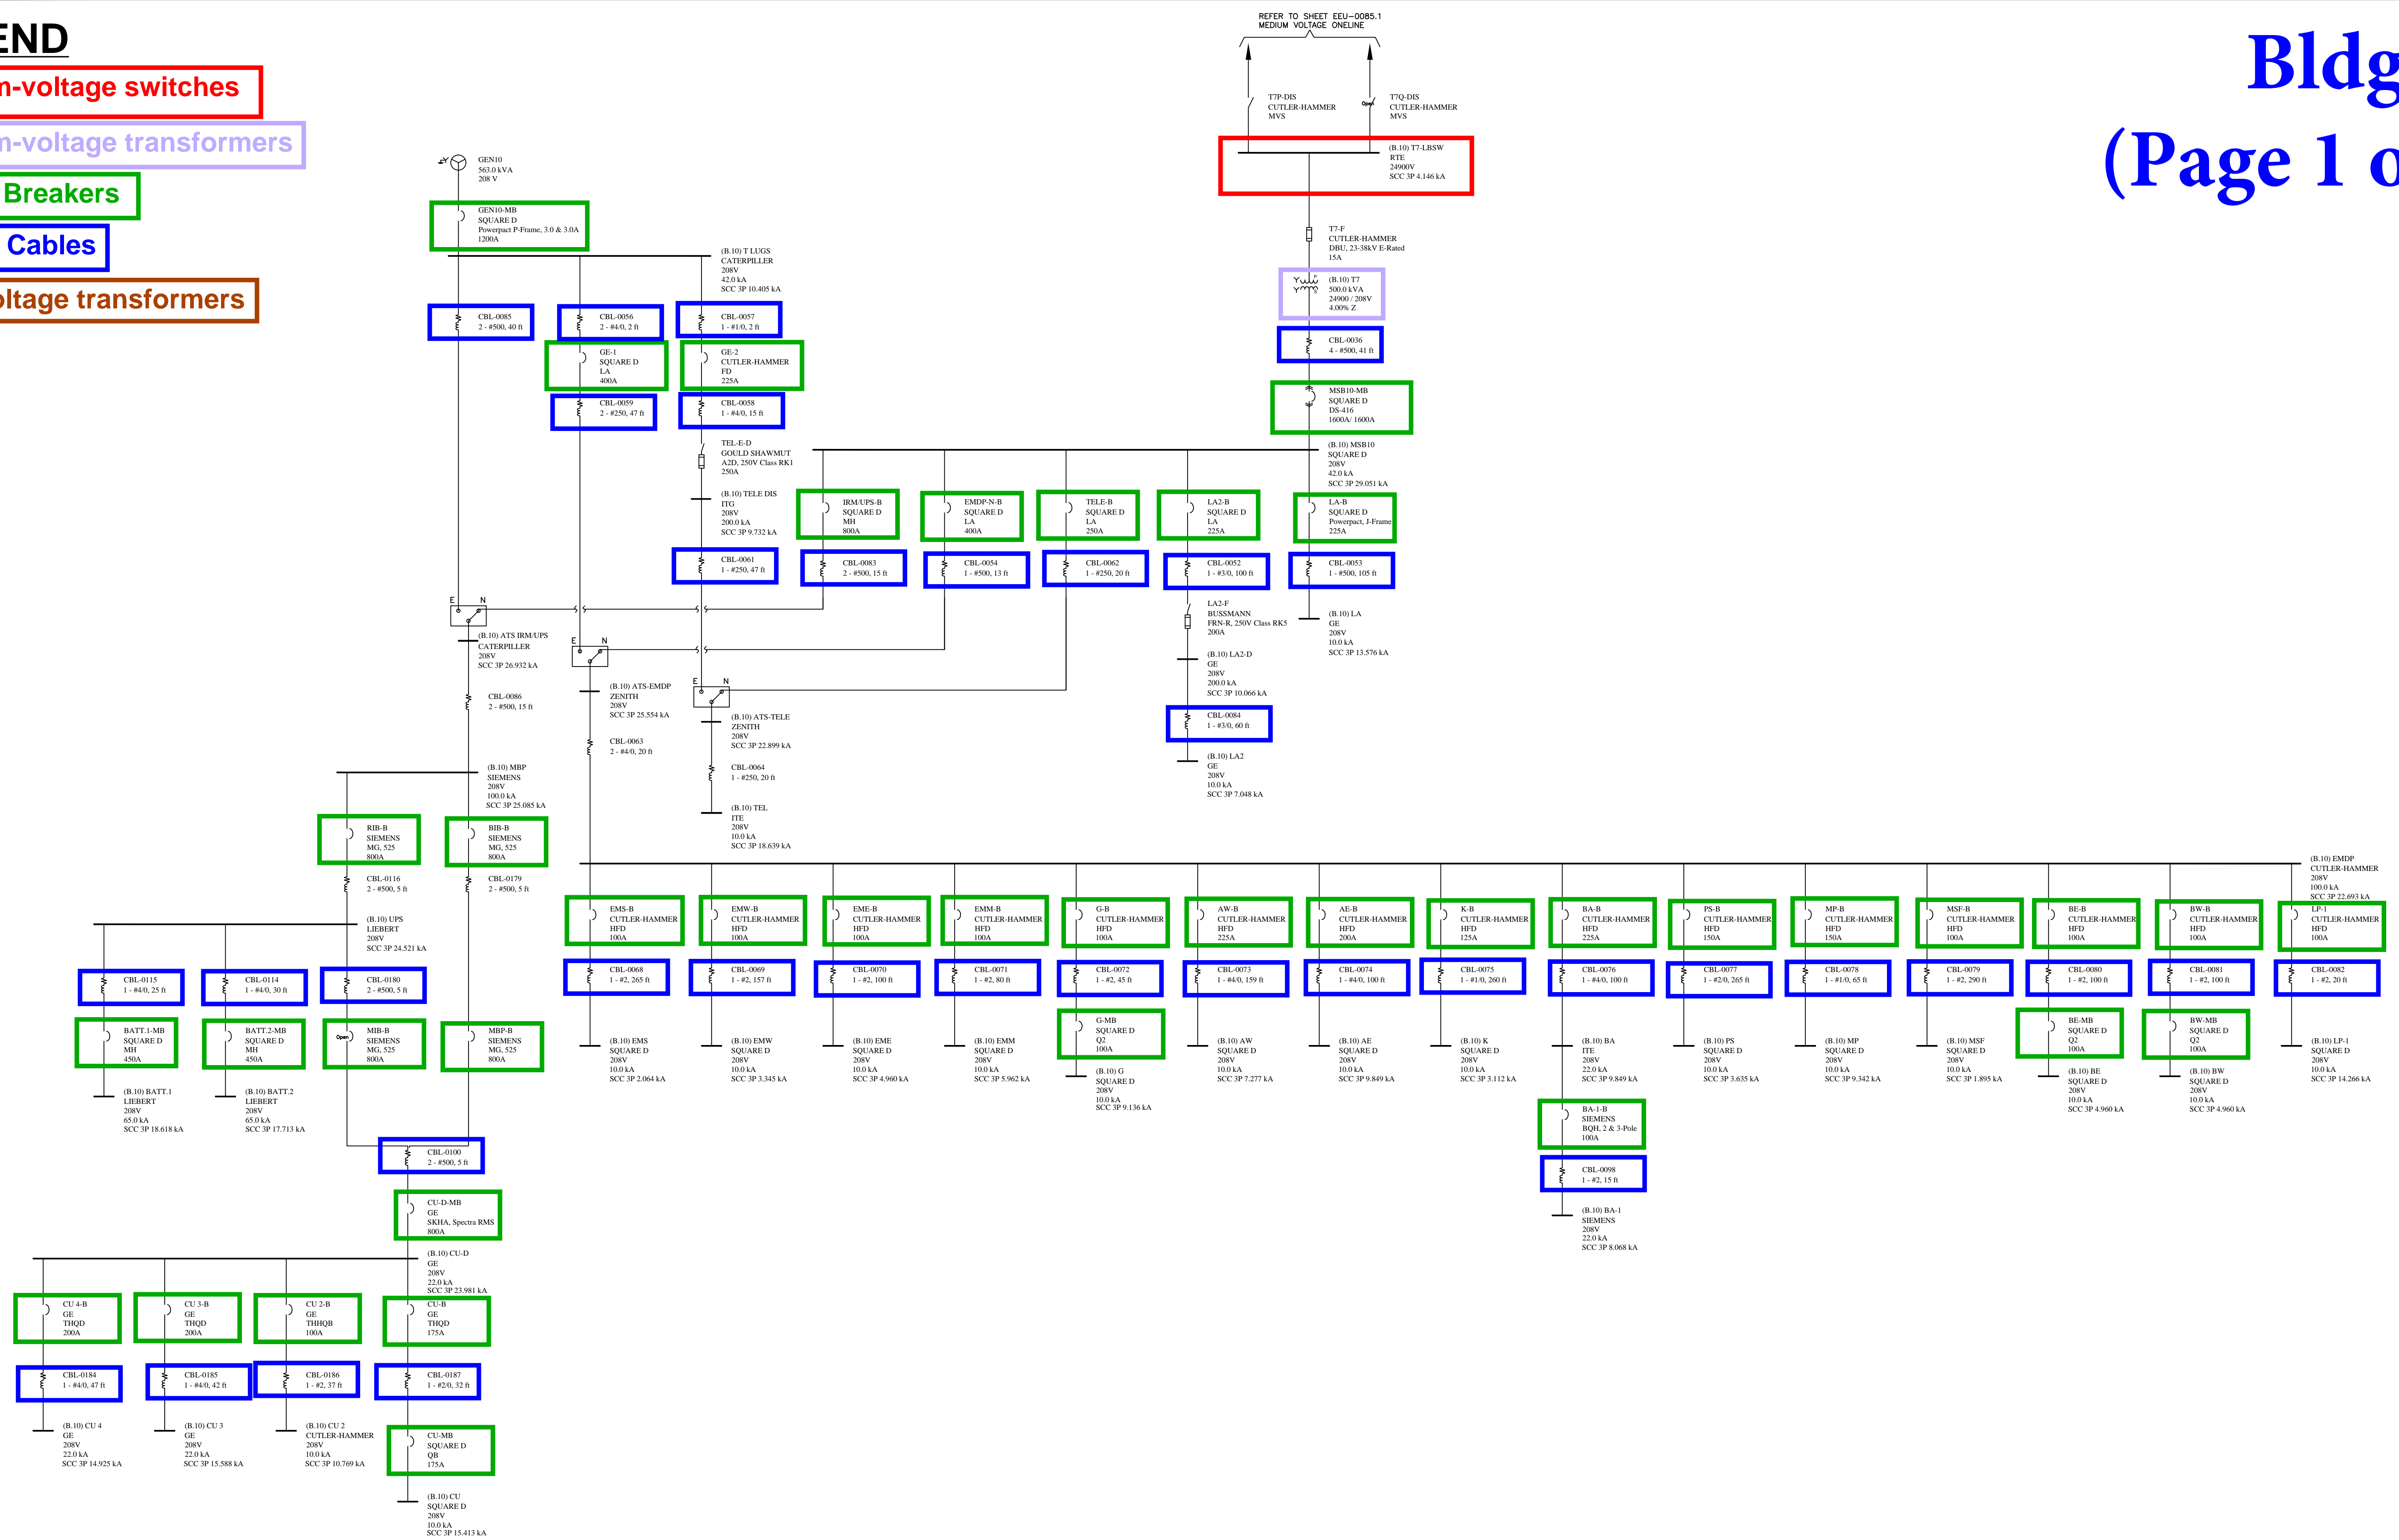

A	1	REVISION	Original revision: 03/28/2017	THE INFORMATION ON THIS DOCUMENT WAS CREATED BY EATON ELECTRICAL. IT WAS DISCLOSED IN CONFIDENCE AND IS ONLY TO BE USED FOR THE PURPOSE IN WHICH IT WAS SUPPLIED.	DATE 9/1/2012	DATE 6/12/2012	EATON Electrical Services & Systems				A	
	TITLE VETERAN'S AFFAIRS MEDICAL CENTER – RENO BUILDING 10 ONE LINE											
	SCALE NONE						TYPE POWER SYSTEM ANALYSIS		ONE–LINE			
	CAD FILENAME EEU–0085						PRODUCT CODE U0160	REVISION 1	G.O. IGS00001D	DWG EEU–0085.2		SHEET 2 OF 13

Low-voltage transformers

Bldg. 7/8
(Page 1 of 1)

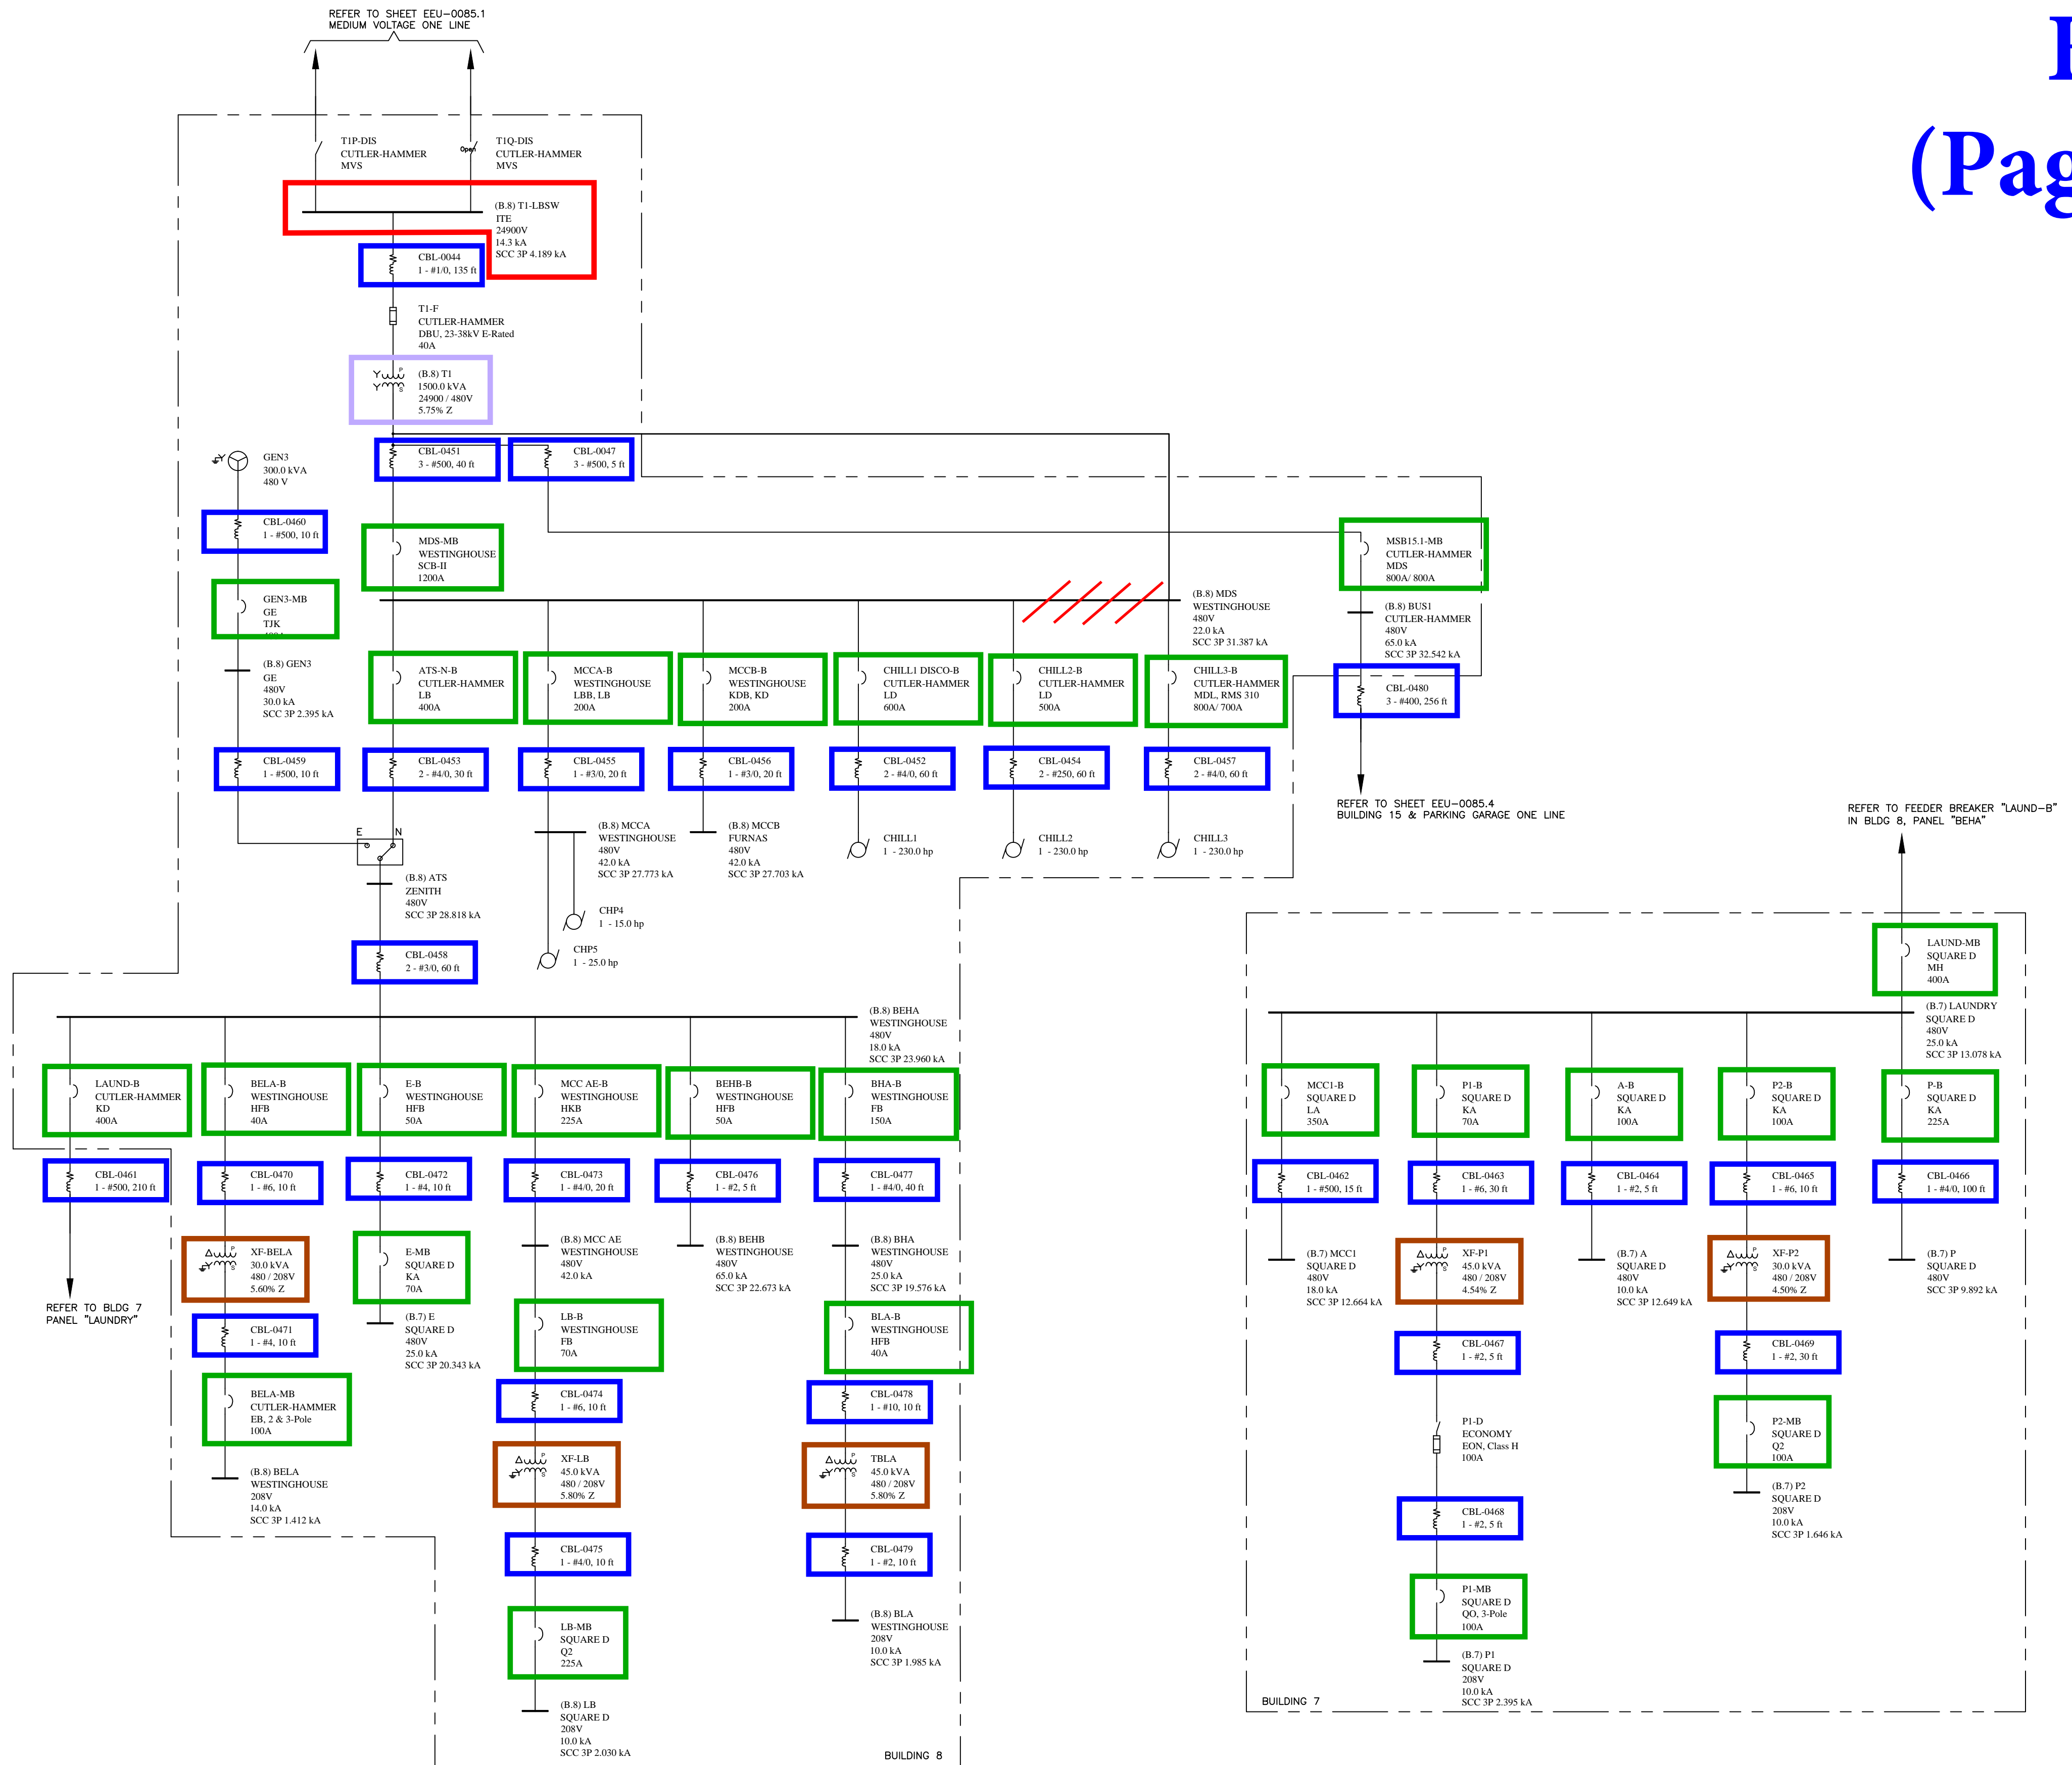[illegible]

Low-voltage transformers

100



A	1	REVISION	Original revision: 03/28/2017	THE INFORMATION ON THIS DOCUMENT WAS CREATED BY EATON ELECTRICAL. IT WAS DISCLOSED IN CONFIDENCE AND IS ONLY TO BE USED FOR THE PURPOSE IN WHICH IT WAS SUPPLIED.	DATE 9/1/2012	EATON Electrical Services & Systems				A
	TITLE VETERAN'S AFFAIRS MEDICAL CENTER – RENO BUILDING 15 & PARKING GARAGE ONE LINE									
	TYPE POWER SYSTEM ANALYSIS					ONE–LINE				
	CAD FILENAME EEU–0085					PRODUCT CODE U0160	REVISION 1	G.O. IGS00001D	DWG EEU–0085.4	

Low-voltage transformers

1

REVISION

Original revision: 03/28/2017

THE INFORMATION ON THIS DOCUMENT WAS CREATED BY EATON ELECTRICAL. IT WAS DISCLOSED IN CONFIDENCE AND IS ONLY TO BE USED FOR THE PURPOSE IN WHICH IT WAS SUPPLIED.

CAD FILENAME
EEU-0085

PRODUCT CODE
U0160

DFT
P. DELOSREYES

ENGR
P. DELOSREYES

DATE
9/1/2012

DATE
6/12/2012

SCALE
NONE

REVISION
1

EATON | Electrical Services & Systems

TITLE
VETERAN'S AFFAIRS MEDICAL CENTER – RENO BUILDING 12, SHEET 1 ONE LINE

TYPE
POWER SYSTEM ANALYSIS

ONE-LINE


G.O.
IGS00001D

DWG
EEU-0085.5

SHEET
5 OF 13

Bldg. 12

(Page 2 of 2)

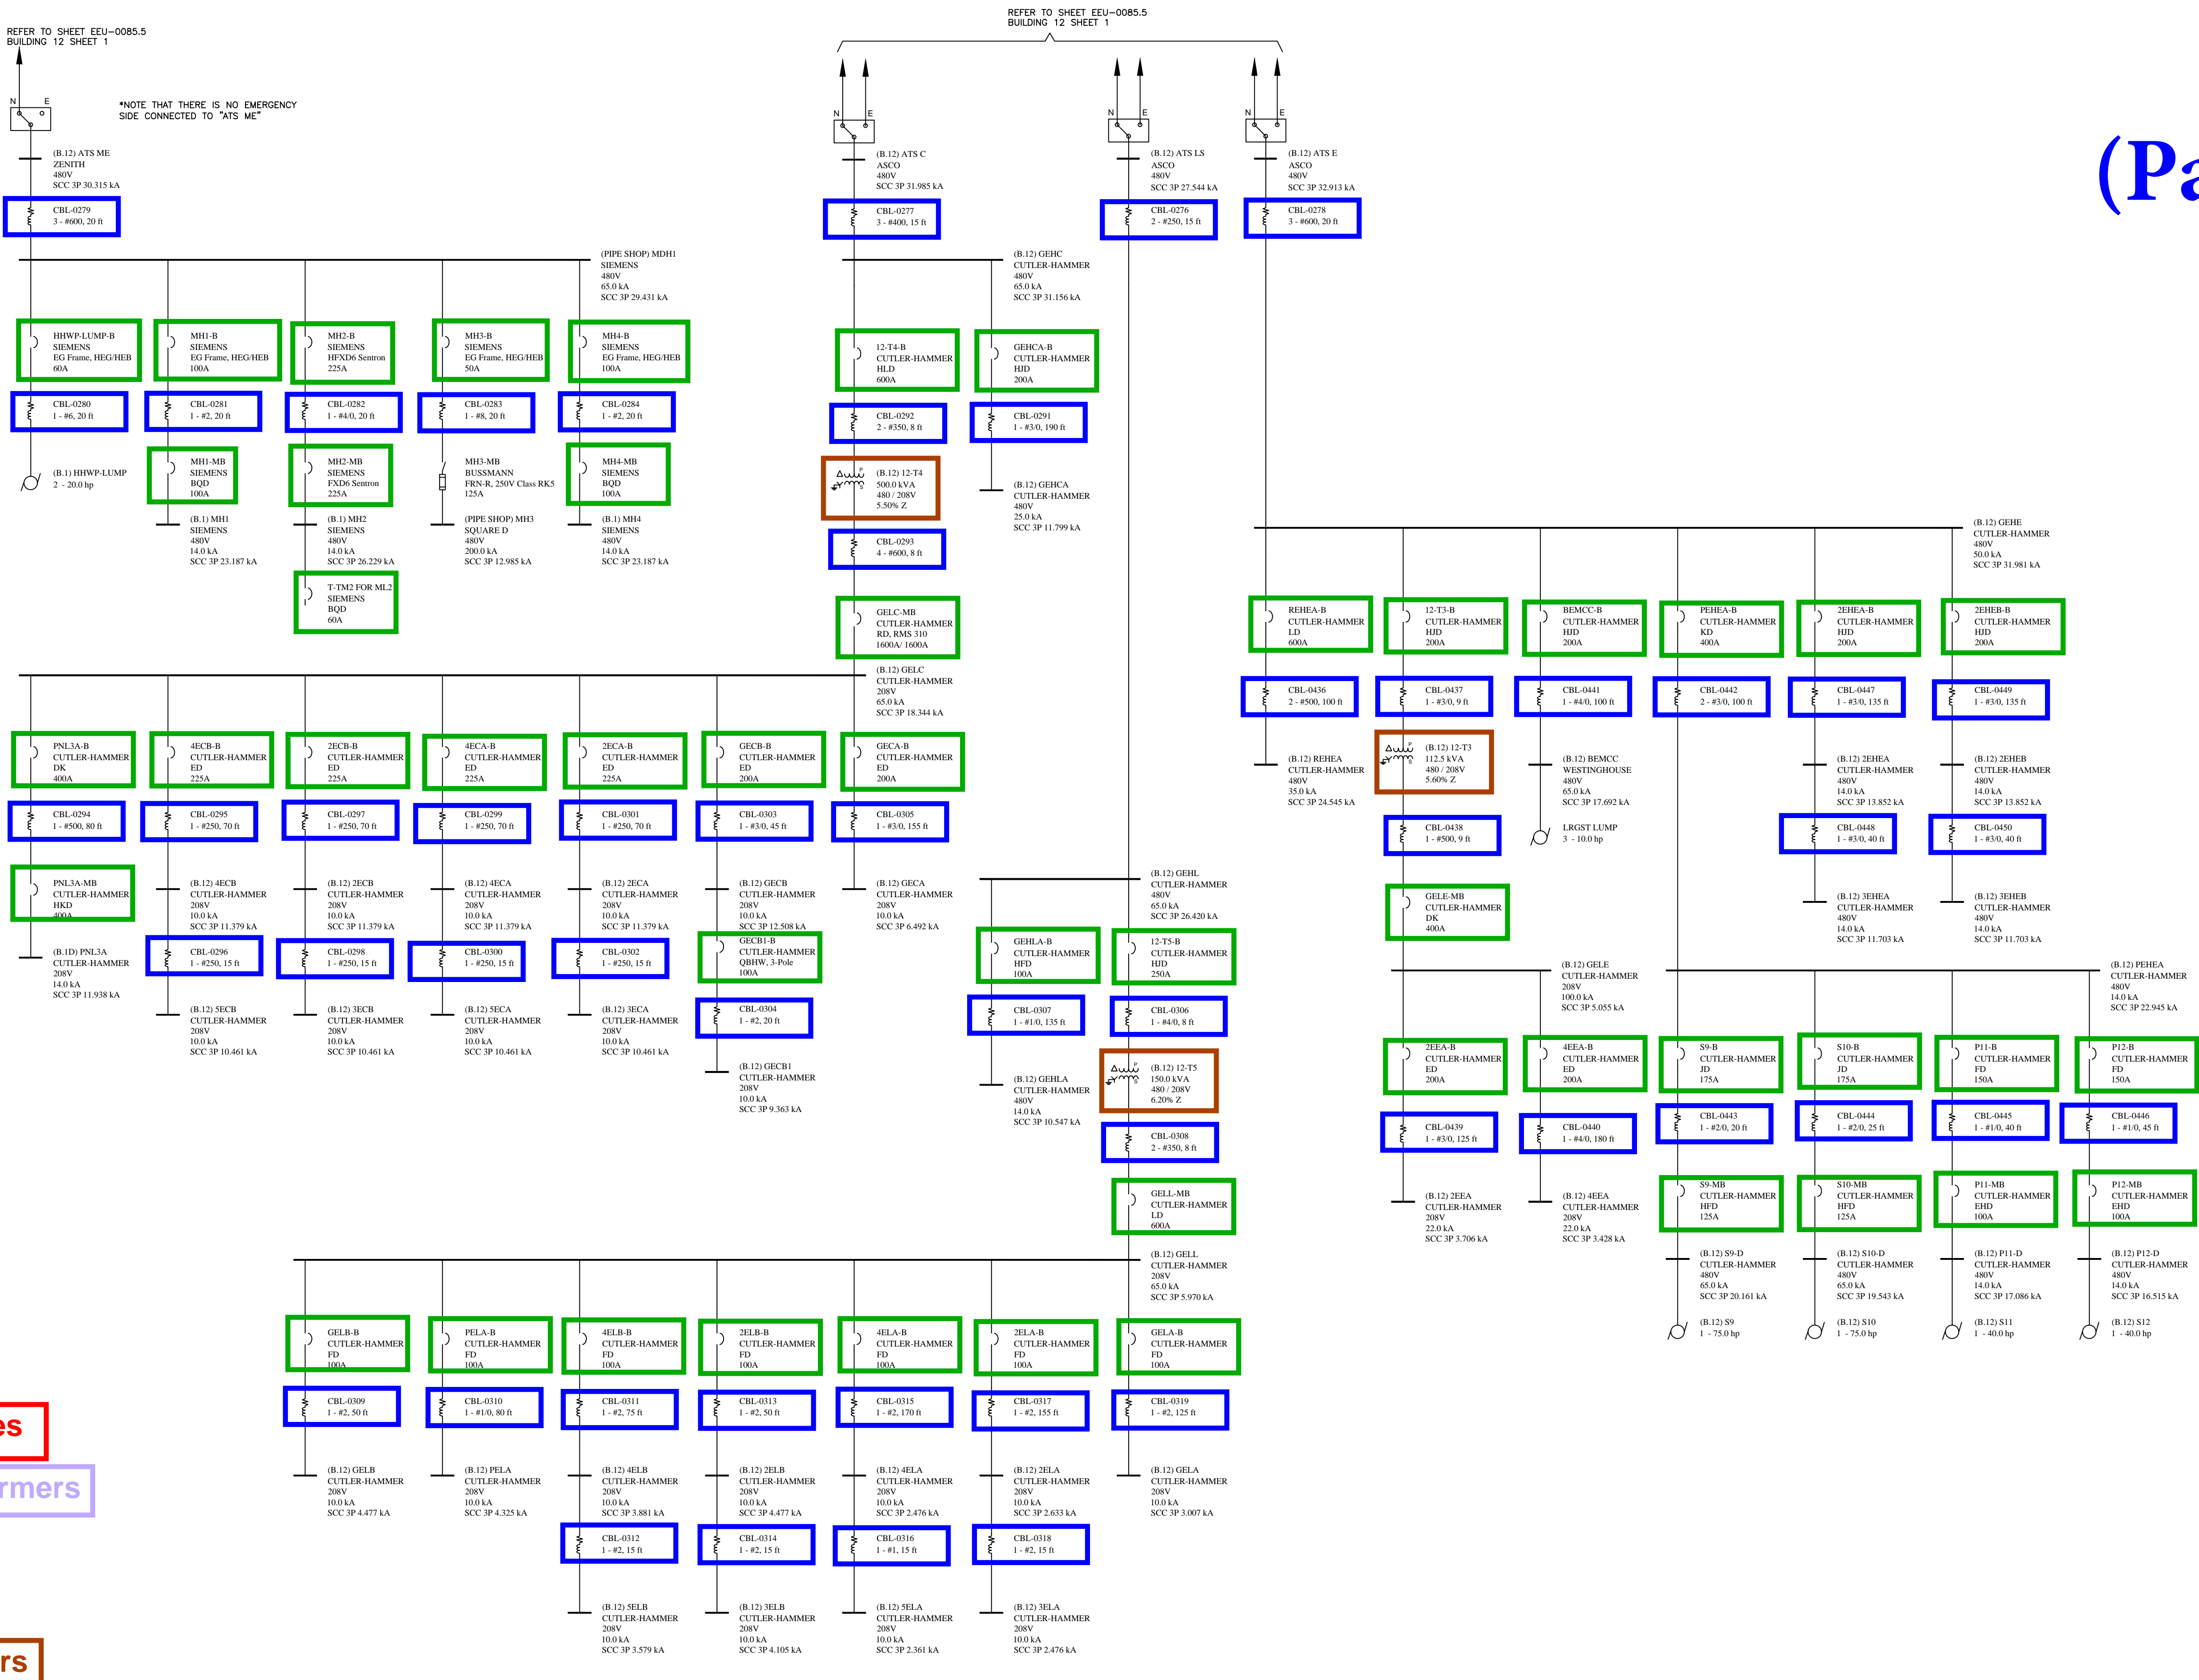

LEGEND

Medium-voltage switches

Medium-voltage transformers

Circuit Breakers

Feeder Cables

Low-voltage transformers

Original revision: 03/28/2017

THE INFORMATION ON THIS
DOCUMENT WAS CREATED BY
EATON ELECTRICAL. IT WAS
DISCLOSED IN CONFIDENCE
AND IS ONLY TO BE USED
FOR THE PURPOSE IN
WHICH IT WAS SUPPLIED.

DFTR P. DELOSREYES 9/1/2012

ENGR P. DELOSREYES 6/12/2012

SCALE NONE

CAD FILENAME
EEU-0085

PRODUCT CODE
U0160

REVISION
1

DATE 9/1/2012
EATON | Electrical Services & Systems

TITLE
VETERAN'S AFFAIRS MEDICAL CENTER - RENO
BUILDING 12, SHEET 2 ONE LINE

TYPE
POWER SYSTEM ANALYSIS

ONE-LINE


G.O.
IGS00001D

DWG
EEU-0085.6

SHEET
6 OF 13


Bldg. 1/1A
(Page 1 of 3)

Low-voltage transformers

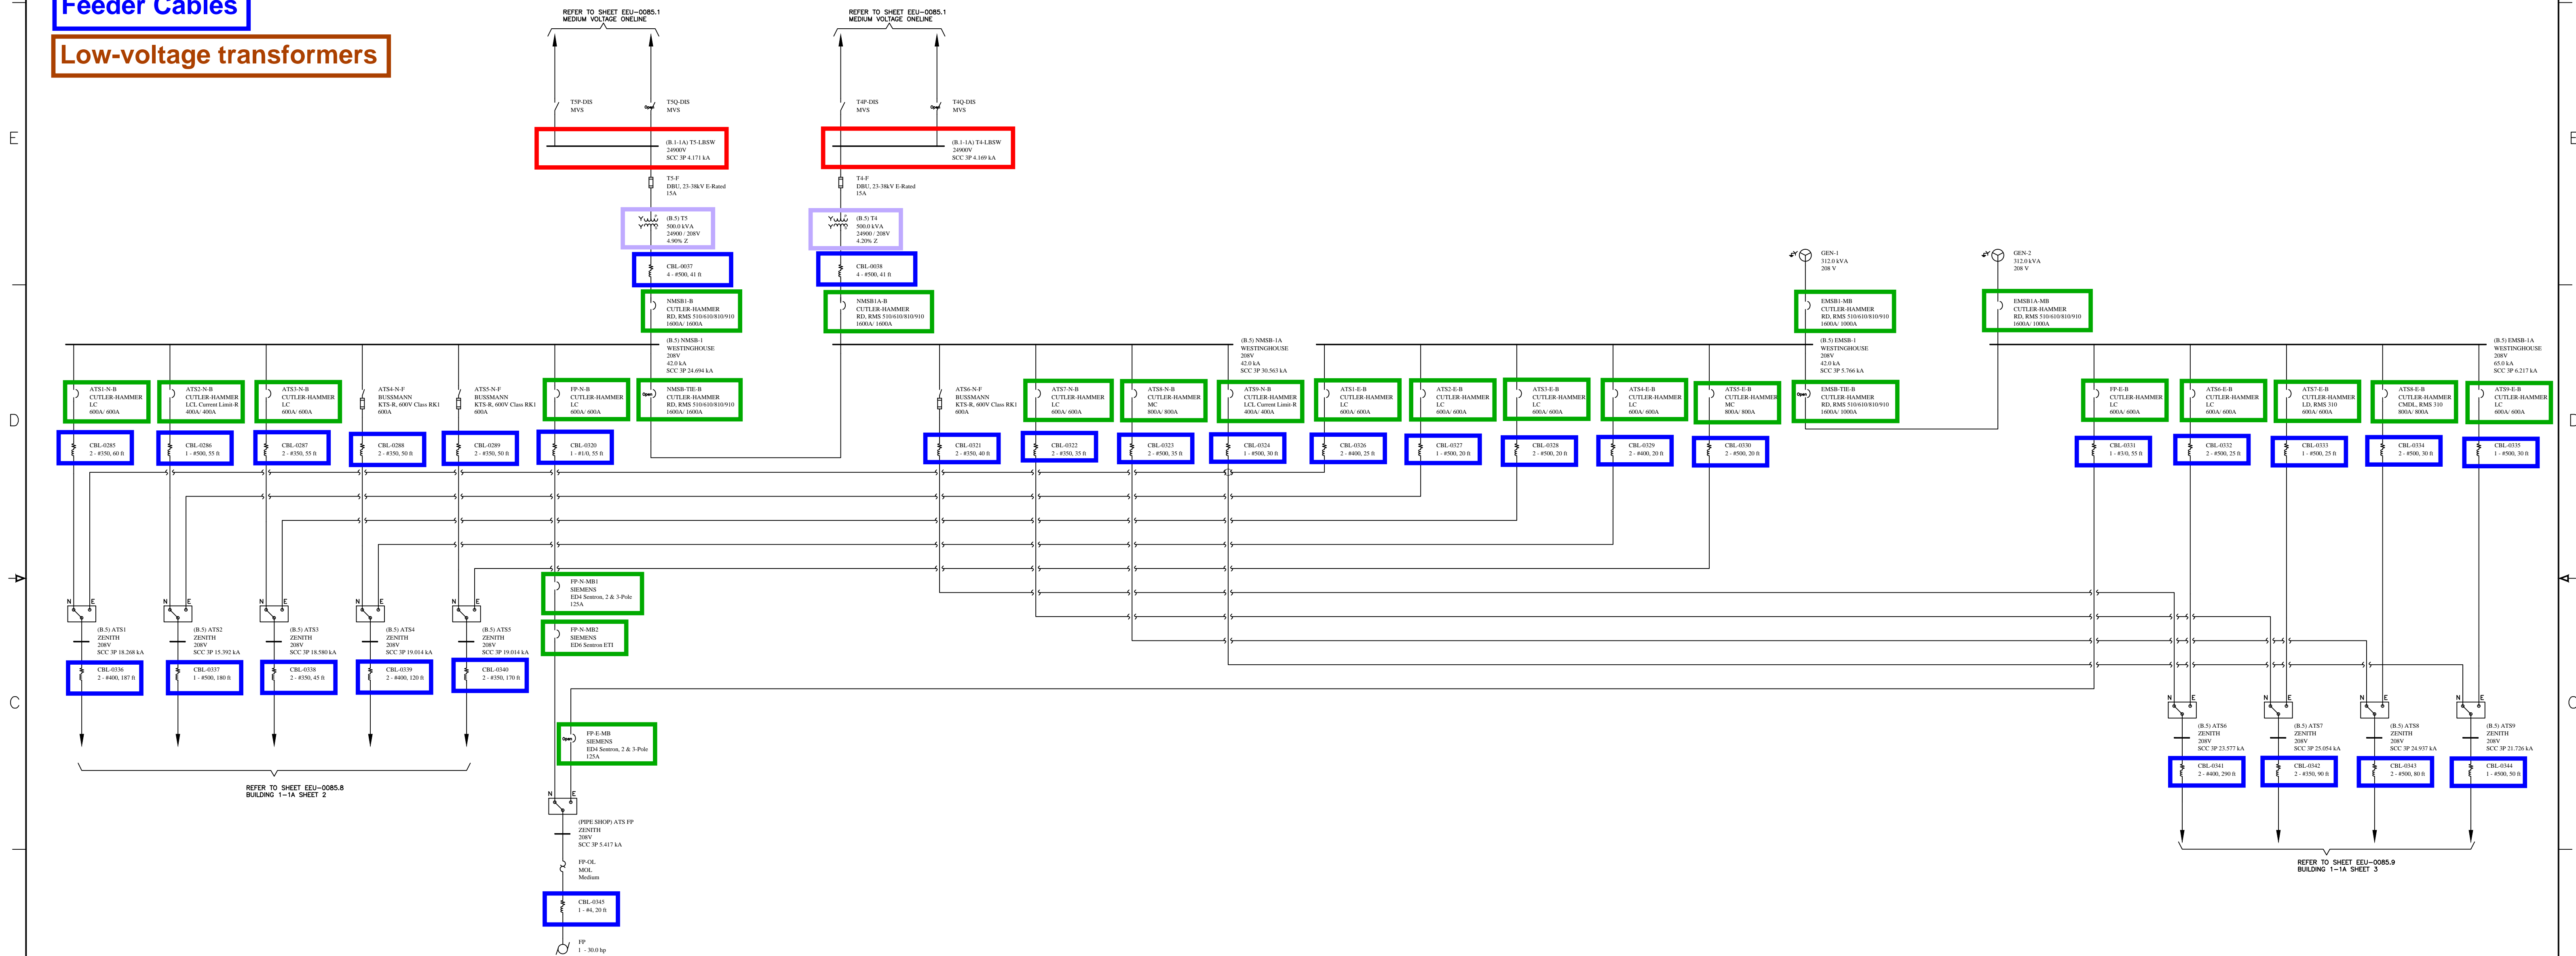

A	1	REVISION	Original revision: 03/28/2017	THE INFORMATION ON THIS DOCUMENT WAS CREATED BY EATON ELECTRICAL. IT WAS DISCLOSED IN CONFIDENCE AND IS ONLY TO BE USED FOR THE PURPOSE IN WHICH IT WAS SUPPLIED.	DATE 9/1/2012	DATE 6/12/2012	EATON Electrical Services & Systems			A
	TITLE VETERAN'S AFFAIRS MEDICAL CENTER – RENO BUILDING 1–1A, SHEET 1 ONE LINE									
	SCALE NONE						TYPE POWER SYSTEM ANALYSIS	ONE–LINE		
	CAD FILENAME EEU–0085						PRODUCT CODE U0160	REVISION 1	G.O. IGS00001D	

8 7 6 5 4 3 2 **Plds 1/1A**

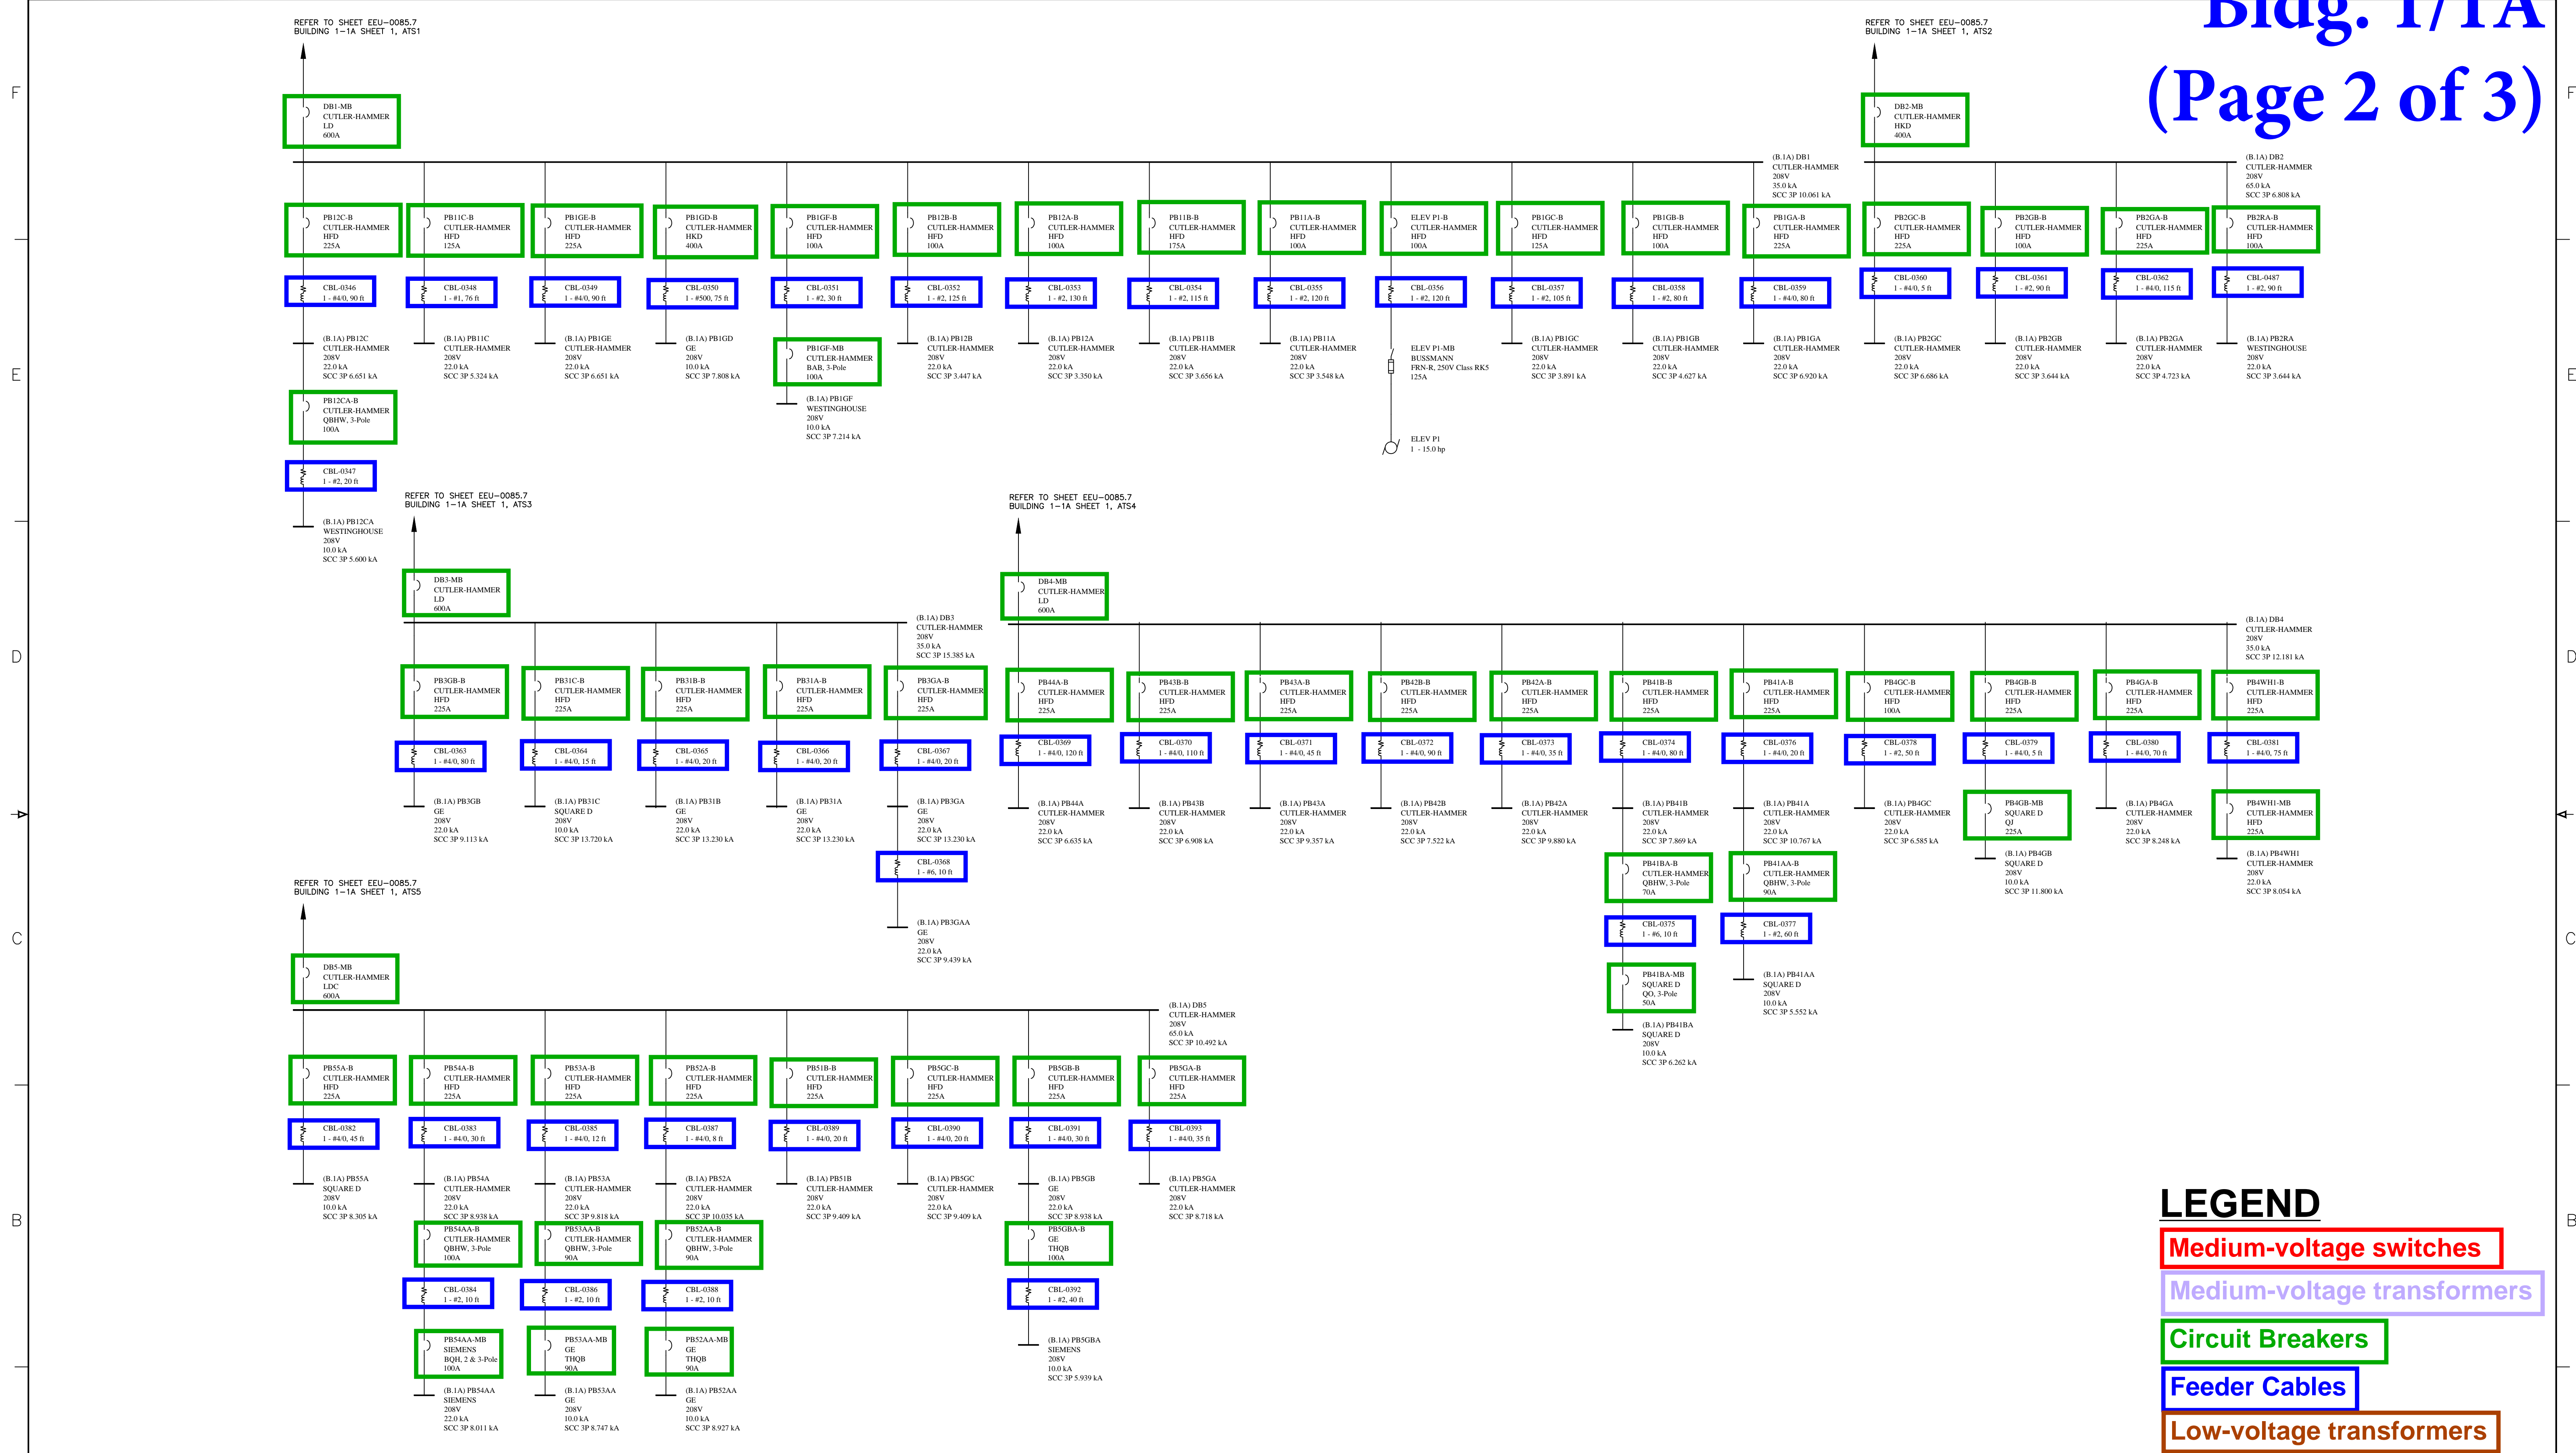

Low-voltage transformers

[illegible]

LEGEND

Medium-voltage switches


Medium-voltage transformers

Circuit Breakers

Feeder Cables

Low-voltage transformers


Bldg. 1/1A
(Page 3 of 3)

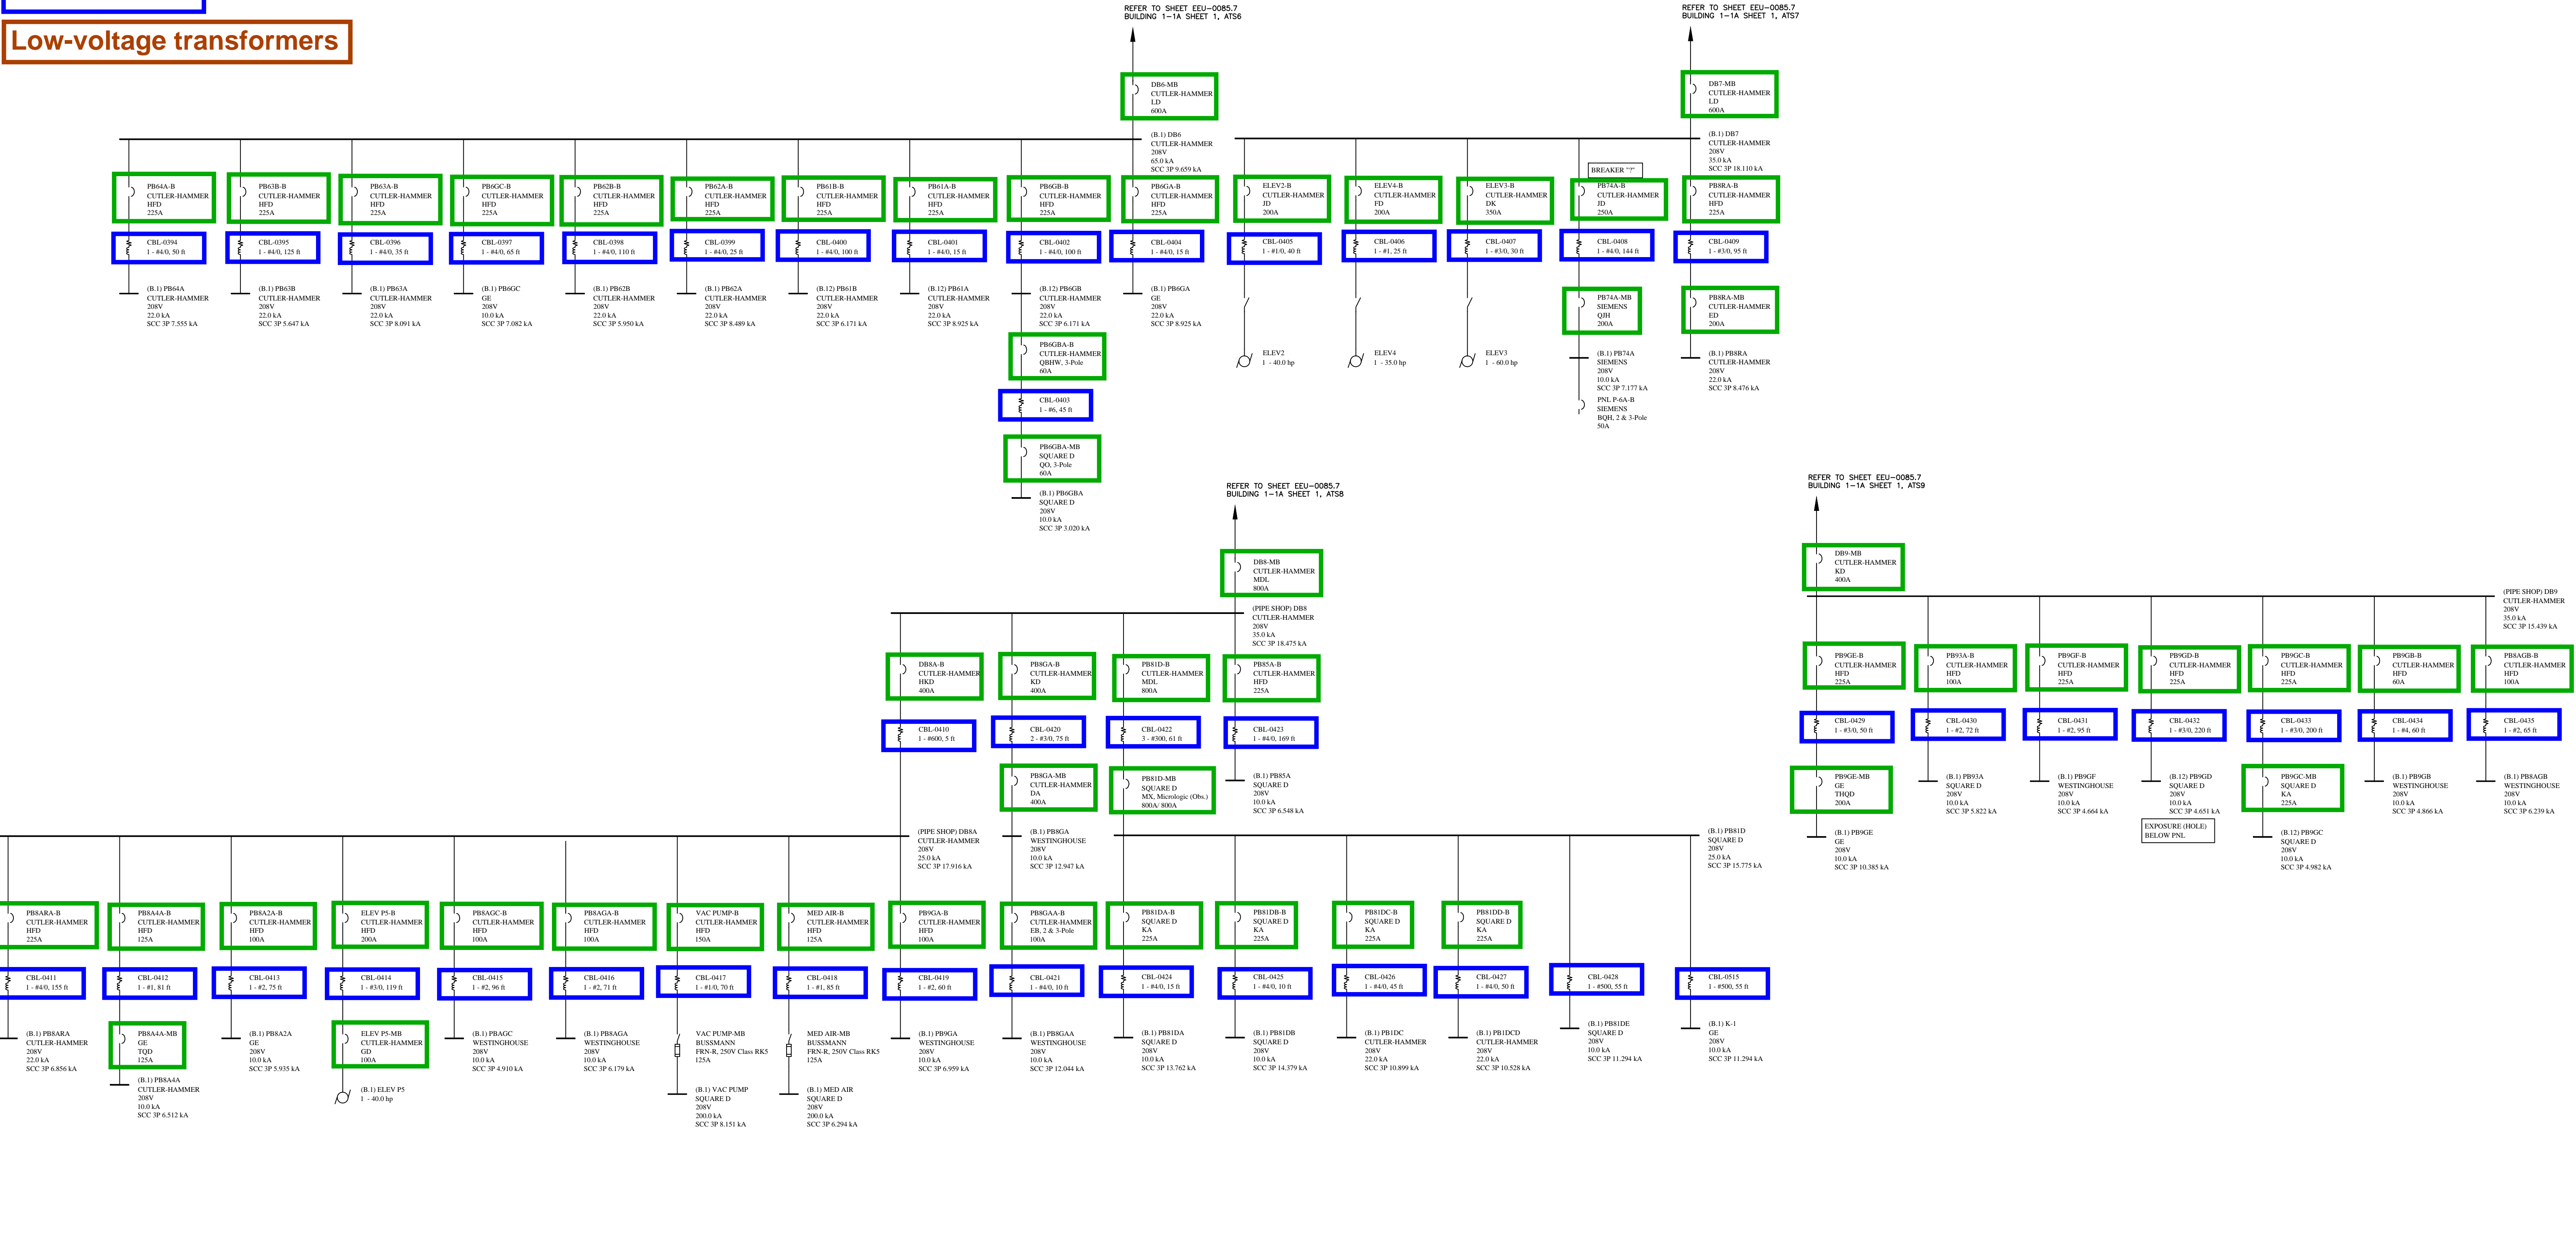

REVISION	THE INFORMATION ON THIS DOCUMENT WAS CREATED BY EATON ELECTRICAL. IT WAS DISCLOSED IN CONFIDENCE AND IS ONLY TO BE USED FOR THE PURPOSE IN WHICH IT WAS SUPPLIED.	DFTF P. DELOSREYES		DATE 9/1/2012		EATON Electrical Services & Systems							
		ENGR P. DELOSREYES		DATE 6/12/2012		TITLE VETERAN'S AFFAIRS MEDICAL CENTER – RENO BUILDING 1–1A, SHEET 3 ONE LINE							
		SCALE NONE				TYPE POWER SYSTEM ANALYSIS		ONE–LINE					
		CAD FILENAME EEU–0085		PRODUCT CODE U0160		REVISION 1		G.O. IGS00001D		DWG EEU–0085.9		SHEET 9 OF 13	
Original revision: 03/28/2017													

Low-voltage transformers

Bldg. 1D/4
(Page 3 of 4)

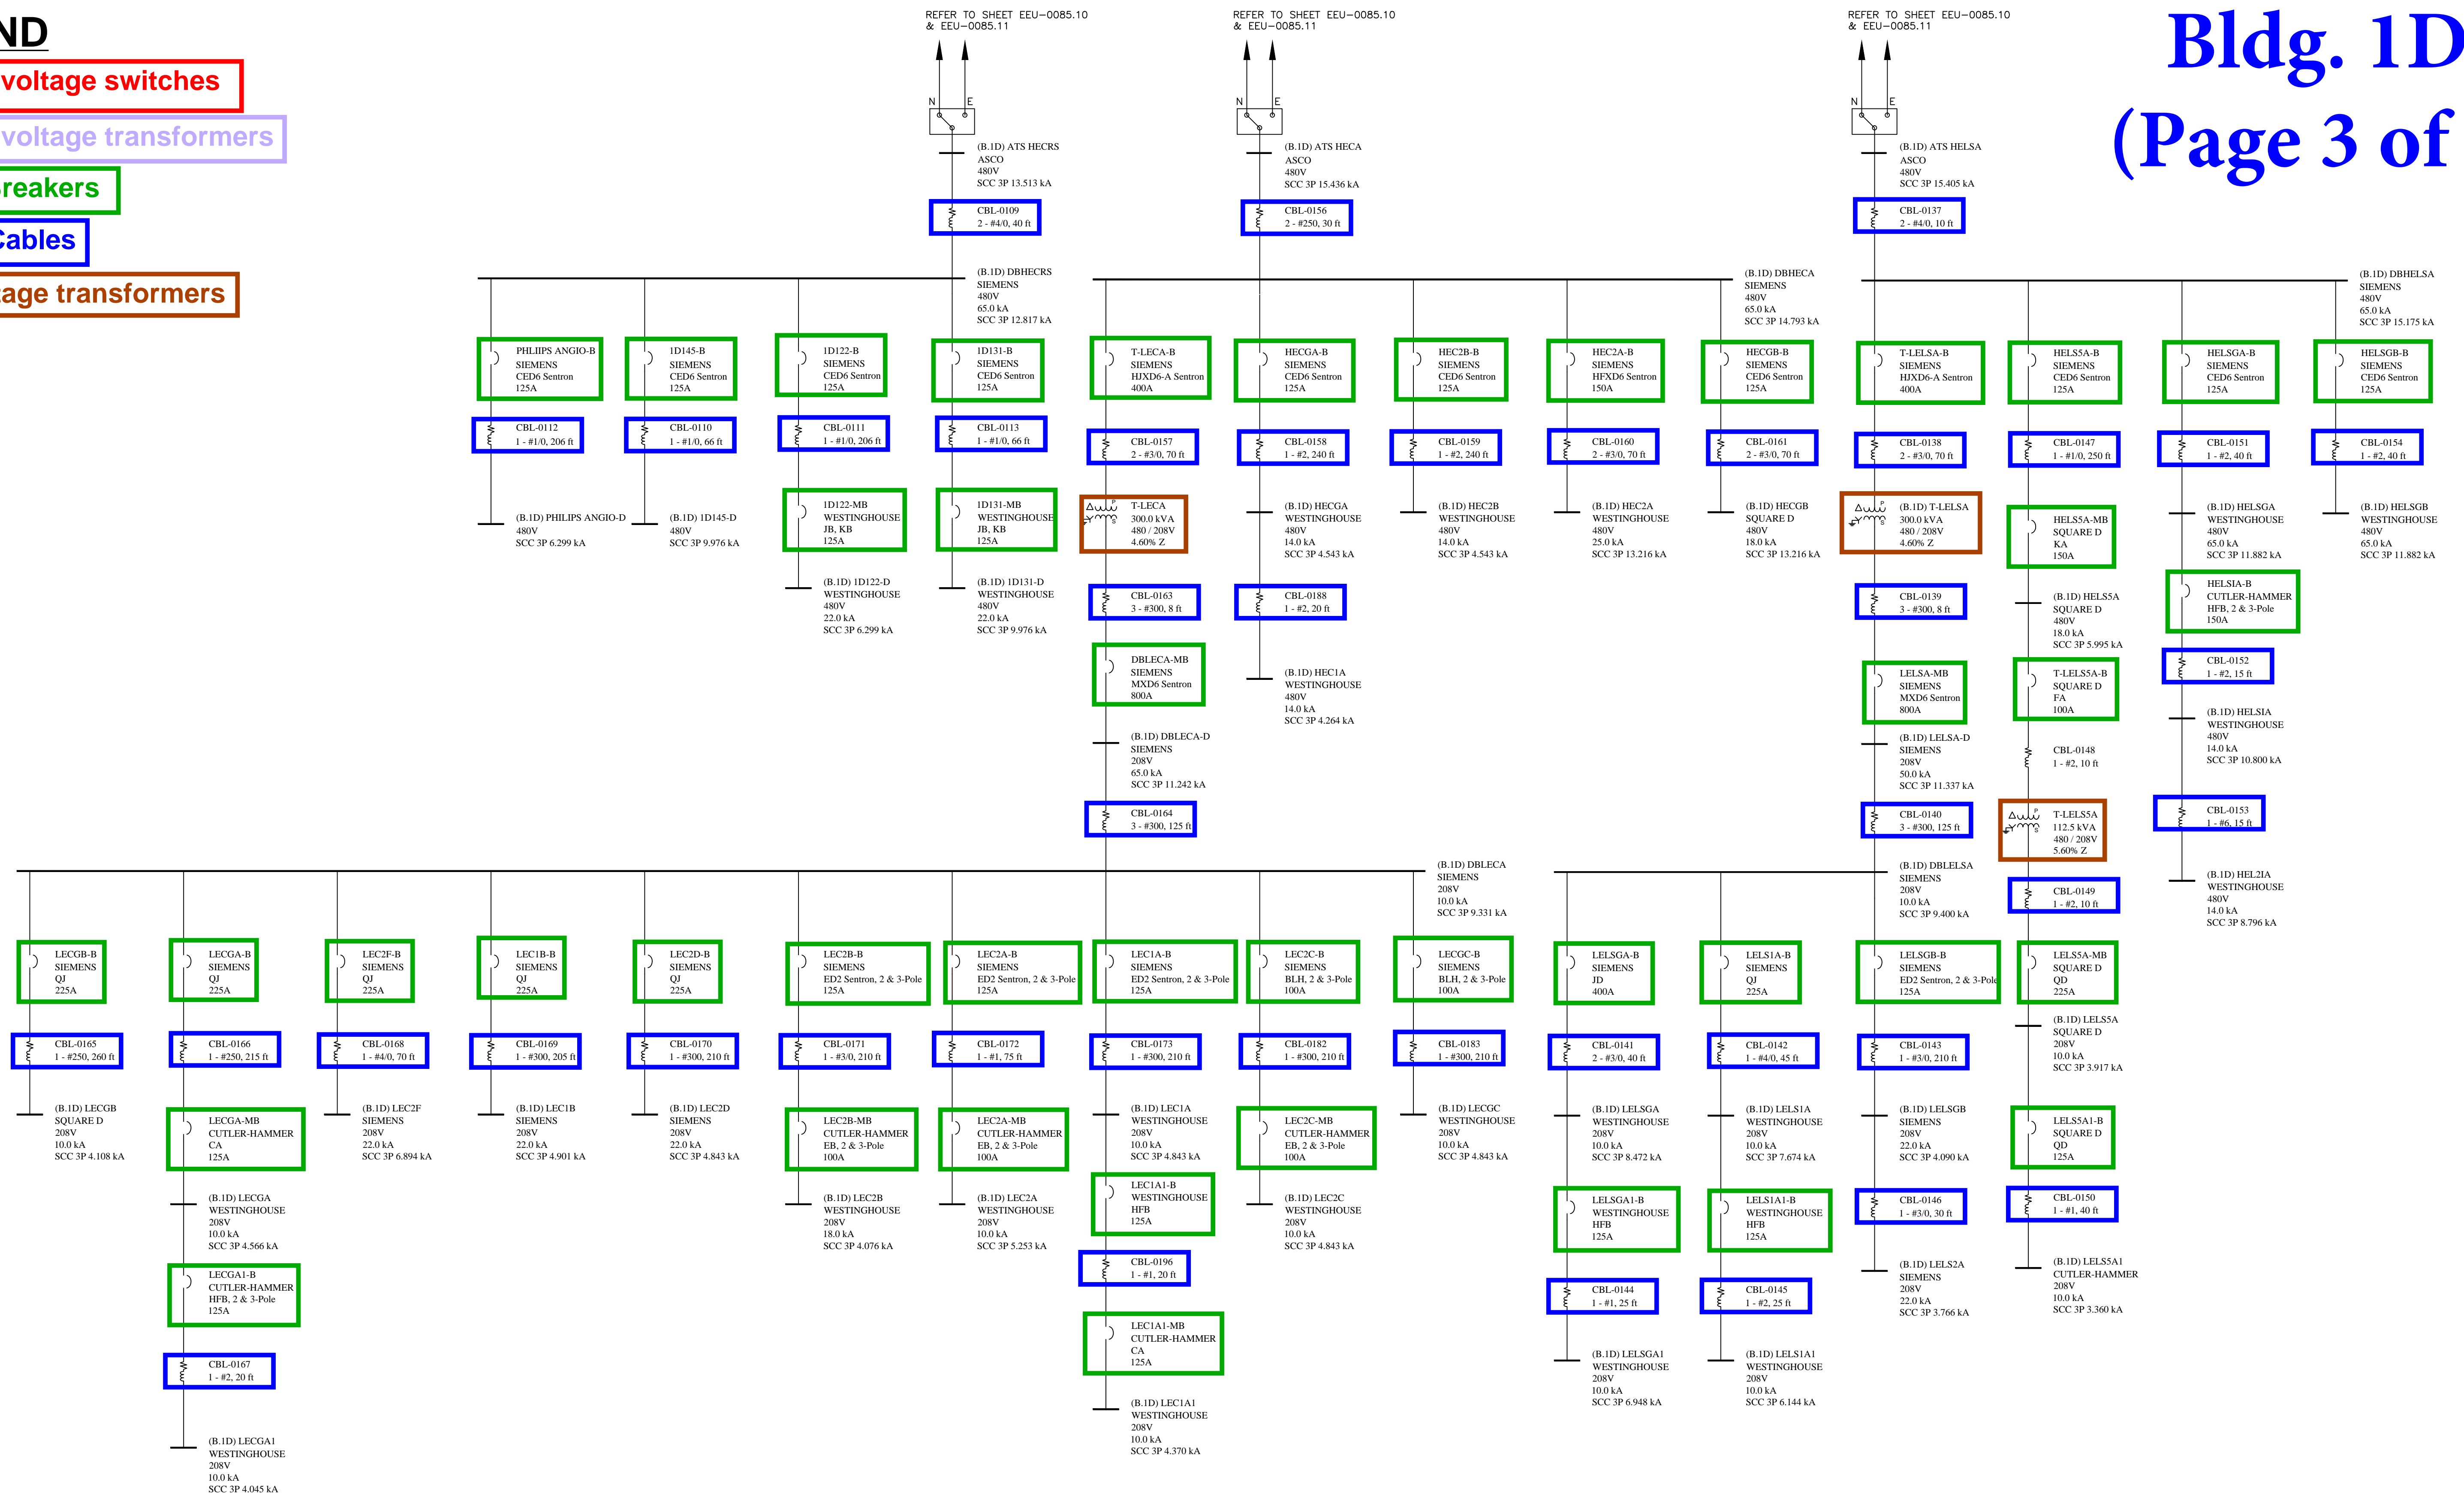[illegible]

Low-voltage transformers

(E) BLDG #1D MAIN SWITCHBOARD 'MRS'
1600A, 480Y/277V 3Ø, 4W, NEMA 1
(REFER TO 5-E59 FOR LOCATION)

(N) SHUNT TRIP STATION.
LOCATION AS APPROVED BY
FIRE DEPARTMENT

17C. W (4) #10
(CONTROL WIRES FOR SHUNT TRIP)

(E) PRIMARY XFMR
000VPRI.-480Y/277VSEC.
750KVA

(E) FROM NV
ENERGY POINT
OF SERVICE

(N) MAIN DISTRIBUTION PANEL 'HDB' ④
400A, 480Y/277V 3Ø, 4W, NEMA 1, AIC=35,000
 (LOCATED IN 1ST FLOOR ELECTRICAL ROOM)

30 LF #3/0 BC—
CONCRETE-ENCASED
GROUND IN FOUNDATION
PER NEC 250

#3/0 BC GROUND BOND —

EXIST. BLDG. ID —

NEW BLDG #5-
COLD WATER
PIPE

XFMR 'T-LDB'
480-208Y/120V
DELTA-WYE
150KVA

1/0 0

(N) DISTRIBUTION BOARD "LDB" (4)
400A 208Y/120V 3Ø, 4W, NEMA 1, AIC=18,000
(LOCATED IN 1ST FLOOR ELECTRICAL ROOM)

Low-voltage transformers

Bldg. 6
(Page 1 of 1)

