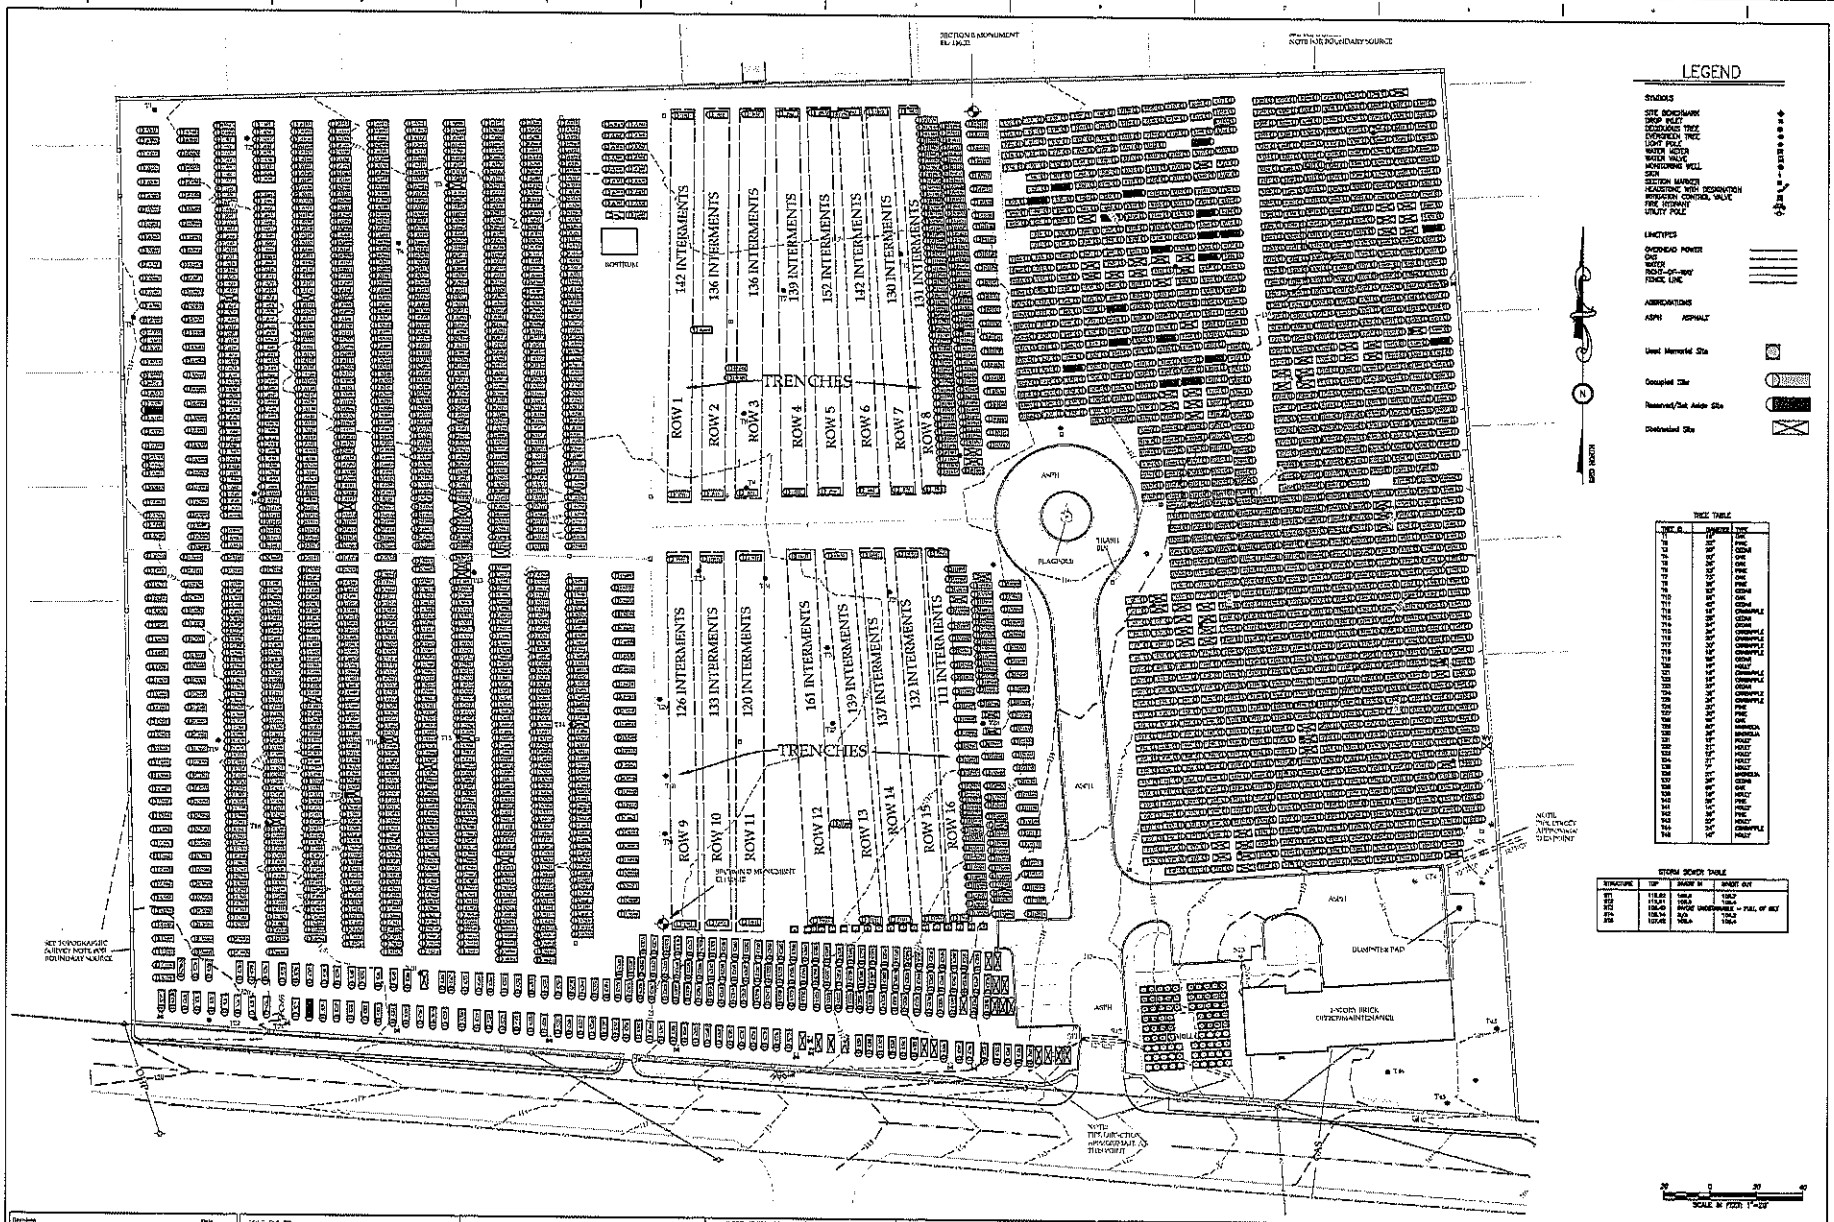

Revisions	Date
Update and BOSS Reconcile	9/12/14

amec

603 E NATIONAL CEMETERY ROAD
FLORENCE, SC 29506

TAX PARCEL
90119-07-001
FLORENCE COUNTY, SC
(CITY OF FLORENCE)

NATIONAL CEMETERY ADMINISTRATION

Drawing Title: GRAVESITE LAYOUT (OVERALL SHEET)

Project Title: MAPPING SURVEY SERVICES

Date: 10-17-14

Project No: 7861/45602

Drawing No.: B200

Sheet: of

Location: FLORENCE NATIONAL CEMETERY