








Update and BOSS Reconcile	2/9/17
Update and BOSS Reconcile	8/18/16
Update and BOSS Reconcile	2/17/16
Update and BOSS Reconcile	8/17/15
Correction to Section Q	3/31/15
Update and BOSS Reconcile	3/31/15
Update and BOSS Reconcile	9/2/14
Update and BOSS Reconcile	4/1/14
Update/Redraw/BOSS Reconcile	10/3/13
Semi-Annual Update	4/2/13
Revisions	Date

CAPACITY IN GRAVESITES						
SECTION	SIZE OF GRAVESITE	TOTAL	RES	AVAIL	OBST.	REMARKS
P	3 X 3	SEE GBSAT				
Q	3 X 3					
R	3 X 3					
S	3 X 3					

Scale 1 : 10

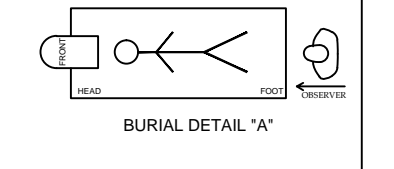

LEGEND	
	AVAILABLE GRAVESITE
	SET ASIDE
	OBSTRUCTED GRAVESITE
	OCCUPIED GRAVESITE
	GRAVES FACE
	GRAVESITE CONTROL MONUMENT



National Cemetery Administration  
Memorial Service Network II  
Decatur, Georgia 30033

Drawing Title Sections P - S Layout Drawing		Project Title Bay Pines National Cemetery		Date	
Approved: Area Director		Building Number		Checked	Drawn
Approved: Cemetery Director		Location Bay Pines, FL		DCJ	
		Dwg.		OR	








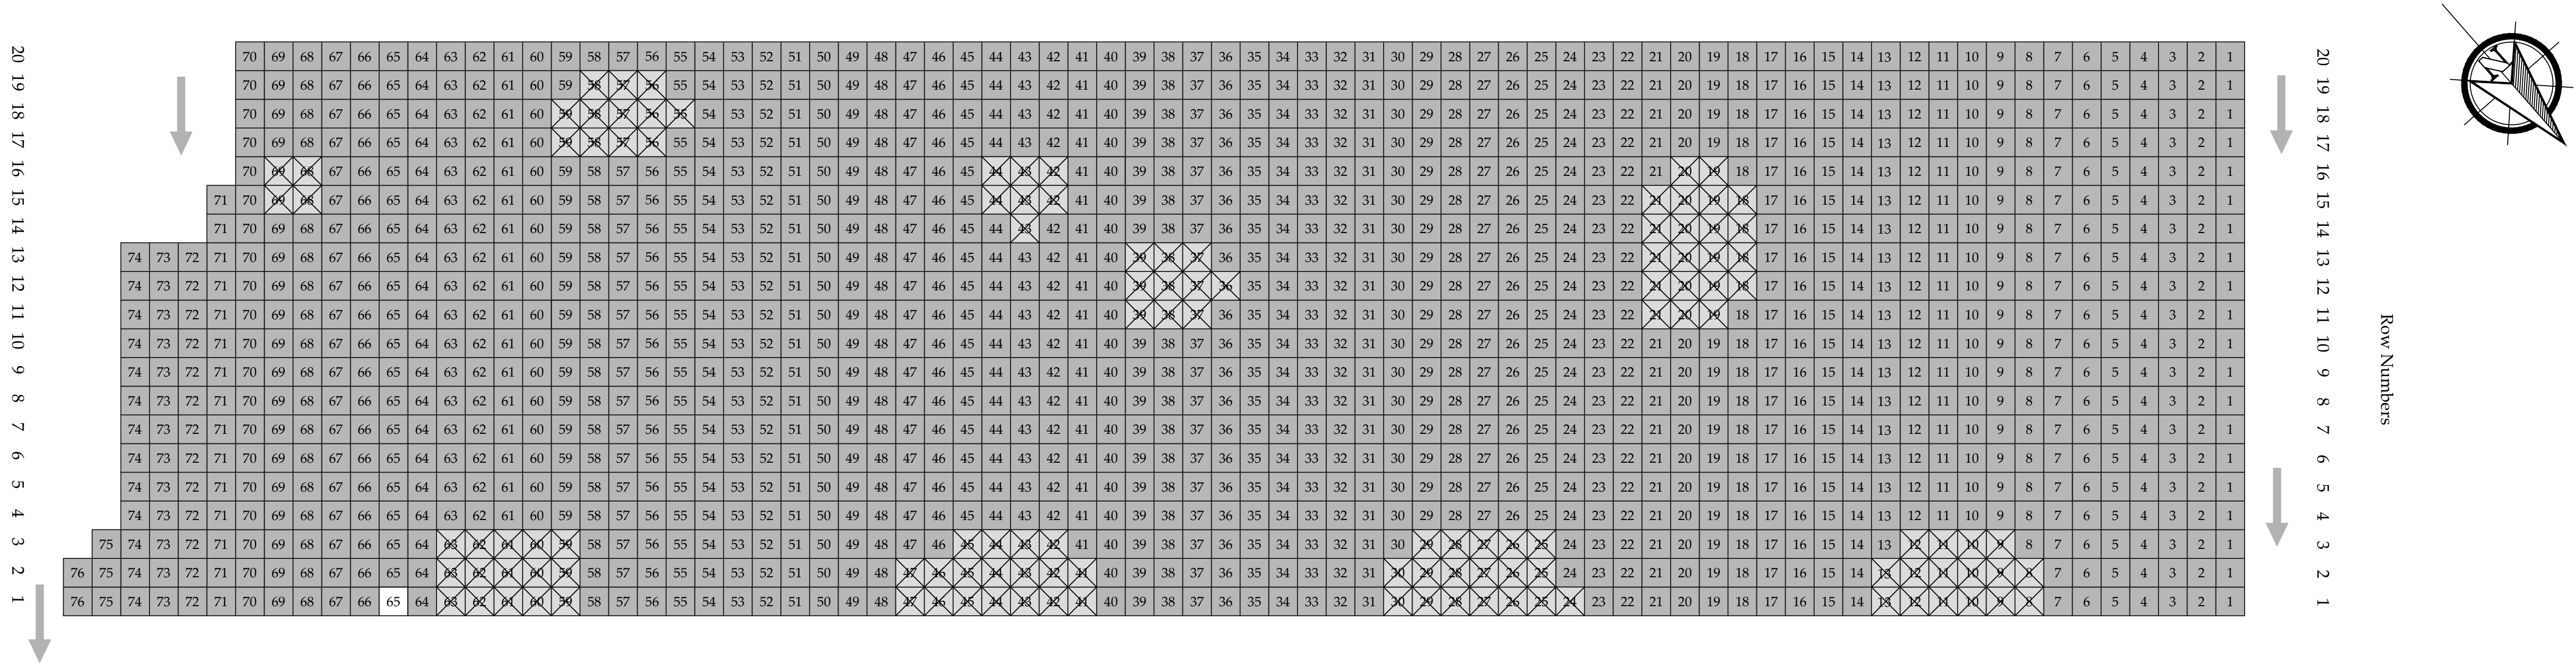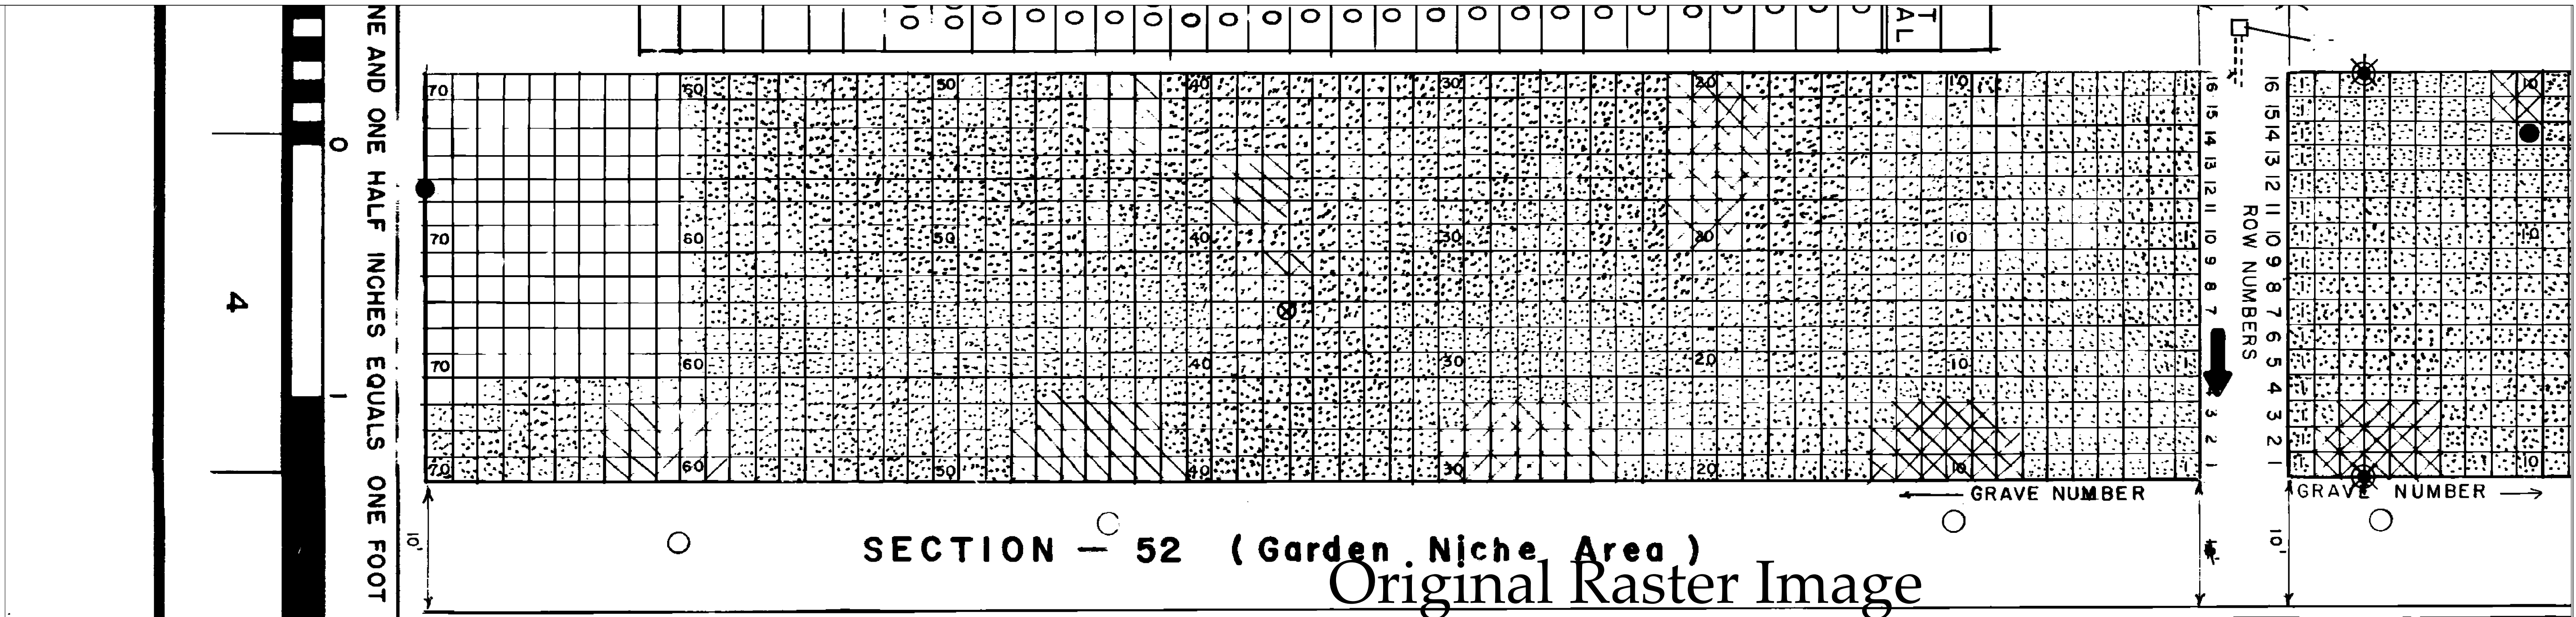


Update and BOSS Reconcile 2/9/17 Update and BOSS Reconcile 2/17/16 Update and BOSS Reconcile 8/14/15 Update and BOSS Reconcile 3/3/15 Revisions Date		CAPACITY IN GRAVESITES		Scale 1 : 10		LEGEND		National Cemetery Administration Memorial Service Network II Decatur, Georgia 30033		Drawing Title Section 52 Layout Drawing		Project Title Bay Pines National Cemetery		Date		
SECTION	SIZE OF GRAVESITE	TOTAL	RES	AVAIL	OBST.	REMARKS	AVAILABLE GRAVESITE	SET ASIDE	OBSTRUCTED GRAVESITE	OCCUPIED GRAVESITE	GRAVES FACE	GRAVESITE CONTROL MONUMENT	Building Number	Checked	Drawn	Project No.
52	3 x 3	SEE GRSAT													DCJ	DRAWING NO. 830LA05-2
													Location Bay Pines, FL			Dwg. Of



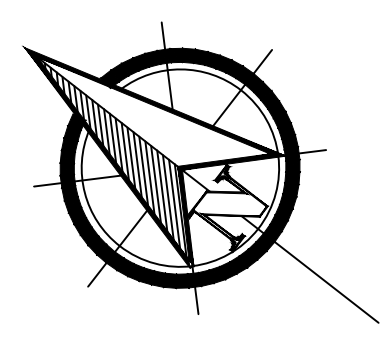



Row 16	1	2	3	4	5	6	7	8	9	10	11	12	13	14
Row 15	1	2	3	4	5	6	7	8	9	10	11	12	13	14
Row 14	1	2	3	4	5	6	7	8	9	10	11	12	13	14
Row 13	1	2	3	4	5	6	7	8	9	10	11	12	13	14
Row 12	1	2	3	4	5	6	7	8	9	10	11	12	13	14
Row 11	1	2	3	4	5	6	7	8	9	10	11	12	13	14
Row 10	1	2	3	4	5	6	7	8	9	10	11	12	13	14
Row 9	1	2	3	4	5	6	7	8	9	10	11	12	13	14
Row 8	1	2	3	4	5	6	7	8	9	10	11	12	13	14
Row 7	1	2	3	4	5	6	7	8	9	10	11	12	13	14
Row 6	1	2	3	4	5	6	7	8	9	10	11	12	13	14
Row 5	1	2	3	4	5	6	7	8	9	10	11	12	13	14
Row 4	1	2	3	4	5	6	7	8	9	10	11	12	13	14
Row 3	1	2	3	4	5	6	7	8	9	10	11	12	13	14
Row 2	1	2	3	4	5	6	7	8	9	10	11	12	13	14
Row 1	1	2	3	4	5	6	7	8	9	10	11	12	13	14

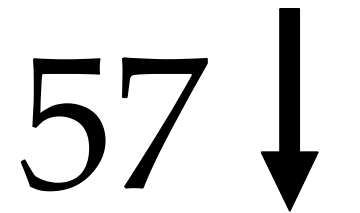

Row 16	1	2	3	4	5	6	7	X	X	10	11	12	13	14	15	16	17	18	19	20	21	22	23	24	25	26	27	28	29	30	31	32	33	34	35	36	37	38	39	40	41	42	43	44	45	46	47	48	49	50	51	52	53	54	55	56	57	58	59	60	61	62	63	64	65	66	67	68	69	70
Row 15	1	2	3	4	5	6	7	8	9	10	11	12	13	14	15	16	17	18	19	20	21	22	23	24	25	26	27	28	29	30	31	32	33	34	35	36	37	38	39	40	41	42	43	44	45	46	47	48	49	50	51	52	53	54	55	56	57	58	59	60	61	62	63	64	65	66	67	68	69	70
Row 14	1	2	3	4	5	6	7	8	9	10	11	12	13	14	15	16	17	18	19	20	21	22	23	24	25	26	27	28	29	30	31	32	33	34	35	36	37	38	39	40	41	42	43	44	45	46	47	48	49	50	51	52	53	54	55	56	57	58	59	60	61	62	63	64	65	66	67	68	69	70
Row 13	1	2	3	4	5	6	7	8	9	10	11	12	13	14	15	16	17	18	19	20	21	22	23	24	25	26	27	28	29	30	31	32	33	34	35	36	37	38	39	40	41	42	43	44	45	46	47	48	49	50	51	52	53	54	55	56	57	58	59	60	61	62	63	64	65	66	67	68	69	70
Row 12	1	2	3	4	5	6	7	8	9	10	11	12	13	14	15	16	17	18	19	20	21	22	23	24	25	26	27	28	29	30	31	32	33	34	35	36	37	38	39	40	41	42	43	44	45	46	47	48	49	50	51	52	53	54	55	56	57	58	59	60	61	62	63	64	65	66	67	68	69	70
Row 11	1	2	3	4	5	6	7	8	9	10	11	12	13	14	15	16	17	18	19	20	21	22	23	24	25	26	27	28	29	30	31	32	33	34	35	36	37	38	39	40	41	42	43	44	45	46	47	48	49	50	51	52	53	54	55	56	57	58	59	60	61	62	63	64	65	66	67	68	69	70
Row 10	1	2	3	4	5	6	7	8	9	10	11	12	13	14	15	16	17	18	19	20	21	22	23	24	25	26	27	28	29	30	31	32	33	34	35	36	37	38	39	40	41	42	43	44	45	46	47	48	49	50	51	52	53	54	55	56	57	58	59	60	61	62	63	64	65	66	67	68	69	70
Row 9	1	2	3	4	5	6	7	8	9	10	11	12	13	14	15	16	17	18	19	20	21	22	23	24	25	26	27	28	29	30	31	32	33	34	35	36	37	38	39	40	41	42	43	44	45	46	47	48	49	50	51	52	53	54	55	56	57	58	59	60	61	62	63	64	65	66	67	68	69	70
Row 8	1	2	3	4	5	6	7	8	9	10	11	12	13	14	15	16	17	18	19	20	21	22	23	24	25	26	27	28	29	30	31	32	33	34	35	36	37	38	39	40	41	42	43	44	45	46	47	48	49	50	51	52	53	54	55	56	57	58	59	60	61	62	63	64	65	66	67	68	69	70
Row 7	1	2	3	4	5	6	7	8	9	10	11	12	13	14	15	16	17	18	19	20	21	22	23	24	25	26	27	28	29	30	31	32	33	34	35	36	37	38	39	40	41	42	43	44	45	46	47	48	49	50	51	52	53	54	55	56	57	58	59	60	61	62	63	64	65	66	67	68	69	70
Row 6	1	2	3	4	5	6	7	8	9	10	11	12	13	14	15	16	17	18	19	20	21	22	23	24	25	26	27	28	29	30	31	32	33	34	35	36	37	38	39	40	41	42	43	44	45	46	47	48	49	50	51	52	53	54	55	56	57	58	59	60	61	62	63	64	65	66	67	68	69	70
Row 5	1	2	3	4	5	6	7	8	9	10	11	12	13	14	15	16	17	18	19	20	21	22	23	24	25	26	27	28	29	30	31	32	33	34	35	36	37	38	39	40	41	42	43	44	45	46	47	48	49	50	51	52	53	54	55	56	57	58	59	60	61	62	63	64	65	66	67	68	69	70
Row 4	1	2	3	4	5	6	7	8	9	10	11	12	13	14	15	16	17	18	19	20	21	22	23	24	25	26	27	28	29	30	31	32	33	34	35	36	37	38	39	40	41	42	43	44	45	46	47	48	49	50	51	52	53	54	55	56	57	58	59	60	61	62	63	64	65	66	67	68	69	70
Row 3	1	2	3	4	5	6	7	8	9	10	11	12	13	14	15	16	17	18	19	20	21	22	23	24	25	26	27	28	29	30	31	32	33	34	35	36	37	38	39	40	41	42	43	44	45	46	47	48	49	50	51	52	53	54	55	56	57	58	59	60	61	62	63	64	65	66	67	68	69	70
Row 2	1	2	3	4	5	6	7	8	9	10	11	12	13	14	15	16	17	18	19	20	21	22	23	24	25	26	27	28	29	30	31	32	33	34	35	36	37	38	39	40	41	42	43	44	45	46	47	48	49	50	51	52	53	54	55	56	57	58	59	60	61	62	63	64	65	66	67	68	69	70
Row 1	1	2	3	4	5	6	7	8	9	10	11	12	13	14	15	16	17	18	19	20	21	22	23	24	25	26	27	28	29	30	31	32	33	34	35	36	37	38	39	40	41	42	43	44	45	46	47	48	49	50	51	52	53	54	55	56	57	58	59	60	61	62	63	64	65	66	67	68	69	70

Scale : NTS

CAPACITY IN GRAVESITES						
SECTION	SIZE OF GRAVESITE	TOTAL	SET ASIDE	AVAIL	ORST	REMARKS
57	3 x 3			SEE GRST		
58	3 x 3					
59	3 x 3					

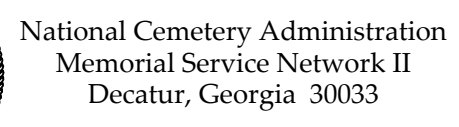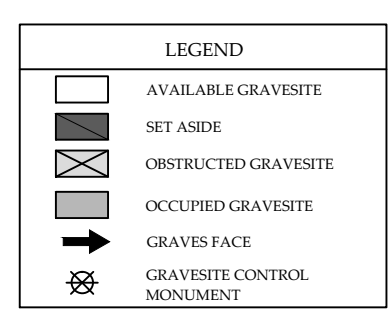
2/9/2017 1:06:31 PM



Update and BOSS Reconcile	2/9/17
Update and BOSS Reconcile	8/18/16
Update and BOSS Reconcile	2/17/16
Update and BOSS Reconcile	8/14/15
Update and BOSS Reconcile	3/3/15
Update and BOSS Reconcile	9/2/14
Update and BOSS Reconcile	4/1/14
Update/Redraw/BOSS Reconcile	10/2/13
Revisions	Date

CAPACITY IN GRAVESTES						
SECTION	SIZE OF GRAVESTITE	TOTAL	SET ASIDE	AVAIL	ORST	REMARKS
60	3 x 3			SEE GRST		
61	3 x 3					

Scale : NTS




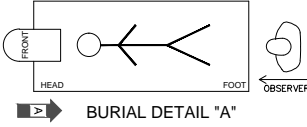


LEGEND	
	AVAILABLE GRAVESTITE
	SET ASIDE
	OCCUPIED GRAVESTITE
	GRAVES FACE
	GRAVESTITE CONTROL MONUMENT




National Cemetery Administration  
Memorial Service Network II  
Decatur, Georgia 30033

Drawing Title <b>Sections 60-61 Layout Drawing</b>		Project: <b>Bay Pines National Cemetery</b>	Date: <b>3/25/10</b>
Approved: Area Director		Location: <b>Bay Pines, FL</b>	Project No.
Approved: Cemetery Director		Building Number	Checked
			Drawn <b>DCJ</b>
		Path: \\Cemata101\share\MSN II Drawings\Bay Pines\Updated Layout	Drawing Title: <b>Sections 57-59 / 60-61 Working</b>
			Dwg. Of

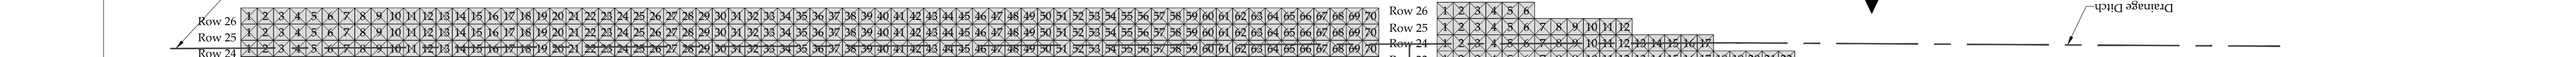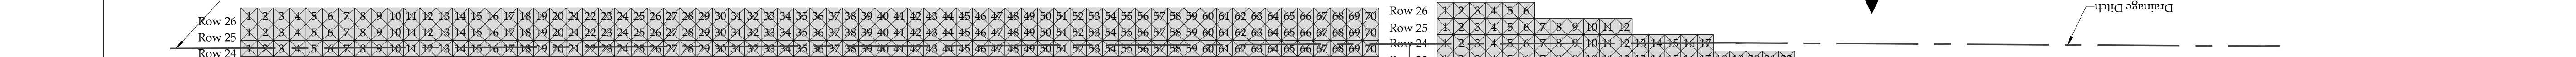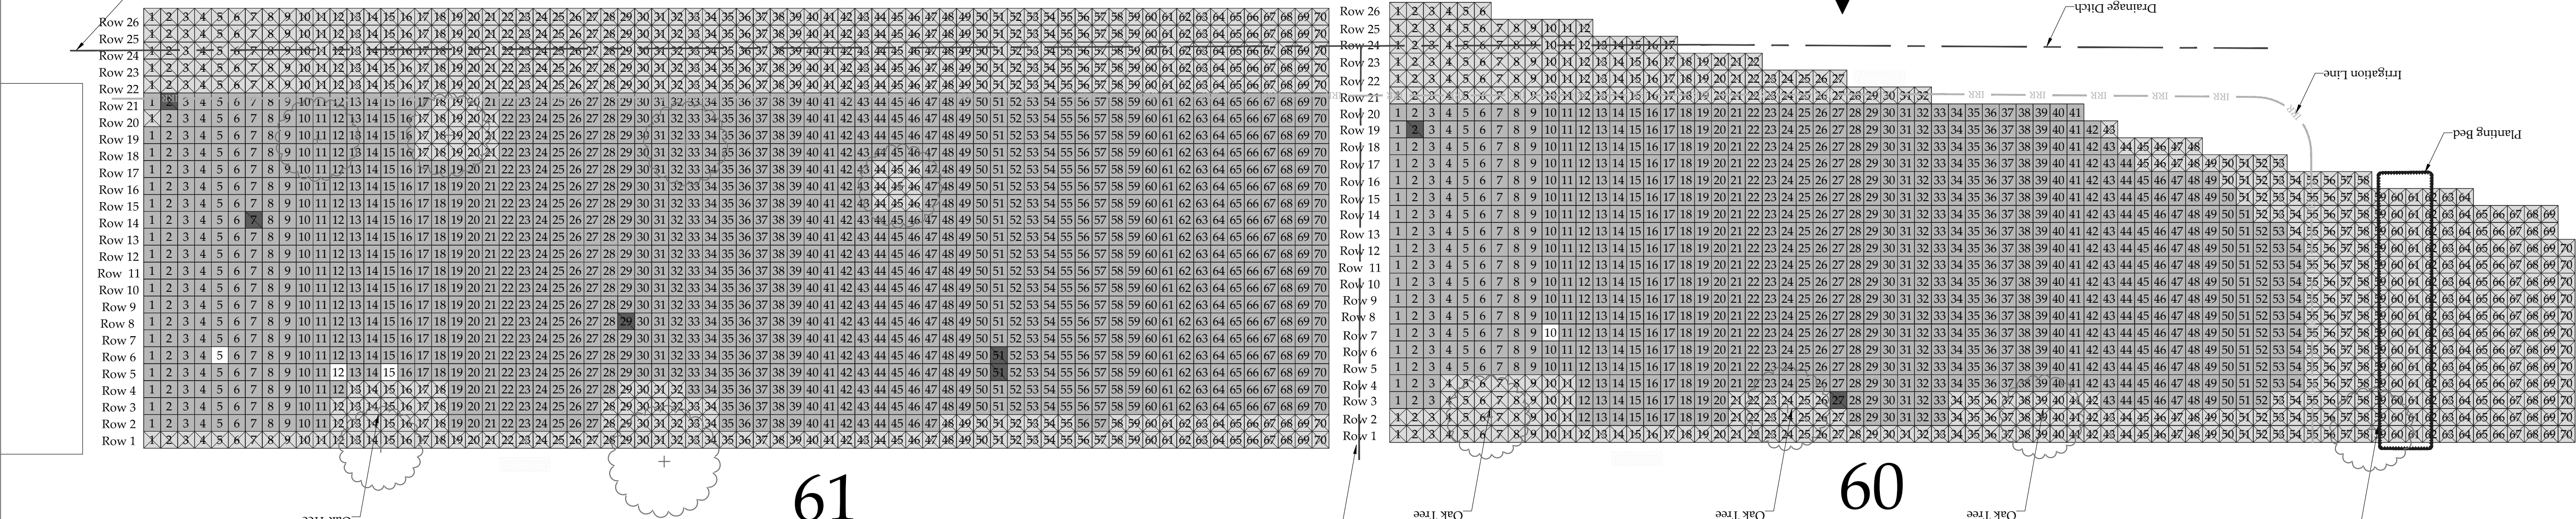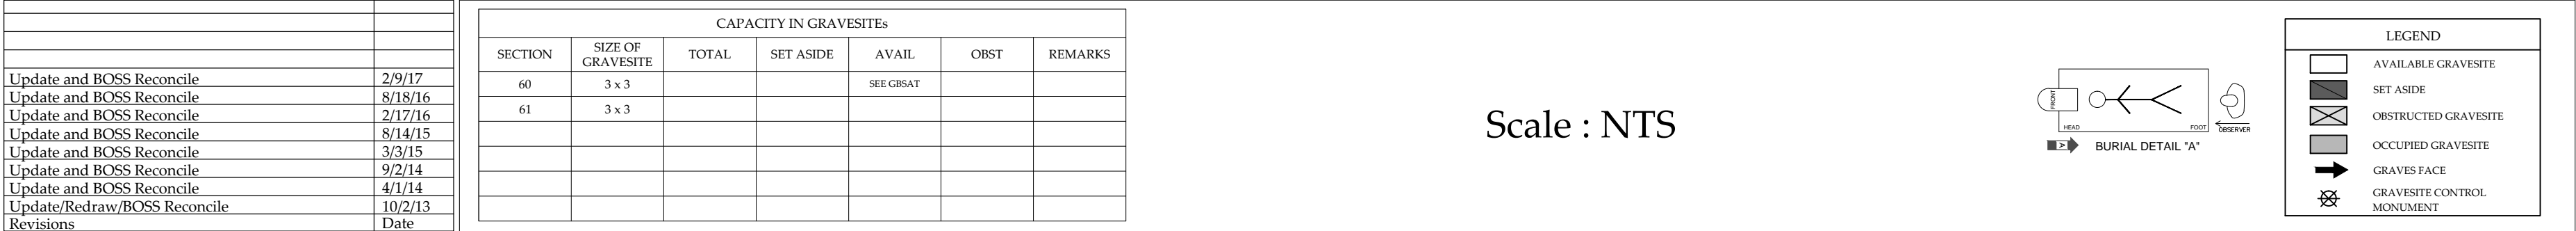



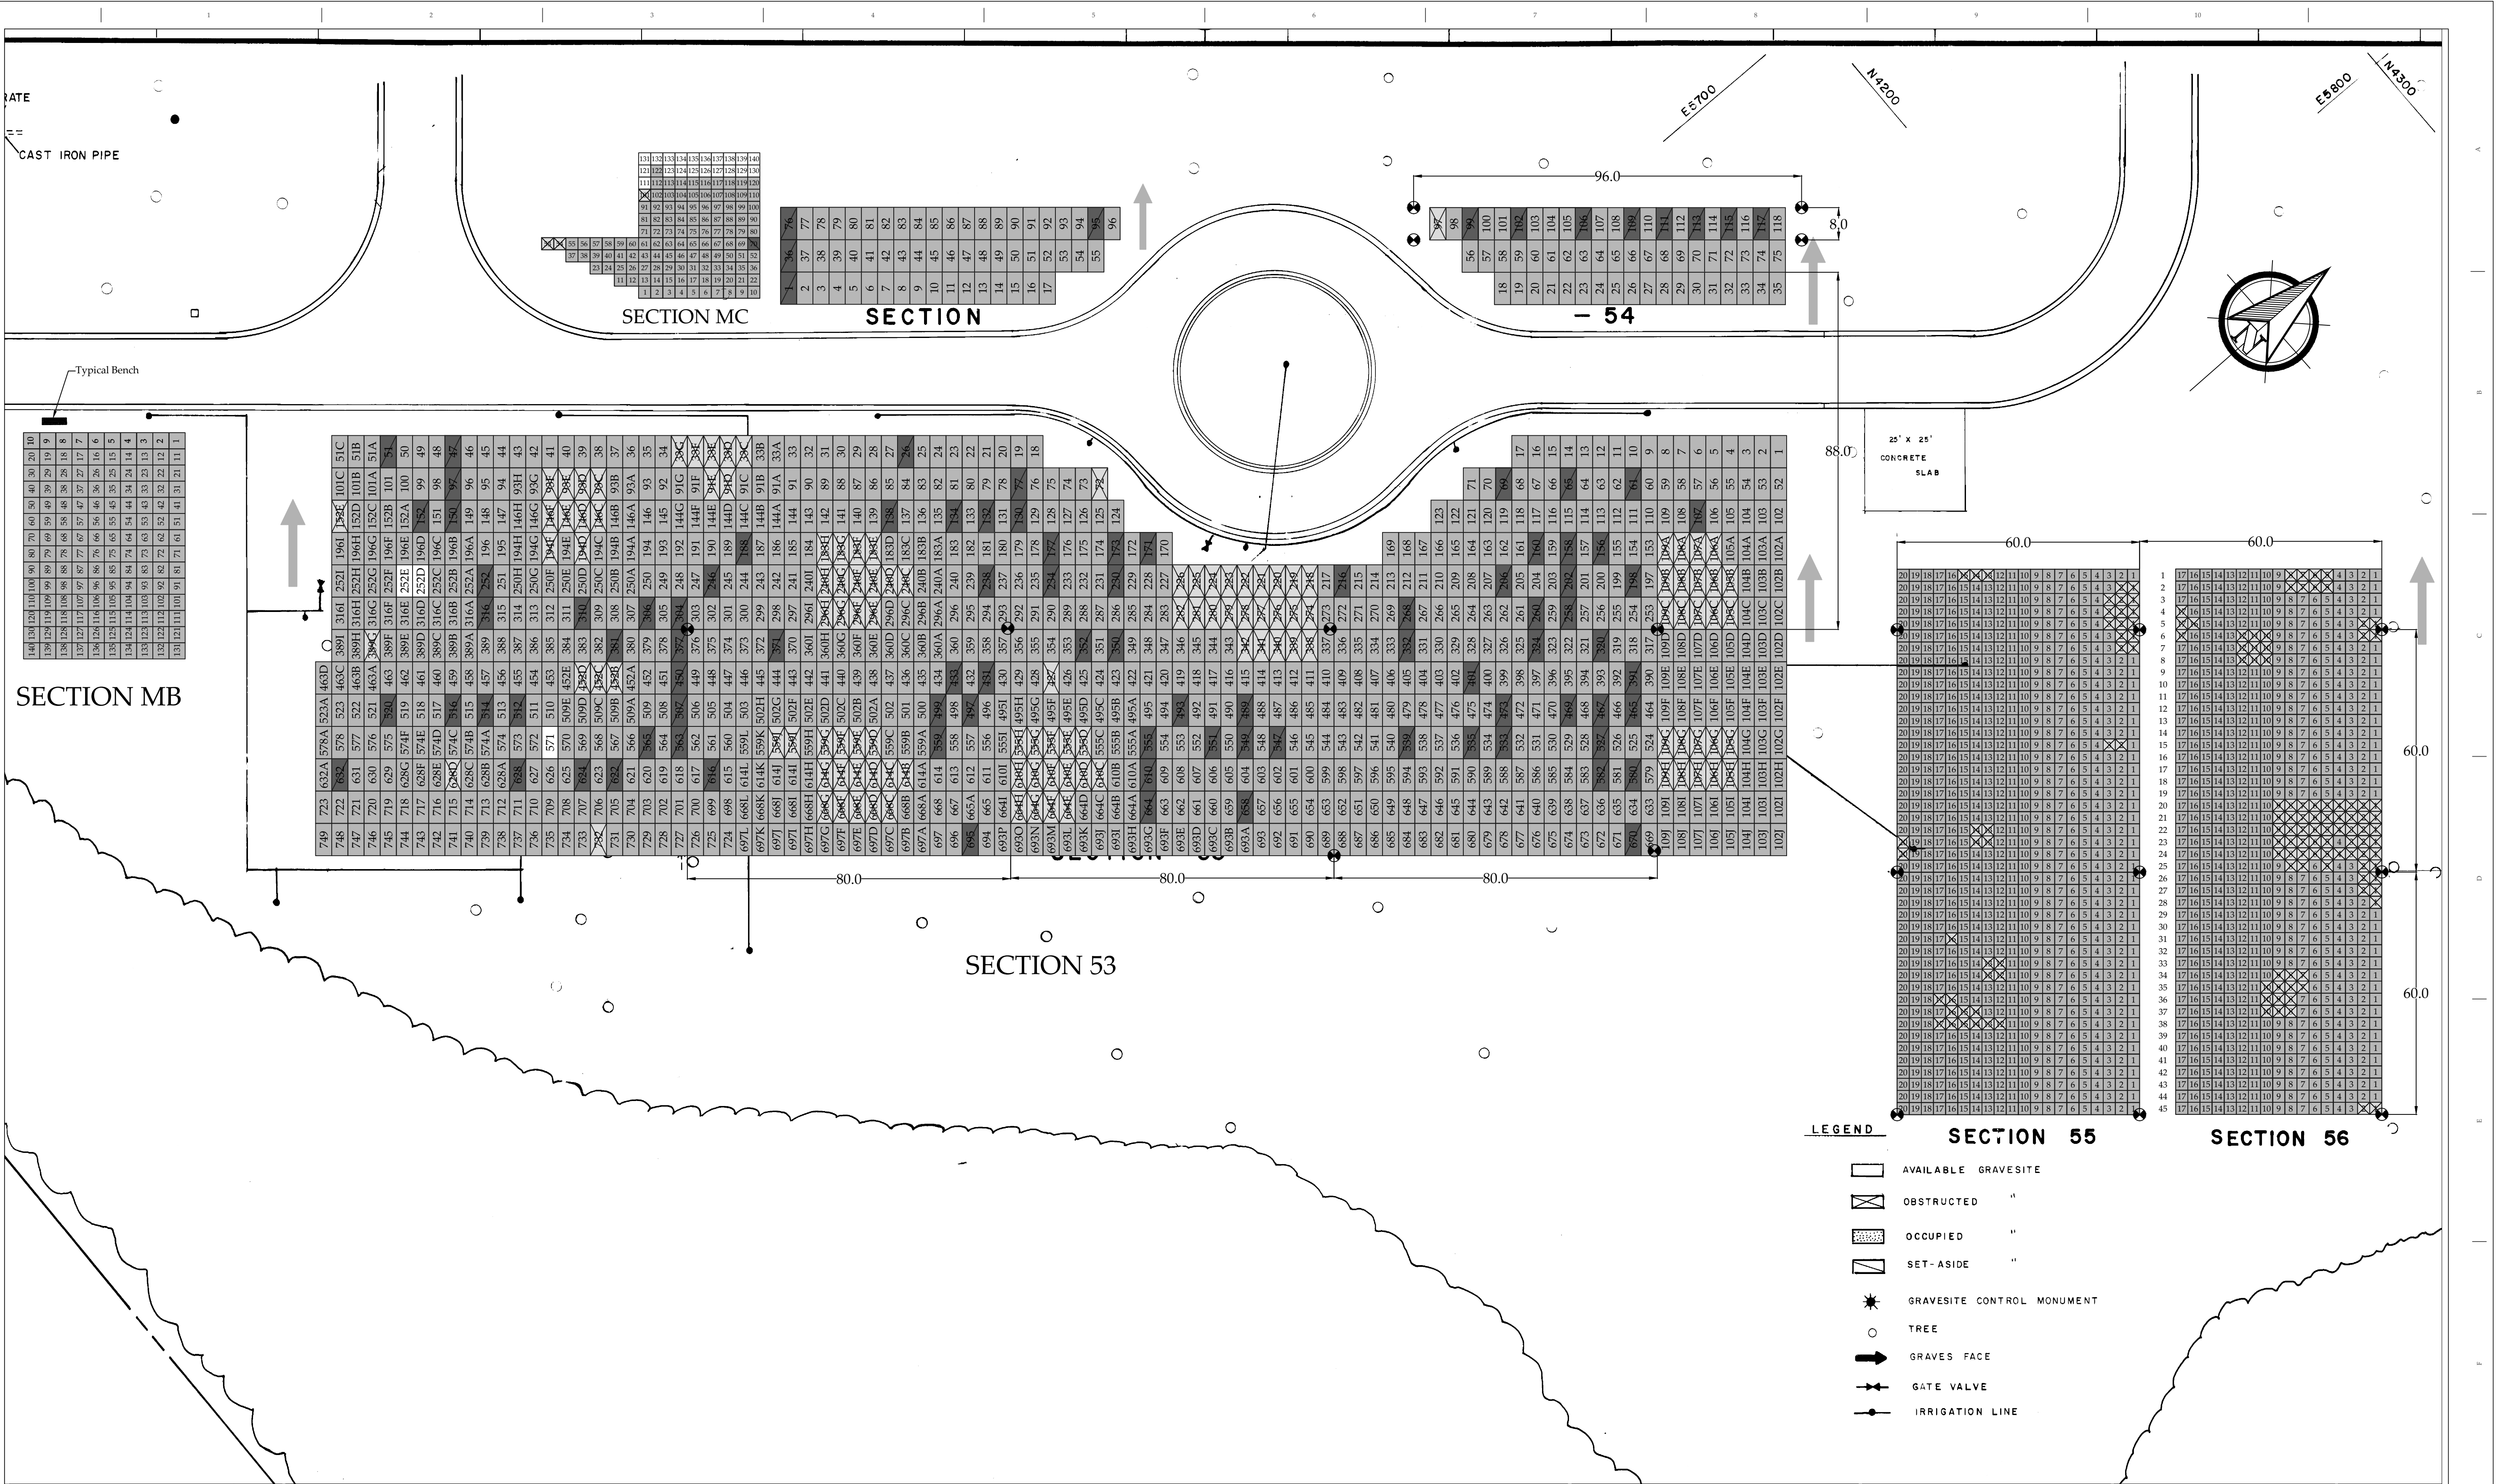

SECTION	SIZE OF GRAVESITE	TOTAL	RES	AVAIL	OBST.	REMARKS
53	4 X 8			SEE GBSAT		
54	4 X 8					
MC	3 X 3					
MB	3 X 3					
55-56	4 X 4					

Scale 1 : 20 (Not Exact)

LEGEND

- AVAILABLE GRAVESITE
- SET ASIDE
- OBSTRUCTED GRAVESITE
- OCCUPIED GRAVESITE
- GRAVES FACE
- GRAVESITE CONTROL MONUMENT

VA FORM 08-6231, FEB. 1983

2/9/2017 1:02:47 PM

Drawing Title

Sections 53-56/MC & MB

Layout Drawing

Approved: Area Director

Approved: Cemetery Director

Project Title

Bay Pines National Cemetery

Location

Bay Pines, FL

Date


Project No.

DRAWING NO.


830LA05-4

Dwg. CR



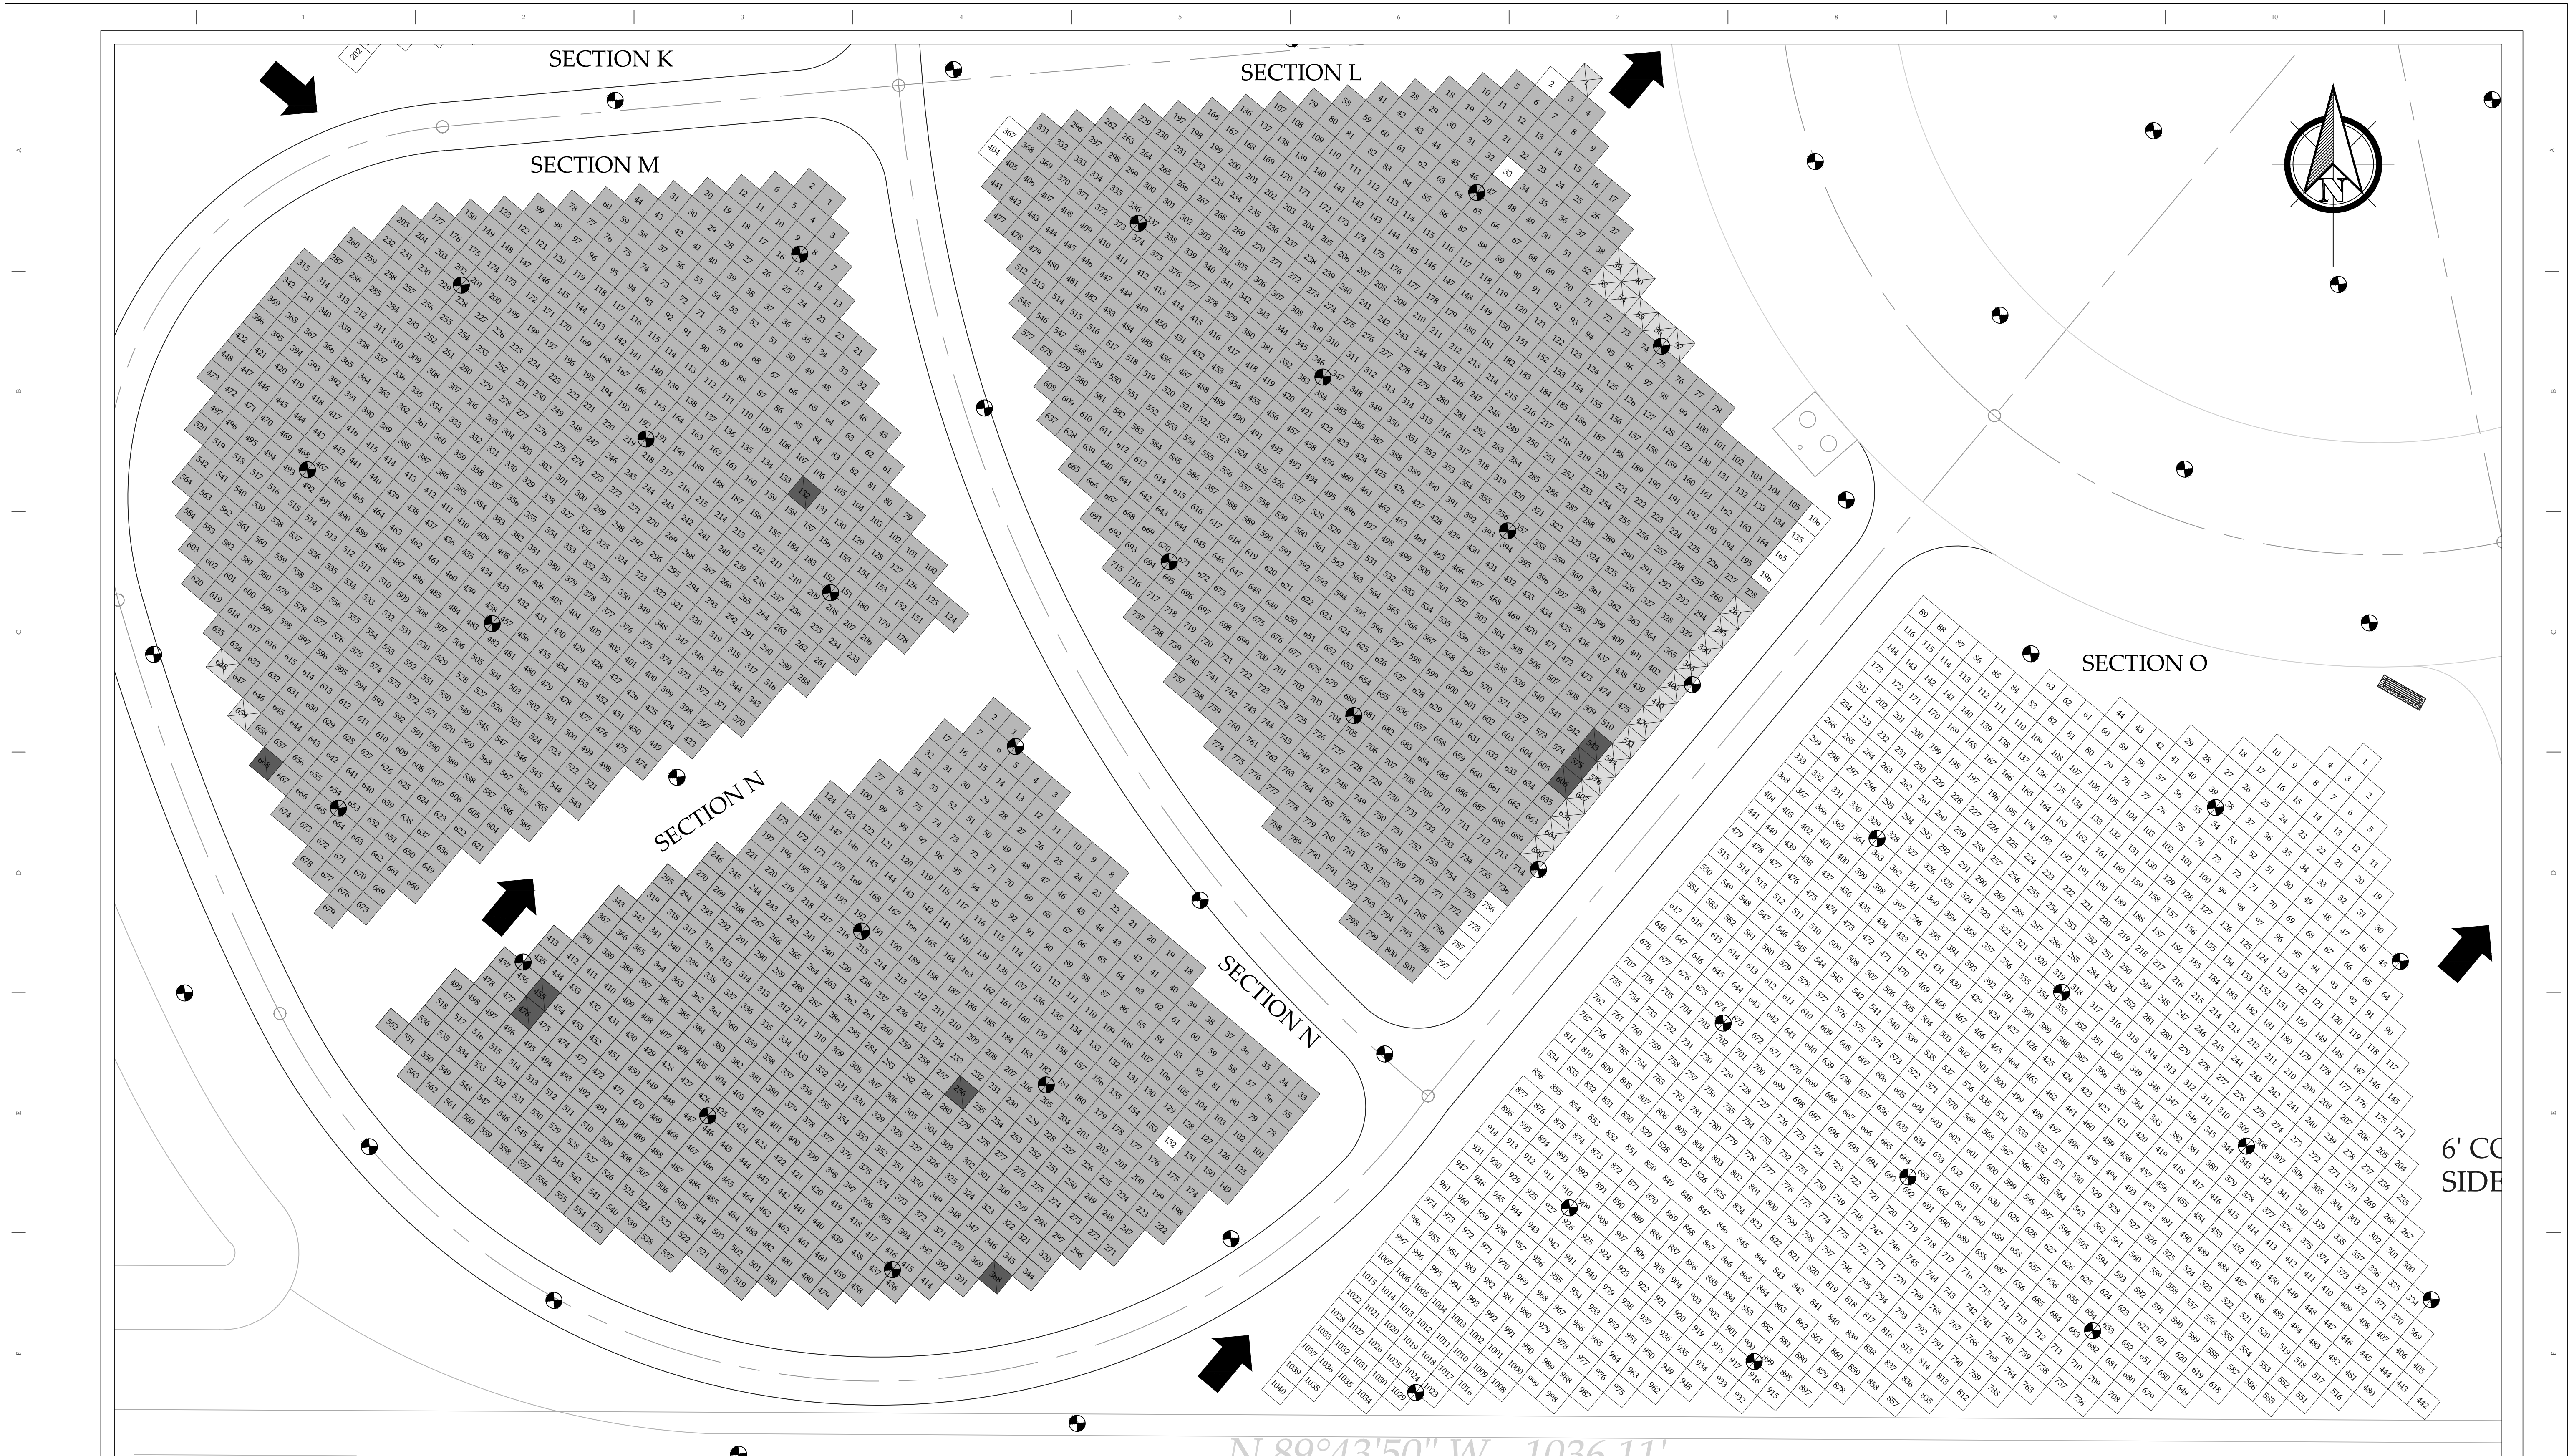

Scale 1 : 10

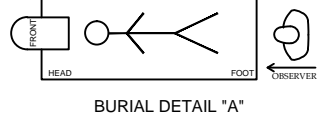

LEGEND	
	AVAILABLE GRAVESITE
	SET ASIDE
	OCCUPIED GRAVESITE
	GRAVES FACE
	GRAVESITE CONTROL MONUMENT



National Cemetery Administration  
Memorial Service Network II  
Decatur, Georgia 30033


Drawing Title Sections L - O Layout Drawing		Project Title Bay Pines National Cemetery		Date
Approved: Area Director		Building Number		Project No.
Approved: Cemetery Director		Checked		Drawn
		Location Bay Pines, FL		DRAWING NO. 8301a100-5
				Dwg. Of

CAPACITY IN GRAVESITES	
SECTION	SIZE OF GRAVESITE
L	3 X 3
M	3 X 3
N	3 X 3
O	3 X 3

TOTAL	RES	AVAIL	OBST.	REMARKS
SEE GBSAT				

Update and BOSS Reconcile	2/9/17
Update and BOSS Reconcile	8/18/16
Update and BOSS Reconcile	2/17/16
Update and BOSS Reconcile	8/14/15
Update and BOSS Reconcile	3/3/15
Update and BOSS Reconcile	9/2/14
Update and BOSS Reconcile	4/1/14
Update/Redraw/BOSS Reconcile	10/2/13
Revisions	Date



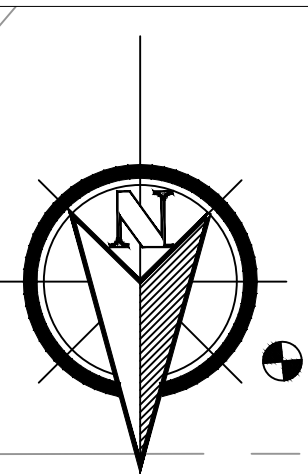

SECTION C

SECTION B

SECTION R

SECTION S

SECTION P

SECTION Q

TYPICAL  
BENCH


FF EL=10.00

SECTION T

Update and BOSS Reconcile	2/9/17
Update and BOSS Reconcile	8/18/16
Update and BOSS Reconcile	2/17/16
Update and BOSS Reconcile	8/17/15
Correction to Section Q	3/31/15
Update and BOSS Reconcile	3/3/15
Update and BOSS Reconcile	9/2/14
Update and BOSS Reconcile	4/1/14
Update/Redraw/BOSS Reconcile	10/3/13
Semi-Annual Update	4/2/13
Revisions	Date

CAPACITY IN GRAVESITES						
SECTION	SIZE OF GRAVESITE	TOTAL	RES	AVAIL	OBST.	REMARKS
P	3 X 3	SEE GBSAT				
Q	3 X 3					
R	3 X 3					
S	3 X 3					

Scale 1 : 10

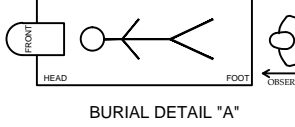

LEGEND	
	AVAILABLE GRAVESITE
	SET ASIDE
	OBSTRUCTED GRAVESITE
	OCCUPIED GRAVESITE
	GRAVES FACE
	GRAVESITE CONTROL MONUMENT



National Cemetery Administration  
Memorial Service Network II  
Decatur, Georgia 30033

Drawing Title	Sections P - S Layout Drawing	Project Title	Bay Pines National Cemetery	Date	
Approved: Area Director		Building Number	Checked	Drawn	Project No.
Approved: Cemetery Director		Location	Bay Pines, FL	DCJ	DRAWING NO. 8301a100-6
				Dwg.	OR