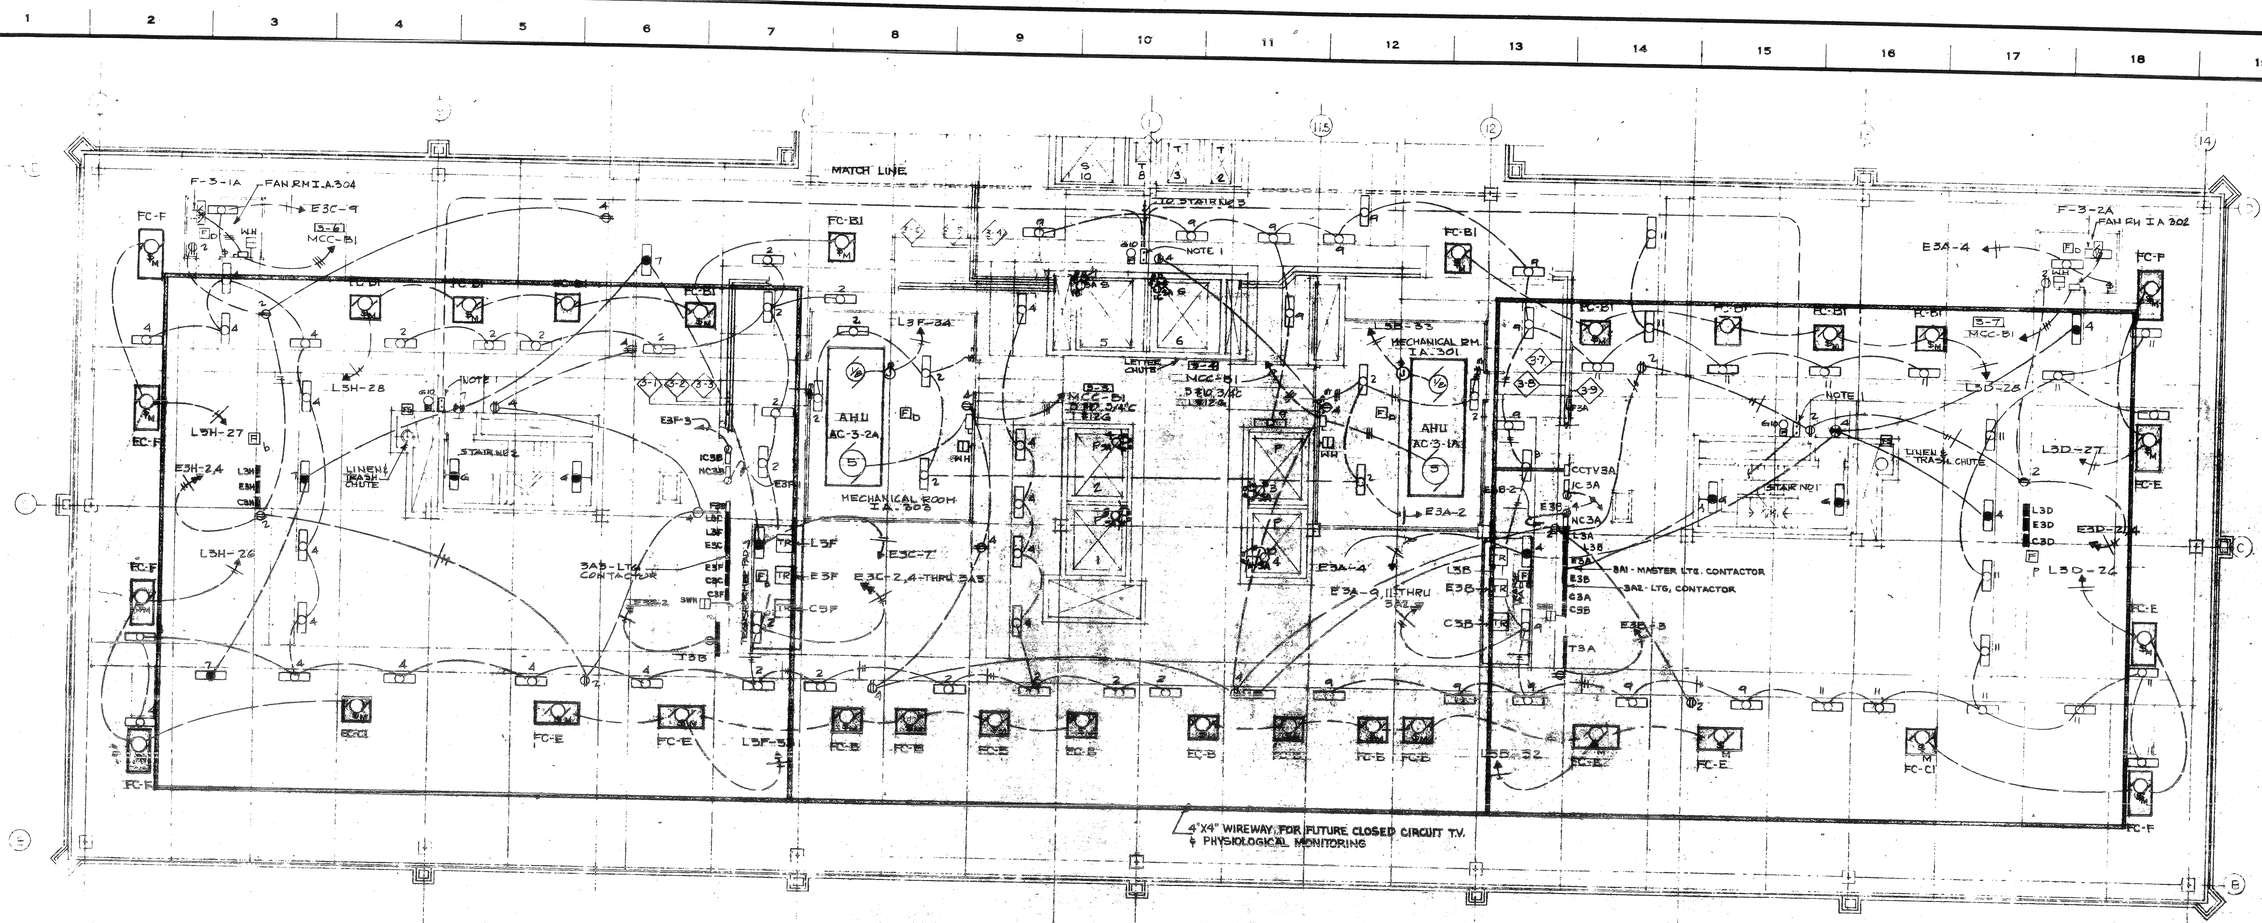

1/69 INTERSTITIAL SPACE THIRD FLOOR AREA A

SCALE: 1/8"= 1'-0"

REFERENCE IDENTIFICATION PLANS

8' 6' 4' 2' 0 8'

1/8" = 1'0"

NOTE:

1. ON-OFF PUSHBUTTON SWITCH TO CONTROL LIGHTING CONTACTOR; REFER TO DWG. 1-E6 FOR LIGHTING CONTROL DIAGRAM.
2. REFER TO DWG 1-E106, LIGHTING FIXTURE HANGER DETAILS
3. ALL LIGHTING FIXTURES ARE TYPE "E4" UNLESS OTHERWISE NOTED.
4. REFER TO DWG 1-E106 FOR PANEL CABINET & EQUIPMENT MOUNTING.

AS-BUILT DRAWING

KEY PLAN

INTERST. SPACE 3RD FLR AREA A

BUILDING NO 1 SCALE 1/8"= 1'-0"

760 BED M. S. & N. AND PSYCHIATRIC HOSPITAL

VETERANS ADMINISTRATION

SAN ANTONIO, TEXAS

Drawn DA GH Date

Checked AA Date

COLEMON & ROLFE ARCHITECTS

SAN ANTONIO ASSOCIATED ARCHITECTS:

NOONAN, KROCKER & ROGERS ARCHITECTS & ENGINEERS

EDWARD R. GONDECK, ARCHITECT

WILLIAM E. PARRISH, ARCHITECT

ADAMS & ADAMS, ARCHITECTS

REVISIONS

DRAWING NUMBER

1-E 69

Sheet 75 of 164

Proj. No. 42-5363

THREE INCHES EQUALS ONE FOOT

ONE AND ONE HALF INCHES EQUALS ONE FOOT

ONE INCH EQUALS ONE FOOT

THREE QUARTER INCH EQUALS ONE FOOT

ONE HALF INCH EQUALS ONE FOOT

THREE EIGHTH INCH EQUALS ONE FOOT

ONE QUARTER INCH EQUALS ONE FOOT

ONE EIGHTH INCH EQUALS ONE FOOT