



















 Audiology	608 SF
 Behavioral Health	1,910 SF
 Canteen Service	9,964 SF
 Chaplain/Chapel	2,804 SF
 Common Space/Lobby Space	25,477 SF
 Diagnostic Imaging	1,170 SF
 Director's Suite/Quality Management	6,587 SF
 Fiscal Service	596 SF
 Healthcare Admin Service	4,793 SF
 Medical Media	2,295 SF
 Nursing Service Admin	2,627 SF
 On-Call Program	203 SF
 Pharmacy	4,417 SF
 Police/Security	2,008 SF
 Primary Care	25,214 SF
 Psychosocial Rehabilitation and Recovery Center (PRRC)	3,749 SF
 Recreational Therapy	2,784 SF
 Space Under Construction	11,783 SF
 Urgent Care	6,887 SF
 Voluntary Service	861 SF
 VSO/Vet Assistance/Union	1,069 SF
	117,805 SF

FIRST FLOOR PLAN


[illegible]

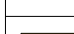


Gross Building Area	
Not Placed	0 SF
MB-0D-PIPE BASEMENT	8,351 SF
MB-0A-BASEMENT	91,848 SF
MB-1-FIRST FLOOR	117,805 SF
MB-2-SECOND FLOOR	101,361 SF
MB-3-THIRD FLOOR	95,047 SF
MB-4-FOURTH FLOOR	44,501 SF
MB-5-FIFTH FLOOR	40,408 SF
MB-6-SIXTH FLOOR	31,225 SF
MB-7-SEVENTH FLOOR	30,869 SF
MB-8-EIGHTH FLOOR	25,766 SF
MB-9-NINTH FLOOR	18,785 SF
MB-10-PENTHOUSE	4,670 SF
MB-11-MECHANICAL	3,067 SF

Department Area Legend	
Bed Medical/Surgical	6,849 SF
Behavioral Health	307 SF
Common Space/Lobby Space	11,757 SF
Inpatient Psychiatry and Substance Abuse	623 SF
Medical Service Admin	4,781 SF
Pharmacy	3,122 SF
Space Under Construction	6,160 SF
Specialty Care	6,808 SF
	40,408 SF

FIFTH FLOOR PLAN
Scale: 1/16" = 1'-0"

CONSULTANTS:		ARCHITECT/ENGINEERS:		Drawing Title		Project Title		Project No.		Office of Construction and Facilities Management Department of Veterans Affairs			
		 JOHN POE ARCHITECTS 3131 Newmark Drive, Suite 200 Miamisburg, OHIO 45342 937 461 3290 jpa@johnpoe.com		CAI - FIFTH FLOOR		VISN 10 Maintain BIM		VA Project No. #552-15-001 JPA Project No. 15005.00					
				Reviewed for Concept Only		Location Cincinnati, Ohio		Building Number 01					
						Date July 29, 2016		Checked Drawn		Drawing Number CAI-1.5			
Revision		Date						Dwg. of					

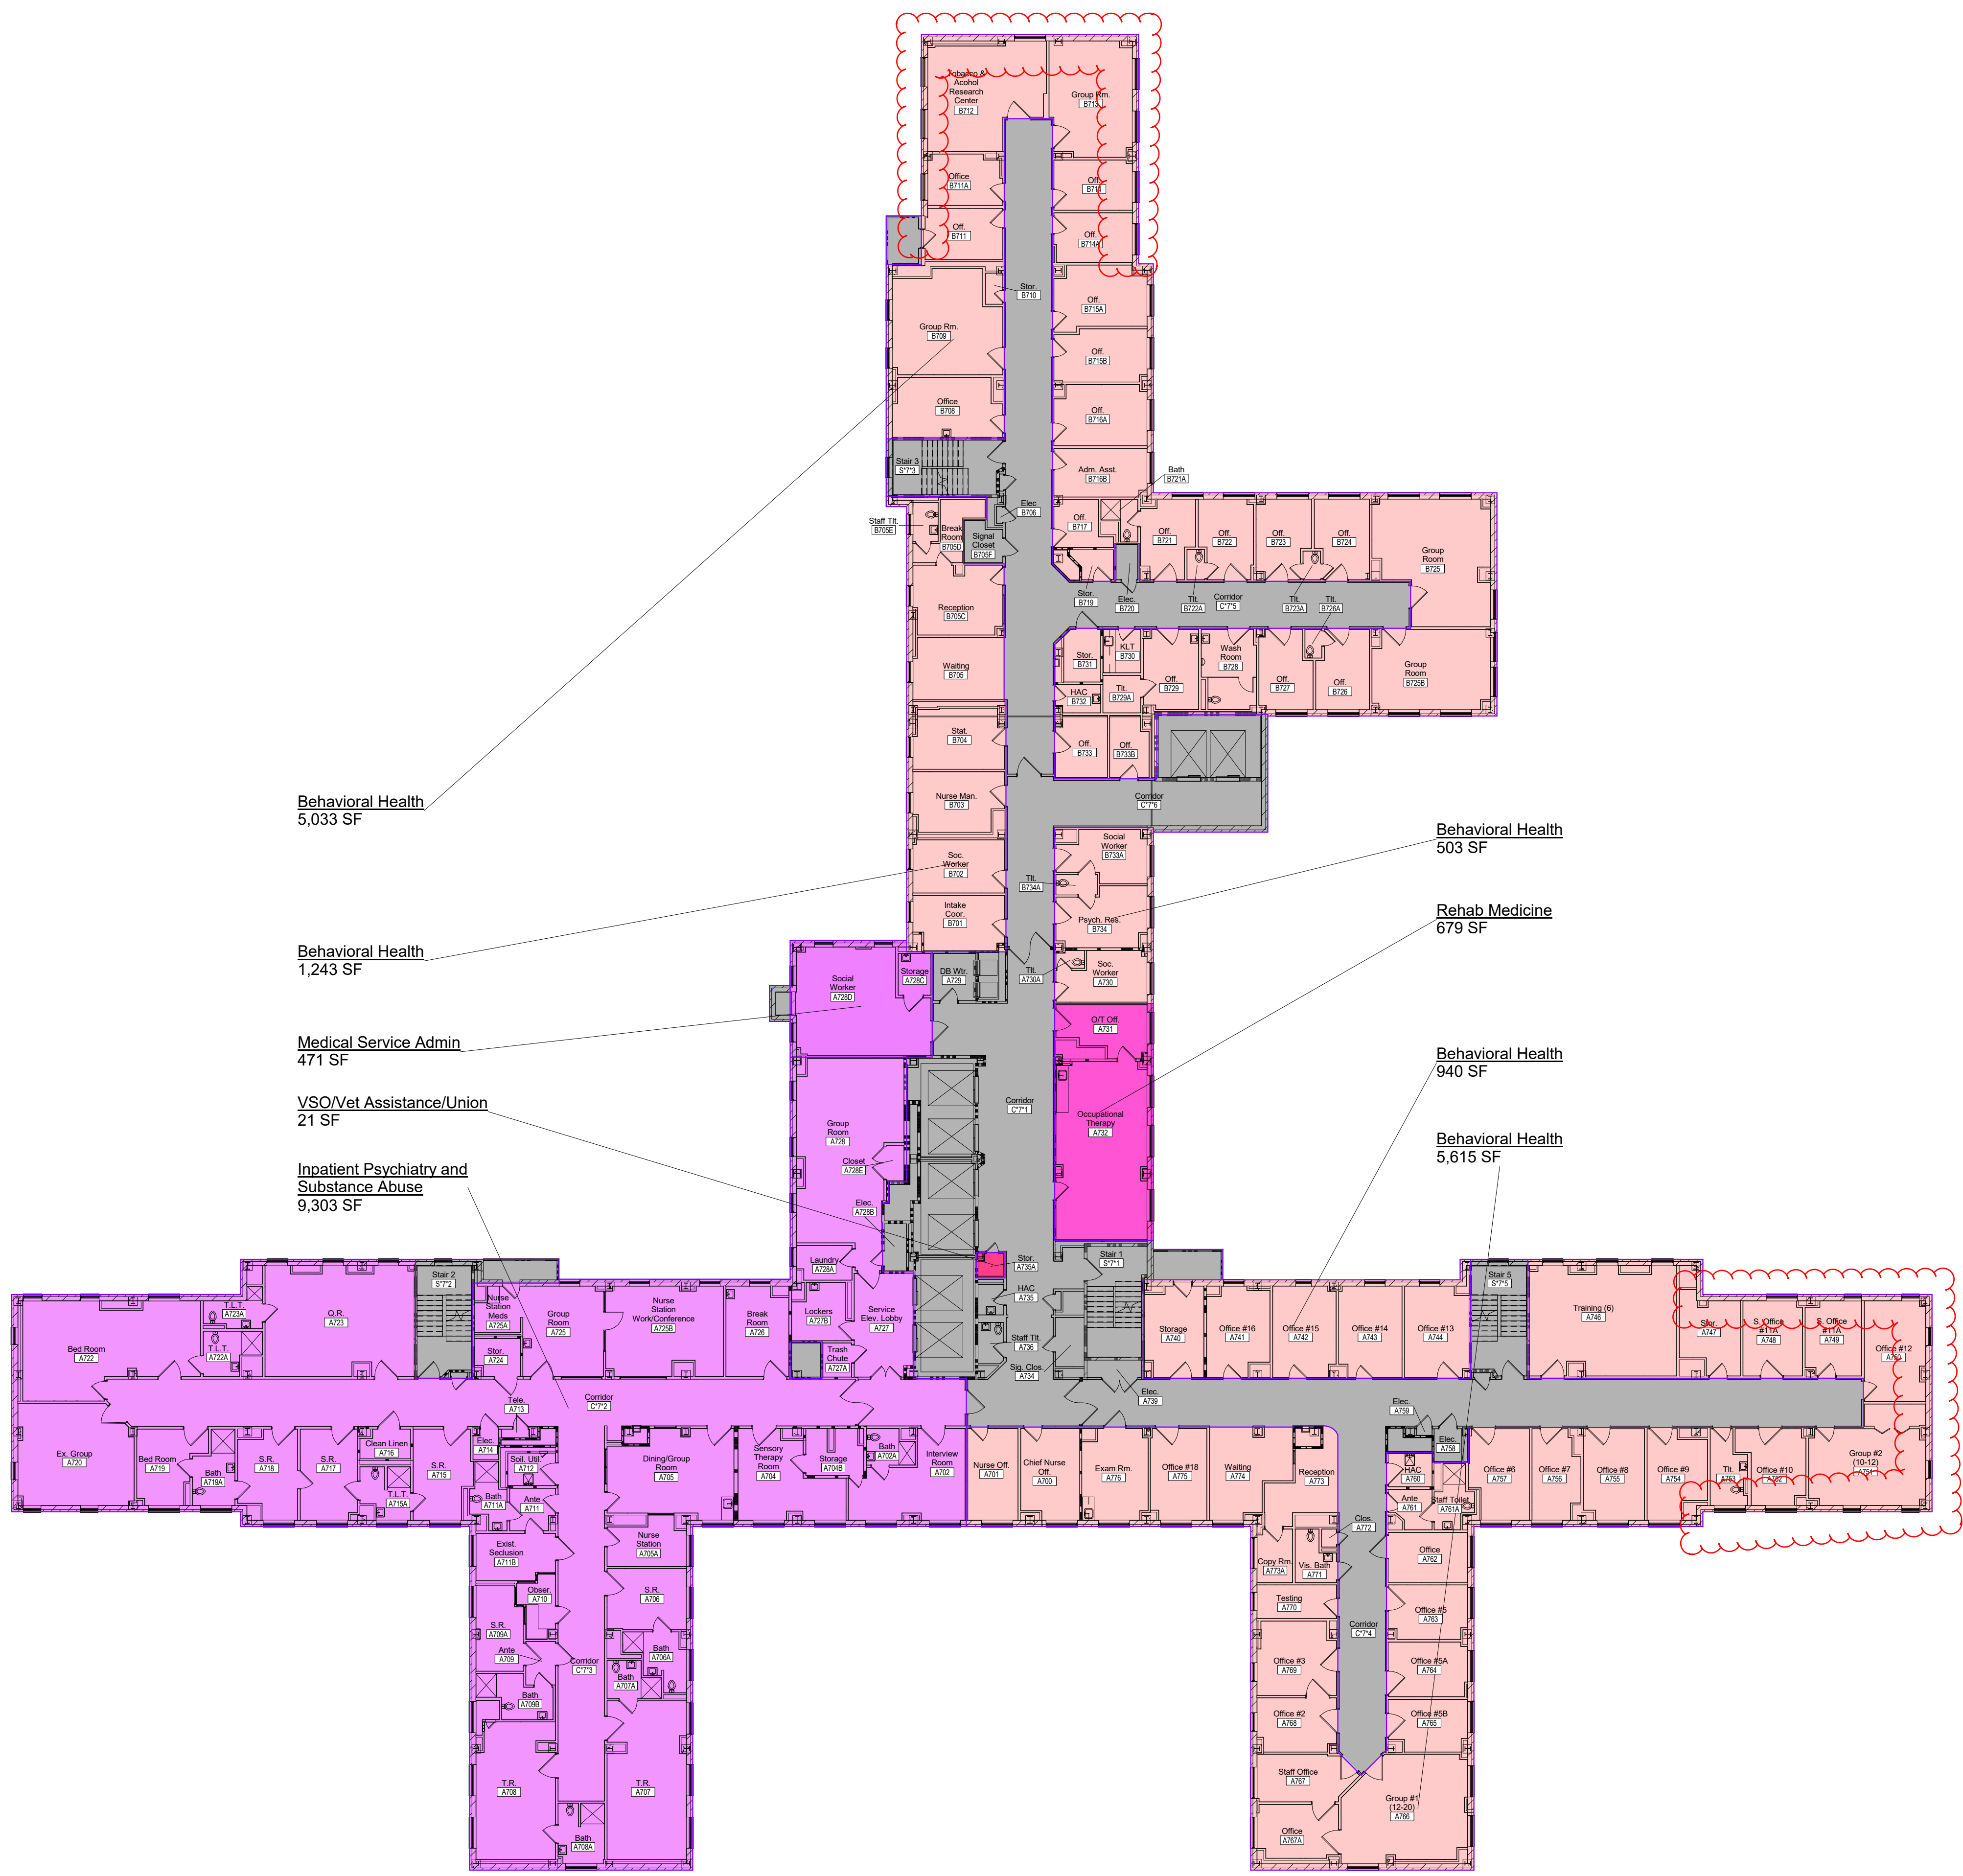

SEVENTH FLOOR PLAN
Scale: 1/16" = 1'-0"

																																																																																																																																																																																																																																																																																																																																																																																																																																																																																																																																																																																																																																																																																																																																																																																																																																																																																																																																																																																																																																																																																																																																																																																																																																																																																																																																																																																																																																																																																																																																																												</
--	--	----