


EQUIPMENT SCHEDULE						
MARK	ITEM	OWNER PROVIDED	OWNER INSTALLED	CONTRACTOR PROVIDED	CONTRACTOR INSTALLED	NOTES
1	FLAT PANEL TV MOUNT			X	X	1.
2	FLAT PANEL TV	X			X	1.
3	EXAM TABLE	X				
4	VACUUM	X			X	
5	DESK, CHAIR, BOOK SHELF	X			X	
6	PATIENT CHAIRS	X			X	
7	VIEW BOX	X			X	
8	ORTHO CART	X			X	
9	REFRIGERATOR	X			X	5.
10	MICROWAVE	X			X	
11	STORAGE CABINETS	X			X	
12	SIGMOID CART AND MONITOR	X			X	
13	SCOPE CABINETS	X			X	
14	1000 LB PATIENT LIFT, LINEAR RAIL			X	X	2.
15	600 LB PATIENT LIFT, X-Y RAIL			X	X	
15A	600 LB PATIENT LIFT, LINEAR RAIL			X	X	
16	1000 LB PATIENT LIFT, X-Y RAIL			X	X	
17	CYSTO SCOPE	X			X	
18	TELEMED	X			X	
19	LIGHT FIXTURE, SEE ELEC DWG'S			X	X	3.
20	PHROPTER	X			X	
21	EXAM CHAIR	X			X	
22	PROJECTOR FLATE	X			X	
23	TANGENT SCREEN	X			X	
24	EYE GLASS HOLDER	X			X	
25	WORK TABLE	X			X	
26	TOOL HOLDER	X			X	
26A	MIRROR	X			X	
27	PROJECTOR	X			X	
28	COPIER	X			X	
29	LENSOMETER/FILE CABINET	X			X	
30	TELE-AUDIOLOGY MONITOR	X			X	
31	AUDIO CHAIR	X			X	
32	PORCORN MAKER	X			X	
33	ICE CREAM MAKER	X			X	
34	COFFEE CART	X			X	
35	PROJECTOR	X			X	
36	PROJECTOR SCREEN	X			X	8.
37	SCALE	X			X	
38	OCT	X			X	
39	FIRE EXTINGUISHER CABINET			X	X	4.
40	ABR/GAE CART AND PRINTER	X			X	
41	VERIFY DESK	X			X	
42	WINDOW SHADE (SEE SCHEDULE)			X	X	
43	FIRE EXTINGUISHER WALL BRACKET			X	X	6.
44	ATDEK PROJECTOR MOUNT TELEHOOK THHH-PH-CM (35 1/4" LENGTH)			X	X	6, 7.


EQUIPMENT NOTES:
 VERIFY LOCATION AND MOUNTING HEIGHTS OF ALL ITEMS WITH OWNER AND OR USERS PRIOR TO INSTALLATION. 'CONTRACTOR INSTALLED' SHALL INCLUDE REMOVAL OF ITEM FROM ITS CURRENT LOCATION. CONTRACTOR TO NOTE EXISTING MOUNTING HEIGHTS PRIOR TO REMOVAL OF ITEMS. ITEMS TO BE REMOVED AND REINSTALLED INCLUDE BUT NOT LIMITED TO THE FOLLOWING: MOVABLE EQUIPMENT AND FURNITURE, FILE CHARTS, STORAGE CABINET SHELVING, FILE CABINETS ETC. ALL ITEMS NOT NOTED ON THIS DRAWING, CONTRACTOR SHALL VERIFY FULL SCOPE OF REMOVALS, REINSTALLATION AND MOVING OF ITEMS DURING PREBID WALKTHROUGH.

- TV MOUNT TO BE WALL HUNG WITH ALUMINUM CONSTRUCTION AND BLACK POWER PAINT FINISH.
- HATCH MOUNT WITH TV MAKE AND MODEL.
- PROVIDE PATIENT AND LIMB LIFTING CAPABILITY.
- COORDINATE LOCATION WITH LIFT AND OTHER CEILING AND HALL MOUNTED ITEMS. COORDINATE LOCATION WITH USERS.
- FIRE EXTINGUISHER BY OWNER.
- 'OWNER PROVIDED' MAY INCLUDE EXISTING SALVAGED ITEMS.
- VERIFY LOCATION AND SIZE WITH OWNER.


ACCESSORIES SCHEDULE						
CODE	ACCESSORY	OWNER PROVIDED	OWNER INSTALLED	CONTRACTOR PROVIDED	CONTRACTOR INSTALLED	NOTES
PTD-1	PAPER TOWEL DISPENSER	X			X	4.
TPH	TOILET PAPER HOLDER	X			X	
SD-1	SOAP DISPENSER	X			X	4.
HSD-1	HAND SANITIZER DISPENSER	X			X	3.
GB-1	GRAB BAR 42"				X	
GB-2	GRAB BAR 36"				X	
GB-3	GRAB BAR 18"				X	
GB-4	GRAB BAR FOLDDOWN				X	
MR-1	MIRROR - METAL FRAMED				X	
ND-1	NAPKIN DISPOSAL				X	
GH-1	COAT HOOK				X	
GH-2	COAT HOOK				X	
GH-3	GLOVE HOLDER				X	5.
MH-1	MASK HOLDER				X	5.
WR-1	WIRE RACK	X			X	6.
SC-1	SHARPS CONTAINER	X			X	

ACCESSORIES NOTES:
 VERIFY LOCATION AND MOUNTING HEIGHTS OF ALL ITEMS WITH OWNER AND OR USERS PRIOR TO INSTALLATION. 'CONTRACTOR INSTALLED' SHALL INCLUDE REMOVAL OF ITEM FROM ITS CURRENT LOCATION. ALL ITEMS NOT NOTED ON THIS DRAWING, CONTRACTOR SHALL VERIFY FULL SCOPE OF REMOVALS, REINSTALLATION AND MOVING OF ITEMS DURING PREBID WALKTHROUGH.


- PROVIDE BACKING IN HALL FOR ALL WALL MOUNTED ITEMS.
- MOUNT ALL ITEMS PER ADA REQUIREMENTS.
- PROVIDE ONE IN EVERY ROOM.
- PROVIDE AT ALL SINKS.
- SEE INTERIOR ELEVATIONS FOR LOCATION OF ADDITIONAL ACCESSORIES.
- EXISTING ACCESSORY.
- PROVIDE ACCESSORIES AT ALL ROOMS AND SINKS REGARDLESS WHICH ALTERNATES ARE ACCEPTED.
- 'OWNER PROVIDED' MAY INCLUDE EXISTING SALVAGED ITEMS.

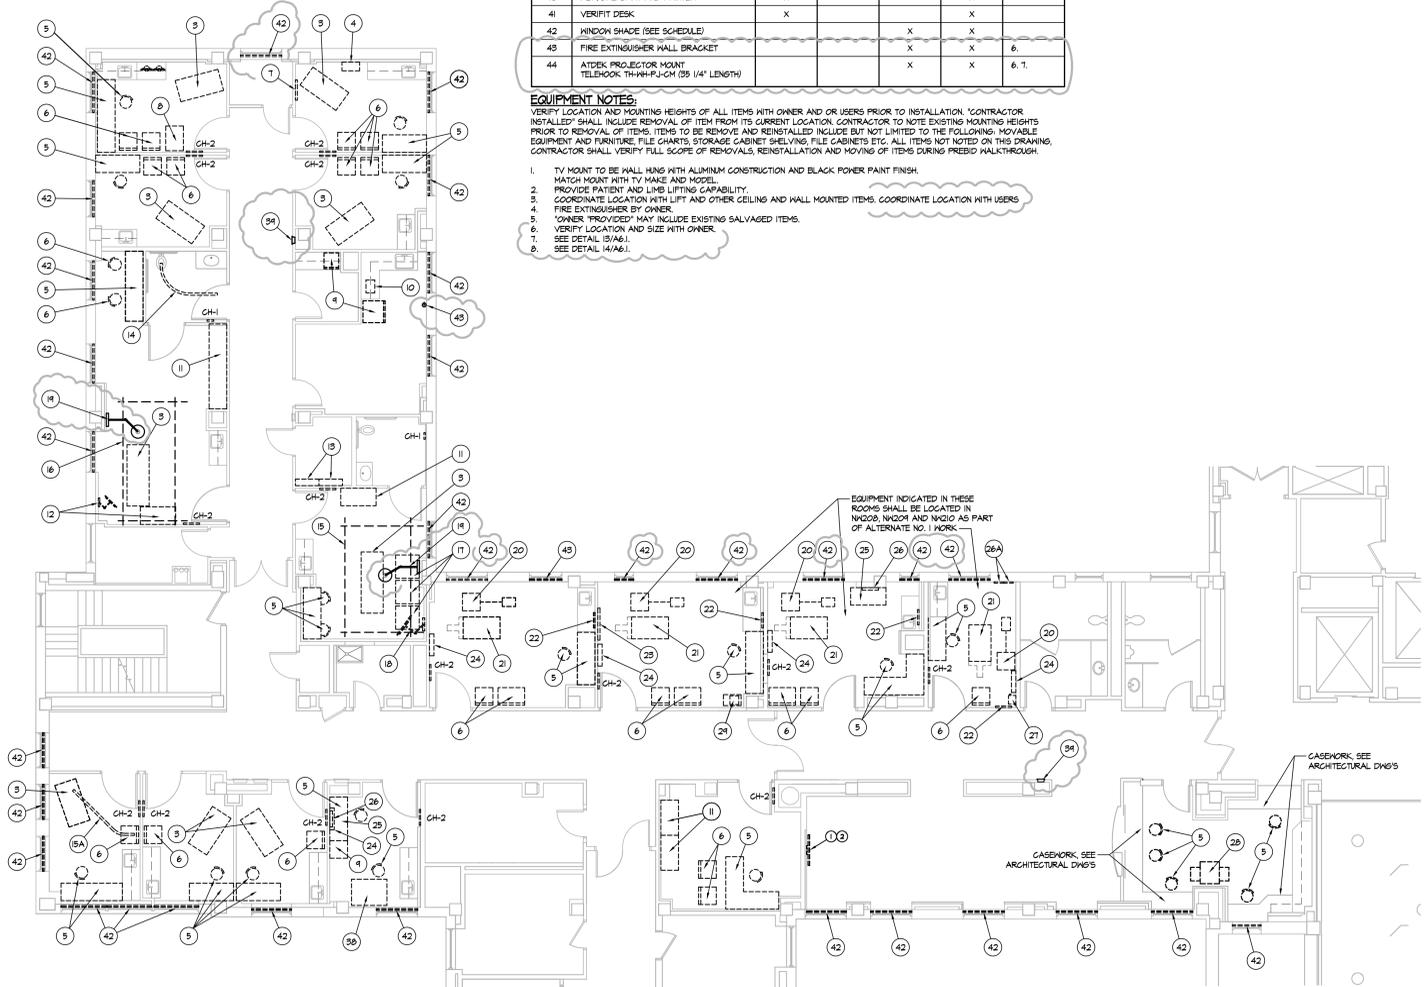


2 BASE BID EQUIPMENT PLAN - 2nd FLOOR
 SCALE: 1/8" = 1'-0"
 PLAN NORTH

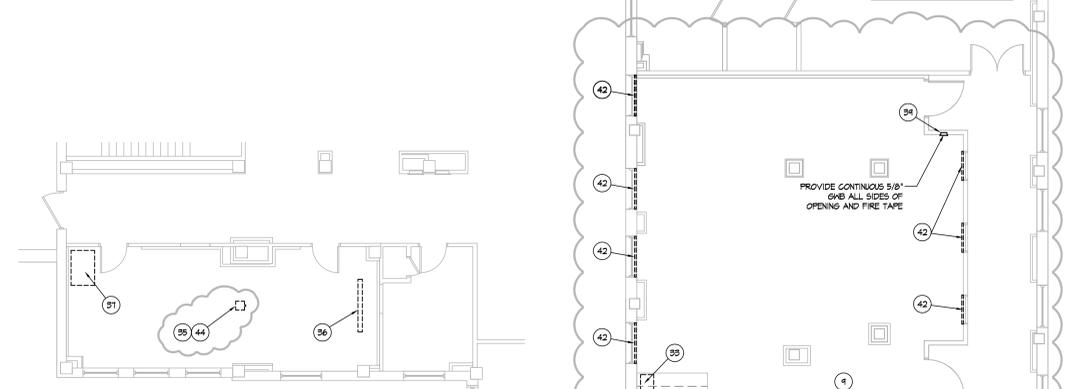

1 BASE BID EQUIPMENT PLAN - 1st FLOOR
 SCALE: 1/8" = 1'-0"
 PLAN NORTH

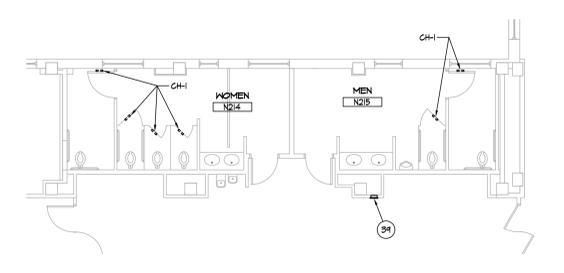

4 ALTERNATE NO. 2 EQUIPMENT PLAN - 2nd FLOOR
 SCALE: 1/8" = 1'-0"
 PLAN NORTH

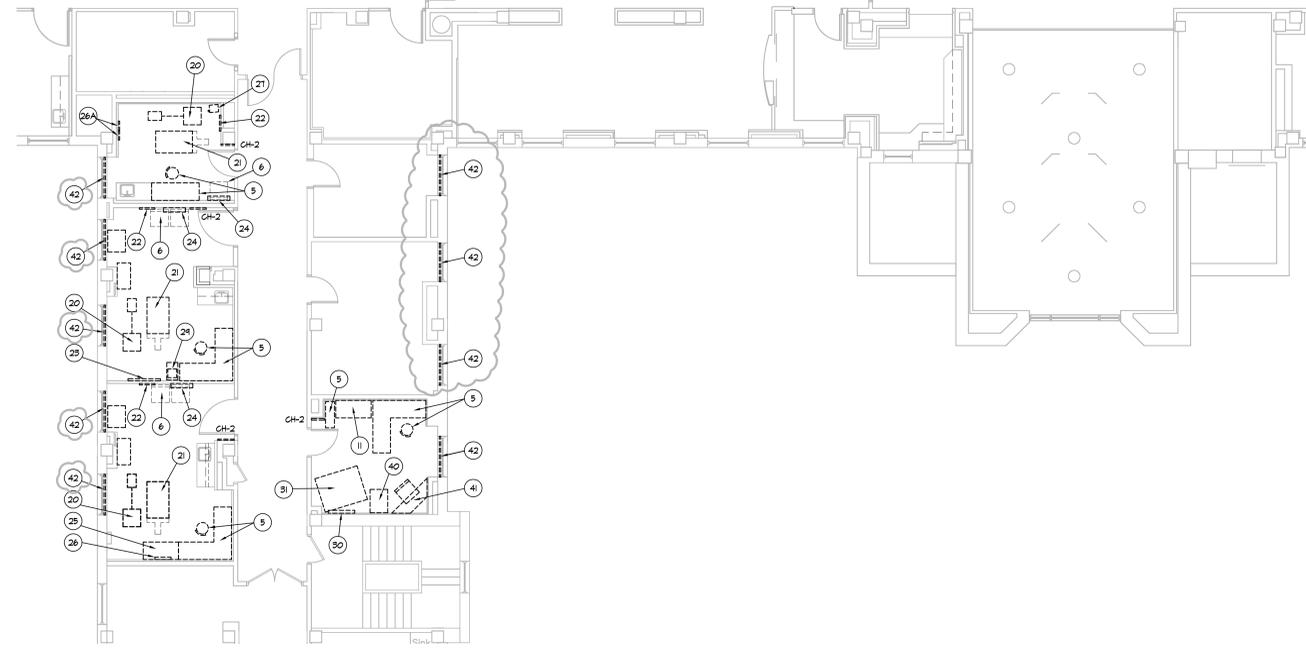


3 ALTERNATE NO. 1 EQUIPMENT PLAN - 2nd FLOOR
 SCALE: 1/8" = 1'-0"
 PLAN NORTH

OWNER CHANGES	
Revisions	Date
	6-13-2012

© 2012 Calvin L. Hinz Architects P.C.
 These plans are specifically designed for construction by Calvin L. Hinz Architects and are intended for no other purposes. Permission for use of this document in part or whole without written consent of Calvin L. Hinz Architects is prohibited.

IMPORTANT CONTRACTOR'S NOTE

- ALL CONTRACTORS ARE RESPONSIBLE FOR REVIEWING ENTIRE SET OF DOCUMENTS TO DETERMINE THEIR FULL SCOPE OF WORK. CONTRACTOR SHALL NOT BE ALLOWED EXTRA COSTS DUE TO FAILURE TO REVIEW ENTIRE SET OF DOCUMENTS.
- ANY USE OF THESE ELECTRONIC DRAWINGS OR SCALING OF THE PRINTED DOCUMENTS ARE DONE SO AT THE CONTRACTOR'S RISK.

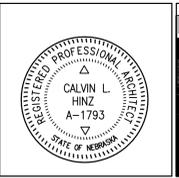

ARCHITECT/ENGINEERS:
CLH Calvin L. Hinz Architects, P.C.
 3705 North 200th Street
 Elkhorn, Nebraska 68022
 Phone: 402.291.6941 Fax: 402.291.9193

KRS ENGINEERING
 11620 ARBOR STREET SUITE 100
 OMAHA, NEBRASKA 68144
 PHONE: 402.932.0100
 FAX: 402.932.1001
 www.krsengineering.com
 KRS # 178
 COPYRIGHT 2011
 This document and the information contained may not be reproduced without the express written permission of KRS Engineering, LLC. Unauthorized copying, disclosure or construction use are prohibited by the copyright law.

Drawing Title
 2nd FLOOR EQUIPMENT PLANS

Approved Project Director
 KEVIN HUTSELL

CONSTRUCTION DOCUMENT (CD-3) SUBMITTAL (00X)
 April 13, 2012

Project Title
 RENOVATE BACKFILL CANTEN SPACE NWIHCs

Location
 VAMC Grand Island, NE

Date
 APRIL 13, 2012

Checked
 CH

Drawn
 [Signature]

Project Number
 636-12-103

Building Number
 ONE

Drawing Number
A2.5

Dwg. 6 of 41

