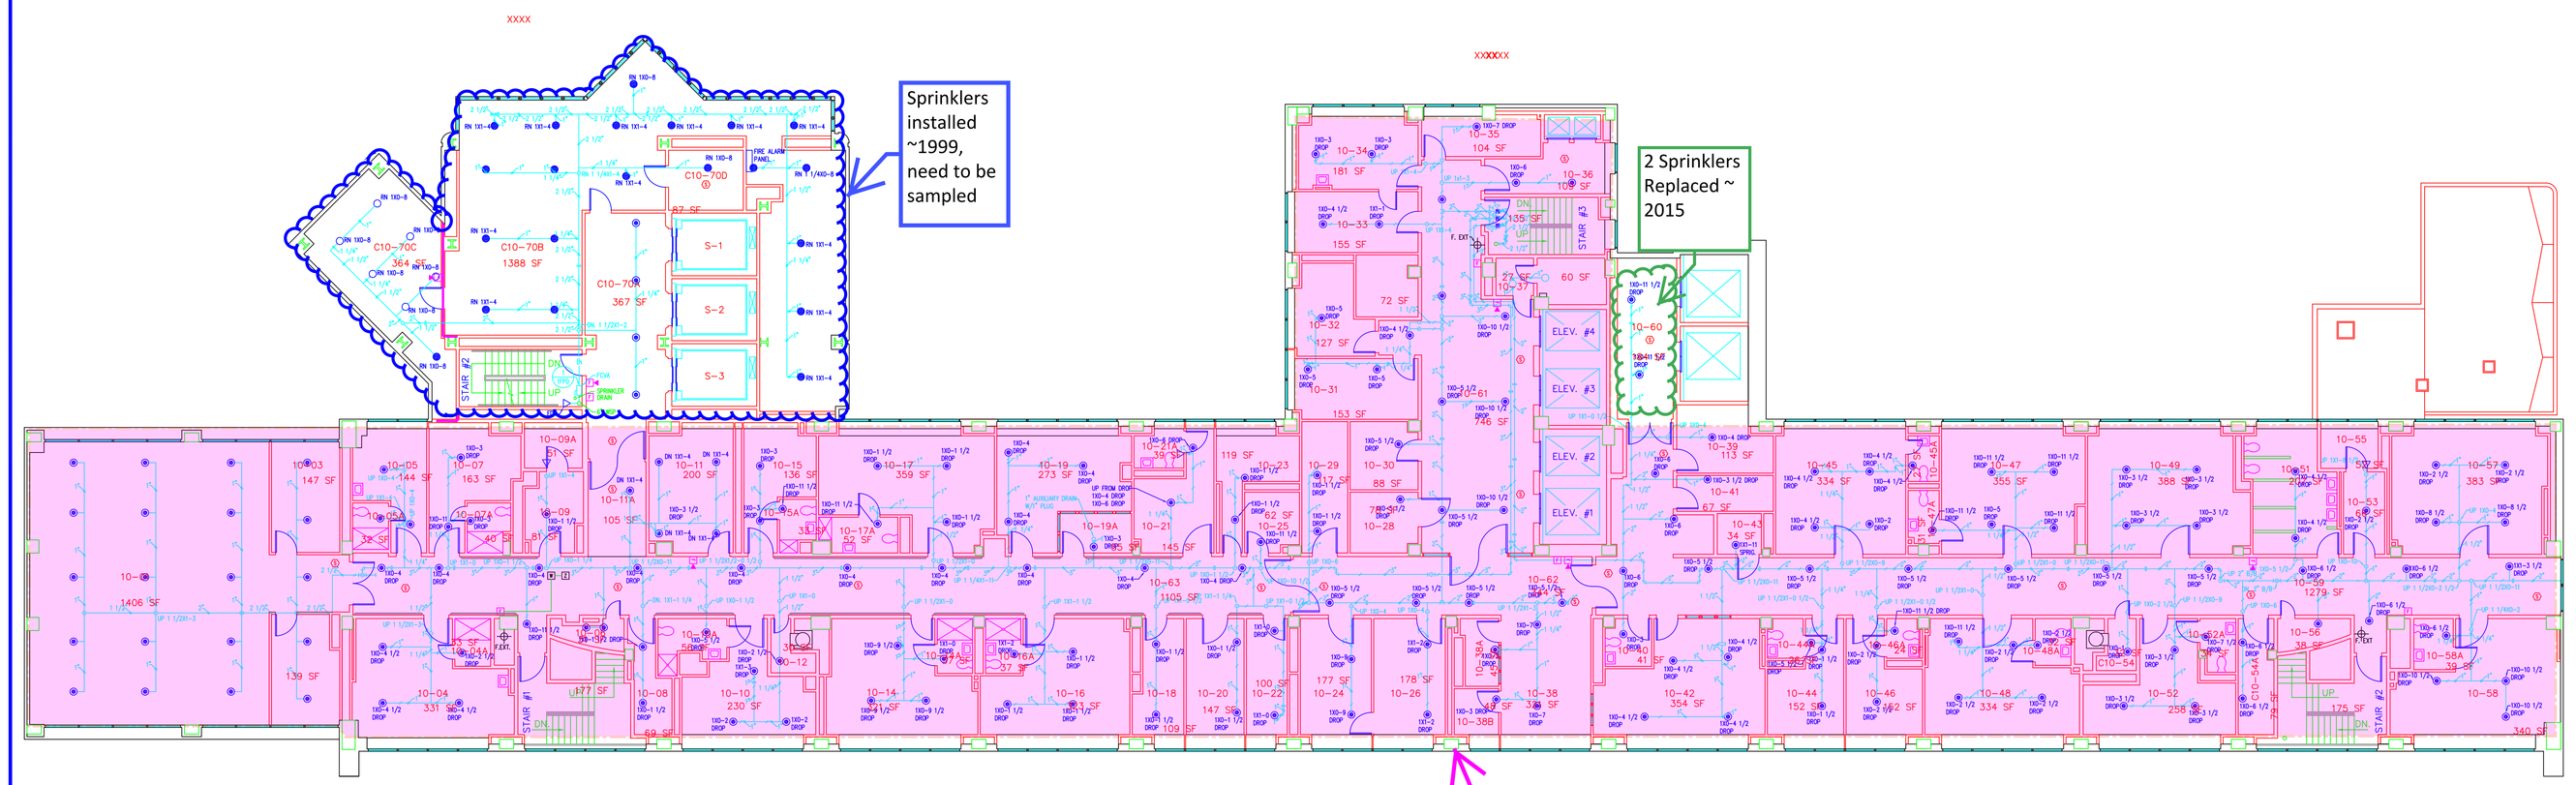

FIRE PROTECTION LEGEND

SYMBOL	NAME	DESCRIPTION
○	FHDTSPR1	PENDENT SPRINKLER
◉	FHDTSPRN	PENDENT SPRINKLER
●	UPRTSPRN	UPRIGHT SPRINKLER
○	UPRTSPR1	UPRIGHT SPRINKLER
◉	DRYPNDT	DRY PENDENT SPRINKLER
⊕	FPNDTSPN	FLUSH PENDENT SPRINKLER
▷	SPRSIDEW	SPRINKLER – SIDEWALK
▶	SPRSIDE1	SPRINKLER – SIDEWALK
◓	FHDTSPR2	PENDENT SPRINKLER
⊗	SPRHEAD	SPRINKLER – HEAD
○	TELBOWUP	TEE ELBOW UP
○	AUXDRAIN	AUXILIARY DRAIN
○	TELBOWDN	TEE ELBOW DOWN
○	RISER	RISER
○	ELBOWDN	ELBOW DOWN
○	DROP	DROP
⊛	HDETR	HEAT DETECTOR
Ⓢ	SMKDETR	SMOKE DETECTOR
⋈	GATEVLV	GATE VALVE
⋈	SHUTOFFV	SHUT OFF VALVE
⋈	2WCTRLVL	TWO-WAY MODULATING CONTROL VALVE
⋈	GLOVEVLVE	GLOVE VALVE
⋈	BFLYVALV	BUTTERFLY VALVE
⋈	CHECKVLV	CHECK VALVE
—	SINGHANG	SINGLE HANGER
—	ELBOW-0	ELBOW-0
⌐	ELBOW-90	ELBOW-90
⊐	TEE-PLAN	TEE-PLAN
▭	GROVCOUP	GROOVED COUPLING
—	GROVCOCP	GROOVED CAP
⋈	OSYGATV	O.S. & Y. GATE VALVE
═	GUIDE	PIPE GUIDE
—	SINGHANG	SINGLE HANGER
FALMBELL	FALMBELL	FIRE ALARM BELL
AUDVISBL	AUDVISBL	FIRE ALARM AUDIO/VISUAL DEVICE
FAHORN	FAHORN	FIRE ALARM HORN
F	FAPULSTN	MANUAL FIRE ALARM PULL STATION
FS	FLOWSW	FLOW SWITCH
TS	TAMPERSW	TAMPER SWITCH
J	CJBOX-C	CEILING MOUNTED JUNCTION BOX
▢	CROSS	CROSS
FACP	FACP	FIRE ALARM CONTROL
▣	WPFLSW	WET PIPE FLOW SWITCH
Z	ZAM	ZONE ADDRESS MODULE
□	FAPANEL	FIRE ALARM PANEL
□	FEQUIP	FIRE EQUIPMENT
⋈	RELIFVLV	RELIEF VALVE
◇	SOLNOVLV	SOLENOID VALVE
S	STROBE-W	STROBE UNIT WALL MOUNTED
⊞	KEYBORD	KEY BOARD
⊕	FIREXTUR	FIRE EXTINGUISHER

Revisions	Date		Professional Seal		Drawing Title: TENTH FLOOR PLAN FIRE PROTECTION	Project Title	Date: 10-20-2004
					Approved: Project Manager	Building Number: 01 / Checked / Drawn	Project No.
					Approved: Service Chief	Location: VAMC, WILKES BARRE PENNSYLVANIA	Drawing No.

VAMC, WILKES BARRE — Department of Veterans Affairs

VA FORM 08-6231, OCT 1978