





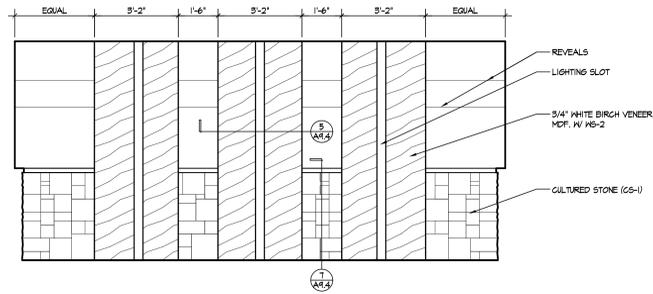


1 INTERIOR ELEVATION  
 A9.4 SCALE: 3/8" = 1'-0"

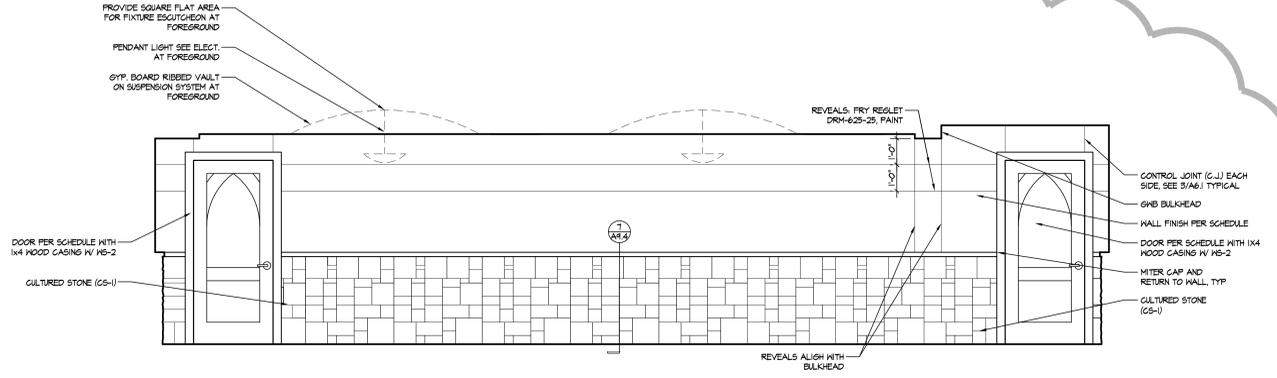


2 INTERIOR ELEVATION  
 A9.4 SCALE: 3/8" = 1'-0"

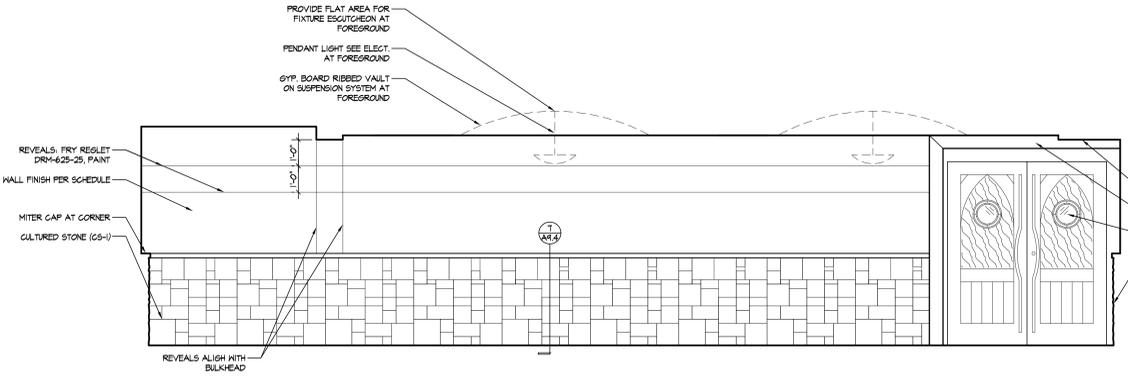


3 INTERIOR ELEVATION  
 A9.4 SCALE: 3/8" = 1'-0"

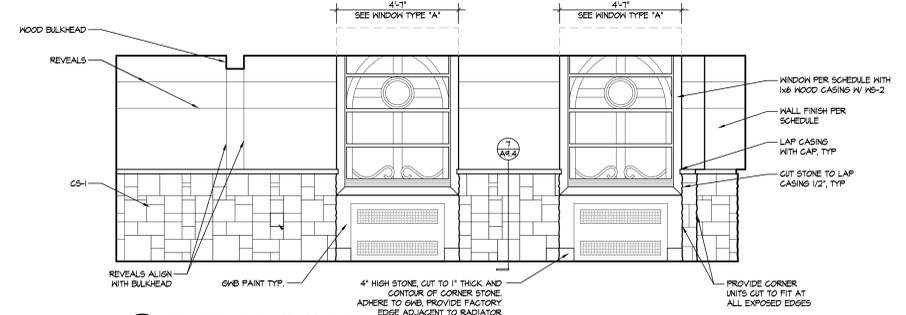


4 INTERIOR ELEVATION  
 A9.4 SCALE: 3/8" = 1'-0"

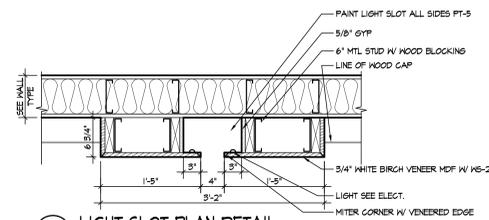


5 LIGHT SLOT PLAN DETAIL  
 A9.4 SCALE: 1" = 1'-0"

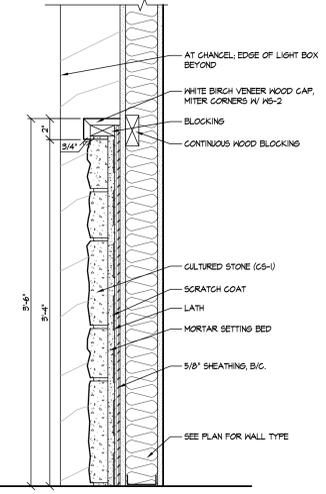


7 WOOD PANEL DETAIL  
 A9.4 SCALE: 1/2" = 1'-0"

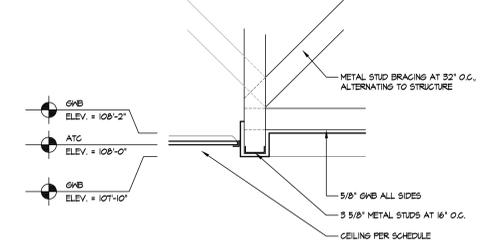


8 DETAIL  
 A9.4 SCALE: 1" = 1'-0"

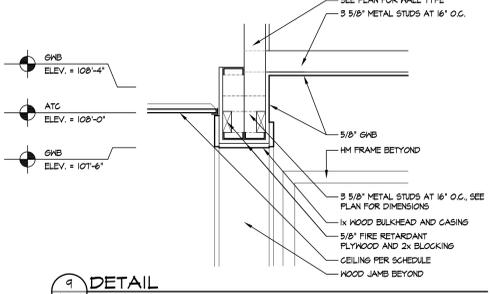

9 DETAIL  
 A9.4 SCALE: 1" = 1'-0"

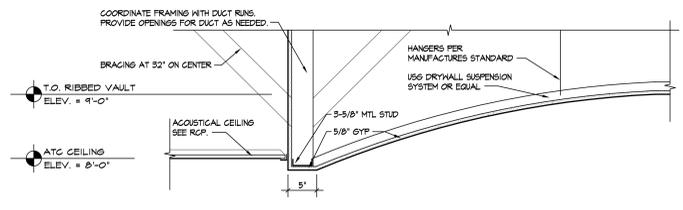

6 RIBBED VAULT DETAIL  
 A9.4 SCALE: 1" = 1'-0"

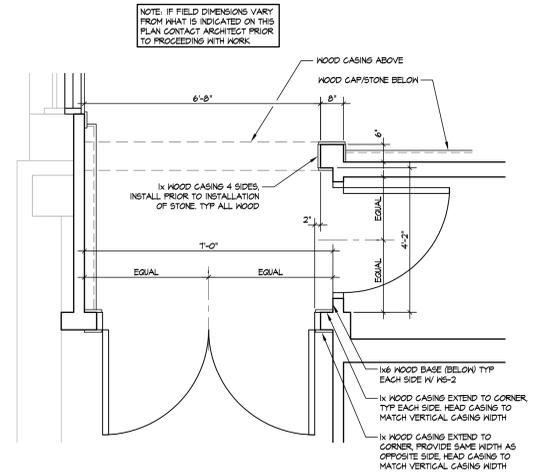


10 ENLARGED PLAN  
 A9.4 SCALE: 1/2" = 1'-0"

OWNER CHANGES	6-13-2012
Revisions	Date

© 2012 Calvin L. Hinz Architects P.C.  
 These plans are specifically designed for construction by Calvin L. Hinz Architects and are intended for no other purposes. Permission for use of this document in part or whole without written consent of Calvin L. Hinz Architects is prohibited.

**IMPORTANT CONTRACTOR'S NOTE**  
 1. ALL CONTRACTORS ARE RESPONSIBLE FOR REVIEWING ENTIRE SET OF DOCUMENTS TO DETERMINE THEIR FULL SCOPE OF WORK. CONTRACTOR SHALL NOT BE ALLOWED EXTRA COSTS DUE TO FAILURE TO REVIEW ENTIRE SET OF DOCUMENTS.  
 2. ANY USE OF THESE ELECTRONIC DRAWINGS OR SCALING OF THE PRINTED DOCUMENTS ARE DONE SO AT THE CONTRACTOR'S RISK.

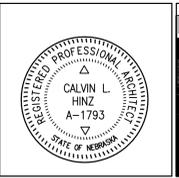

**ARCHITECT/ENGINEERS:**  
**CLH** Calvin L. Hinz Architects, P.C.  
 3705 North 200th Street  
 Elkhorn, Nebraska 68022  
 Phone: 402.291.6941 Fax: 402.291.9193

**KRS ENGINEERING**  
 11620 ARBOR STREET SUITE 100  
 OMAHA, NEBRASKA 68144  
 PHONE: 402.932.0100  
 FAX: 402.932.1001  
 www.krsengineering.com

**Drawing Title:** CHAPEL ELEVATIONS AND DETAILS  
**Approved Project Director:** KEVIN HUTSELL  
**CONSTRUCTION DOCUMENT (CD-3) SUBMITTAL (100%)**  
 April 13, 2012

**Project Title:** RENOVATE BACKFILL CANTEEN SPACE NWHCS  
**Location:** VAMC Grand Island, NE  
**Date:** APRIL 13, 2012  
**Checked:** CH  
**Drawn:**

**Project Number:** 636-12-103  
**Building Number:** ONE  
**Drawing Number:** A9.4  
**Dwg. 12 of 41**

