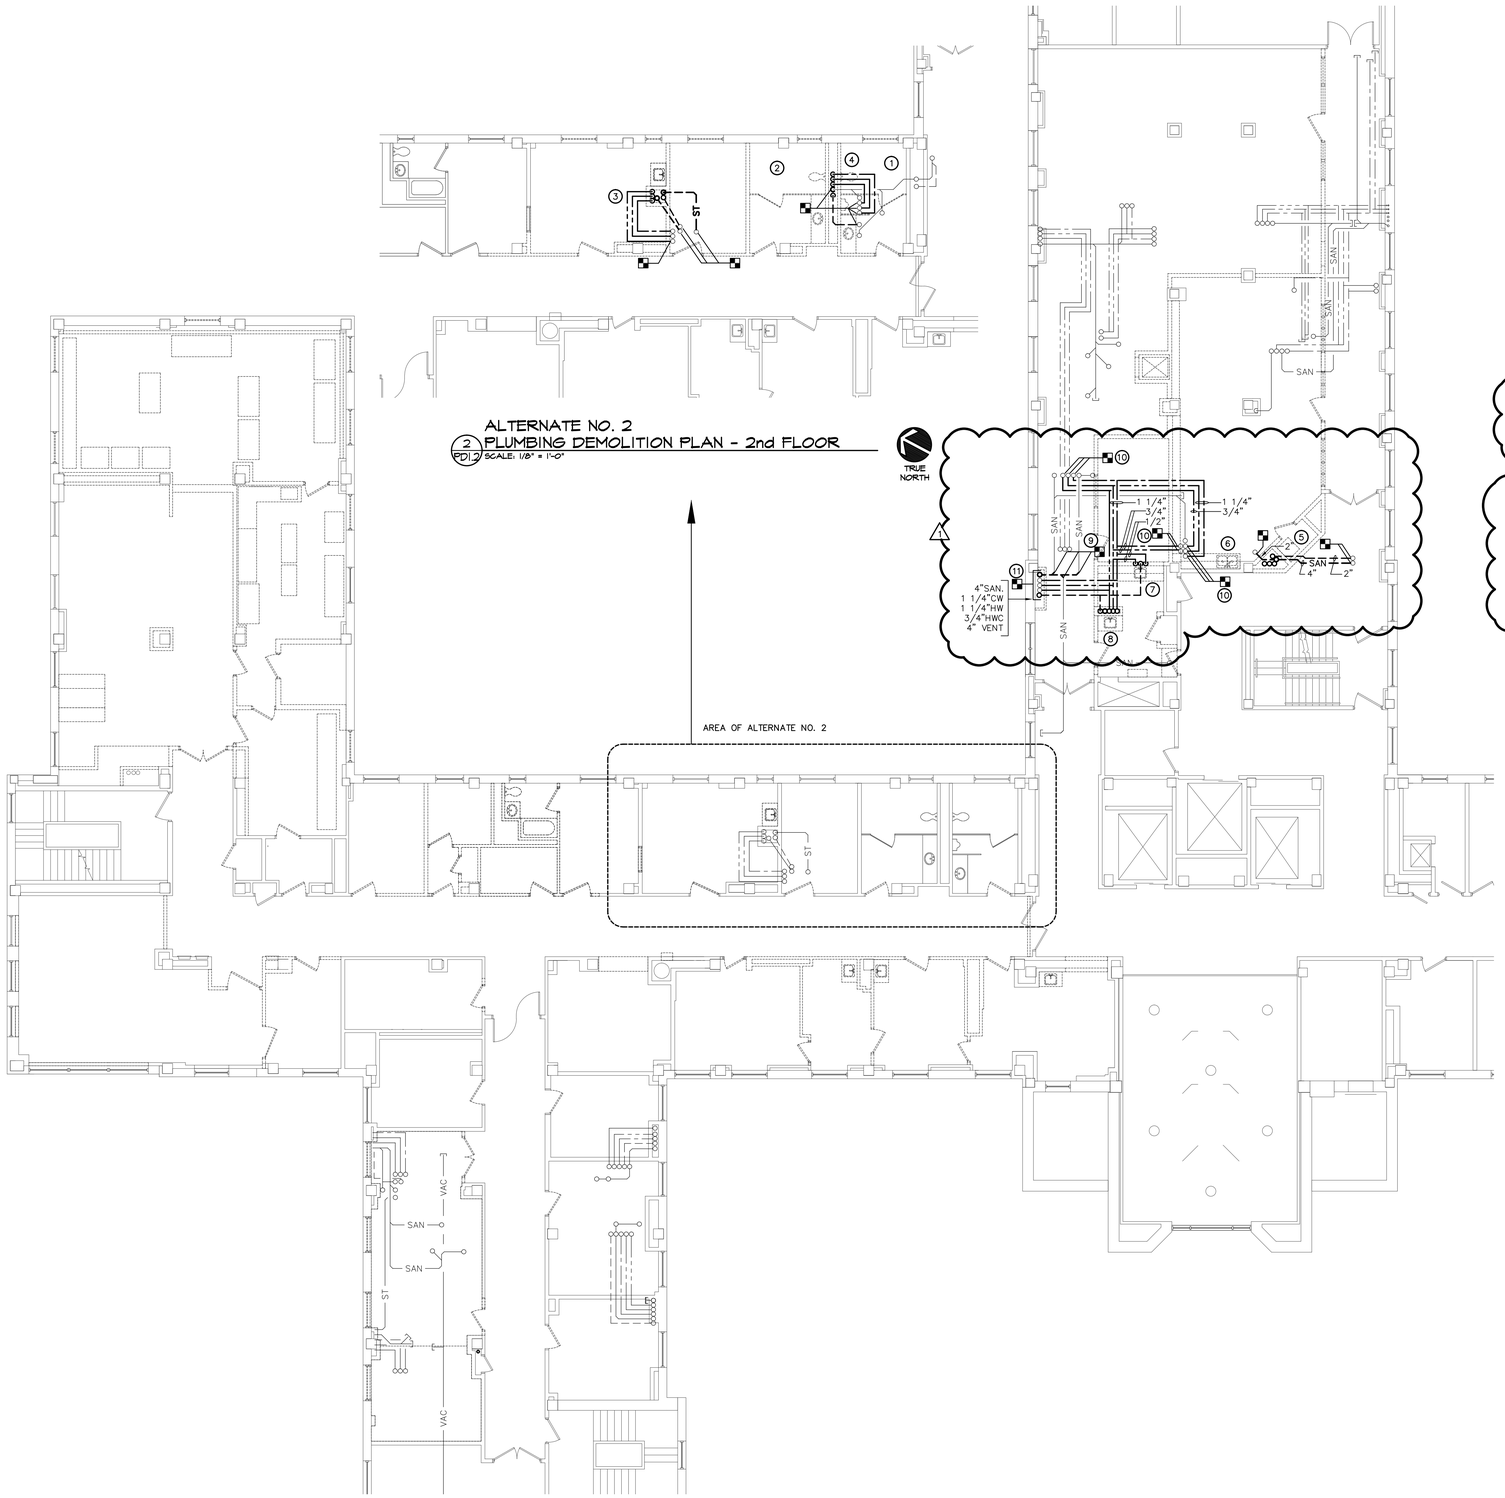

GENERAL NOTES

1. EXISTING CONDITIONS ABOVE CEILINGS AND WITHIN VERTICAL CHASES ARE NOT FULLY KNOWN. FIELD VERIFY ACTUAL CONDITIONS AND ADJUST WORK AS REQUIRED. NOTIFY ENGINEER AND ARCHITECT IF EXISTING PIPING, DUCTWORK, OR EQUIPMENT TO REMAIN CONFLICTS WITH THE NEW DESIGN.
2. DURING CONSTRUCTION NO CEILING TILES IN PUBLIC AREAS CAN BE LEFT OPEN OVERNIGHT.
3. COORDINATE SCHEDULING OF ALL WORK REQUIRED OUTSIDE THE RENOVATION AREA INCLUDING FLOORS ABOVE AND BELOW THE RENOVATION AREA WITH COTR. SPACES ADJACENT TO THE RENOVATION WILL REMAIN OPERATIONAL DURING CONSTRUCTION.

PLUMBING DEMOLITION KEYNOTES

1. REMOVE WATER CLOSET, URINAL, AND LAVATORY COMPLETE. REMOVE ALL SANITARY, VENT, AND DOMESTIC WATER LINES IN CHASE. REMOVE HW, CW, AND HWC RISER FROM FIRST FLOOR CEILING TO DISCONNECT POINT IN SECOND FLOOR CEILING. SEE PLUMBING PLAN #3 ON SHEET P1.3 FOR NEW WORK.
2. REMOVE WATER CLOSET AND LAVATORY COMPLETE. REMOVE ALL SANITARY, VENT, AND DOMESTIC WATER LINES IN CHASE. SEE PLUMBING PLAN #3 ON SHEET P1.3 FOR NEW WORK.
3. REMOVE 4" SANITARY, 4" STORM, 2 1/2" VENT, 1 1/2" CW, 1" HW, AND 3/4" HWC FROM DISCONNECT POINT IN SECOND FLOOR CEILING DOWN TO FIRST FLOOR CEILING. SEE PLUMBING PLAN #3 ON SHEET P1.3 FOR NEW WORK.
4. REMOVE 4" SANITARY, 2" VENT, 2" CW, 1" HW, AND 3/4" HWC FROM DISCONNECT POINT IN SECOND FLOOR CEILING DOWN TO FIRST FLOOR CEILING. SEE PLUMBING PLAN #3 ON SHEET P1.3 FOR NEW WORK.
5. REMOVE SERVICE SINK. REMOVE 3/4" HW, CW, HWC, 4" SAN., AND 2" VENT IN CHASE DOWN TO FIRST FLOOR. REMOVE 4" SAN., 2" SAN., AND 2" VENT LINE FROM DISCONNECT POINT IN SECOND FLOOR CEILING DOWN TO FIRST FLOOR CEILING.
6. REMOVE 2-COMPARTMENT SINK. REMOVE HW, CW, SANITARY, AND VENT COMPLETE.
7. REMOVE SINK. REMOVE HW, CW, SANITARY, AND VENT COMPLETE.
8. REMOVE SINK. REMOVE 1 1/4" HW, 1 1/4" CW, 3/4" HWC, AND 1 1/2" VENT DOWN TO FIRST FLOOR CEILING.
9. REMOVE 4" SANITARY TO DISCONNECT POINTS FOR RE-ROUTING OF SANITARY. SEE SHEET P1.2 FOR NEW WORK.
10. REMOVE HW, CW, AND HWC LINES FROM DISCONNECT POINT BACK DOWN TO MAINS LOCATED IN THE FIRST FLOOR CEILING. SEE SHEET P1.2 FOR NEW WORK.
11. REMOVE 4" SANITARY AND 4" VENT FROM SECOND FLOOR CEILING DOWN TO FIRST FLOOR CEILING. REMOVE 1 1/4" HW, CW, AND 3/4" HWC FROM DISCONNECT POINT IN SECOND FLOOR CEILING BACK TO THE MAIN(S) AND DOWN TO FIRST FLOOR.

OWNER CHANGES	6-13-2012
Revisions:	Date

© 2000 Calvin L. Hinz Architects P.C.

These plans are specifically designed for construction by Calvin L. Hinz Architects and are intended for no other purposes. Permission for use of this document in part or whole without written consent of Calvin L. Hinz Architects is prohibited.

IMPORTANT CONTRACTOR'S NOTE

1. ALL CONTRACTORS ARE RESPONSIBLE FOR REVIEWING ENTIRE SET OF DOCUMENTS TO DETERMINE THEIR FULL SCOPE OF WORK. CONTRACTOR SHALL NOT BE ALLOWED EXTRA COSTS DUE TO FAILURE TO REVIEW ENTIRE SET OF DOCUMENTS.
2. ANY USE OF THESE ELECTRONIC DRAWINGS OR SCALING OF THE PRINTED DOCUMENTS ARE DONE SO AT THE CONTRACTORS RISK.

ARCHITECT/ENGINEERS:

CLH Calvin L. Hinz Architects

Calvin L. HINZ Architects, P.C.
3705 North 200th Street
Elkhorn, Nebraska 68022
Phone:402.291.6941 Fax: 402.291.9193

KRS engineering

11620 ARBOR STREET SUITE 100
OMAHA, NEBRASKA 68144
PHONE : 402 . 932 . 0100
FAX: 402 . 932 . 1001
www.krsengineering.com
KRS # 121013

COPYRIGHT 2012
This document and the information contained may not be reproduced without the express written permission of KRS Engineering, LLC. Unauthorized copying, disclosure or construction use are prohibited by the copyright law.

Drawing Title
- ALT. #1 PLUMBING DEMOLITION PLAN - 2nd FLOOR
- ALT. #2 PLUMBING DEMOLITION PLAN - 2nd FLOOR

Approved Project Director: KEVIN HUTSELL

CONSTRUCTION DOCUMENT (CD-3) SUBMITTAL 100%
APRIL 13, 2012

Project Title: RENOVATE BACKFILL CANTEEN SPACE NWIHCS

Location: VAMC Grand Island, NE

Date: APRIL 13, 2012 | Checked: MKL | Drawn: CER

Project Number: 636-12-103

Building Number: ONE

Drawing Number: PD1.2

Dwg. 16 of 41

Office of Construction and Facilities Management

Department of Veterans Affairs

VA FORM 08-6231