

A

B

C

D

E

F

A

B


C

D

E

F

one eighth inch = one foot  
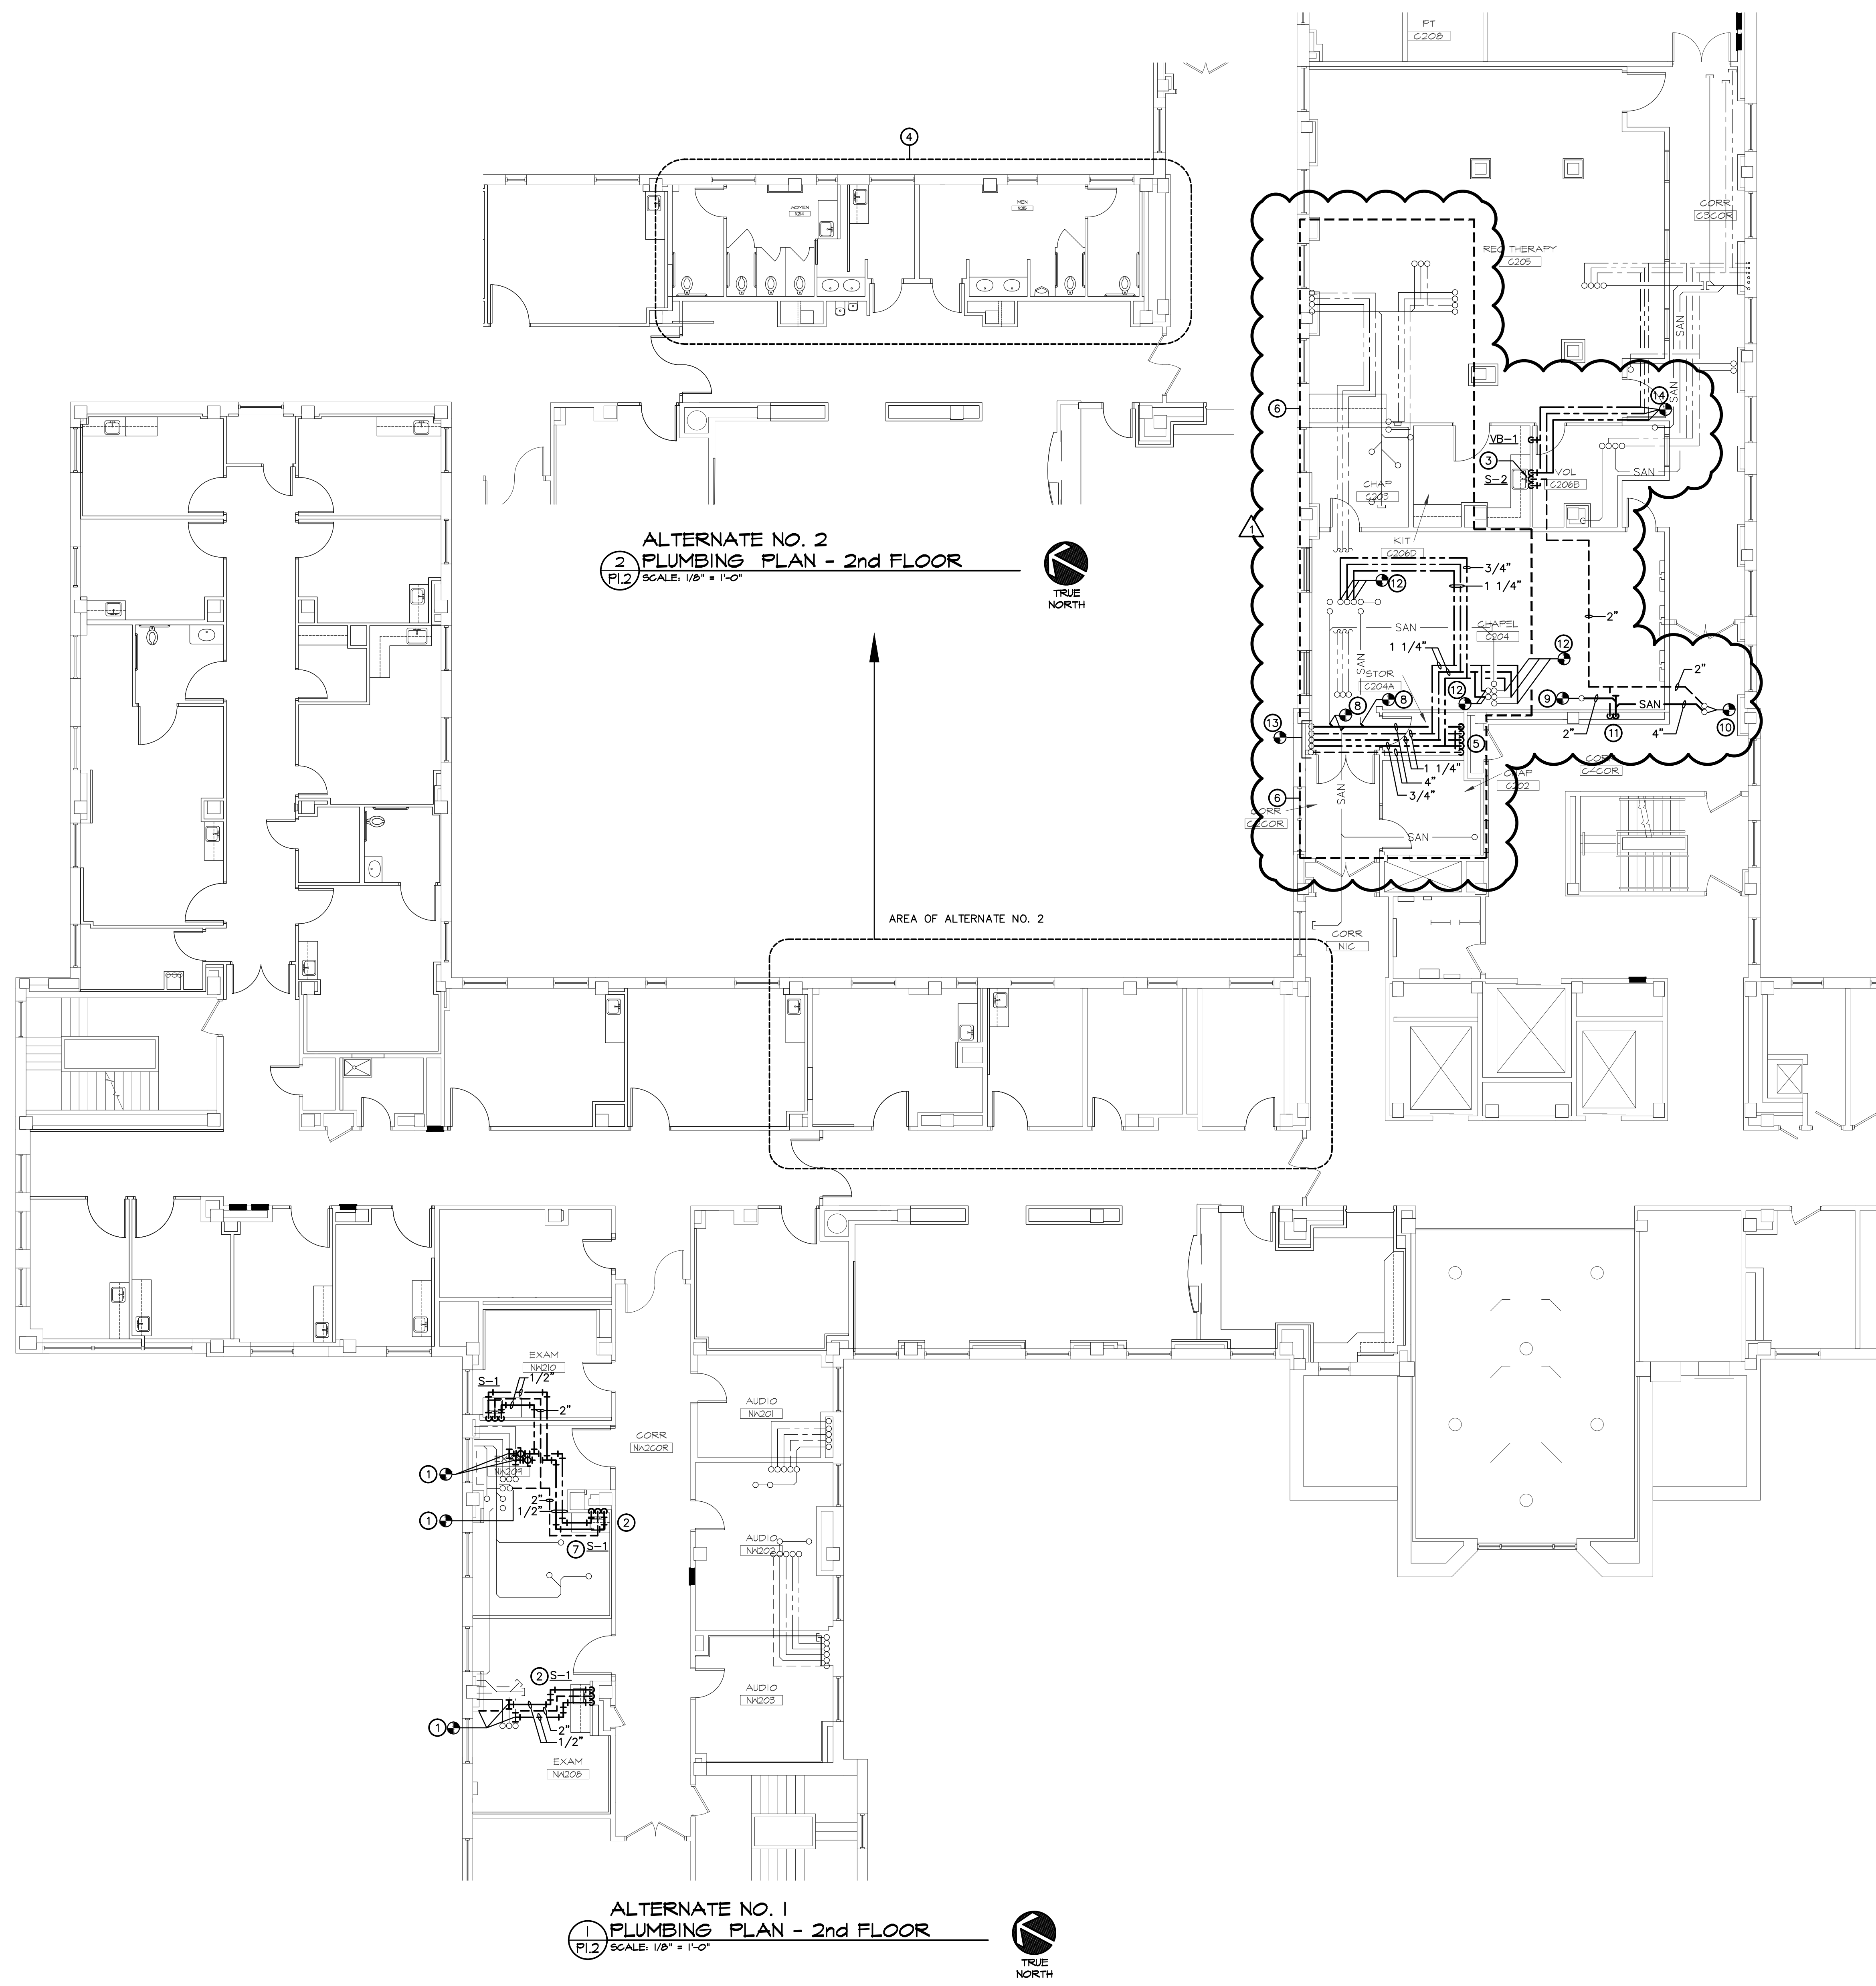

- ### GENERAL NOTES
- EXISTING CONDITIONS ABOVE CEILINGS AND WITHIN VERTICAL CHASES ARE NOT FULLY KNOWN. FIELD VERIFY ACTUAL CONDITIONS AND ADJUST WORK AS REQUIRED. NOTIFY ENGINEER AND ARCHITECT IF EXISTING PIPING, DUCTWORK, OR EQUIPMENT TO REMAIN CONFLICTS WITH THE NEW DESIGN.
  - DURING CONSTRUCTION NO CEILING TILES IN PUBLIC AREAS CAN BE LEFT OPEN OVERNIGHT.
  - COORDINATE SCHEDULING OF ALL WORK REQUIRED OUTSIDE THE RENOVATION AREA INCLUDING FLOORS ABOVE AND BELOW THE RENOVATION AREA WITH COTR. SPACES ADJACENT TO THE RENOVATION WILL REMAIN OPERATIONAL DURING CONSTRUCTION.
- ### PLUMBING KEYNOTES
- CONNECT NEW 1/2" HW, CW AND 2" VENT TO EXISTING 3/4" HW, CW, AND 2" VENT.
  - 2" SANITARY DOWN. SEE PLUMBING PLAN #2 ON SHEET P1.3 FOR SANITARY CONNECTION ON FIRST FLOOR.
  - 2" SANITARY DOWN. SEE PLUMBING PLAN #1 ON SHEET P1.3 FOR SANITARY CONNECTION ON FIRST FLOOR.
  - SEE PLUMBING PLAN #3 ON SHEET P1.4 FOR WORK IN THIS AREA.
  - 1 1/4" HW, 1 1/4" CW, 3/4" HWC, 4" VENT, AND 4" SANITARY DOWN. SEE PLUMBING PLAN #1 ON SHEET P1.3 FOR CONTINUATION.
  - RAISE ALL EXISTING PLUMBING LINES IN THIS ROOM AS HIGH AS POSSIBLE FOR NEW CEILING AND/OR STRUCTURAL FOR LIFT EQUIPMENT. COORDINATE WITH ARCHITECTURAL REFLECTED CEILING PLAN AND EQUIPMENT PLAN.
  - CONDENSATE DRAIN DOWN TO BRANCH WYE CONNECTION ABOVE P-TRAP IN CASEWORK BELOW SINK. SEE P1.4C PLUMBING PLAN.
  - RE-CONNECT EXISTING SANITARY LINES AS SHOWN. FIELD VERIFY EXACT SIZE(S).
  - CONNECT NEW 2" SANITARY TO EXISTING 2" SANITARY.
  - CONNECT NEW 4" SANITARY AND 2" VENT TO EXISTING 4" SANITARY AND 2" VENT.
  - 4" SANITARY AND 2" VENT DOWN. SEE SHEET P1.3 FOR CONTINUATION.
  - CONNECT NEW HW, CW, AND HWC TO EXISTING HW, CW, AND HWC RISERS. FIELD VERIFY EXACT SIZES.
  - CONNECT NEW 1 1/4" HW, 1 1/4" CW, 3/4" HWC, 4" SANITARY, AND 4" VENT TO EXISTING.
  - EXTEND EXISTING HW, CW, AND HWC LINES AS SHOWN. FIELD VERIFY EXACT SIZES.

<div>OWNER CHANGES</div> <div>Revisions</div> <div>6-13-2012</div> <div>Date</div>	<div>© 2000 Calvin L. Hinz Architects P.C.</div> <div>These plans are specifically designed for construction by Calvin L. Hinz Architects and are intended for no other purposes. Permission for use of this document in part or whole without written consent of Calvin L. Hinz Architects is prohibited.</div>	<div>IMPORTANT CONTRACTOR'S NOTE</div> <div>1. ALL CONTRACTORS ARE RESPONSIBLE FOR REVIEWING ENTIRE SET OF DOCUMENTS TO DETERMINE THEIR FULL SCOPE OF WORK. CONTRACTOR SHALL NOT BE ALLOWED EXTRA COSTS DUE TO FAILURE TO REVIEW ENTIRE SET OF DOCUMENTS.</div> <div>2. ANY USE OF THESE ELECTRONIC DRAWINGS OR SCALING OF THE PRINTED DOCUMENTS ARE DONE SO AT THE CONTRACTORS RISK.</div>	<div>CLH</div> <div>Calvin L. Hinz Architects, P.C.</div> <div>3705 North 200th Street</div> <div>Elkhorn, Nebraska 68022</div> <div>Phone: 402.291.6941 Fax: 402.291.9193</div>	<div>ARCHITECT/ENGINEERS:</div> <div>KRS</div> <div>11620 ARBOR STREET SUITE 100</div> <div>OMAHA, NEBRASKA 68144</div> <div>PHONE: 402.932.0100</div> <div>FAX: 402.932.1001</div> <div>www.krsengineering.com</div> <div>COPYRIGHT 2012</div> <div>This document and the information contained may not be reproduced without the express written permission of KRS Engineering, LLC. Unauthorized copying, disclosure or construction use are prohibited by the copyright law.</div>	<div>Drawing Title</div> <div>- ALT. #1 PLUMBING PLAN - 2nd FLOOR</div> <div>- ALT. #2 PLUMBING PLAN - 2nd FLOOR</div> <div>Approved Project Director</div> <div>KEVIN HUTSELL</div> <div>CONSTRUCTION DOCUMENT (CD-3) SUBMITTAL 100%</div> <div>APRIL 13, 2012</div>	<div>Project Title</div> <div>RENOVATE BACKFILL CANTEN SPACE NWHCS</div> <div>Location</div> <div>VAMC Grand Island, NE</div> <div>Date</div> <div>APRIL 13, 2012</div> <div>Checked</div> <div>MKL</div> <div>Drawn</div> <div>CER</div>	<div>Project Number</div> <div>636-12-103</div> <div>Building Number</div> <div>ONE</div> <div>Drawing Number</div> <div>P1.2</div> <div>Dwg. 19 of 41</div>	<div>Office of Construction and Facilities Management</div> <div>Department of Veterans Affairs</div>
--	--	---	--	--	---	---	--	---