
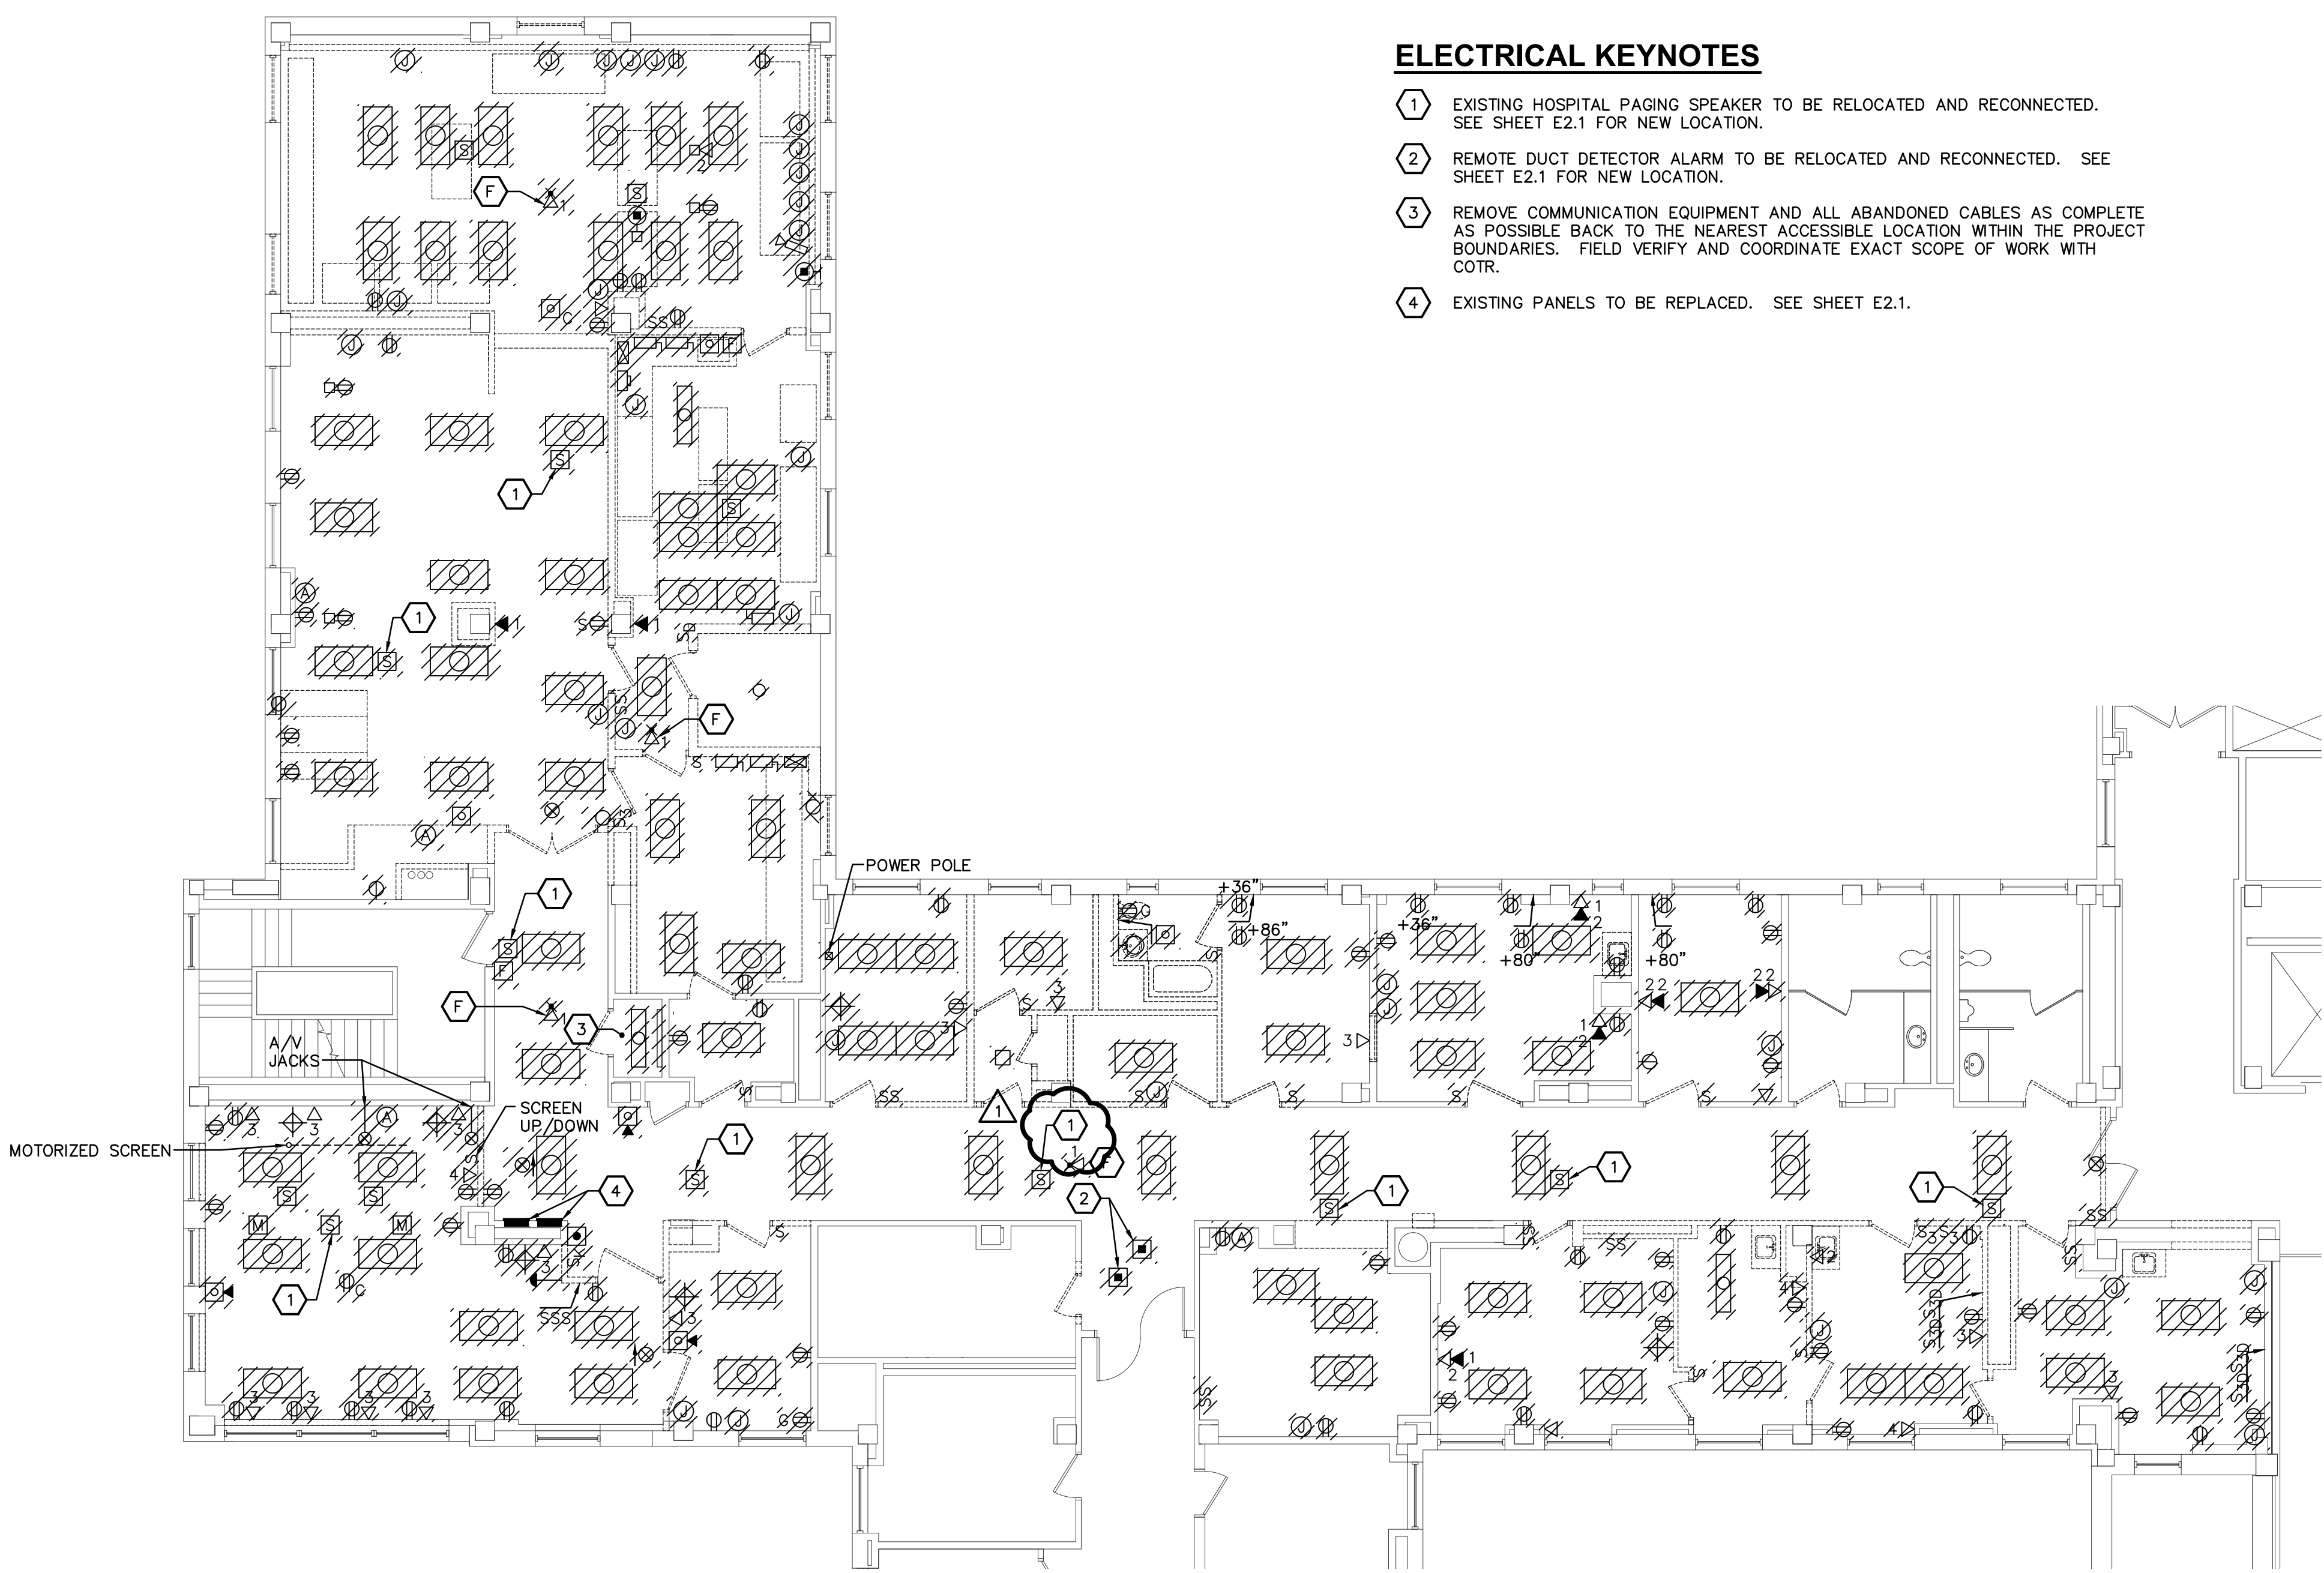


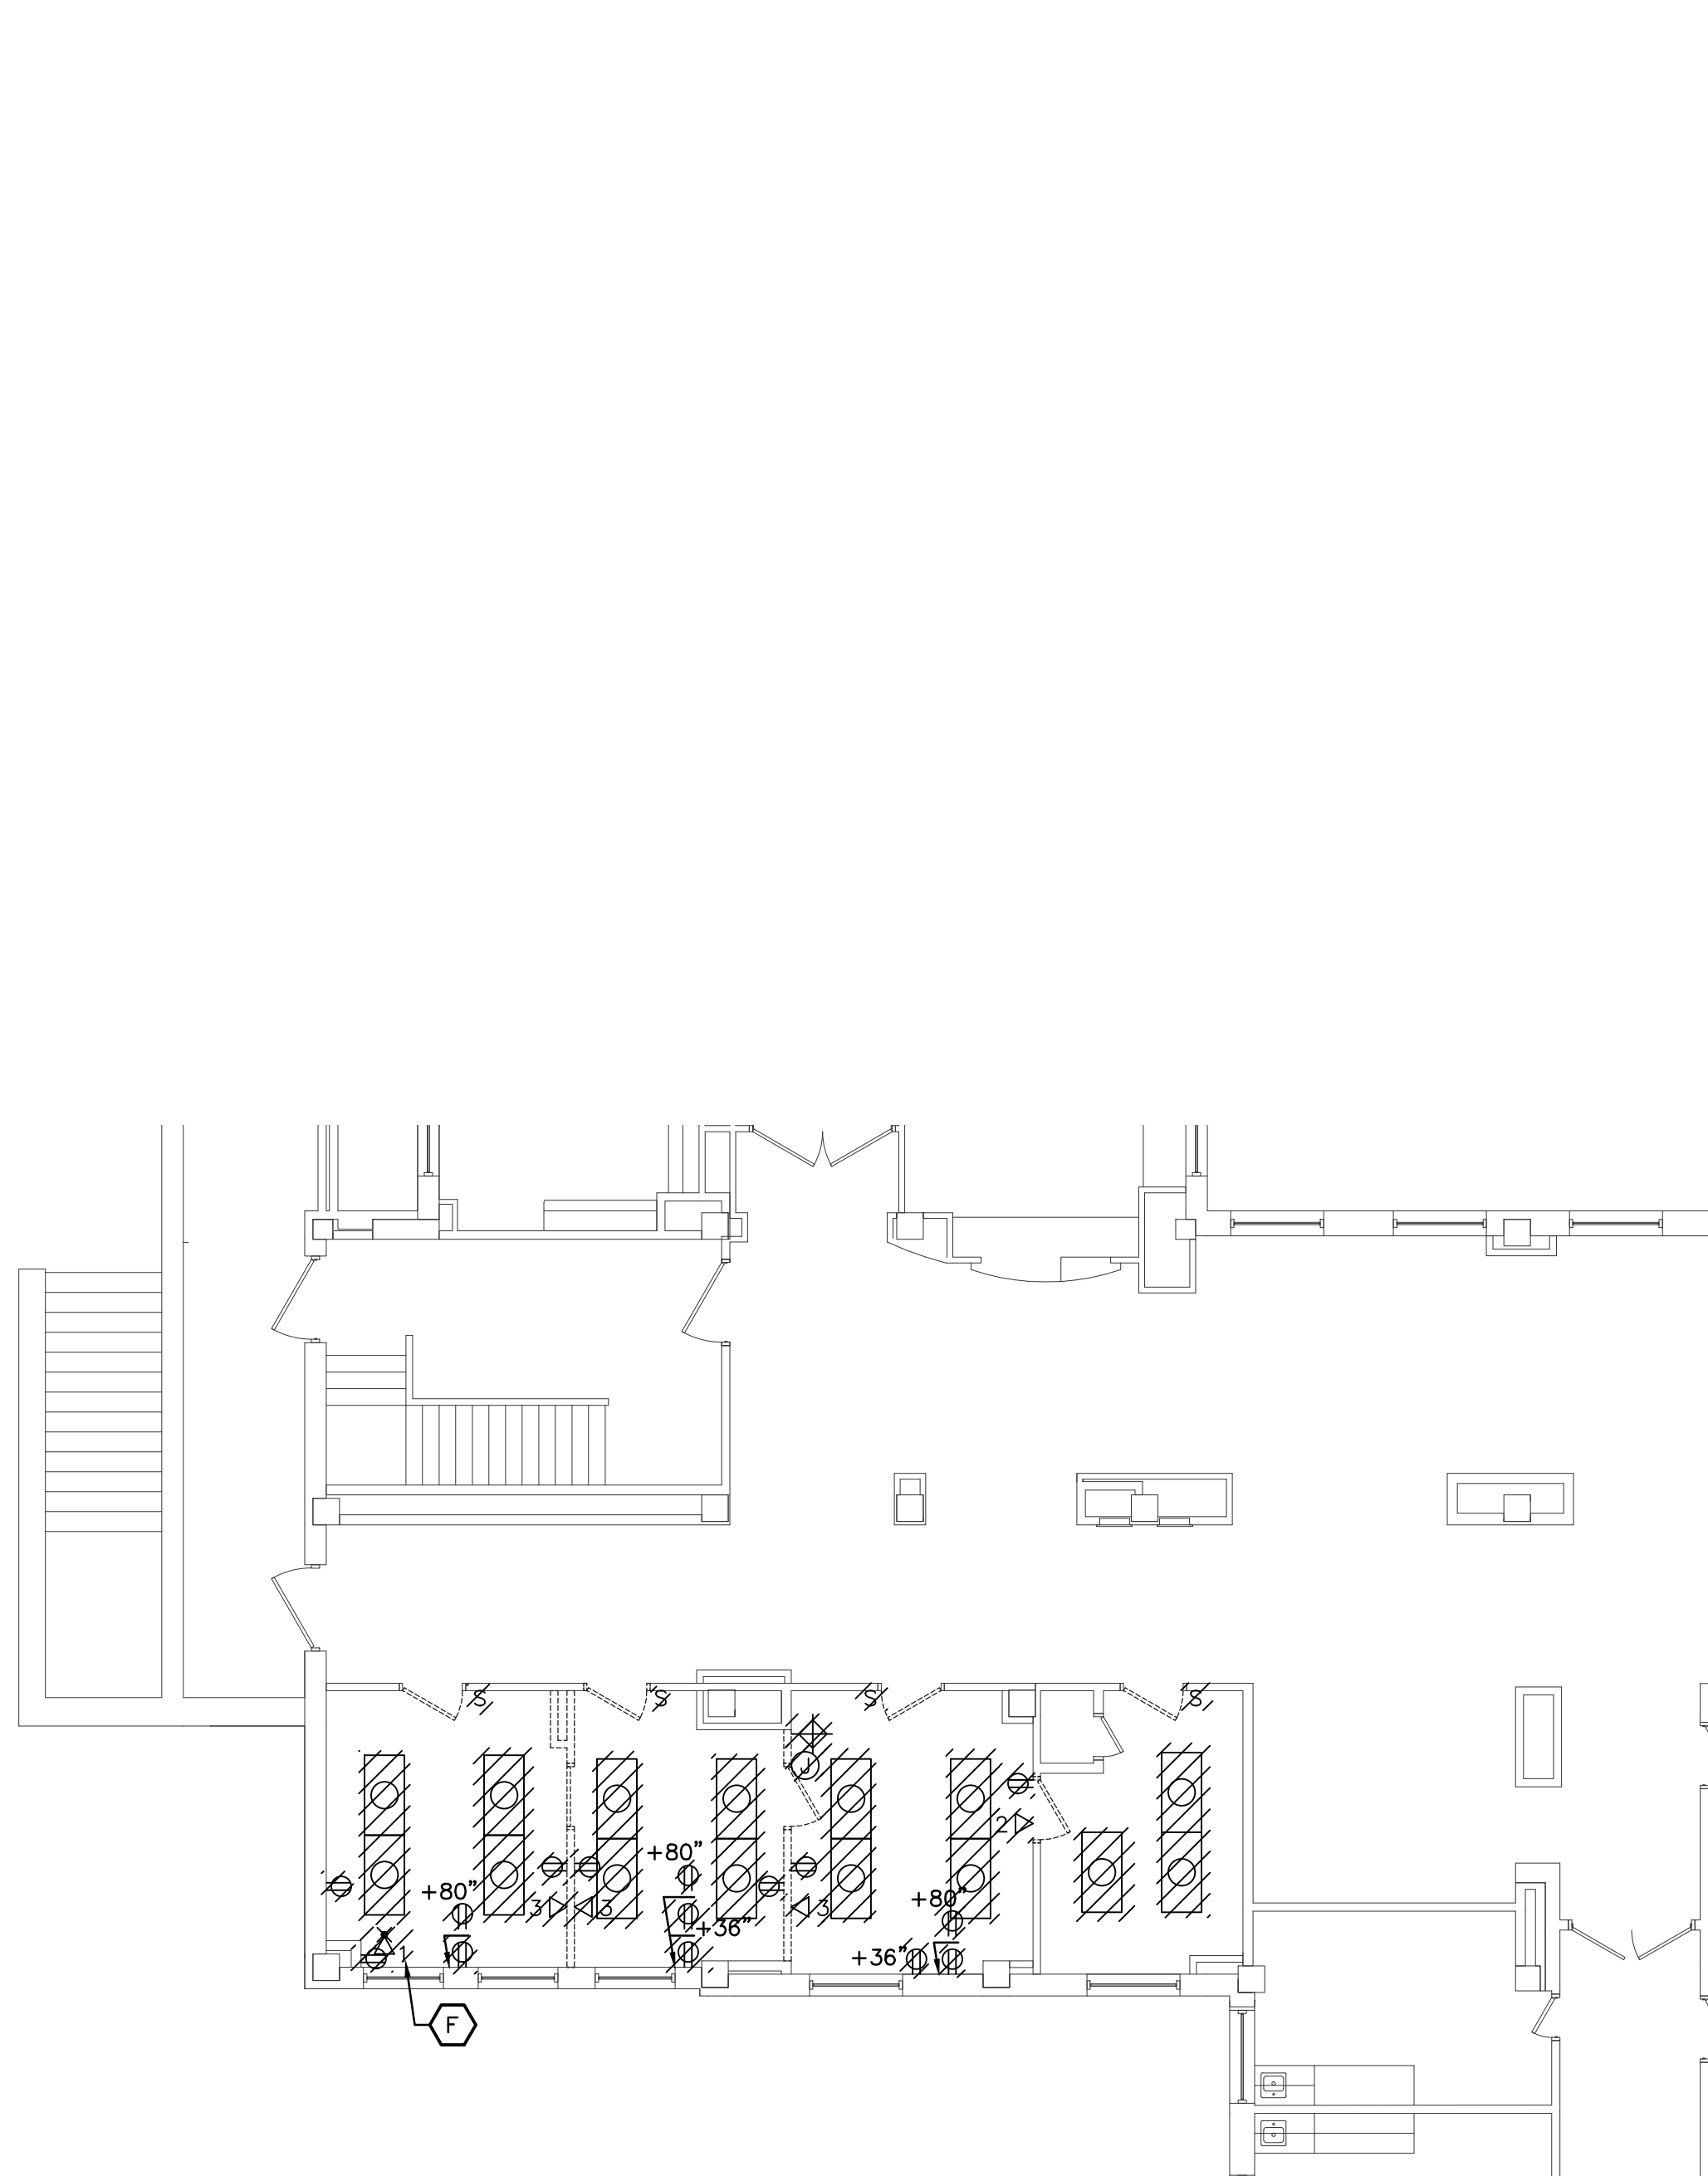

ELECTRICAL KEYNOTES

- 1 EXISTING HOSPITAL PAGING SPEAKER TO BE RELOCATED AND RECONNECTED. SEE SHEET E2.1 FOR NEW LOCATION.
- 2 REMOTE DUCT DETECTOR ALARM TO BE RELOCATED AND RECONNECTED. SEE SHEET E2.1 FOR NEW LOCATION.
- 3 REMOVE COMMUNICATION EQUIPMENT AND ALL ABANDONED CABLES AS COMPLETE AS POSSIBLE BACK TO THE NEAREST ACCESSIBLE LOCATION WITHIN THE PROJECT BOUNDARIES. FIELD VERIFY AND COORDINATE EXACT SCOPE OF WORK WITH COTR.
- 4 EXISTING PANELS TO BE REPLACED. SEE SHEET E2.1.

GENERAL ELECTRICAL DEMOLITION NOTES

- a. THE CONTRACTOR SHALL COORDINATE AND SCHEDULE ALL NECESSARY POWER OUTAGES WITH THE OWNERS REPRESENTATIVE PRIOR TO PROCEEDING WITH WORK TO INSURE THAT OPERATIONS IN ADJACENT OCCUPIED PORTIONS OF THE BUILDING ARE NOT INTERRUPTED OR RESTRICTED WITHOUT PRIOR APPROVAL.
- b. THE CONTRACTOR SHALL BE RESPONSIBLE FOR REPAIRING, PAINTING OR REPLACEMENT OF ALL WALL, CEILING, OR OTHER BUILDING ELEMENTS WHICH ARE DISTURBED AS PART OF THE DEMOLITION OR INSTALLATION OF ELECTRICAL WORK.
- c. THE CONTRACTOR SHALL COMPLETELY REMOVE ALL WIRING, CONDUIT, SWITCHES, DISCONNECTS, LIGHTING FIXTURES AND OTHER ASSOCIATED ITEMS AS SHOWN (CROSSHATCHED). THE ITEMS INDICATED SPECIFICALLY ON THE DRAWINGS TO BE REMOVED ARE ONLY TO INDICATE IN GENERAL TO THE CONTRACTOR THE AMOUNT OF DEMOLITION WORK INVOLVED. A SITE INVESTIGATION BY THE CONTRACTOR SHOULD BE PERFORMED TO AID IN DETERMINING THE COMPLETE EXTENT OF WORK INVOLVED.
- d. ALL EXISTING BRANCH CIRCUITS BEING REMOVED SHALL BE REMOVED AS COMPLETE AS POSSIBLE. EXISTING CONDUCTORS SHALL BE REMOVED COMPLETELY FROM THEIR RACEWAYS, DISPOSED OF AS SCRAP. REMOVED FROM SITE AND NOT REUSED EXCEPT WHERE SPECIFICALLY NOTED OTHERWISE. WHERE AN EXISTING DEVICE IS SHOWN REMOVED FROM AN EXISTING CIRCUIT, NEW WIRING SHALL BE PROVIDED AS REQUIRED TO INSURE CONTINUITY OF EXISTING CIRCUIT. ELECTRICAL RACEWAYS WHERE STUBBED FROM A CONCRETE FLOOR OR WALL SHALL BE CHISELED 2 INCHES BELOW SURFACE, GROUTED AND SCALED.
- e. ALL EXISTING LIGHT FIXTURES, LAMPS, AND ELECTRICAL EQUIPMENT SHOWN TO BE REMOVED SHALL BE REMOVED BY THE CONTRACTOR. EXISTING FIXTURES AND EQUIPMENT CONSIDERED SALVAGEABLE BY THE OWNER AND NOT SHOWN TO BE REUSED SHALL BE TURNED OVER TO THE OWNER OR REMOVED FROM SITE AS DIRECTED BY OWNER. LAMPS AND BALLASTS THAT ARE CONSIDERED AS HAZARDOUS WASTE SHALL BE DISPOSED OF PROPERLY.
- f. ALL EXISTING SURFACE MOUNTED BACKBOXES, CONDUIT, WIREWAY, JUNCTION BOXES, ETC. SHOWN REMOVED SHALL BE REMOVED IN THEIR ENTIRETY. ALL RECESSED BACKBOXES, JUNCTION BOXES SHOWN REMOVED SHALL BE ABANDONED IN PLACE AND COVERED WITH STAINLESS STEEL COVER PLATES. ALL RECESSED CONDUIT SHALL BE ABANDONED IN PLACE AND CAPPED OFF IN A SUITABLE MANNER PER LOCAL INSPECTORS REQUIREMENTS.
- g. REMOVE ELECTRICAL CONNECTIONS TO ALL MECHANICAL EQUIPMENT BEING REMOVED BY DIVISION 15. COORDINATE EQUIPMENT REMOVAL LOCATIONS WITH MECHANICAL DRAWINGS.

OWNER CHANGES Revisions 6-13-2012 Date		IMPORTANT CONTRACTOR'S NOTE 1. ALL CONTRACTORS ARE RESPONSIBLE FOR REVIEWING ENTIRE SET OF DOCUMENTS TO DETERMINE THEIR FULL SCOPE OF WORK. CONTRACTOR SHALL NOT BE ALLOWED EXTRA COSTS DUE TO FAILURE TO REVIEW ENTIRE SET OF DOCUMENTS. 2. ANY USE OF THESE ELECTRONIC DRAWINGS OR SCALING OF THE PRINTED DOCUMENTS ARE DONE SO AT THE CONTRACTORS RISK.		ARCHITECT/ENGINEERS: CLH Calvin L. Hinz Architects, P.C. 3705 North 200th Street Elkhorn, Nebraska 68022 Phone: 402.291.6941 Fax: 402.291.9193 KRS KRS Engineering, LLC 11620 ARBOR STREET SUITE 100 OMAHA, NEBRASKA 68144 PHONE: 402.932.0100 FAX: 402.932.1001 www.krsengineering.com KRS # 121013 COPYRIGHT 2012 This document and the information contained may not be reproduced without the express written permission of KRS Engineering, LLC. Unauthorized copying, disclosure or construction use are prohibited by the copyright law.		Drawing Title - BASE BID ELECTRICAL DEMOLITION PLAN - 1st FLOOR - BASE BID ELECTRICAL DEMOLITION PLAN - 2nd FLOOR Approved Project Director KEVIN HUTSELL CONSTRUCTION DOCUMENT (CD-3) SUBMITTAL 100% APRIL 13, 2012		Project Title RENOVATE BACKFILL CANTEN SPACE NWIHCs Location VAMC Grand Island, NE Date APRIL 13, 2012 Checked KJM Drawn GJH		Project Number 636-12-103 Building Number ONE Drawing Number ED1.1 Dwg. 35 of 41		Office of Construction and Facilities Management Department of Veterans Affairs	
--	--	---	--	---	--	---	--	--	--	---	--	---	--