



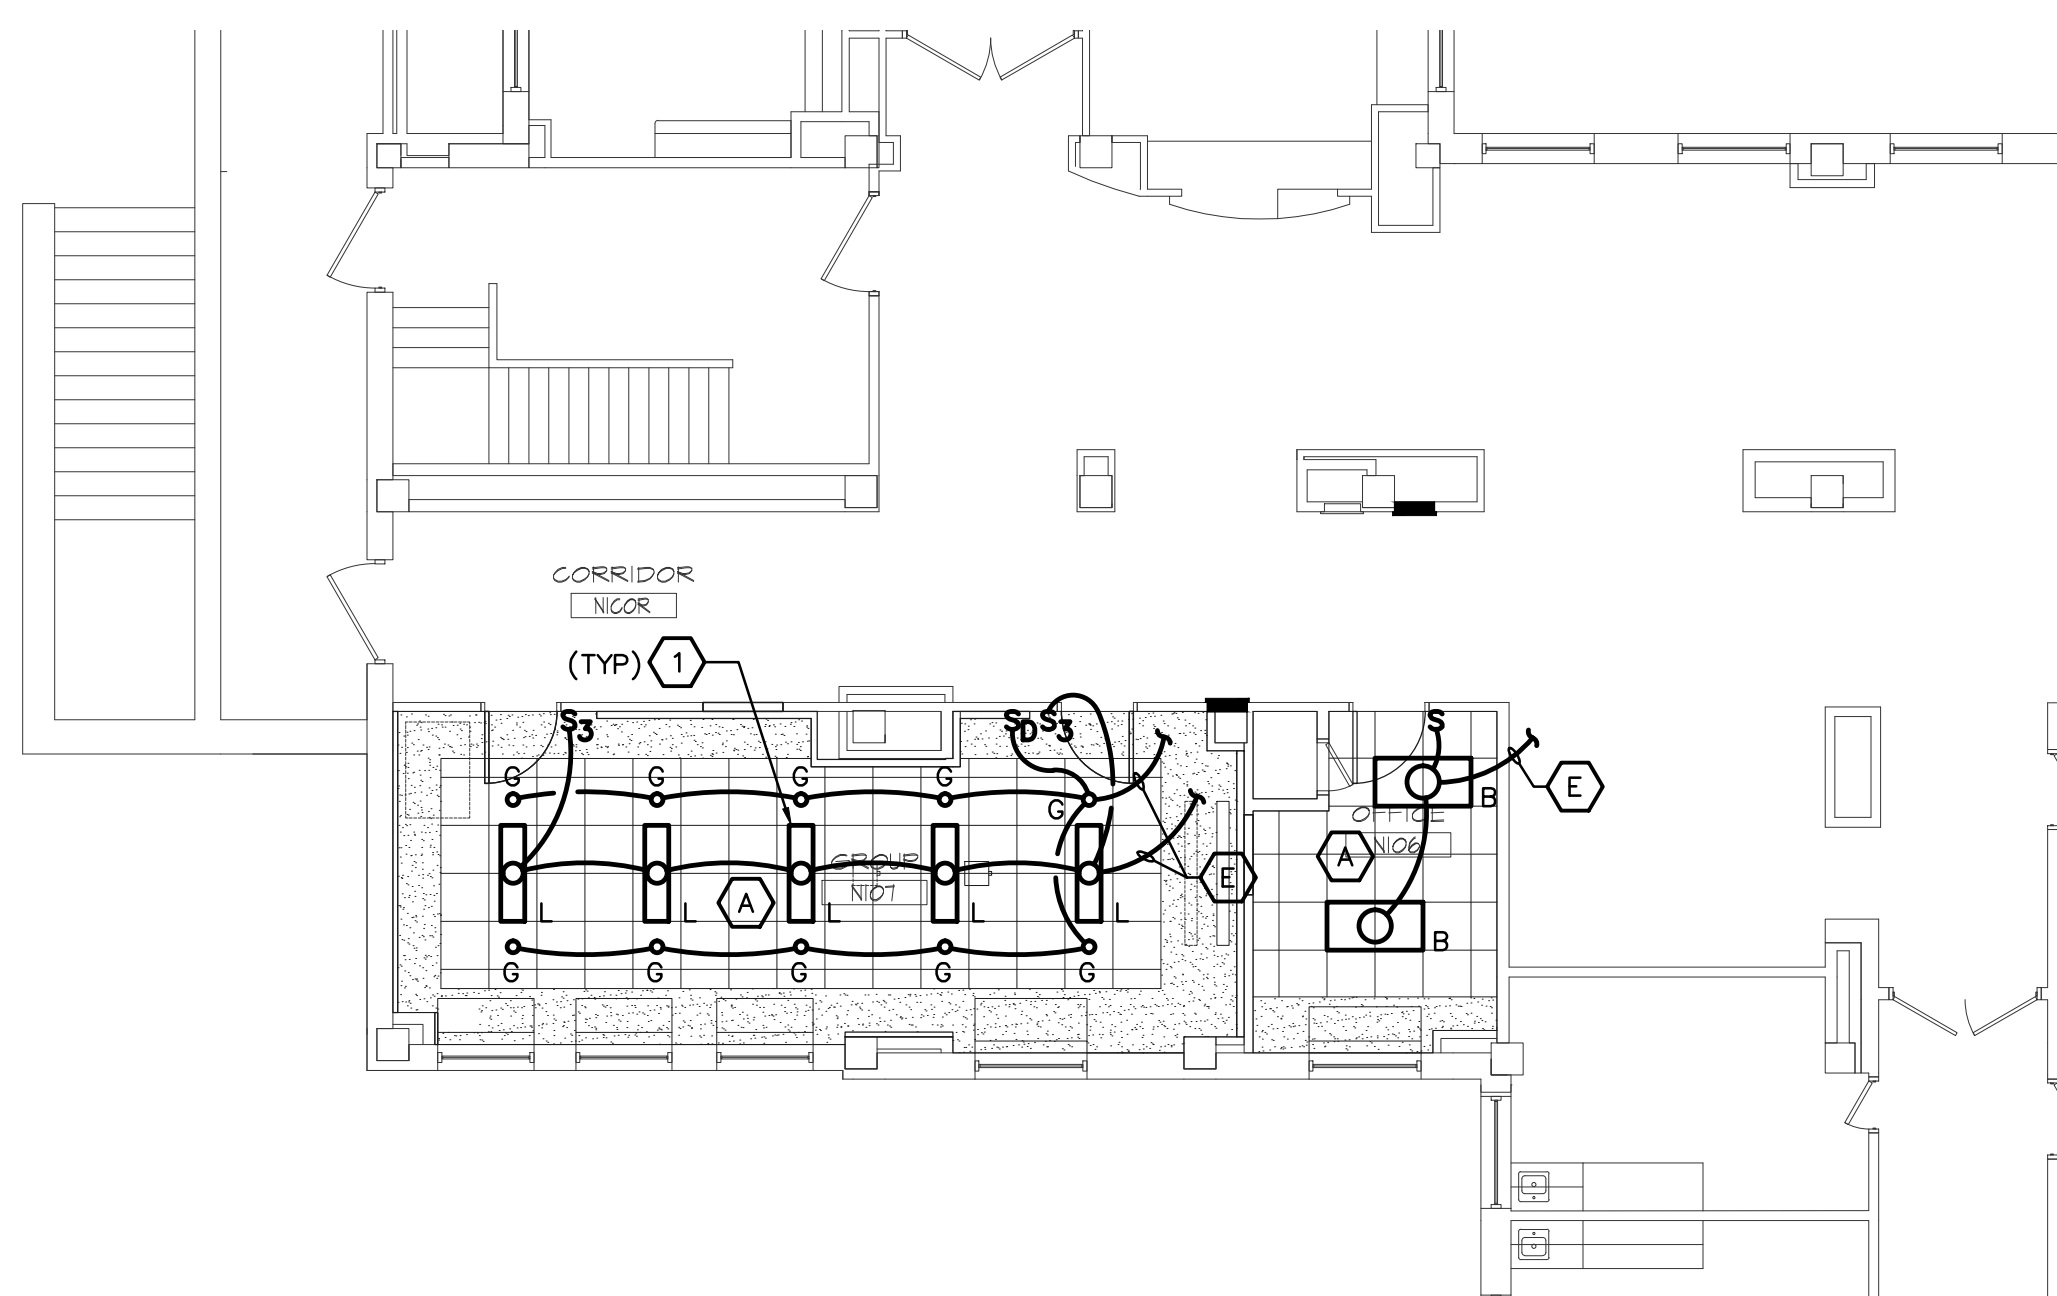

BASE BID
LIGHTING PLAN - 1st FLOOR
SCALE: 1/8" = 1'-0"
TRUE NORTH

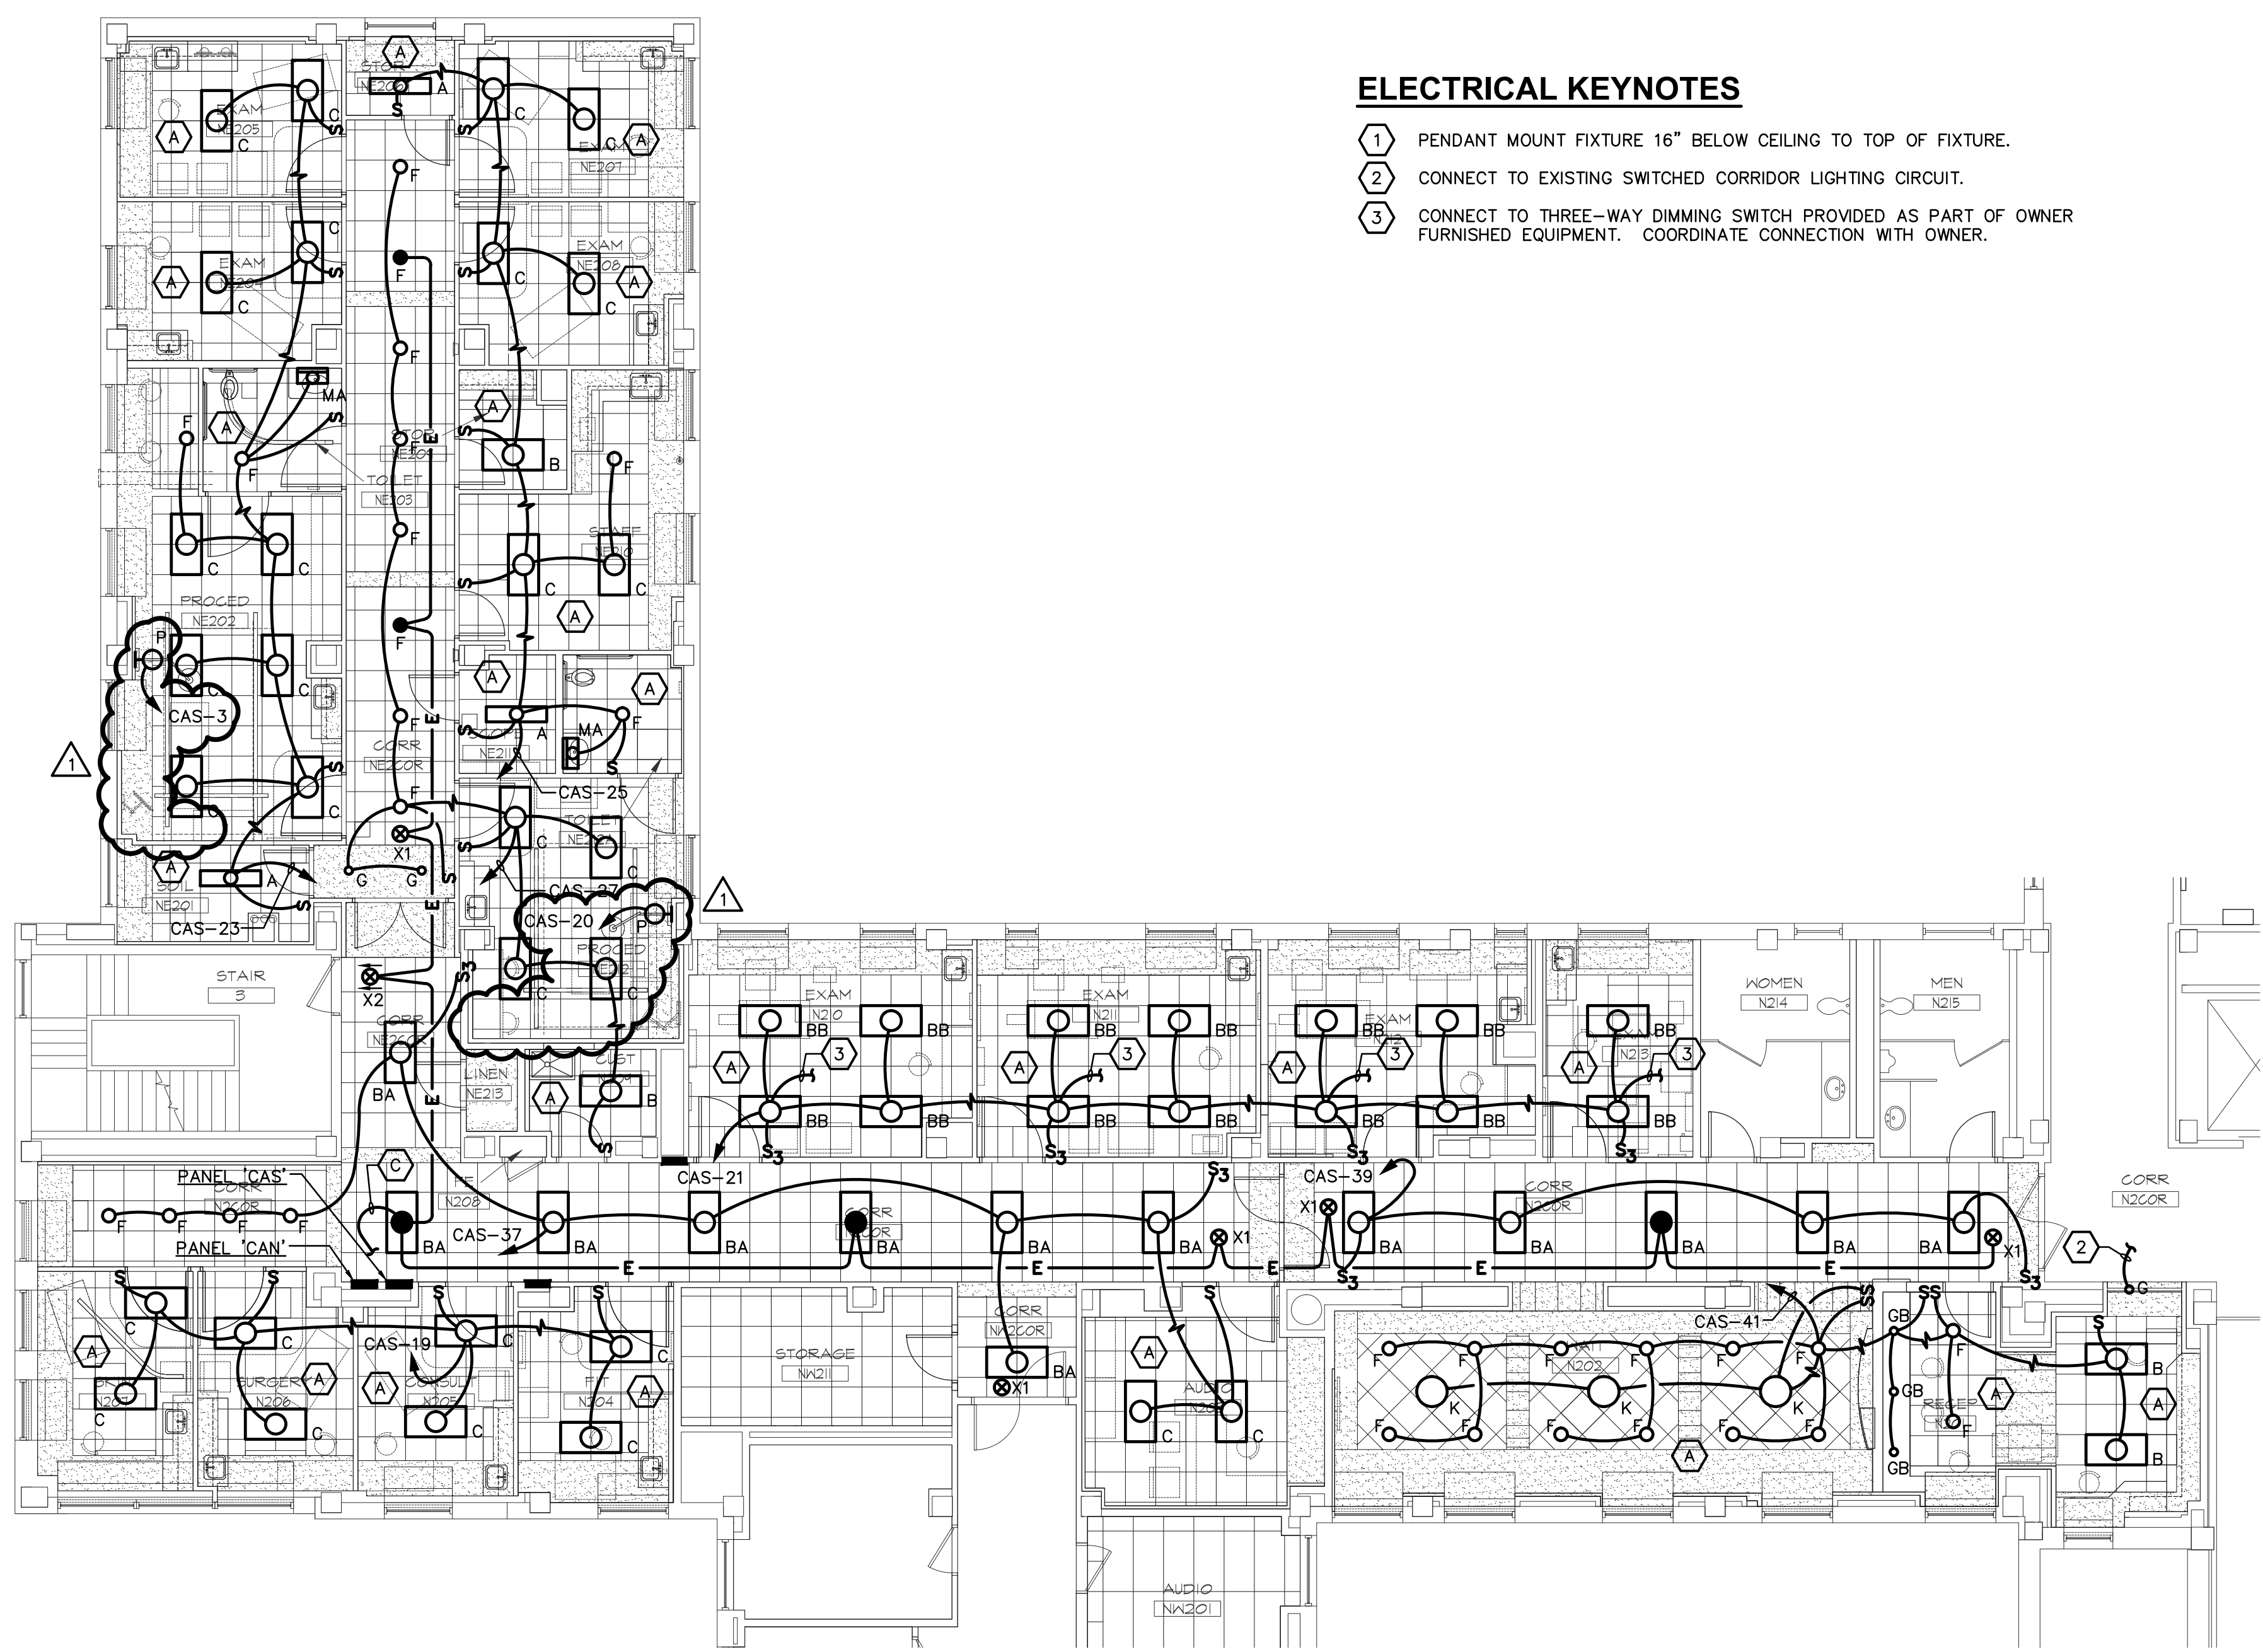

BASE BID
LIGHTING PLAN - 2nd FLOOR
SCALE: 1/8" = 1'-0"
TRUE NORTH

- ELECTRICAL KEYNOTES**
- 1 PENDANT MOUNT FIXTURE 16" BELOW CEILING TO TOP OF FIXTURE.
 - 2 CONNECT TO EXISTING SWITCHED CORRIDOR LIGHTING CIRCUIT.
 - 3 CONNECT TO THREE-WAY DIMMING SWITCH PROVIDED AS PART OF OWNER FURNISHED EQUIPMENT. COORDINATE CONNECTION WITH OWNER.

OWNER CHANGES Revisions 6-13-2012 Date		IMPORTANT CONTRACTOR'S NOTE 1. ALL CONTRACTORS ARE RESPONSIBLE FOR REVIEWING ENTIRE SET OF DOCUMENTS TO DETERMINE THEIR FULL SCOPE OF WORK. CONTRACTOR SHALL NOT BE ALLOWED EXTRA COSTS DUE TO FAILURE TO REVIEW ENTIRE SET OF DOCUMENTS. 2. ANY USE OF THESE ELECTRONIC DRAWINGS OR SCALING OF THE PRINTED DOCUMENTS ARE DONE SO AT THE CONTRACTOR'S RISK.		ARCHITECT/ENGINEERS: CLH Calvin L. Hinz Architects, P.C. 3705 North 200th Street Elkhorn, Nebraska 68022 Phone: 402.291.6941 Fax: 402.291.9193 KRS KRS Engineering, LLC 11620 ARBOR STREET SUITE 100 OMAHA, NEBRASKA 68144 PHONE: 402.932.0100 FAX: 402.932.1001 www.krsengineering.com COPYRIGHT 2012 This document and the information contained may not be reproduced without the express written permission of KRS Engineering, LLC. Unauthorized copying, disclosure or construction use are prohibited by the copyright law.		Drawing Title - BASE BID LIGHTING PLAN - 1st FLOOR - BASE BID LIGHTING PLAN - 2nd FLOOR Approved Project Director KEVIN HUTSELL CONSTRUCTION DOCUMENT (CD-3) SUBMITTAL 100% APRIL 13, 2012		Project Title RENOVATE BACKFILL CANTEN SPACE NWIHCS Location VAMC Grand Island, NE Date APRIL 13, 2012 Checked KJM Drawn GJH		Project Number 636-12-103 Building Number ONE Drawing Number E11 Dwg. 37 of 41		Office of Construction and Facilities Management Department of Veterans Affairs	
--	--	--	--	---	--	---	--	---	--	---	--	---	--