GENERAL SHEET NOTES:

1. REFER TO DRAWING MH-001 FOR SYMBOLS AND ABBREVIATIONS.
2. VERIFY LOCATION AND DIMENSIONS OF EXISTING EQUIPMENT AND COORDINATE ALL WORK PRIOR TO THE START OF CONSTRUCTION.
3. CONTRACTOR REQUIRED TO PROVIDE BARRIERS AROUND TRENCHED AREAS AT ALL TIMES WHEN NOT ATTENDED.
4. PROVIDE METAL PLATES ACROSS TRENCHES IN PARKING AREAS WHEN NOT ATTENDED.
5. CONTRACTOR REQUIRED TO RE-PAINT ANY AND ALL PARKING LOT MARKINGS DISTURBED AS PART OF THE PIPE TRENCHING WORK. PAINTING TO BE IN THE SAME LOCATION, AND SAME COLOR AS BEFORE.

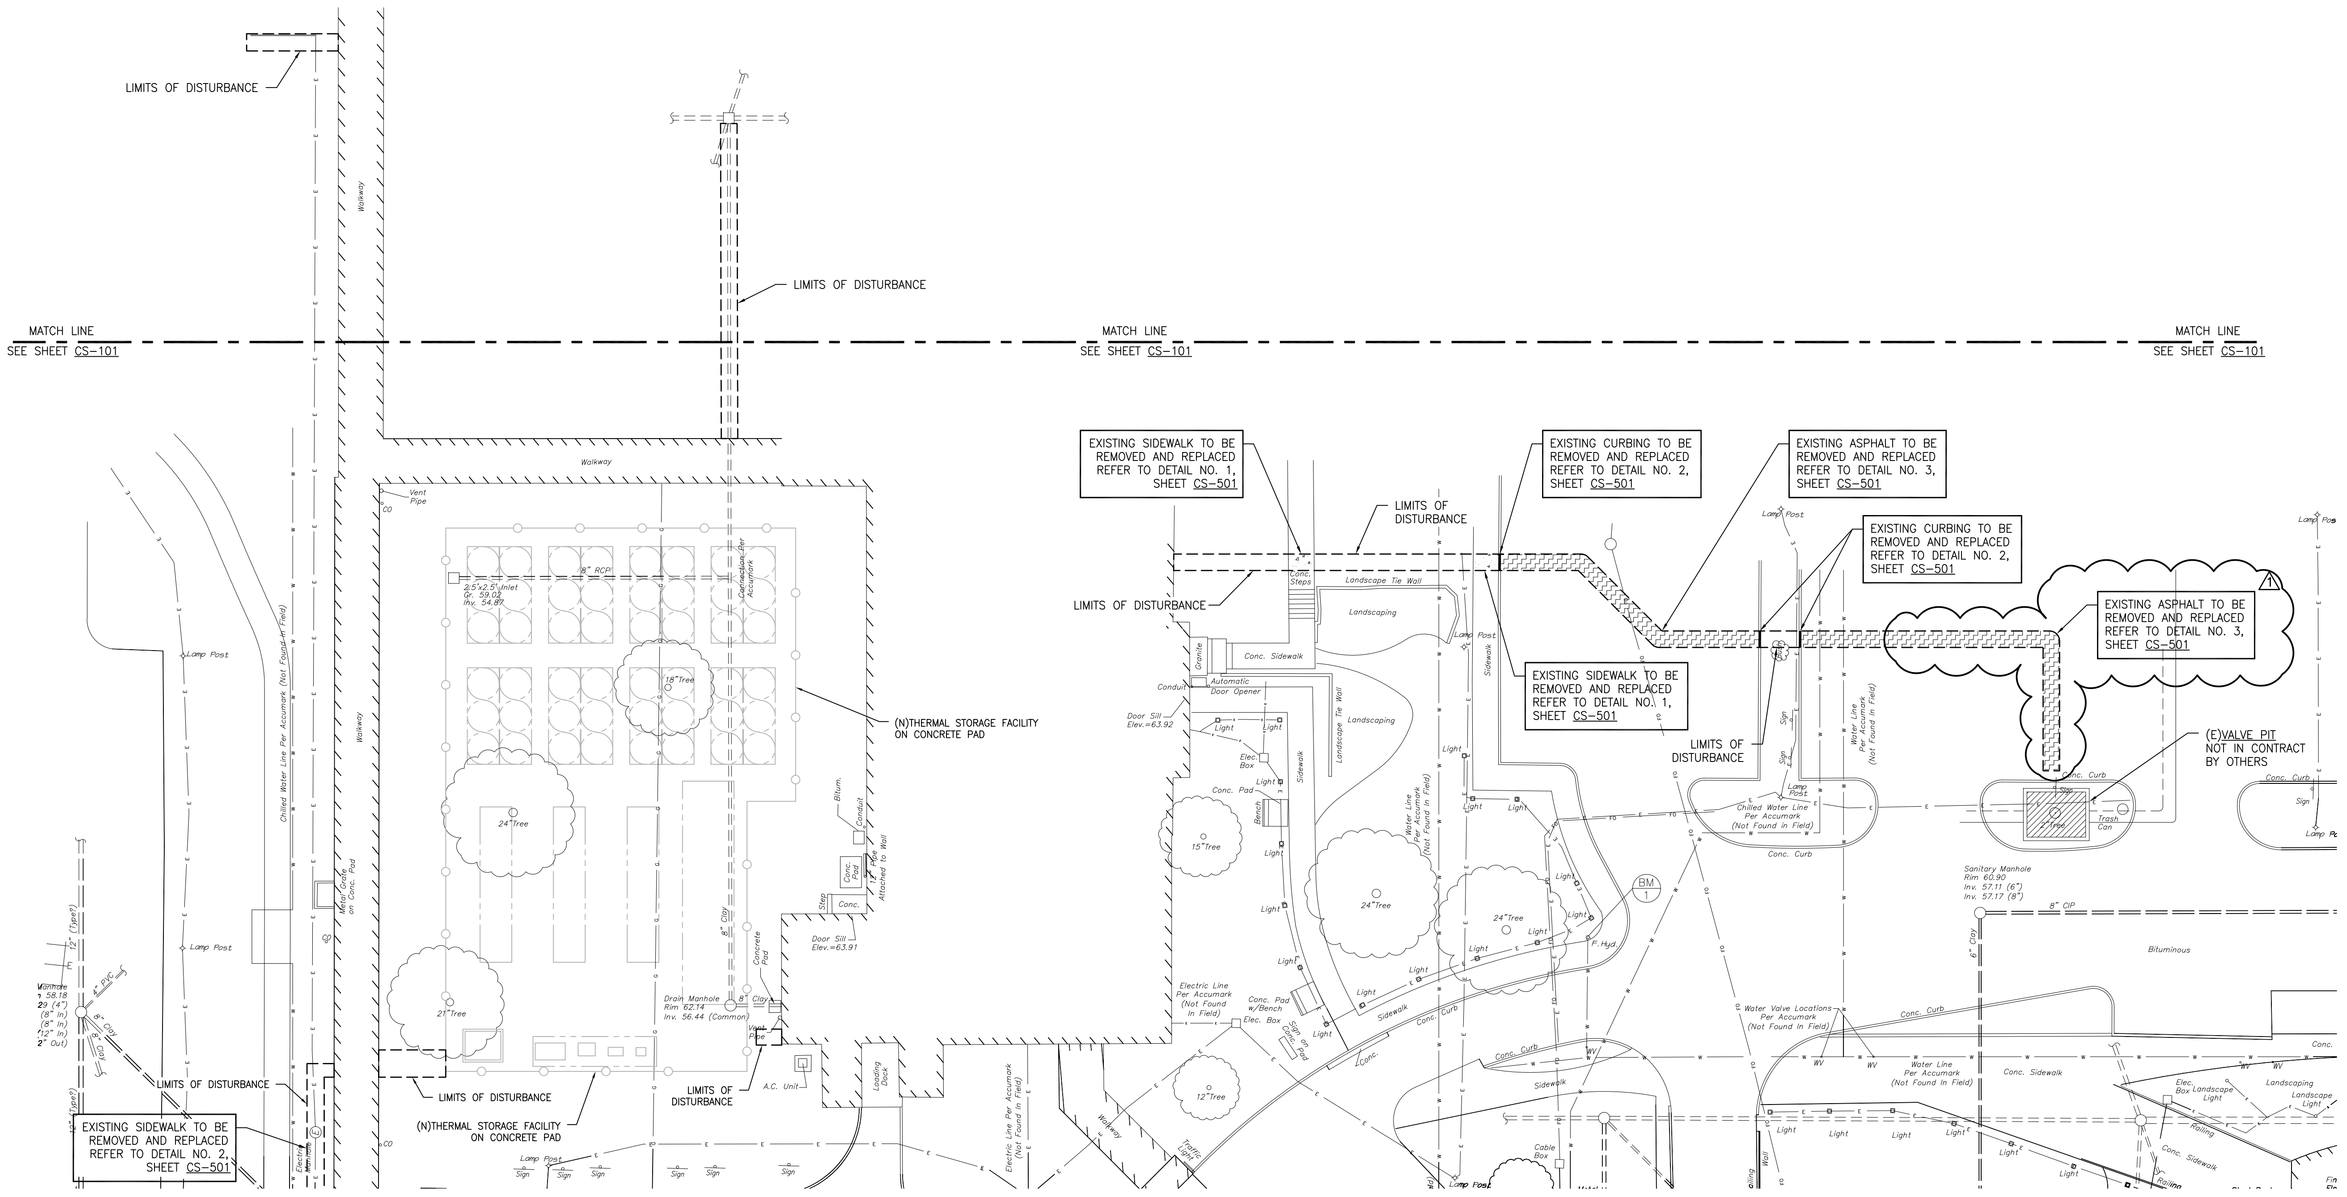

1 PARTIAL SITE PLAN
SCALE: 1"=20'

CONSTRUCTION DOCUMENTS

⚠ ADDENDUM #1	06-11-12
Revisions	Date

CONSULTANTS:

Mechanical/Electrical/Plumbing/Structure:

ANTHONY D. PACARO JR., P.E.
MILLER-REMICK CORPORATION
PROFESSIONAL ENGINEER
PENNSYLVANIA LICENSE NO. PE062779

SIGNATURE: _____

ARCHITECT/ENGINEERS:

Miller-Remick LLC
M.E.P. & Structural Engineering
A Veteran Owned Small Business
1010 KINGS HIGHWAY SOUTH
BUILDING ONE – 1st FLOOR
CHERRY HILL, NEW JERSEY 08034
PHONE: (856)429-4000
FAX: (856)429-5002

Drawing Title	SITE PLAN – EAST SCALE: 1"=20'
Approved Project Director	
Project Title	THERMAL STORAGE FOR CHILLER PLANT
Location	VA MED. CENTER, LEBANON, PA
Date	6/11/2012
Checked	KD
Drawn	MM
Project Number	595-11-131
Building Number	N/A
Drawing Number	CS-103
Dwg.	5 of 34

Office of Construction and Facilities Management
Department of Veterans Affairs

VA FORM 08-6231