




1 BLDG. 19 EMERG. POWER UNDERGROUND TUNNEL PENETRATION
SCALE: 3/4"=1'-0"

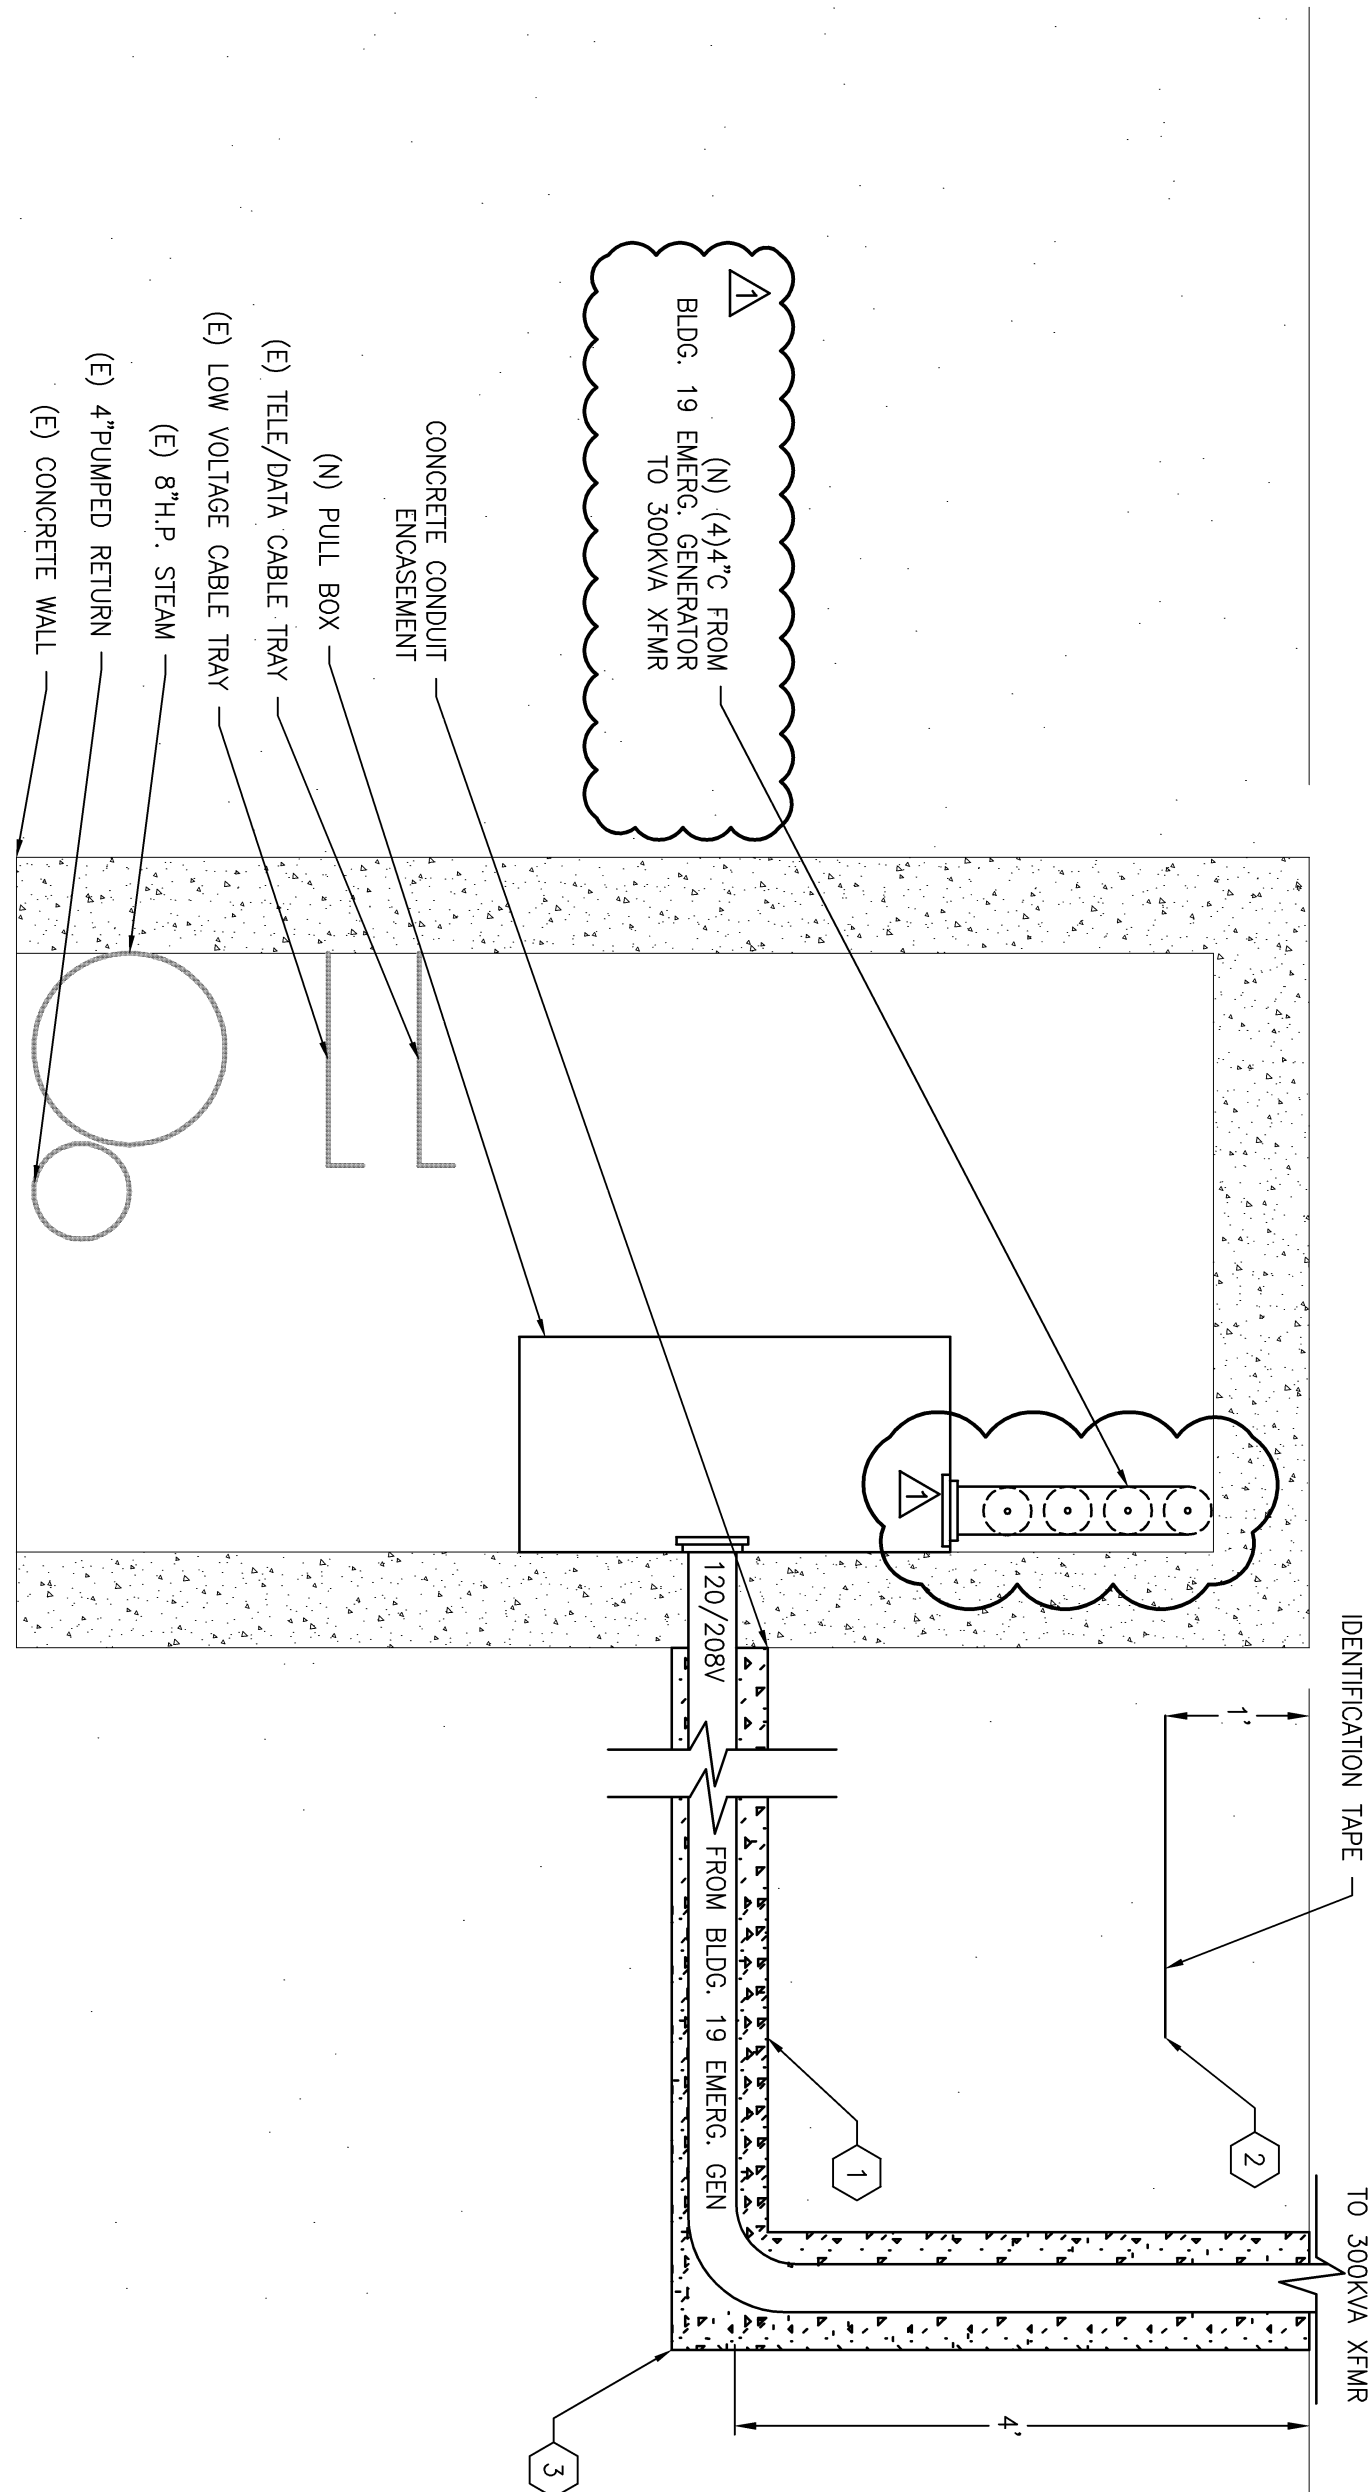

2 BLDG. 19 EMERG. POWER UNDERGROUND TUNNEL PENETRATION
SCALE: 3/4"=1'-0"

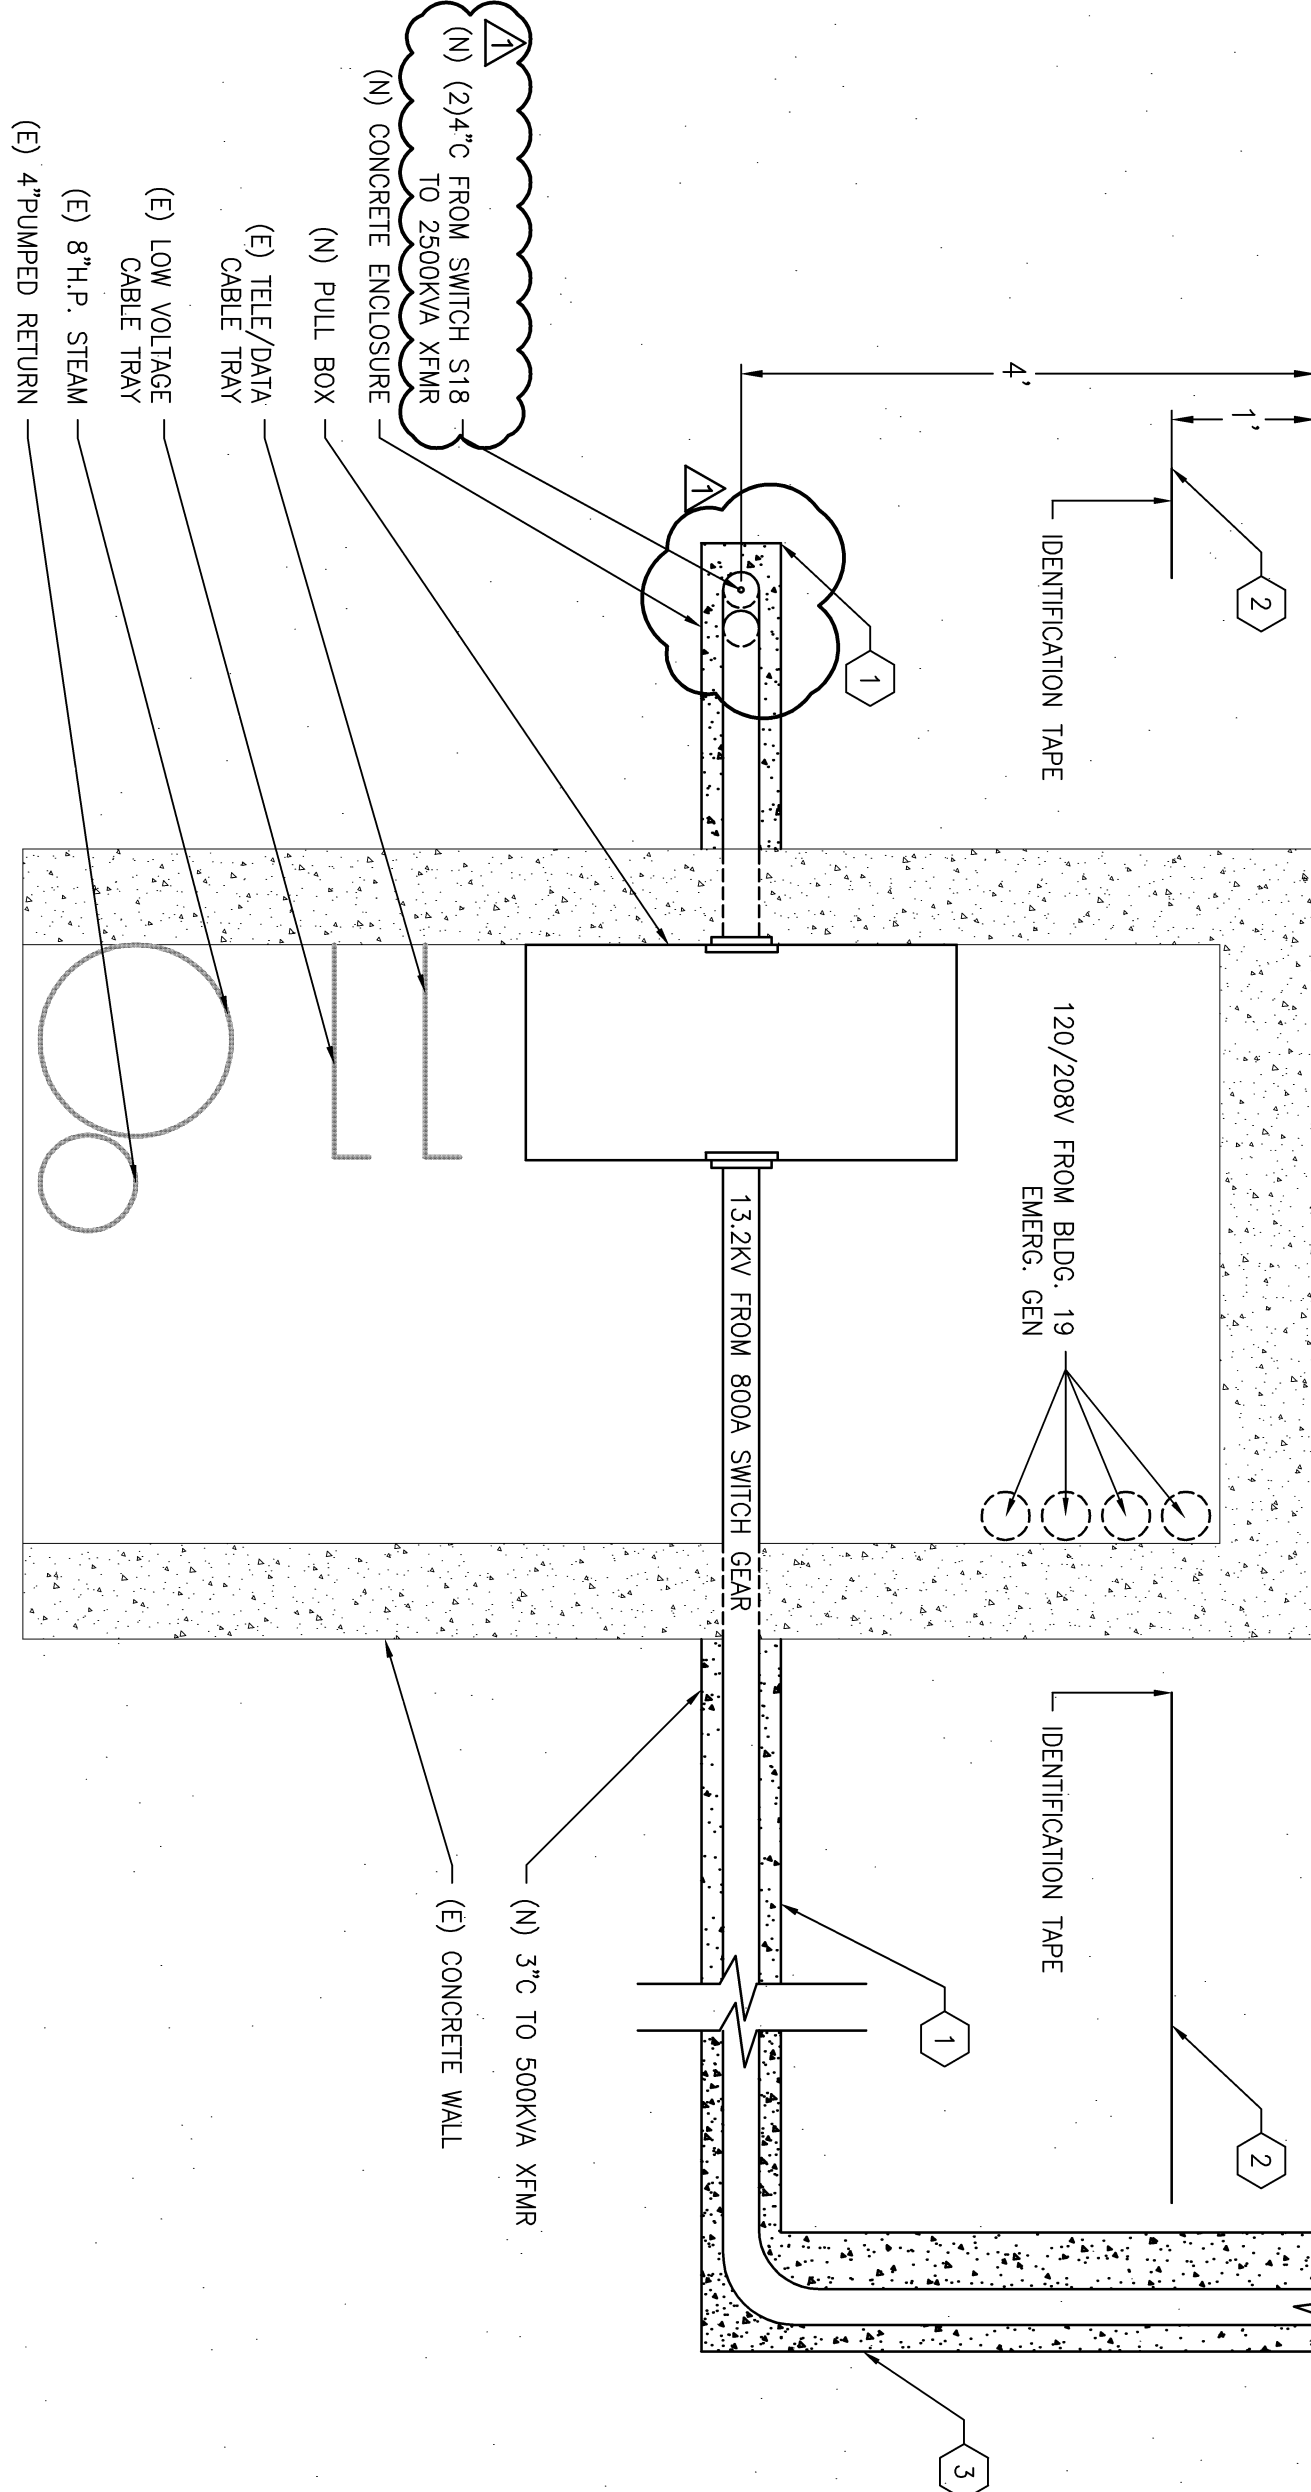

3 UNDERGROUND TUNNEL 13.2KV SECTION VIEW
SCALE: 3/4"=1'-0"

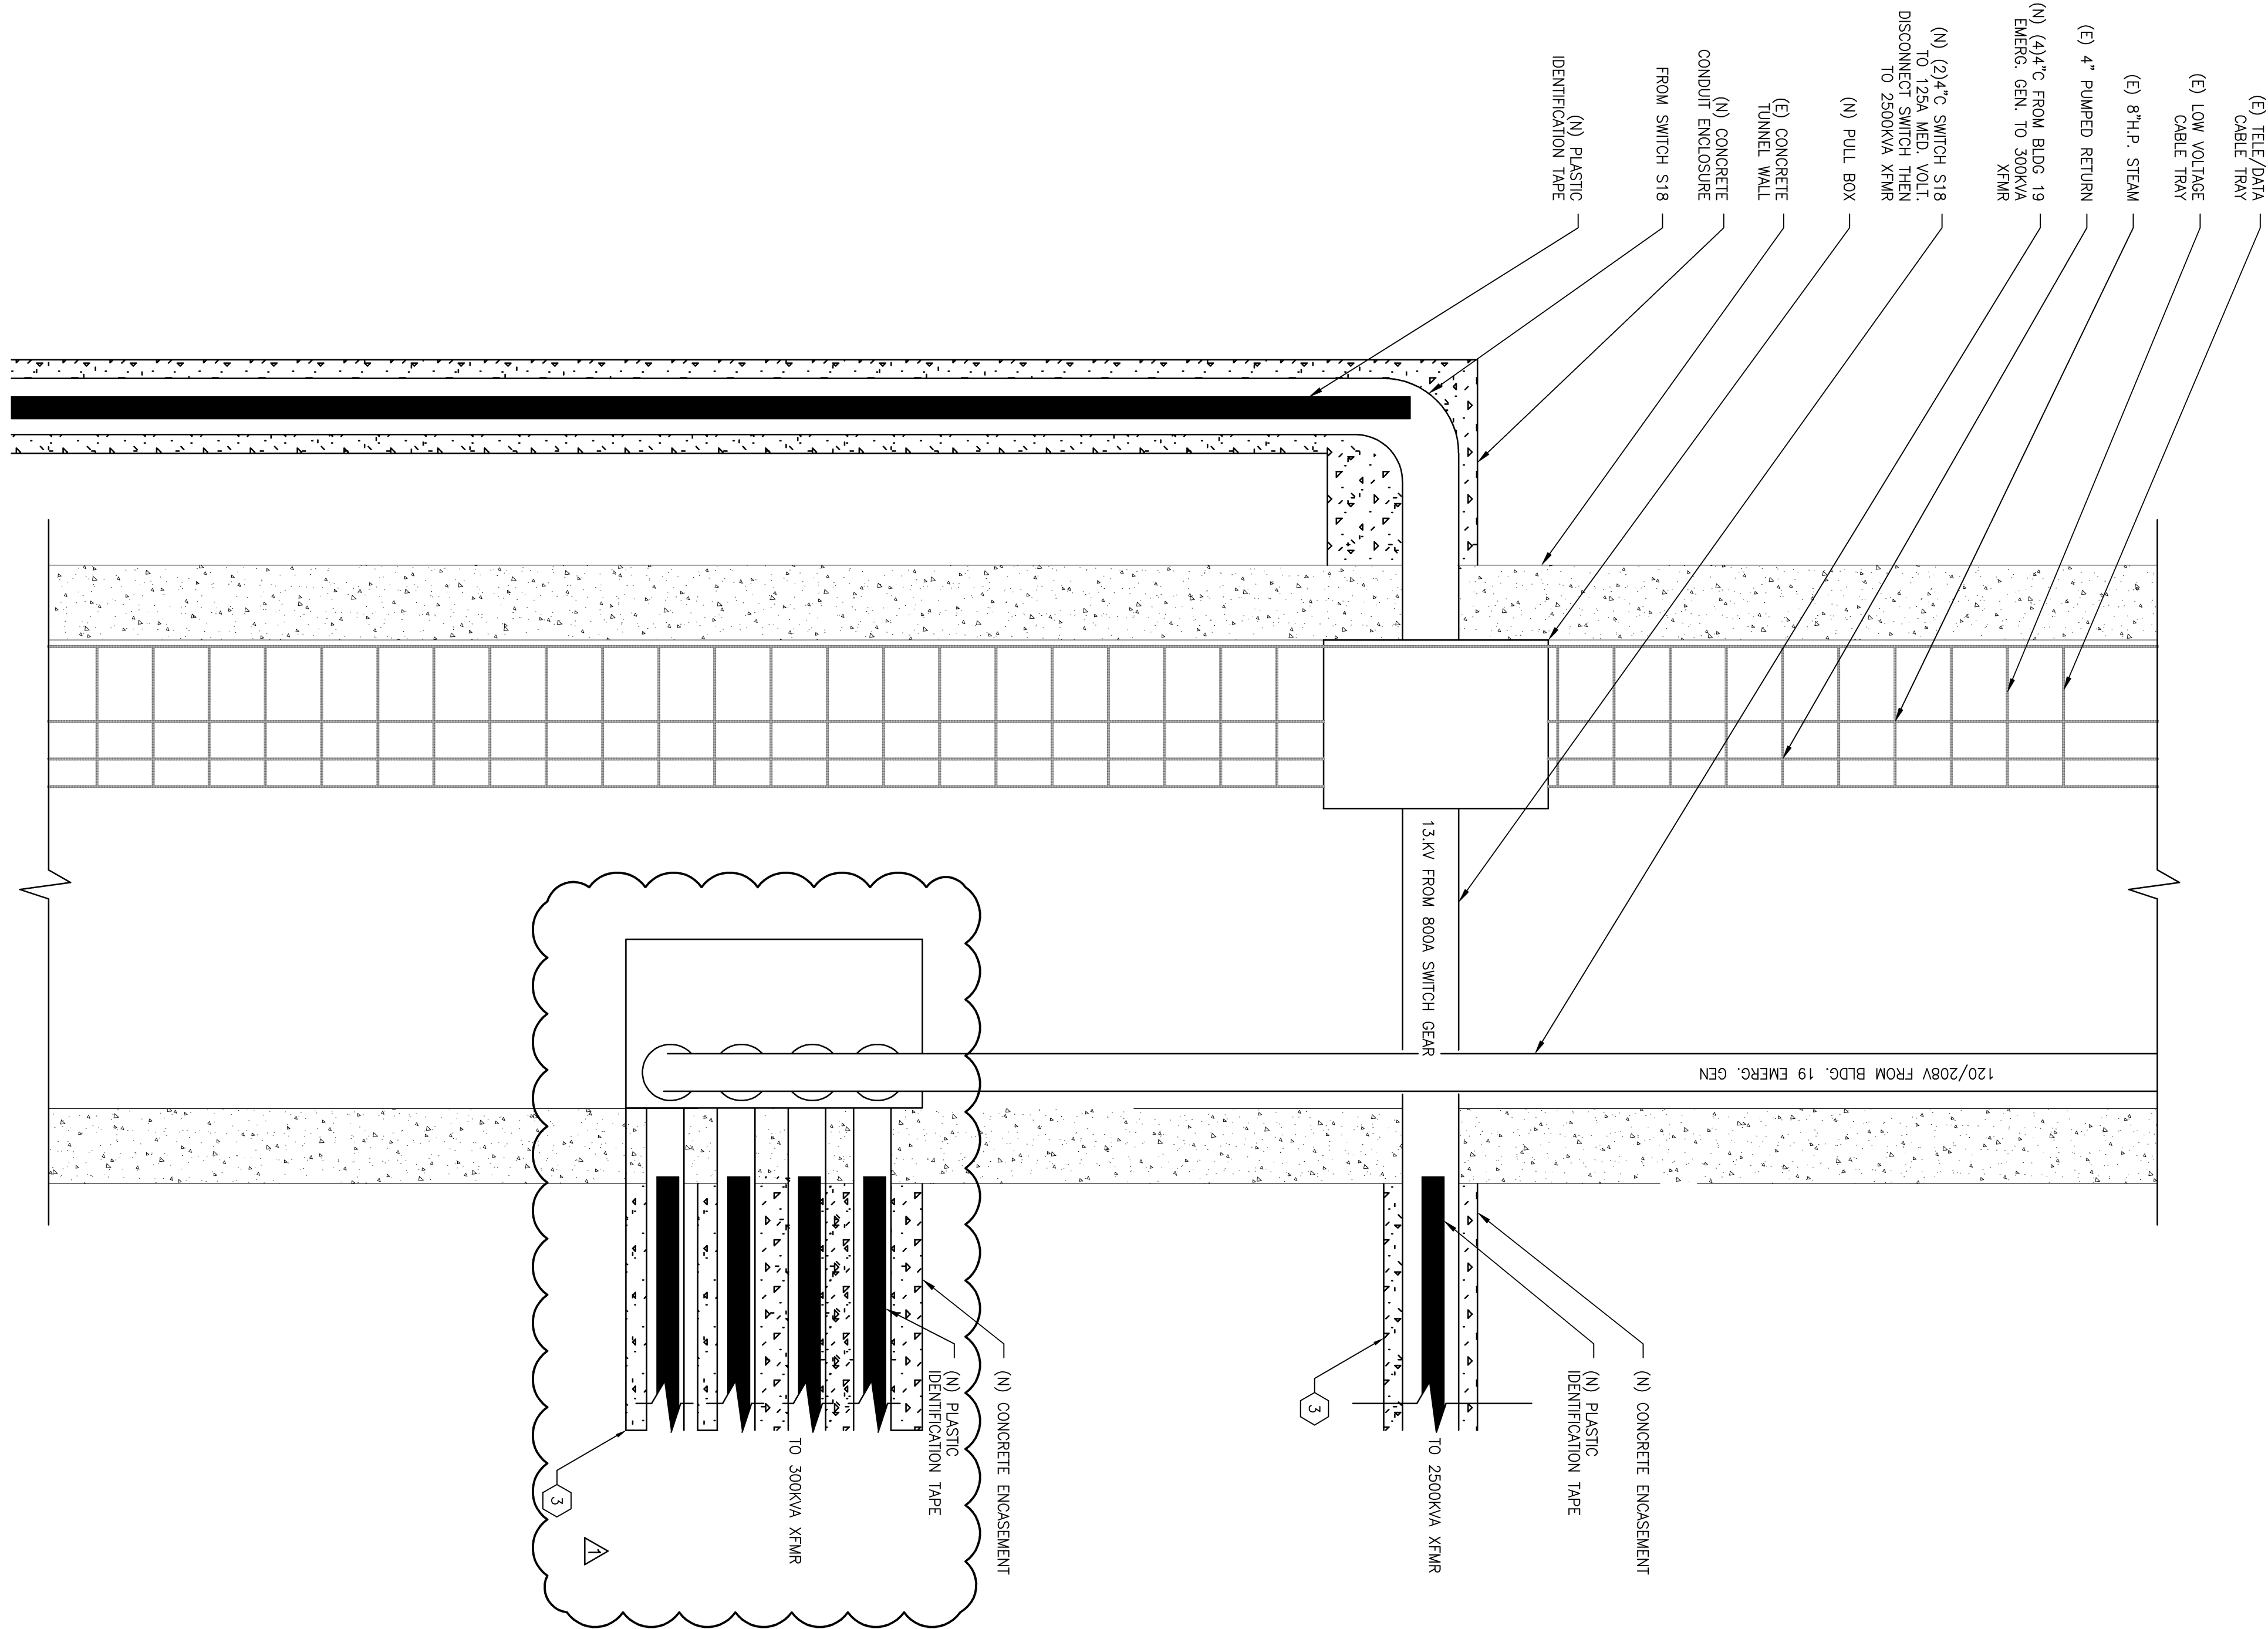

4 UNDERGROUND TUNNEL PENETRATION DETAIL
SCALE: 1"=1'-0"

- GENERAL SHEET NOTES:**
- SEE TWE E-101 FOR GENERAL NOTES, LEGEND, AND DIMENSIONS.
 - ELECTRICAL EQUIPMENT DIMENSIONS ARE AS SHOWN ON THE ELECTRICAL EQUIPMENT MANUFACTURE AND INSTALLATION DRAWINGS.
 - CONTRACTOR SHALL PROVIDE AND INSTALL CONCRETE AROUND ALL CONDUIT.
- SHEET KEYNOTES:**
- PER V.A. SPECIFICATION 26-05-41, CONDUITS ENCASED IN CONCRETE SHALL BE BURIED AT A MINIMUM OF 18\"/>

CONSULTANTS:

ADDENDUM #1	06-11-12
Revisions	

ARCHITECT/ENGINEERS:

THOMAS L. CHURCH, P.E.
PROFESSIONAL ENGINEER
PAVING/PAVING DESIGN INC. PROVIDER

Signature: _____

Miller-Ramick LLC
A Division of Ramick Construction, Inc.
1010 KINGS HIGHWAY SOUTH
CHERRY HILL, NEW JERSEY 08034
PHONE: (609)939-4000
FAX: (609)939-5502

Drawing Title

TUNNEL PENETRATION

SCALE: VARIOUS

Approved Project Director

Project Title

THERMAL STORAGE
FOR CHILLER PLANT

Project Number

595-11-131

Office of Construction and Facilities Management

Department of Veterans Affairs