

OFS BRANDS

OFS FirstOffice Carolina Loewenstein Highmark

CONCEPT ONLY

Special Req #: 352749

Item #:

Series: MILE MARKER



Tag:

Dwg #: 1539CM

Desc: SIOUX FALLS

Date: 3/16/17

Drawn By: CM

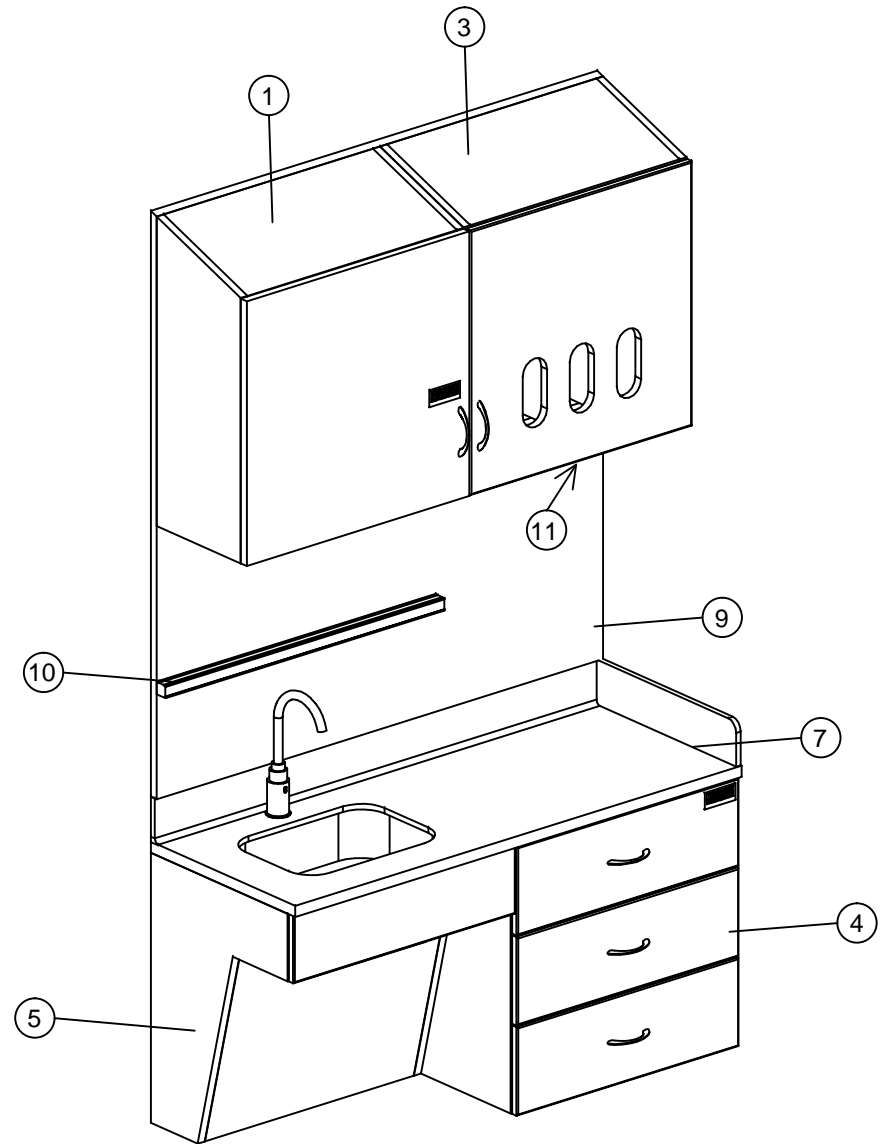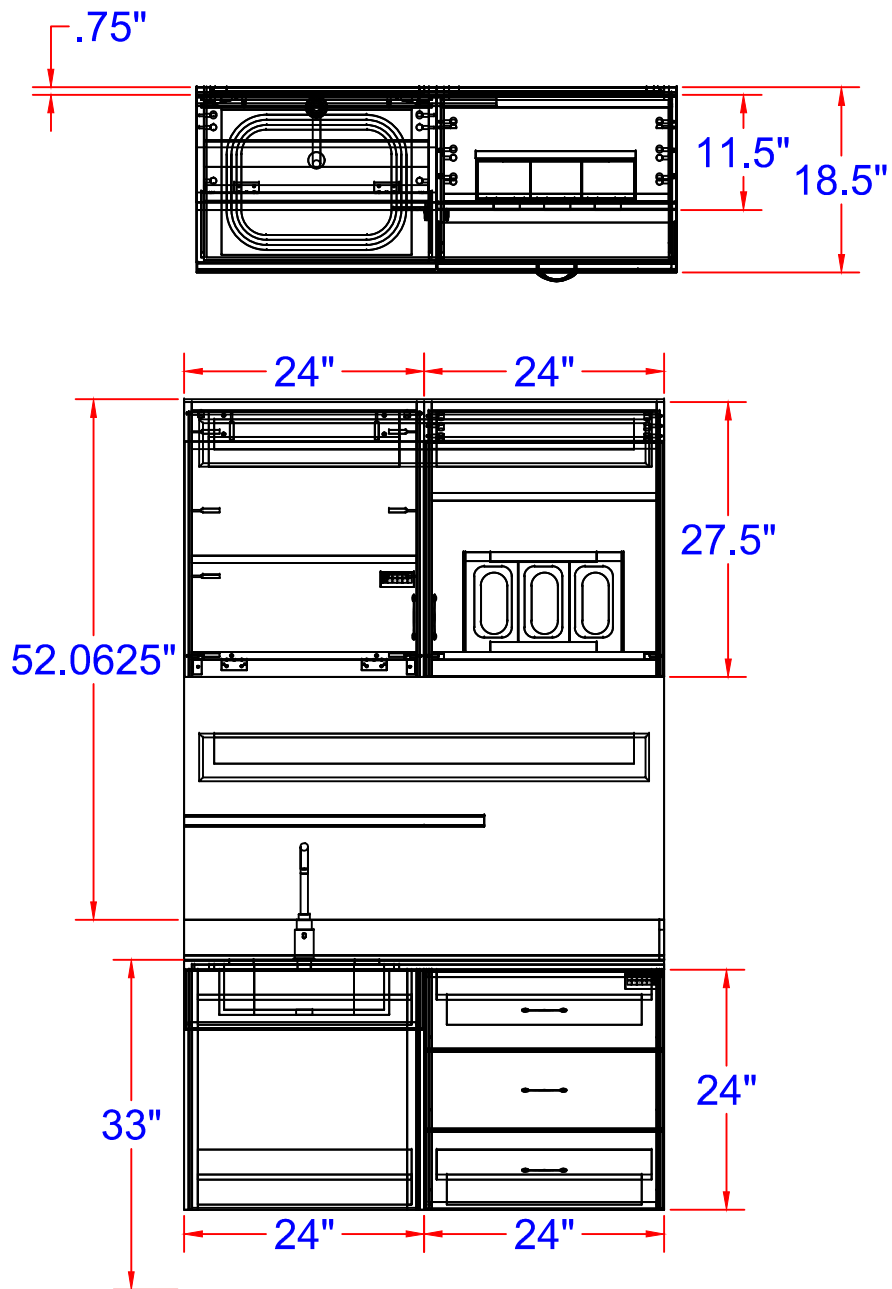

OFS BRANDS

OFS FirstOffice Carolina Loewenstein Highmark

CONCEPT ONLY

Special Req #: 352749

Item #:

Series: MILE MARKER


Tag:

Dwg #: 1540CM

Desc: SIOUX FALLS

Date: 3/16/17

Drawn By: CM

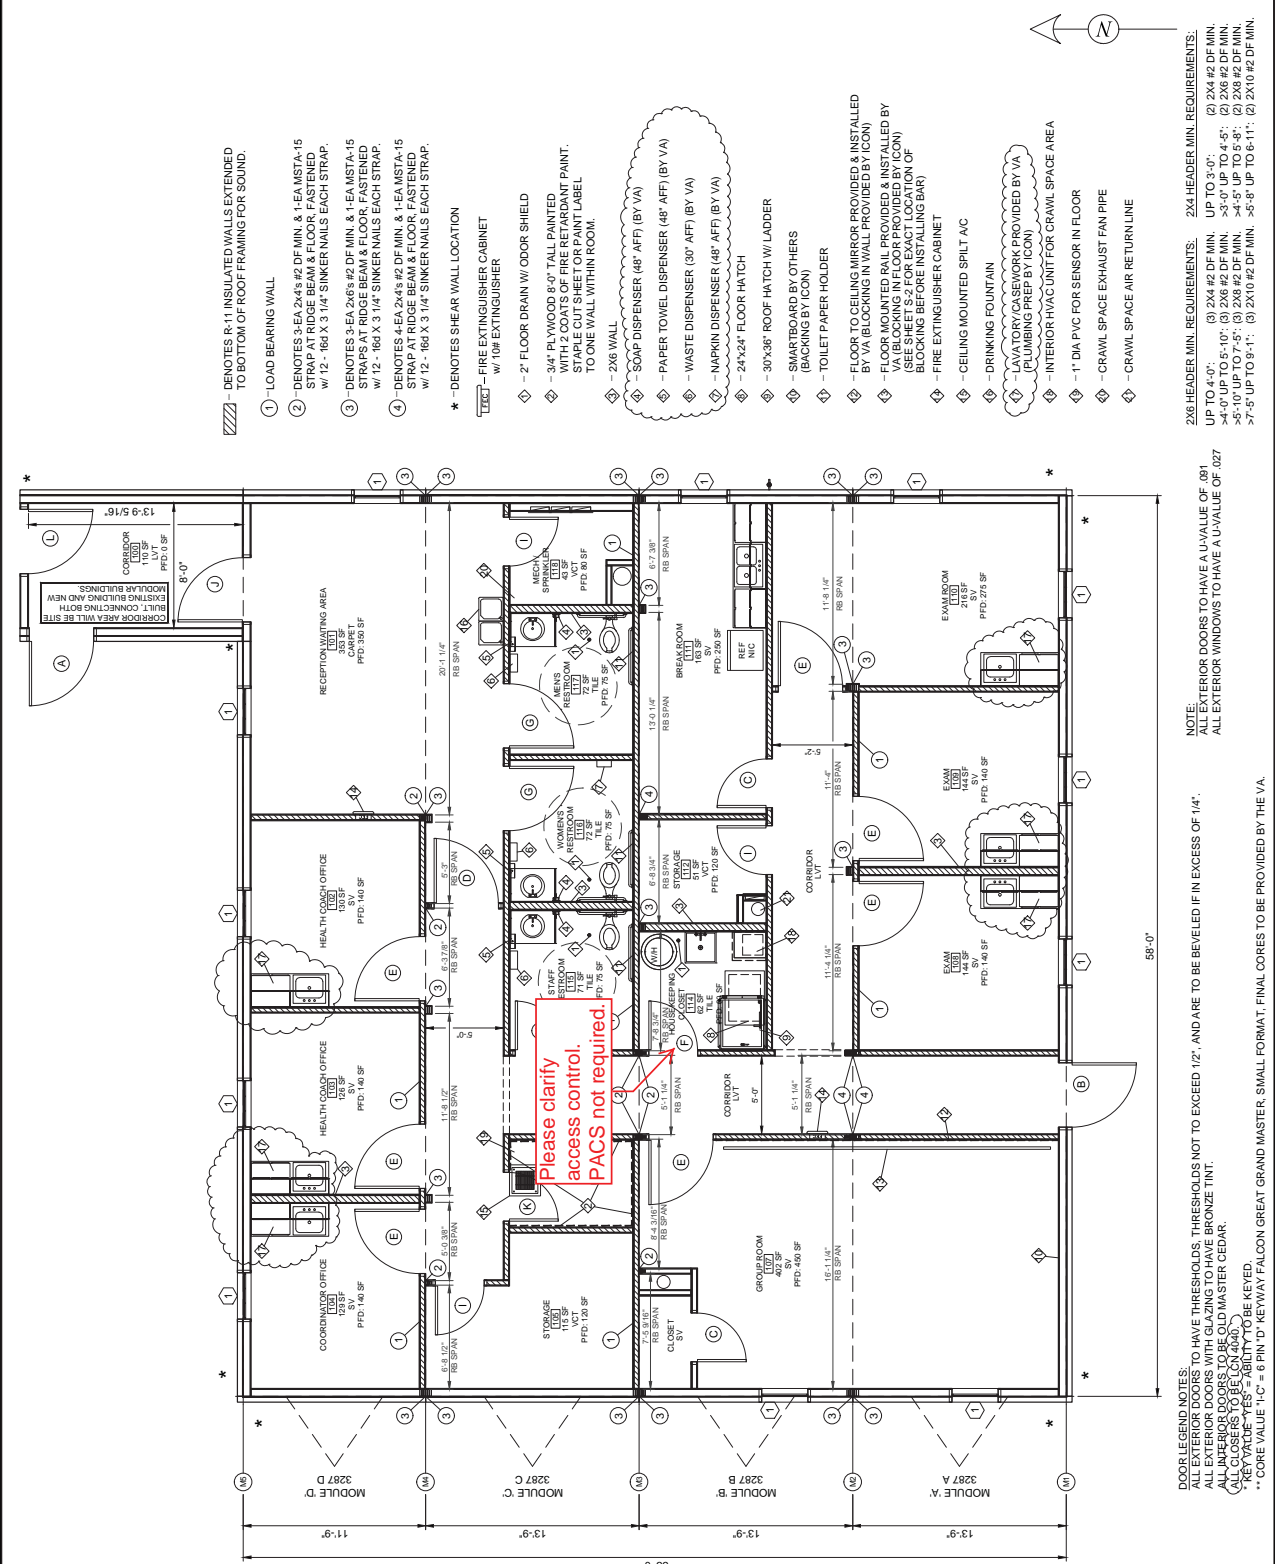

DESIGNATION	QTY	DIMENSIONS - WIDTH X HEIGHT	DOOR & FRAME MATERIAL	GLAZING	FUNCTION	KEY	CORE	NOTES
A	1	4'-0" x 6'-0"	18 GA. STEEL DOOR - 16 GA. K.D. FRAME	PULL - PANIC	2	EXTENSION	YES	WELDED FRAME, AUTO OPENER, ACCESS CONTROL
B	2	3'-0" x 6'-0"	PREF-FINISHED SOLID CORE - K.D. FRAME	NONE	NONE	NONE	NO	
C	1	4'-0" x 6'-0"	PREF-FINISHED SOLID CORE - K.D. FRAME	NONE	LEVER - LEVER	2	PASSAGE	NO
D	1	4'-0" x 6'-0"	PREF-FINISHED SOLID CORE - K.D. FRAME	NONE	ENTRY	YES	NO	
E	2	3'-0" x 6'-0"	PREF-FINISHED SOLID CORE - K.D. FRAME	NONE	STOREROOM	NO	NO	ACCESS CONTROL
F	2	4'-0" x 6'-0"	PREF-FINISHED SOLID CORE - K.D. FRAME	NONE	STOREROOM	NO	NO	CLOSER, KICKPLATE
G	1	3'-0" x 6'-0"	PREF-FINISHED SOLID CORE - K.D. FRAME	NONE	STOREROOM	YES	NO	CLOSER, KICKPLATE
H	1	4'-0" x 6'-0"	PREF-FINISHED SOLID CORE - K.D. FRAME	NONE	STOREROOM	YES	NO	ACCESS CONTROL
I	3	3'-0" x 6'-0"	PREF-FINISHED SOLID CORE - K.D. FRAME	NONE	STOREROOM	YES	NO	CLOSER, KICKPLATE
J	1	4'-0" x 6'-0"	PREF-FINISHED SOLID CORE - K.D. FRAME	NONE	STOREROOM	YES	NO	CLOSER, KICKPLATE
K	1	3'-0" x 6'-0"	18 GA. STEEL DOOR - 16 GA. K.D. FRAME	NONE	STOREROOM	YES	NO	WELDED FRAME, ACCESS CONTROL
L	1	4'-0" x 6'-0"	1 1/2 HOUR RATED DOOR - K.D. FRAME	NONE	ENTRY	YES	NO	CLOSER, ACCESS CONTROL

DESIGNATION	QTY	DIMENSIONS - WIDTH X HEIGHT	FINISH	GLAZING	TYPE	COVERING	NOTES
1	1	2'-11 3/4" x 3'-11 3/4"	BRONZE ALUMINUM THERMAL BREAK FRAME	CLEAR-LOW E	FIXED	2" FAUX WOOD BLINDS	6X6 GRID INSERT - COMMERCIAL GRADE
2	12	3'-0" x 4'-0"					

Auto Operate