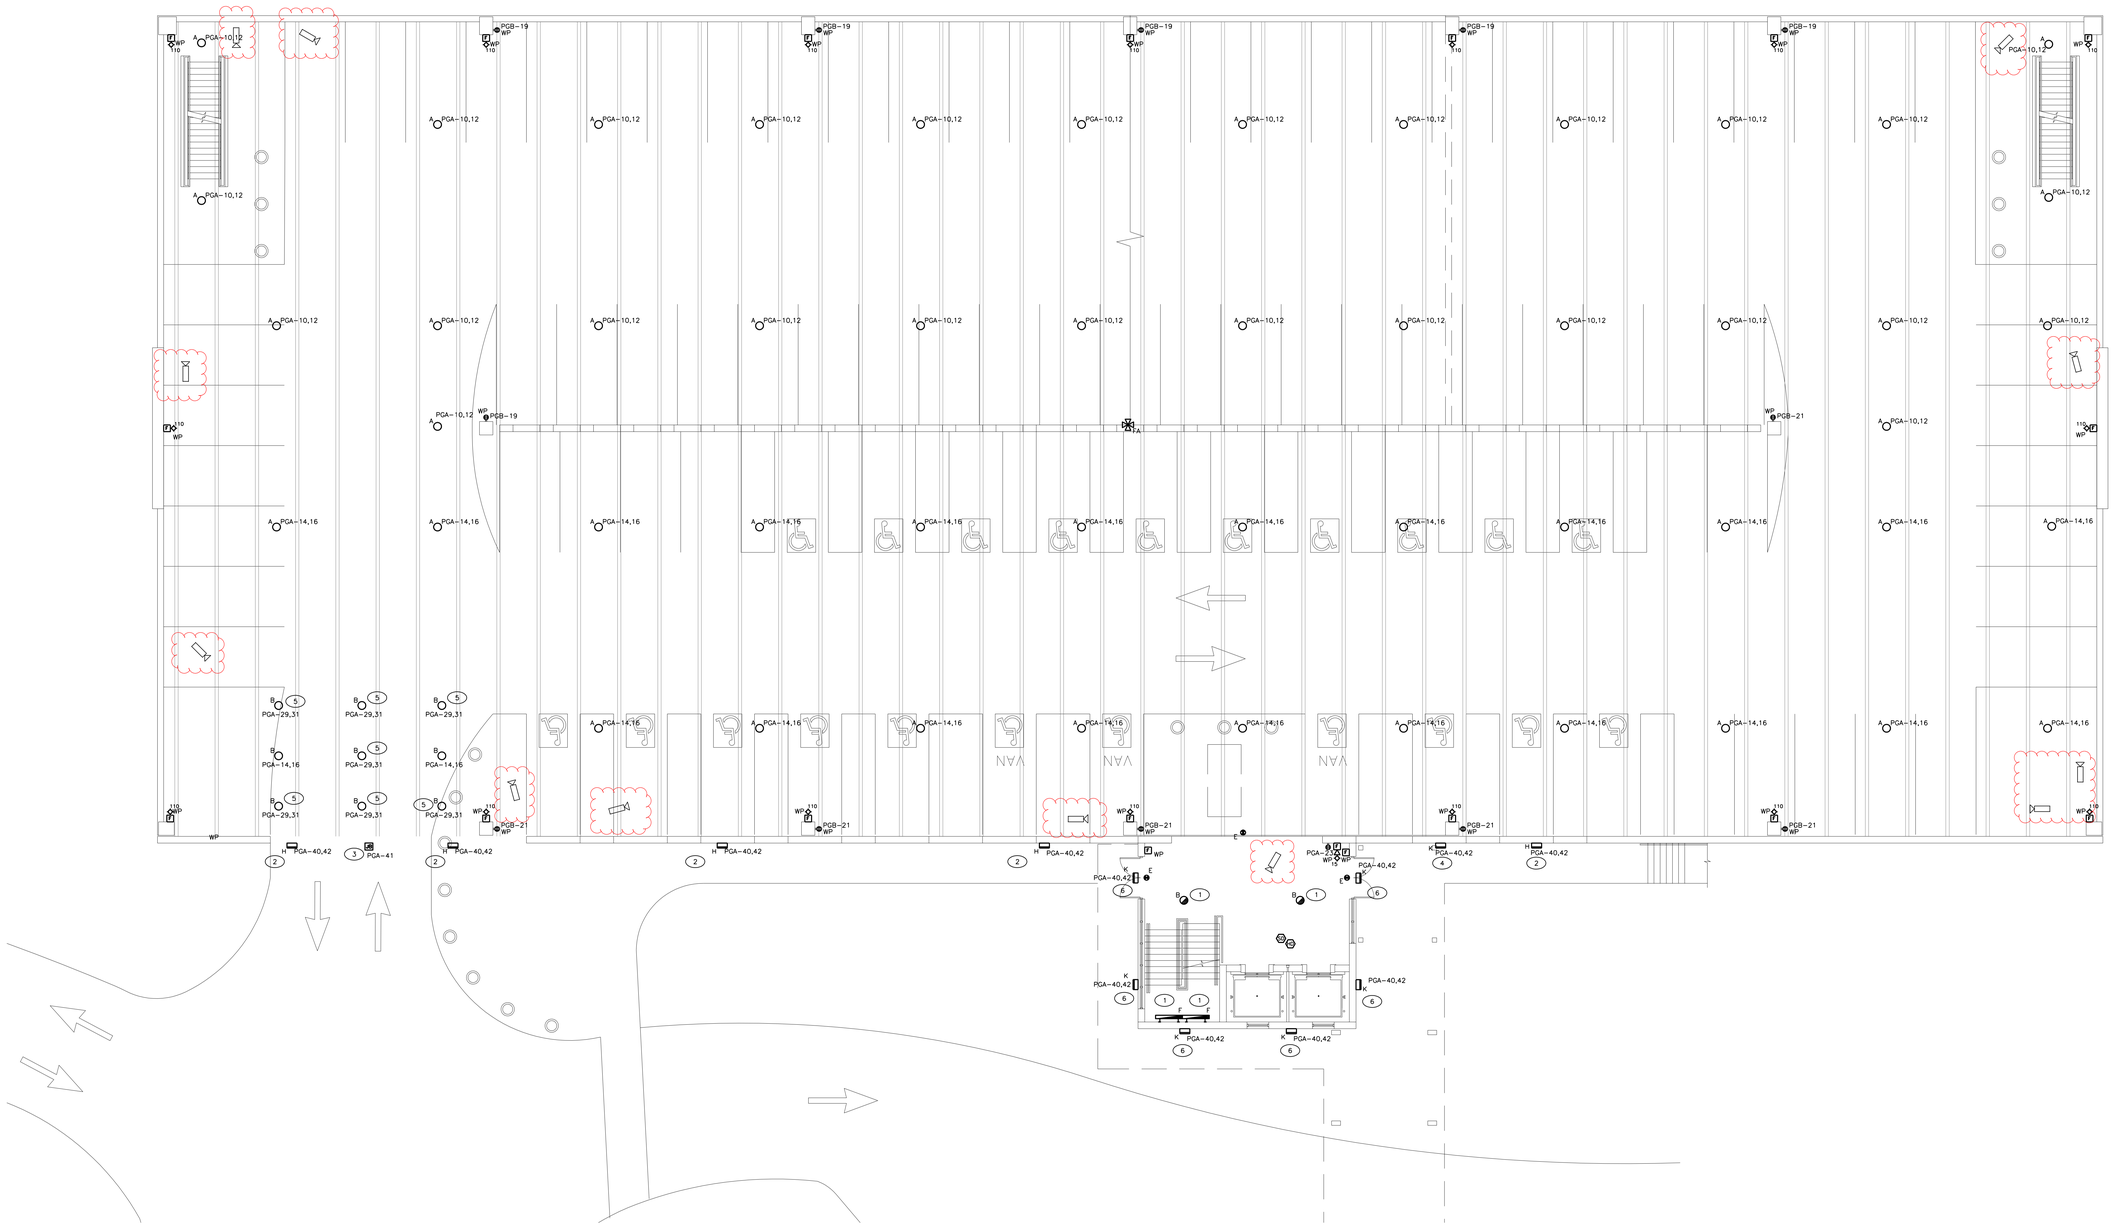

THIRD FLOOR PLAN - ELECTRICAL

1/8"=1'-0"

GENERAL NOTES:

1. CONNECT EXIT SIGNS FIXTURE TYPE E TO UNSWITCHED LEG OF LOCAL LIGHTING CIRCUIT.

NOTES BY SYMBOL: (#)

(THIS SHEET ONLY)

(1) CONNECT FIXTURE TO 20A-2P CIRCUIT BREAKER IN EMERGENCY LIGHTING INVERTER. IF EMERGENCY LIGHTING INVERTER ALTERNATE E1 IS NOT ACCEPTED PROVIDE FIXTURE WITH INTEGRAL EMERGENCY BATTERY BACK UP WITH THE HIGHEST LUMEN OUTPUT AVAILABLE AND CONNECT FIXTURE TO PGA-17,19.

(2) MOUNT LIGHT FIXTURE @ 11'-6" ABOVE FINISHED FLOOR ELEVATION 899'-0" TO CENTERLINE OF FIXTURE. CIRCUIT FIXTURE THROUGH LIGHTING CONTACTOR 'LC1' LOCATED IN MAIN ELECTRIC ROOM.

(3) JUNCTION BOX FOR INTERNALLY ILLUMINATED SIGN. COORDINATE ROUGH-IN AND CONNECTION REQUIREMENTS WITH SIGN INSTALLER. CIRCUIT FIXTURE THROUGH LIGHTING CONTACTOR 'LC1' LOCATED IN MAIN ELECTRIC ROOM.

(4) THIS FIXTURE IS TO BE PROVIDED IN LIEU OF FIXTURE TYPE 'H' ALONG SAME WALL IF CANOPY ALTERNATE IS ACCEPTED. MOUNT FIXTURE ON WALL WITH TOP OF FIXTURE @ 1'3" BELOW UNDERSIDE OF CANOPY. CIRCUIT FIXTURE THROUGH LIGHTING CONTACTOR 'LC1' LOCATED IN MAIN ELECTRIC ROOM.

(5) THIS FIXTURE IS TO BE WIRED THROUGH LIGHTING CONTACTOR LC2 CONTROLLED BY TIME CLOCK TC2. TIME CLOCK IS TO BE SET SO THIS FIXTURE IS ON DURING DAYLIGHT HOURS.

(6) MOUNT FIXTURE ON WALL WITH TOP OF FIXTURE @ 1'3" BELOW UNDERSIDE OF CANOPY. CIRCUIT FIXTURE THROUGH LIGHTING CONTACTOR 'LC1' LOCATED IN MAIN ELECTRIC ROOM.

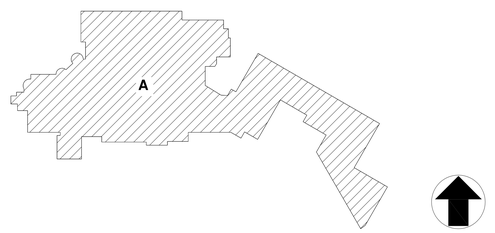

BARRY ISETT & ASSOCIATES, INC.
Multidiscipline Engineers & Consultants

Allentown, PA 610.398.0904
Phoenixville, PA 610.935.2175
Forty Fort, PA 570.285.8200
Hazleton, PA 570.455.2999
Phillipsburg, NJ 908.454.9500

www.barryisett.com

REVISIONS	DATE

DRAWING TITLE: THIRD FLOOR PLAN – ELECTRICAL

FACILITY PROJECT NAME: WILKES-BARRE V.A. MEDICAL CENTER

PROJECT TITLE: WB VAMC PARKING GARAGE

BUILDING NUMBER: PARKING GARAGE | CHECKED: KLP | DRAWN: KLP

LOCATION: 1111 EAST END BLVD. WILKES BARRE, PA

DATE: 3/10/2017

PROJECT NO.: 693-222

DRAWING NO. DRAWING: E-104

DWG. 6 OF 8

Veterans Affairs