

NO.	NAME	NO.	NAME

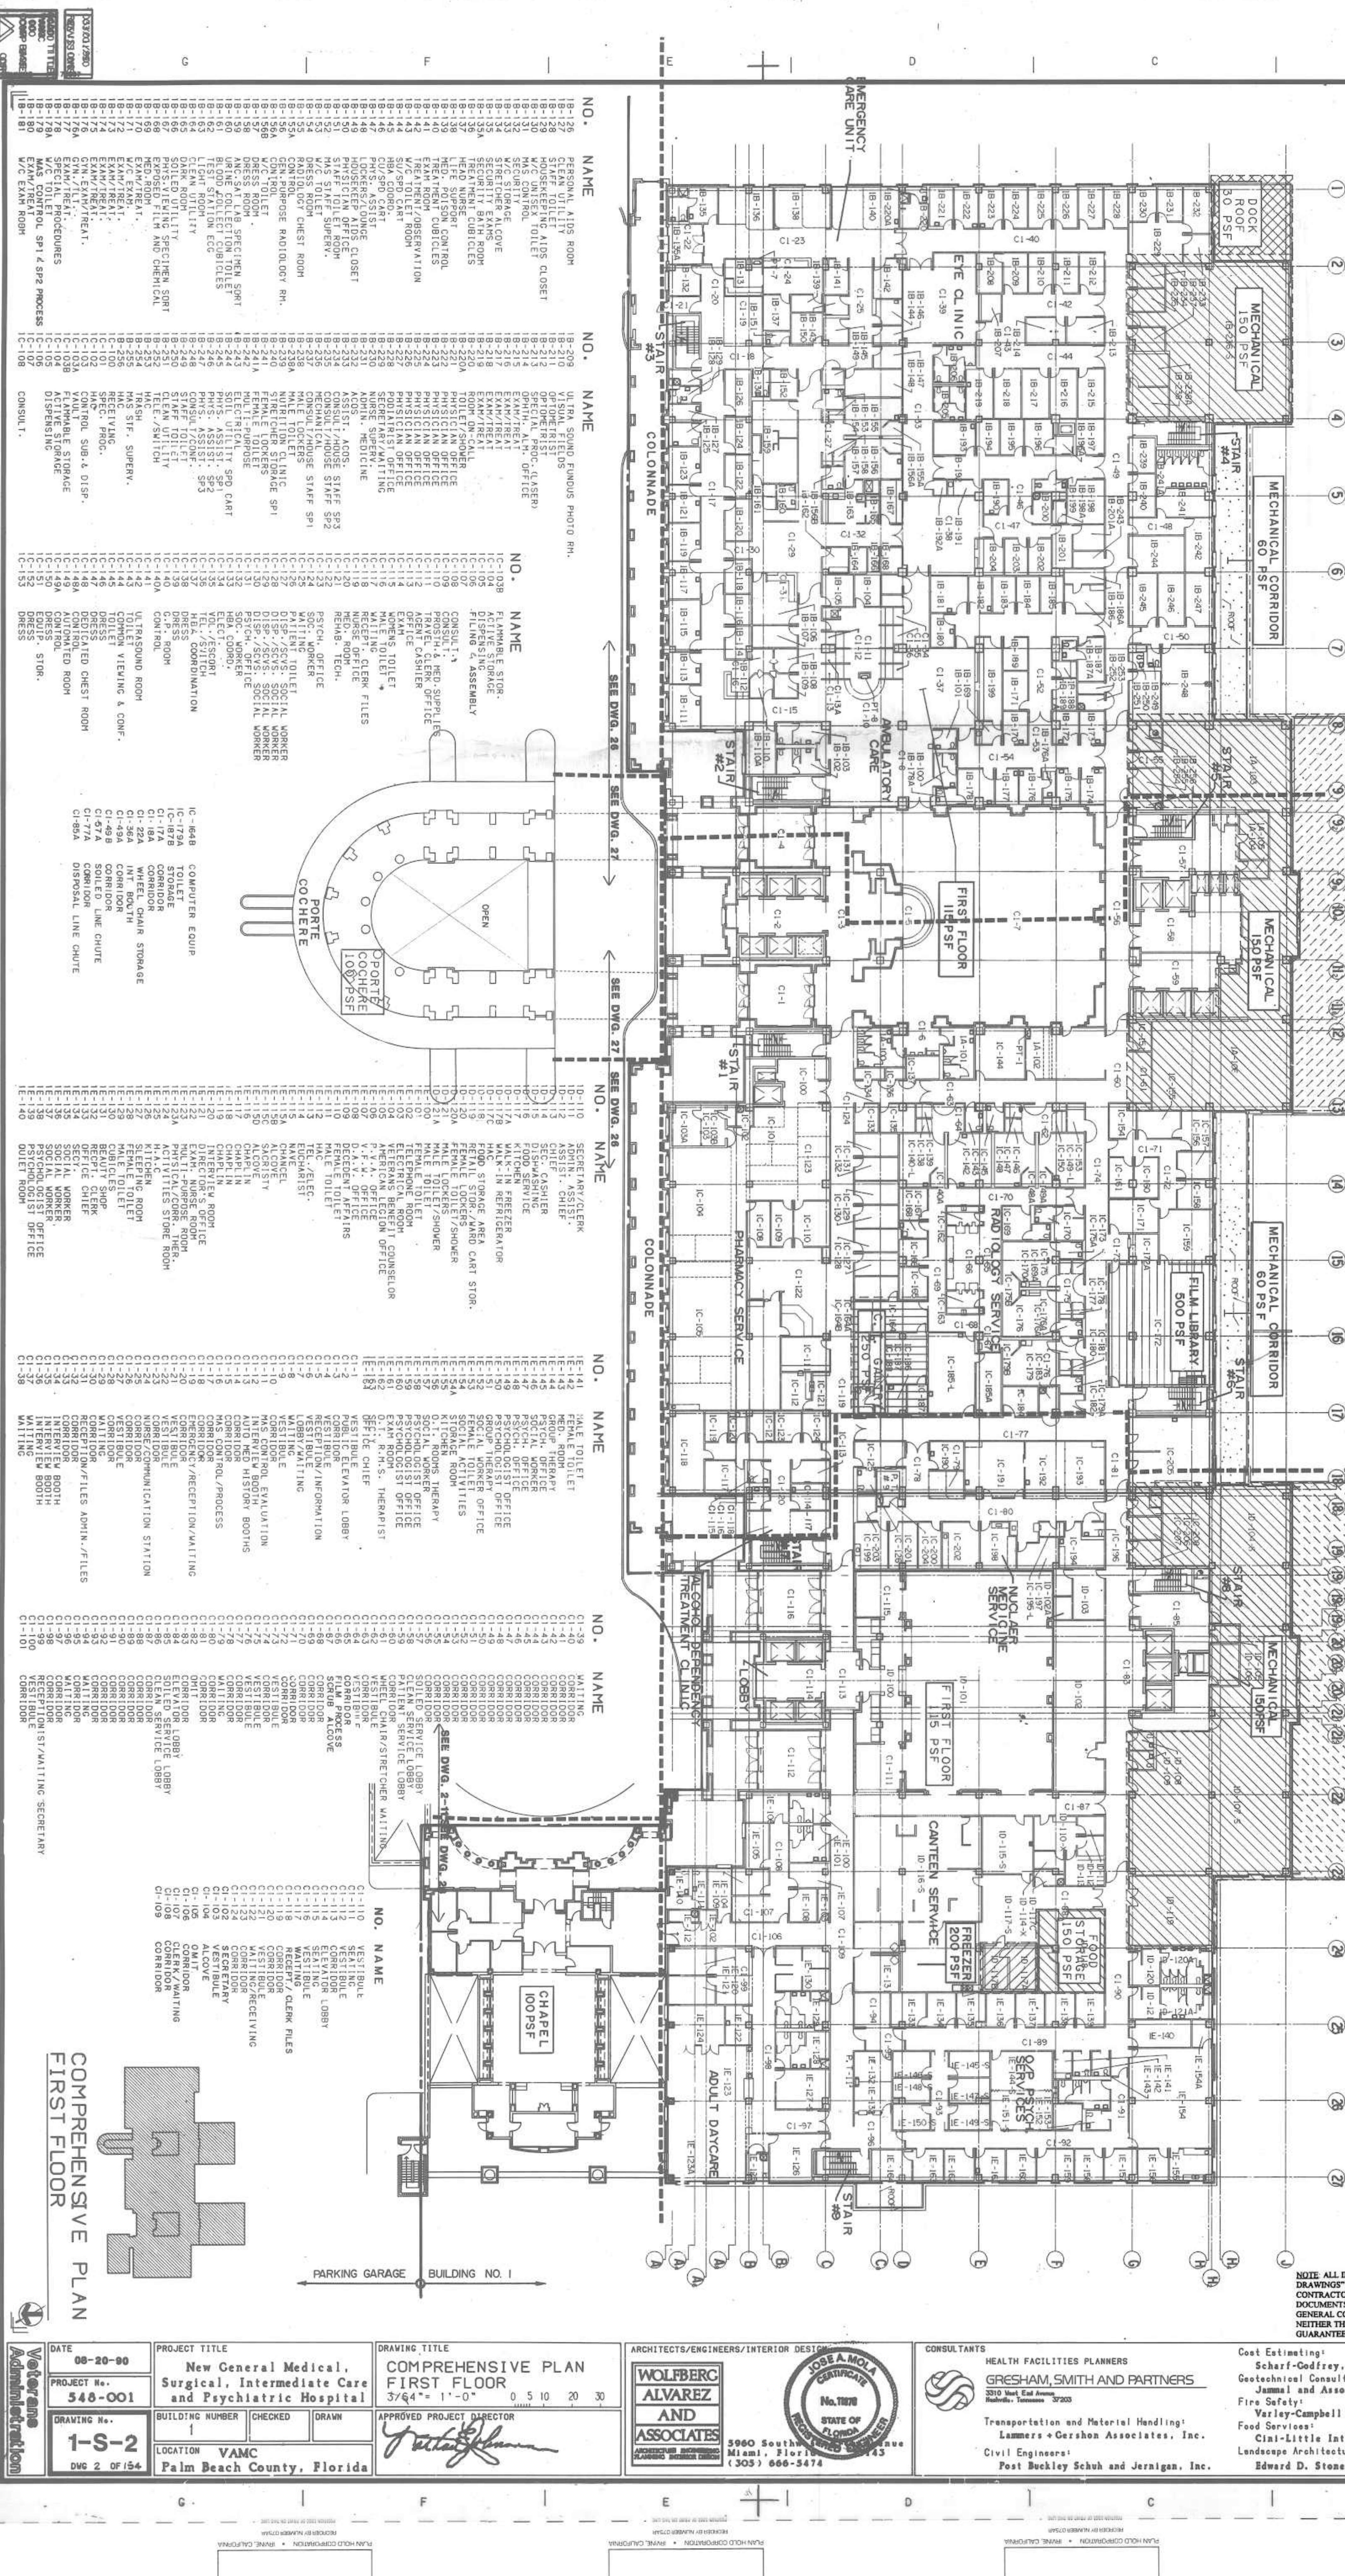

DATE: 08-20-90

PROJECT NO.: 548-001

DRAWING NO.: 1-S-2

DWG 2 OF 154

PROJECT TITLE: New General Medical, Surgical, Intermediate Care and Psychiatric Hospital

BUILDING NUMBER: 1

CHECKED: []

DRAWN: []

LOCATION: VAMC Palm Beach County, Florida

DRAWING NUMBER: []

DRAWING NUMBER: []

DRAWING NUMBER: []

ARCHITECTS/ENGINEERS/INTERIOR DESIGN: WOLBERG ALVAREZ AND ASSOCIATES

JOSE A. MOLA

STATE OF FLORIDA

REGISTERED ARCHITECT

No. 1078

5960 Southpointe Blvd., Suite 100, Miami, Florida 33156 (305) 666-5474

CONSULTANTS: HEALTH FACILITIES PLANNERS: GRESHAM, SMITH AND PARTNERS

TRANSPORTATION AND MATERIAL HANDLING: LAMMERS & GERSHON ASSOCIATES, INC.

CIVIL ENGINEERS: POST BUCKLEY SCHUH AND JERNIGAN, INC.

COST ESTIMATING: Schaff-Godfrey, Inc.

GEOTECHNICAL CONSULTANTS: Jammal and Associates, Inc.

FIRE SAFETY: Varley-Campbell and Associates, Inc.

FOOD SERVICES: Cini-Little International

LANDSCAPE ARCHITECTURE: Edward D. Stone, Jr. and Associates

RECORD DRAWINGS

REVISIONS

DATE: 5/14/97