




three inches = one foot
one and one half inches = one foot
one inch = one foot
three quarters inch = one foot
one half inch = one foot
three eighths inch = one foot
one quarter inch = one foot
one eighth inch = one foot
one sixteenth inch = one foot

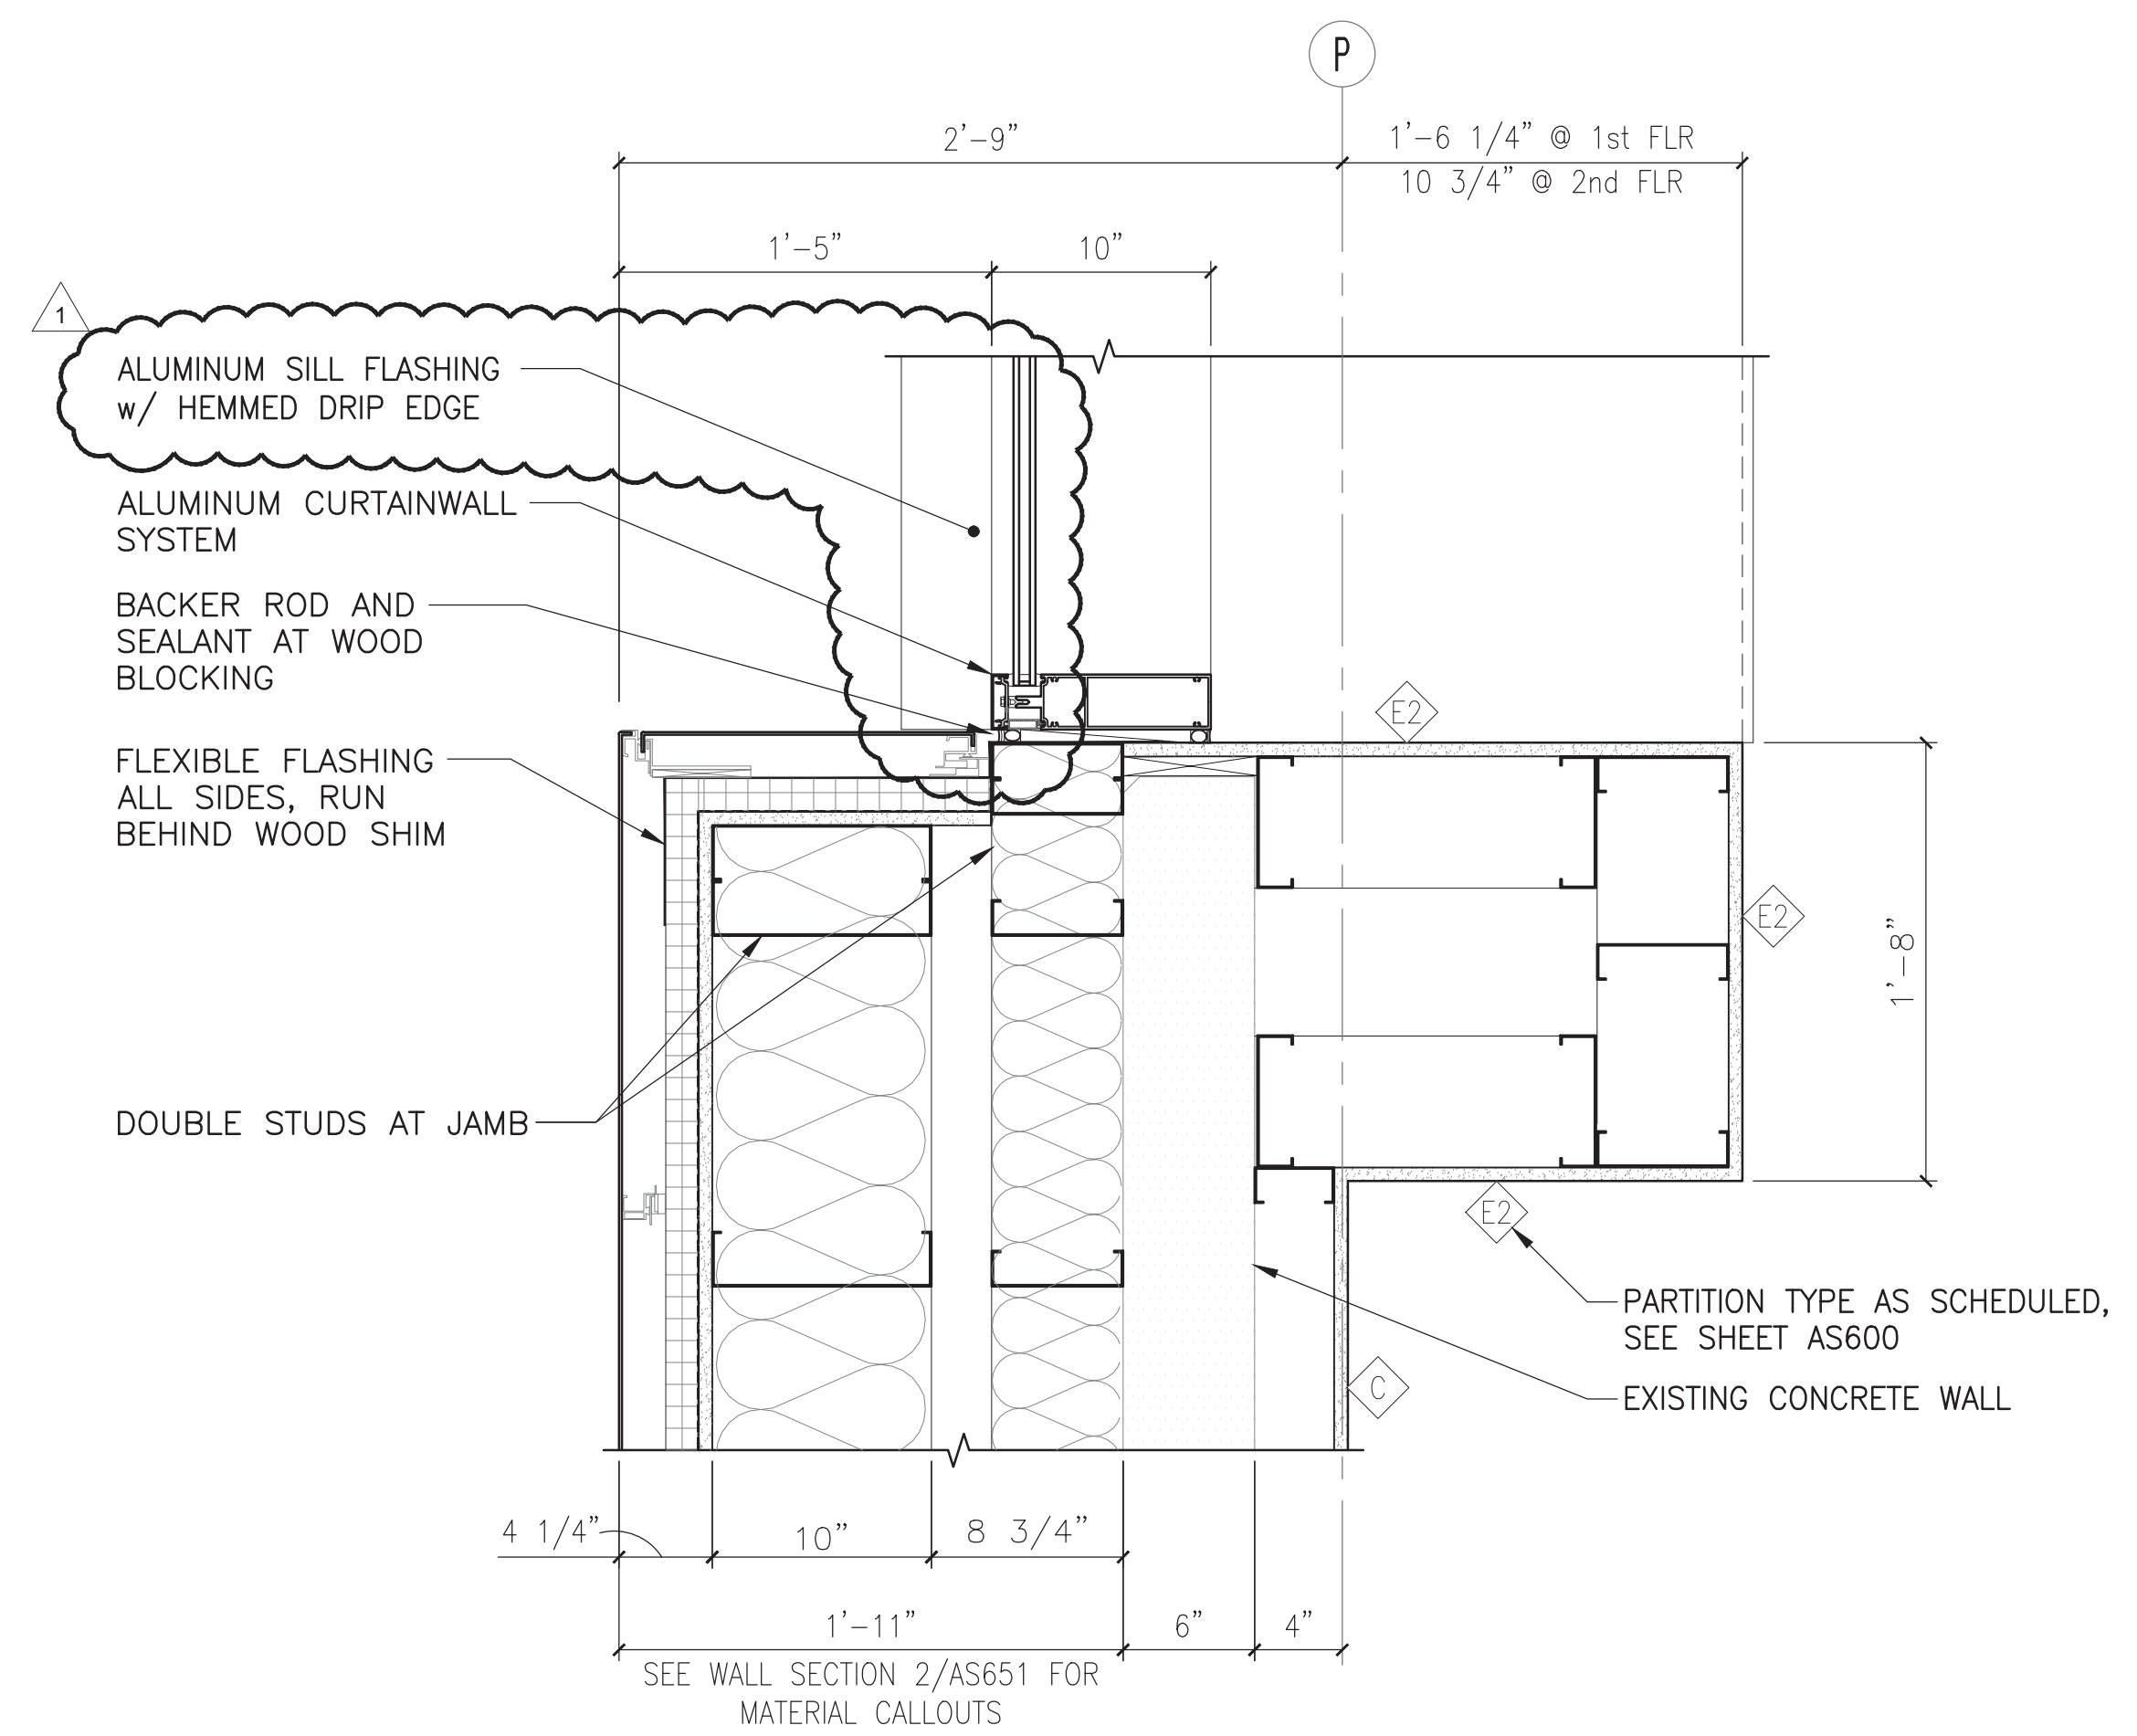


5 CURTAINWALL - PLAN DETAIL
1 1/2" = 1'-0"

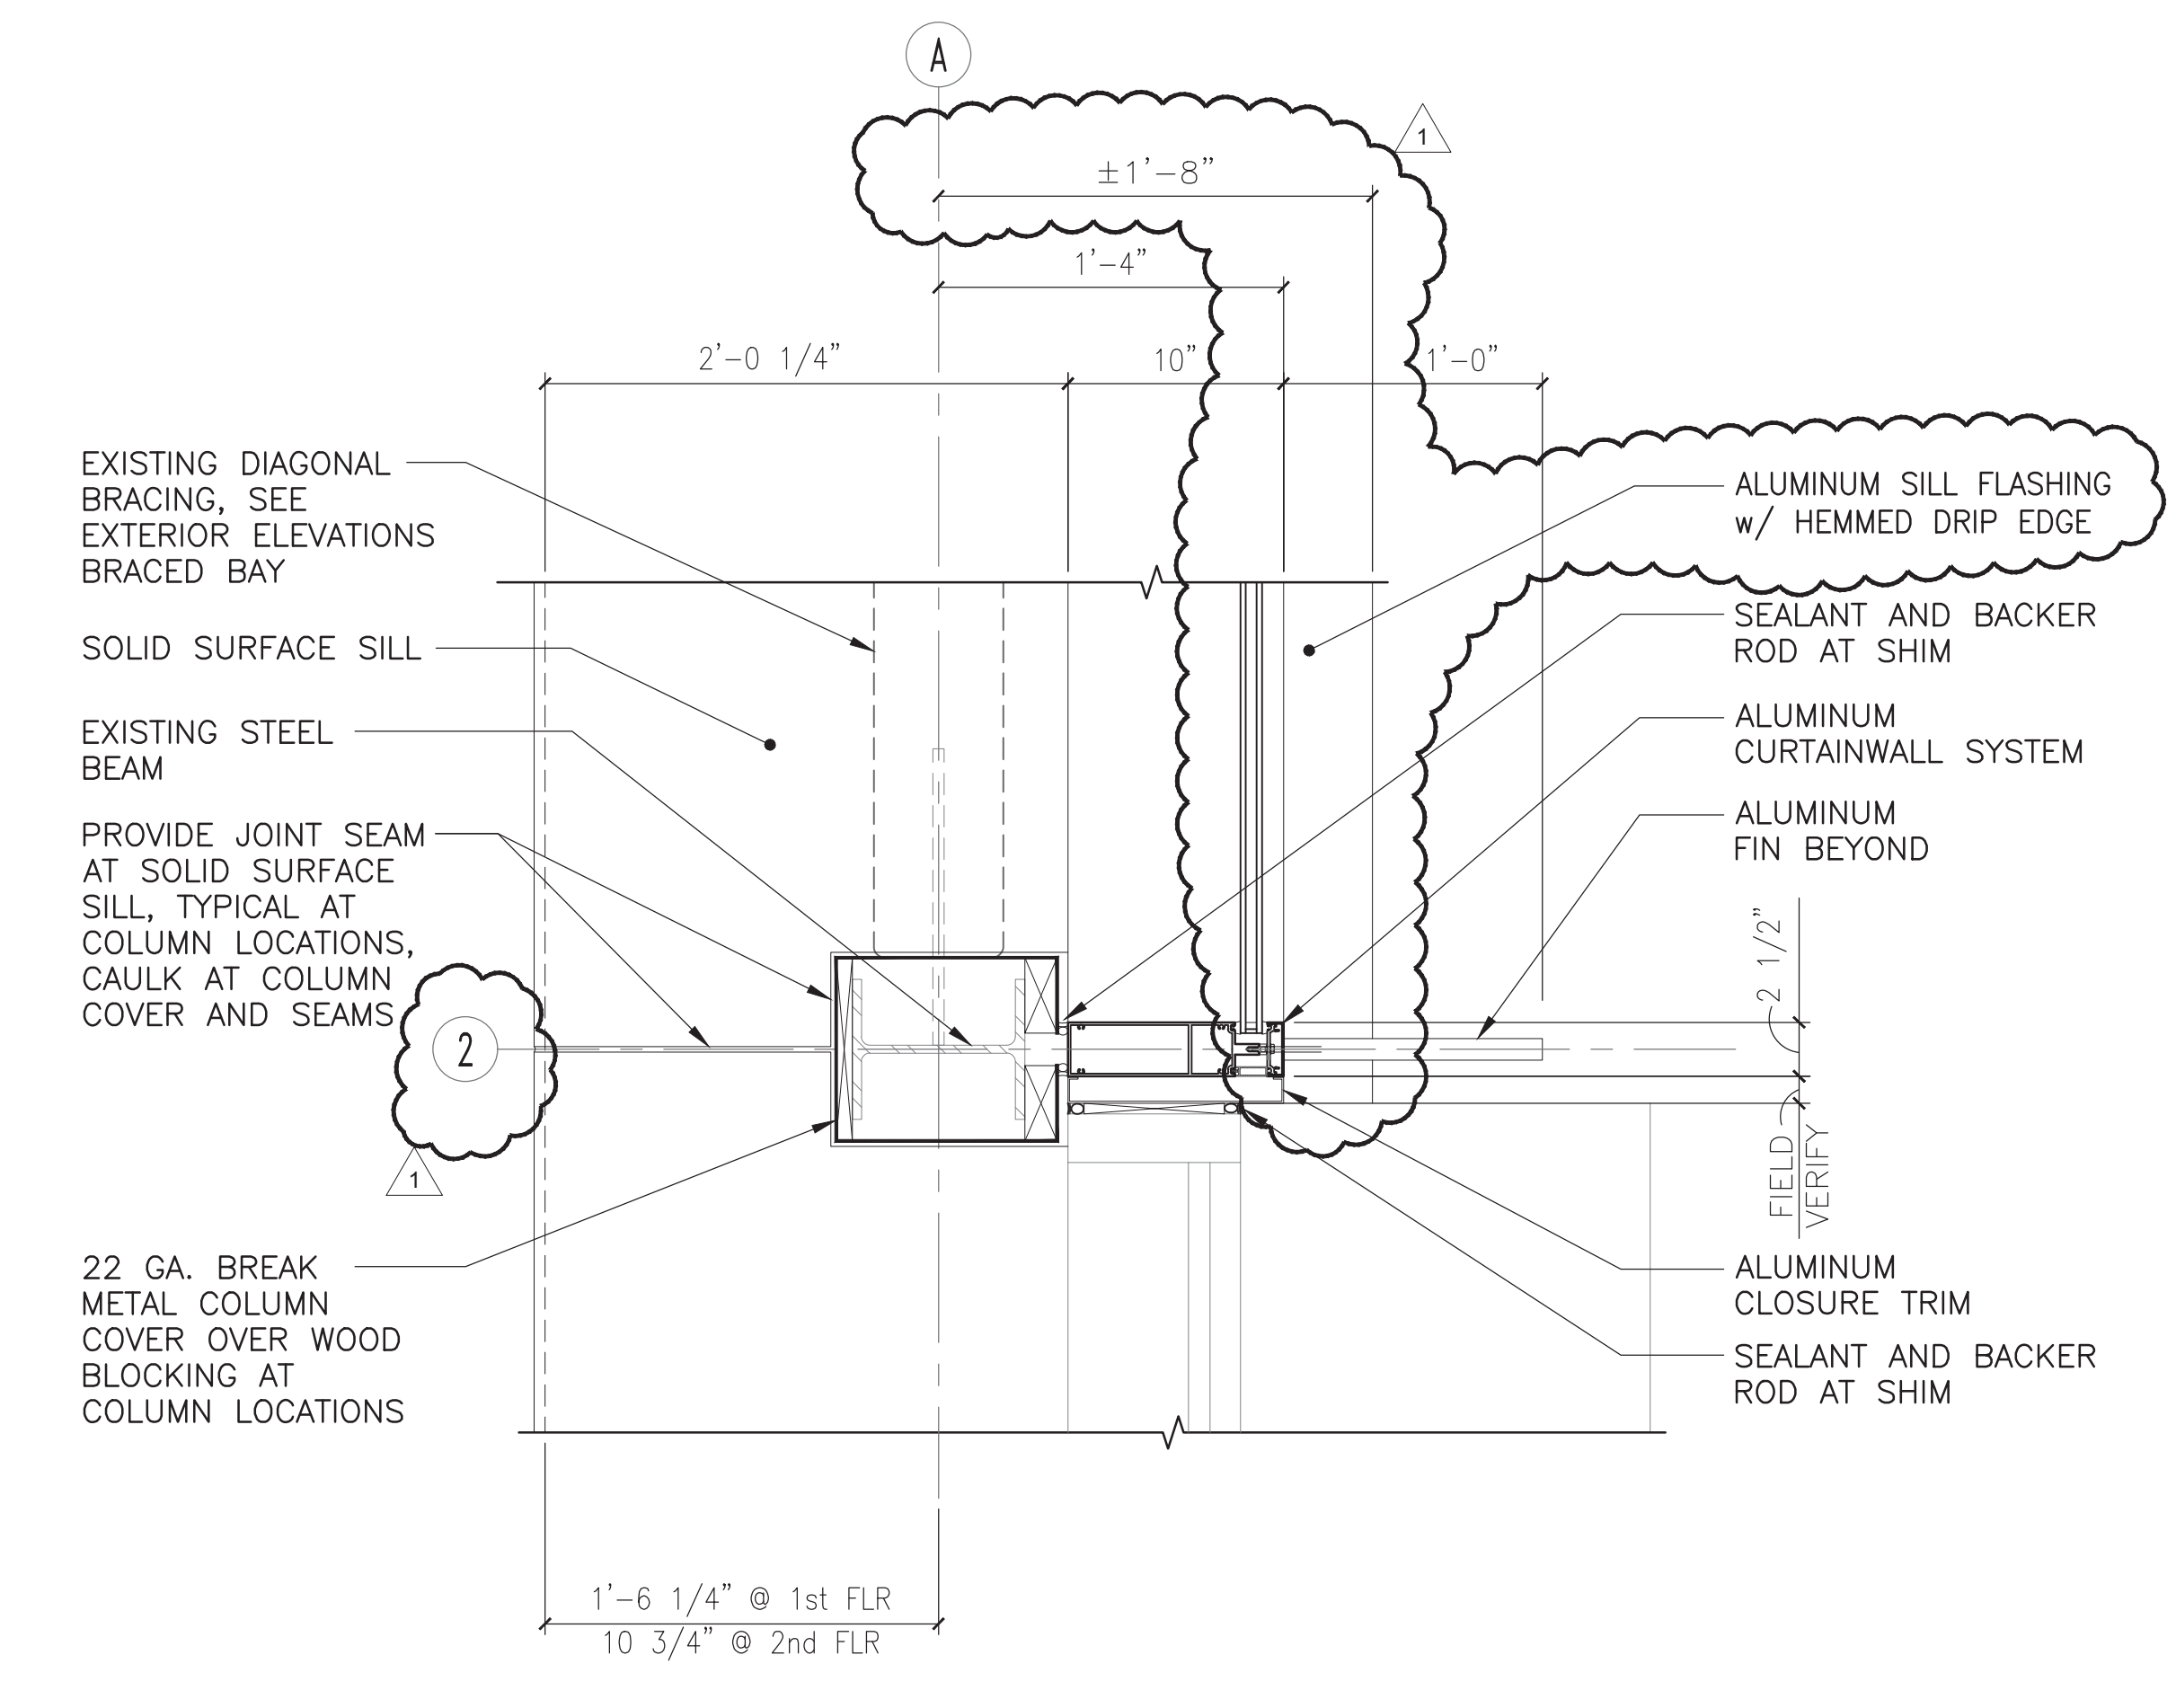


3 CURTAINWALL - PLAN DETAIL
1 1/2" = 1'-0"

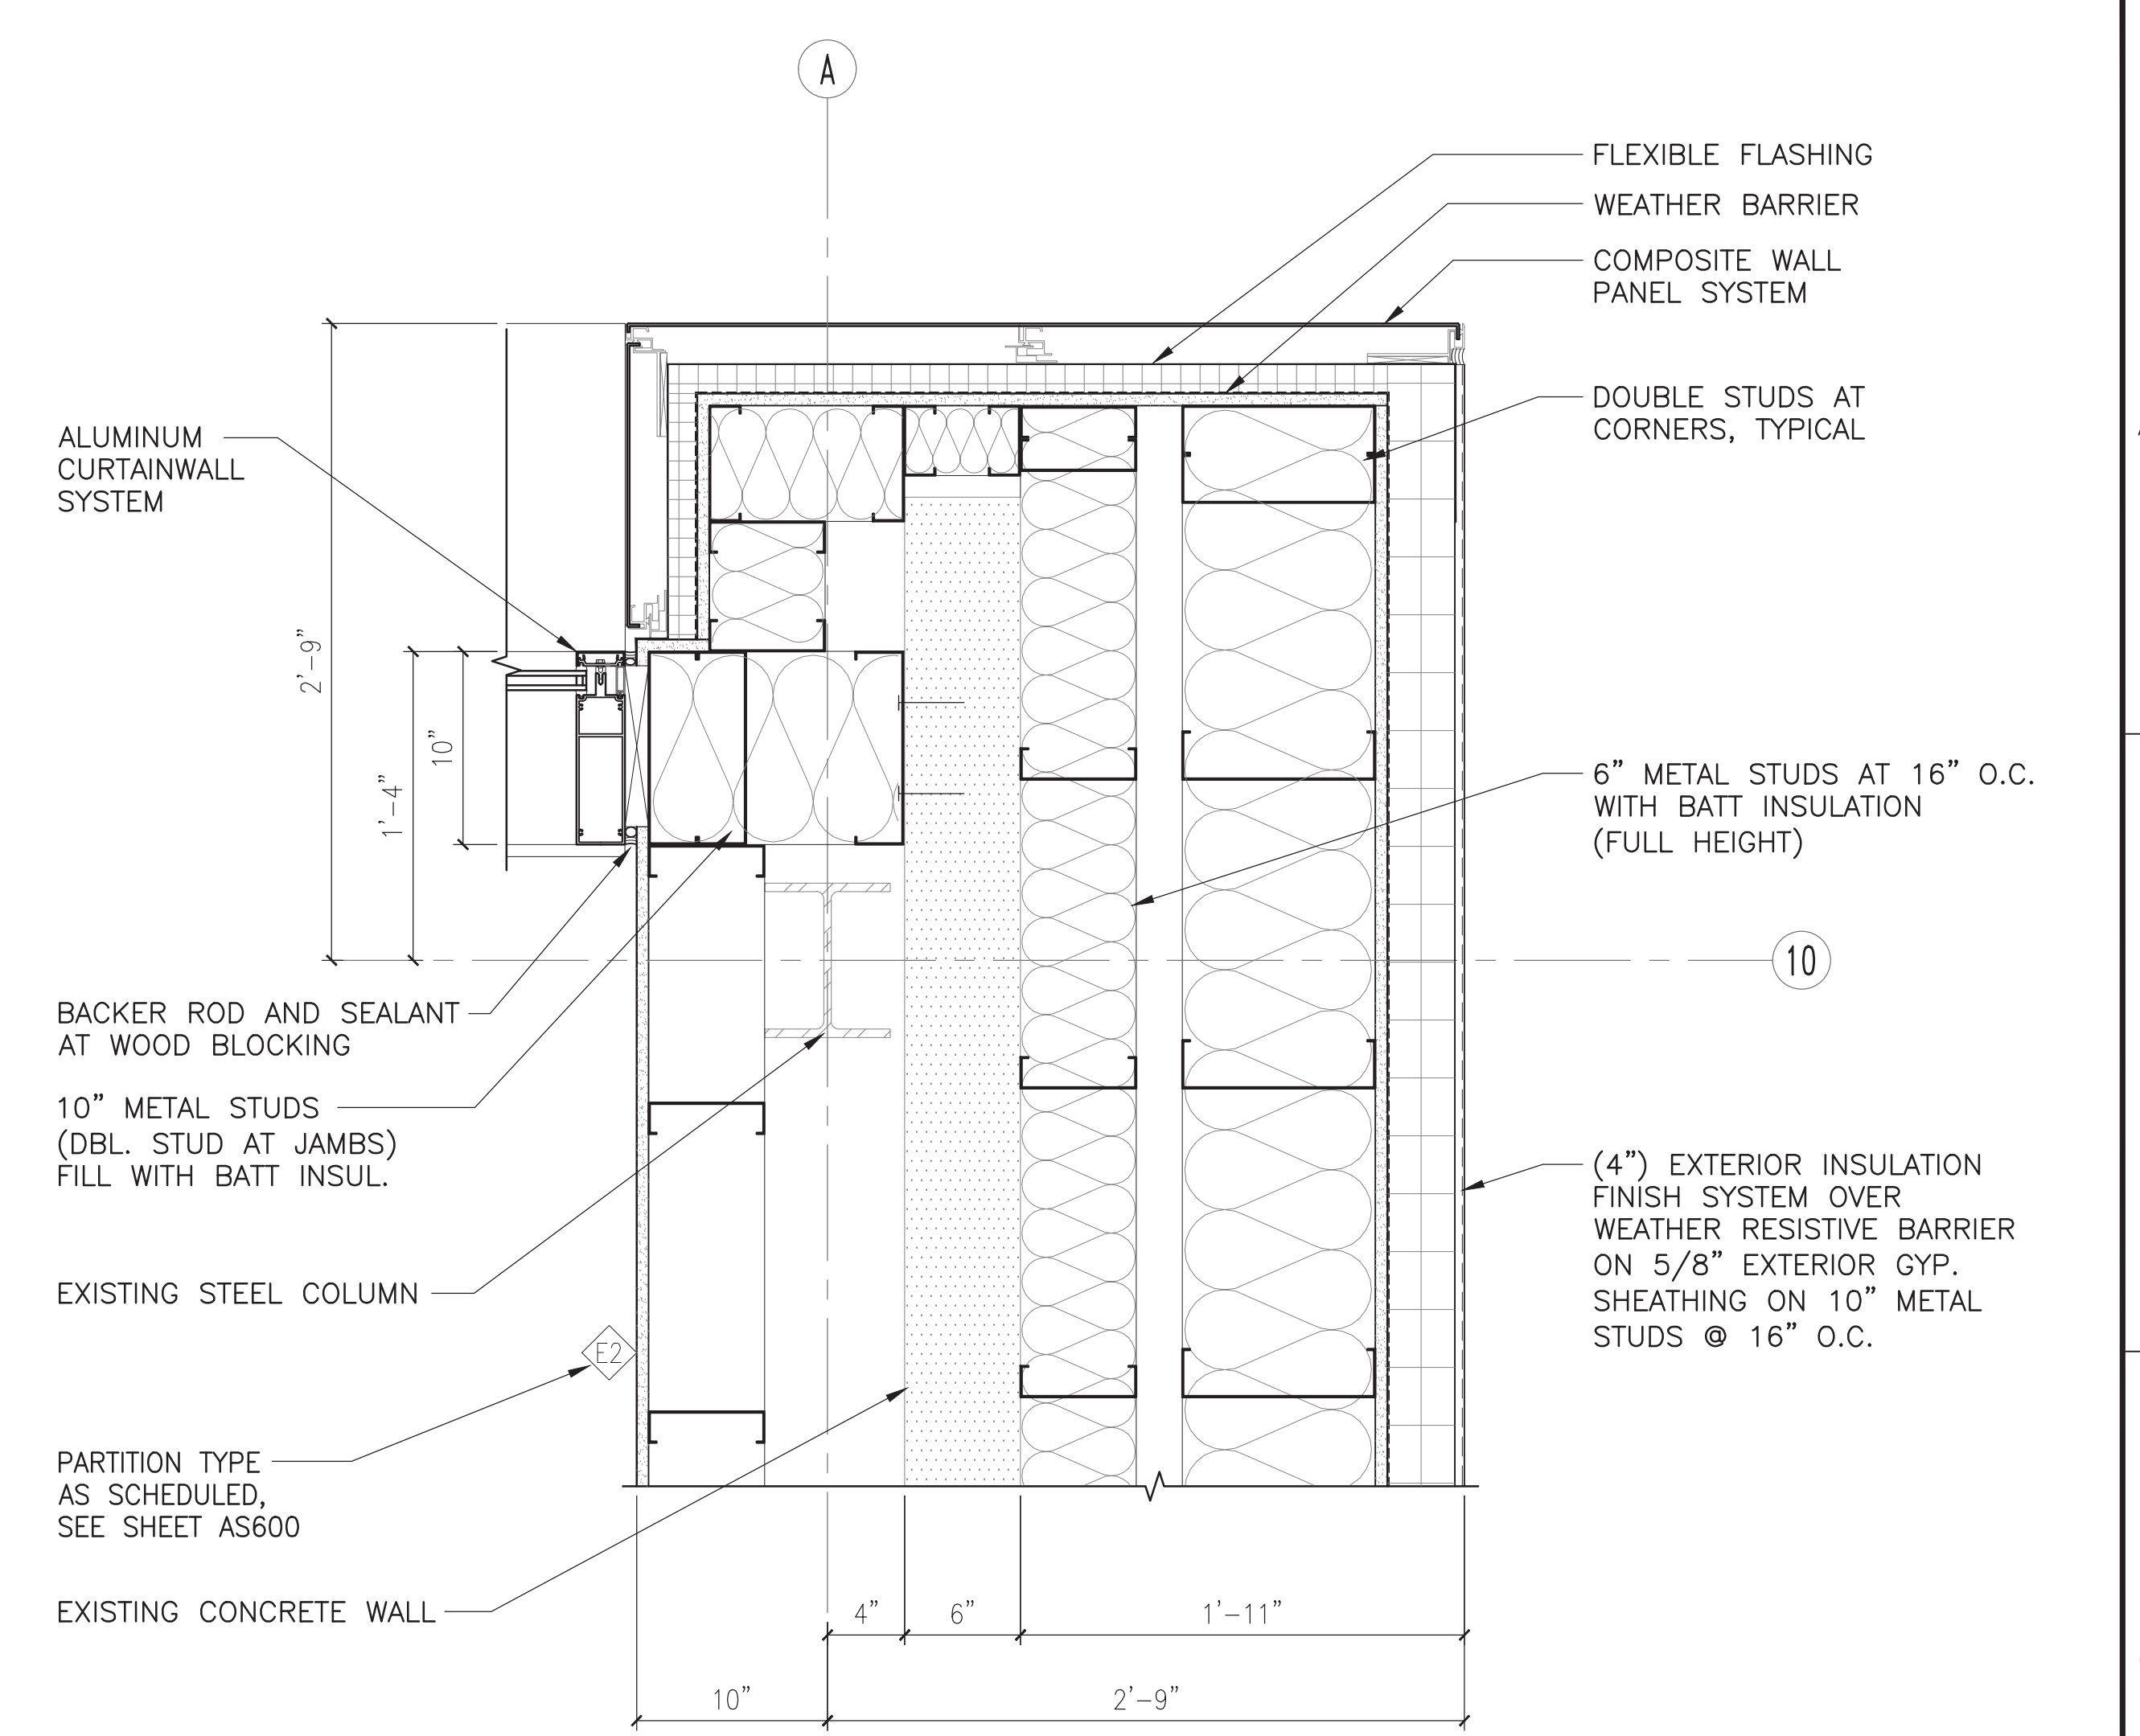


1 CURTAINWALL - PLAN DETAIL
1 1/2" = 1'-0"

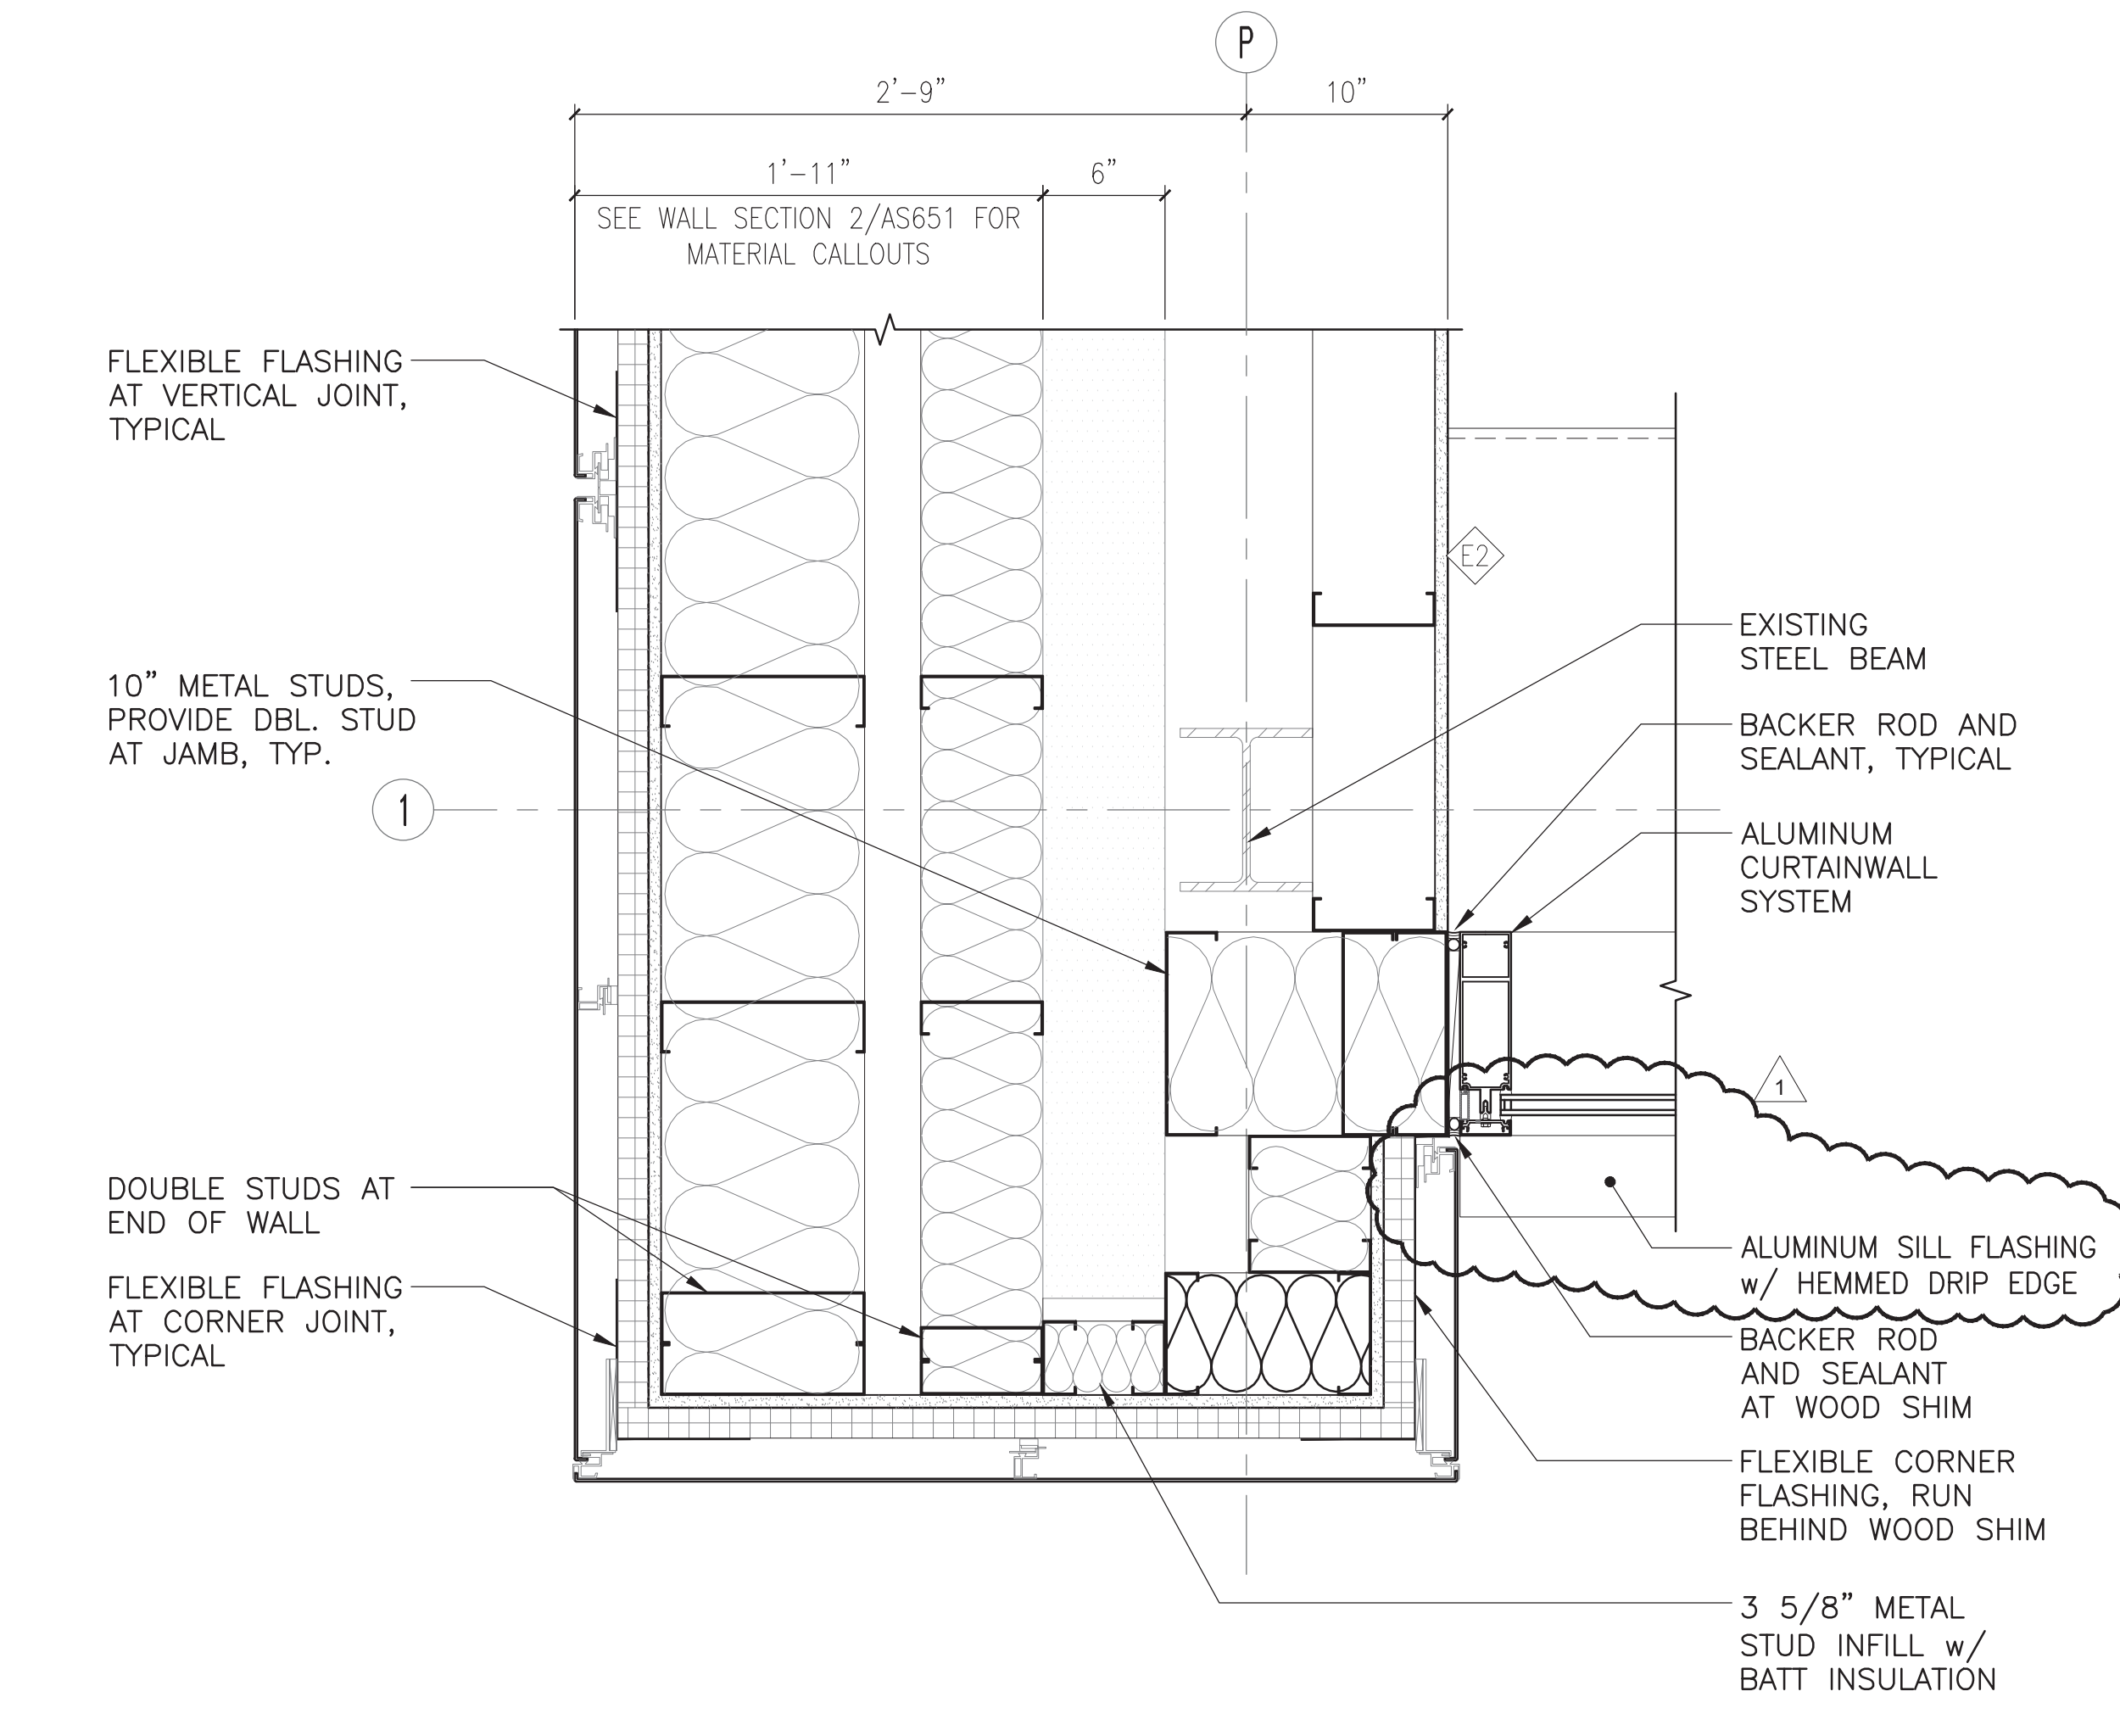

6 CURTAINWALL - PLAN DETAIL
1 1/2" = 1'-0"

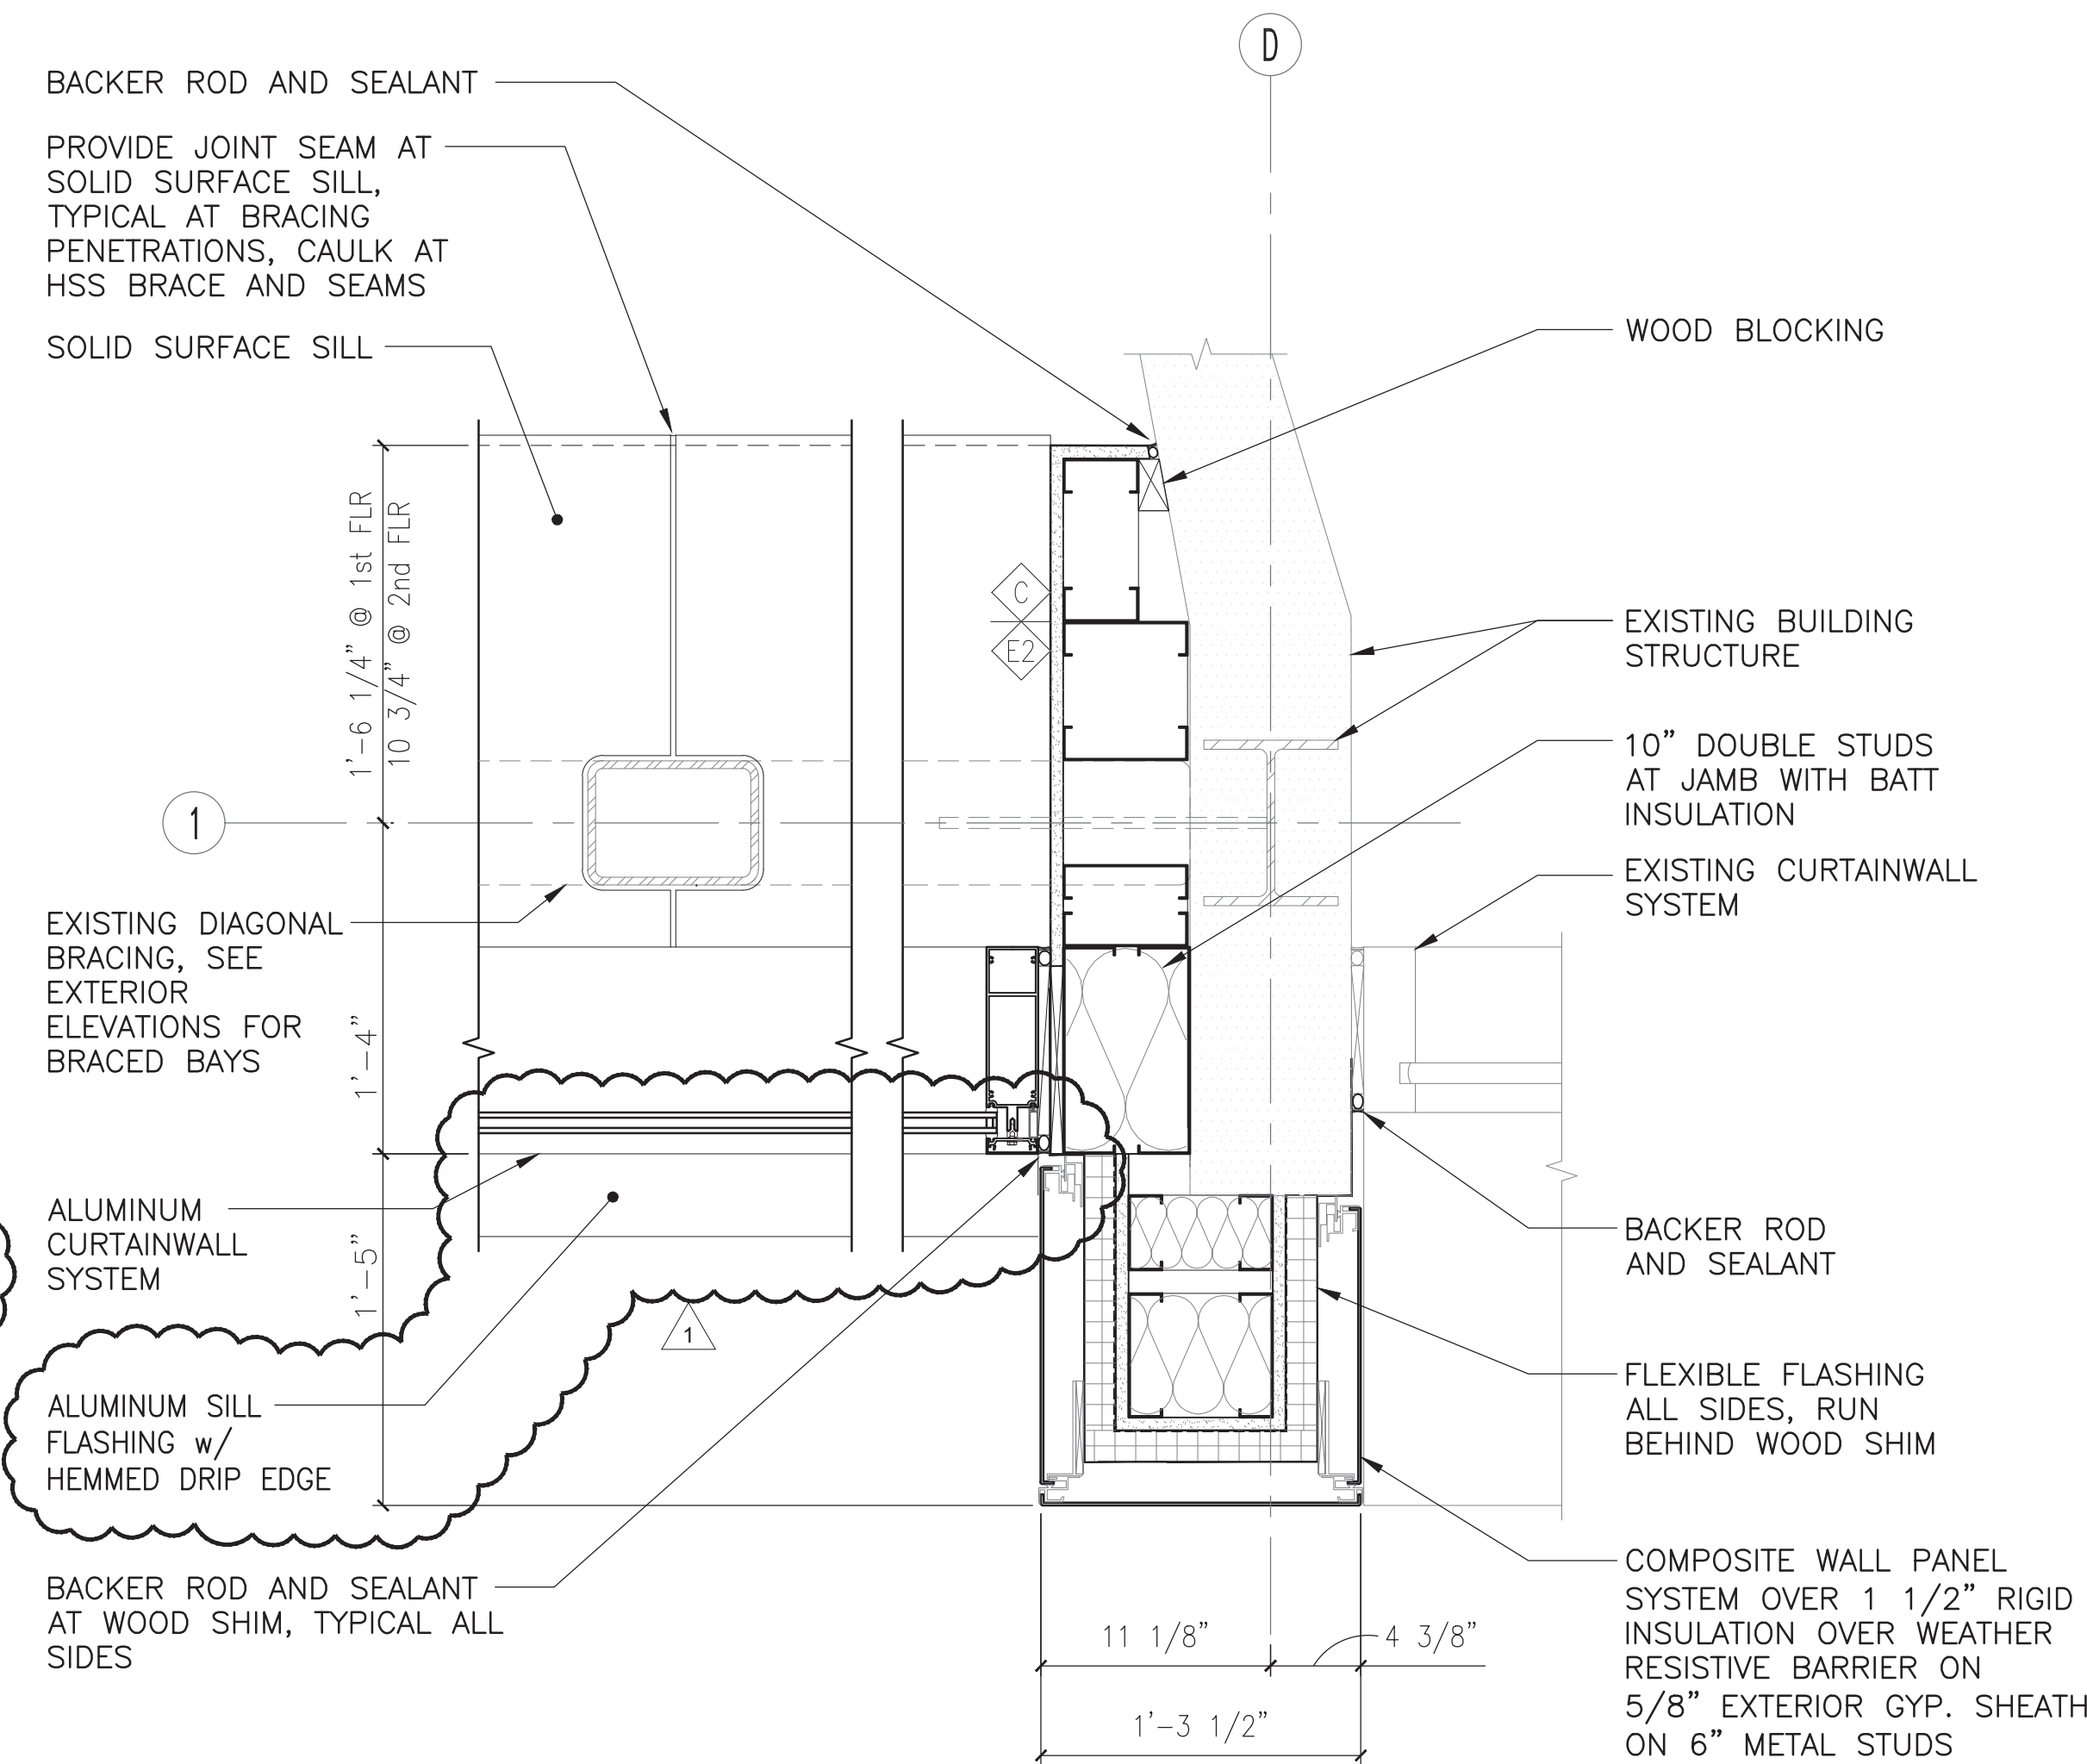


4 CURTAINWALL - PLAN DETAIL
1 1/2" = 1'-0"

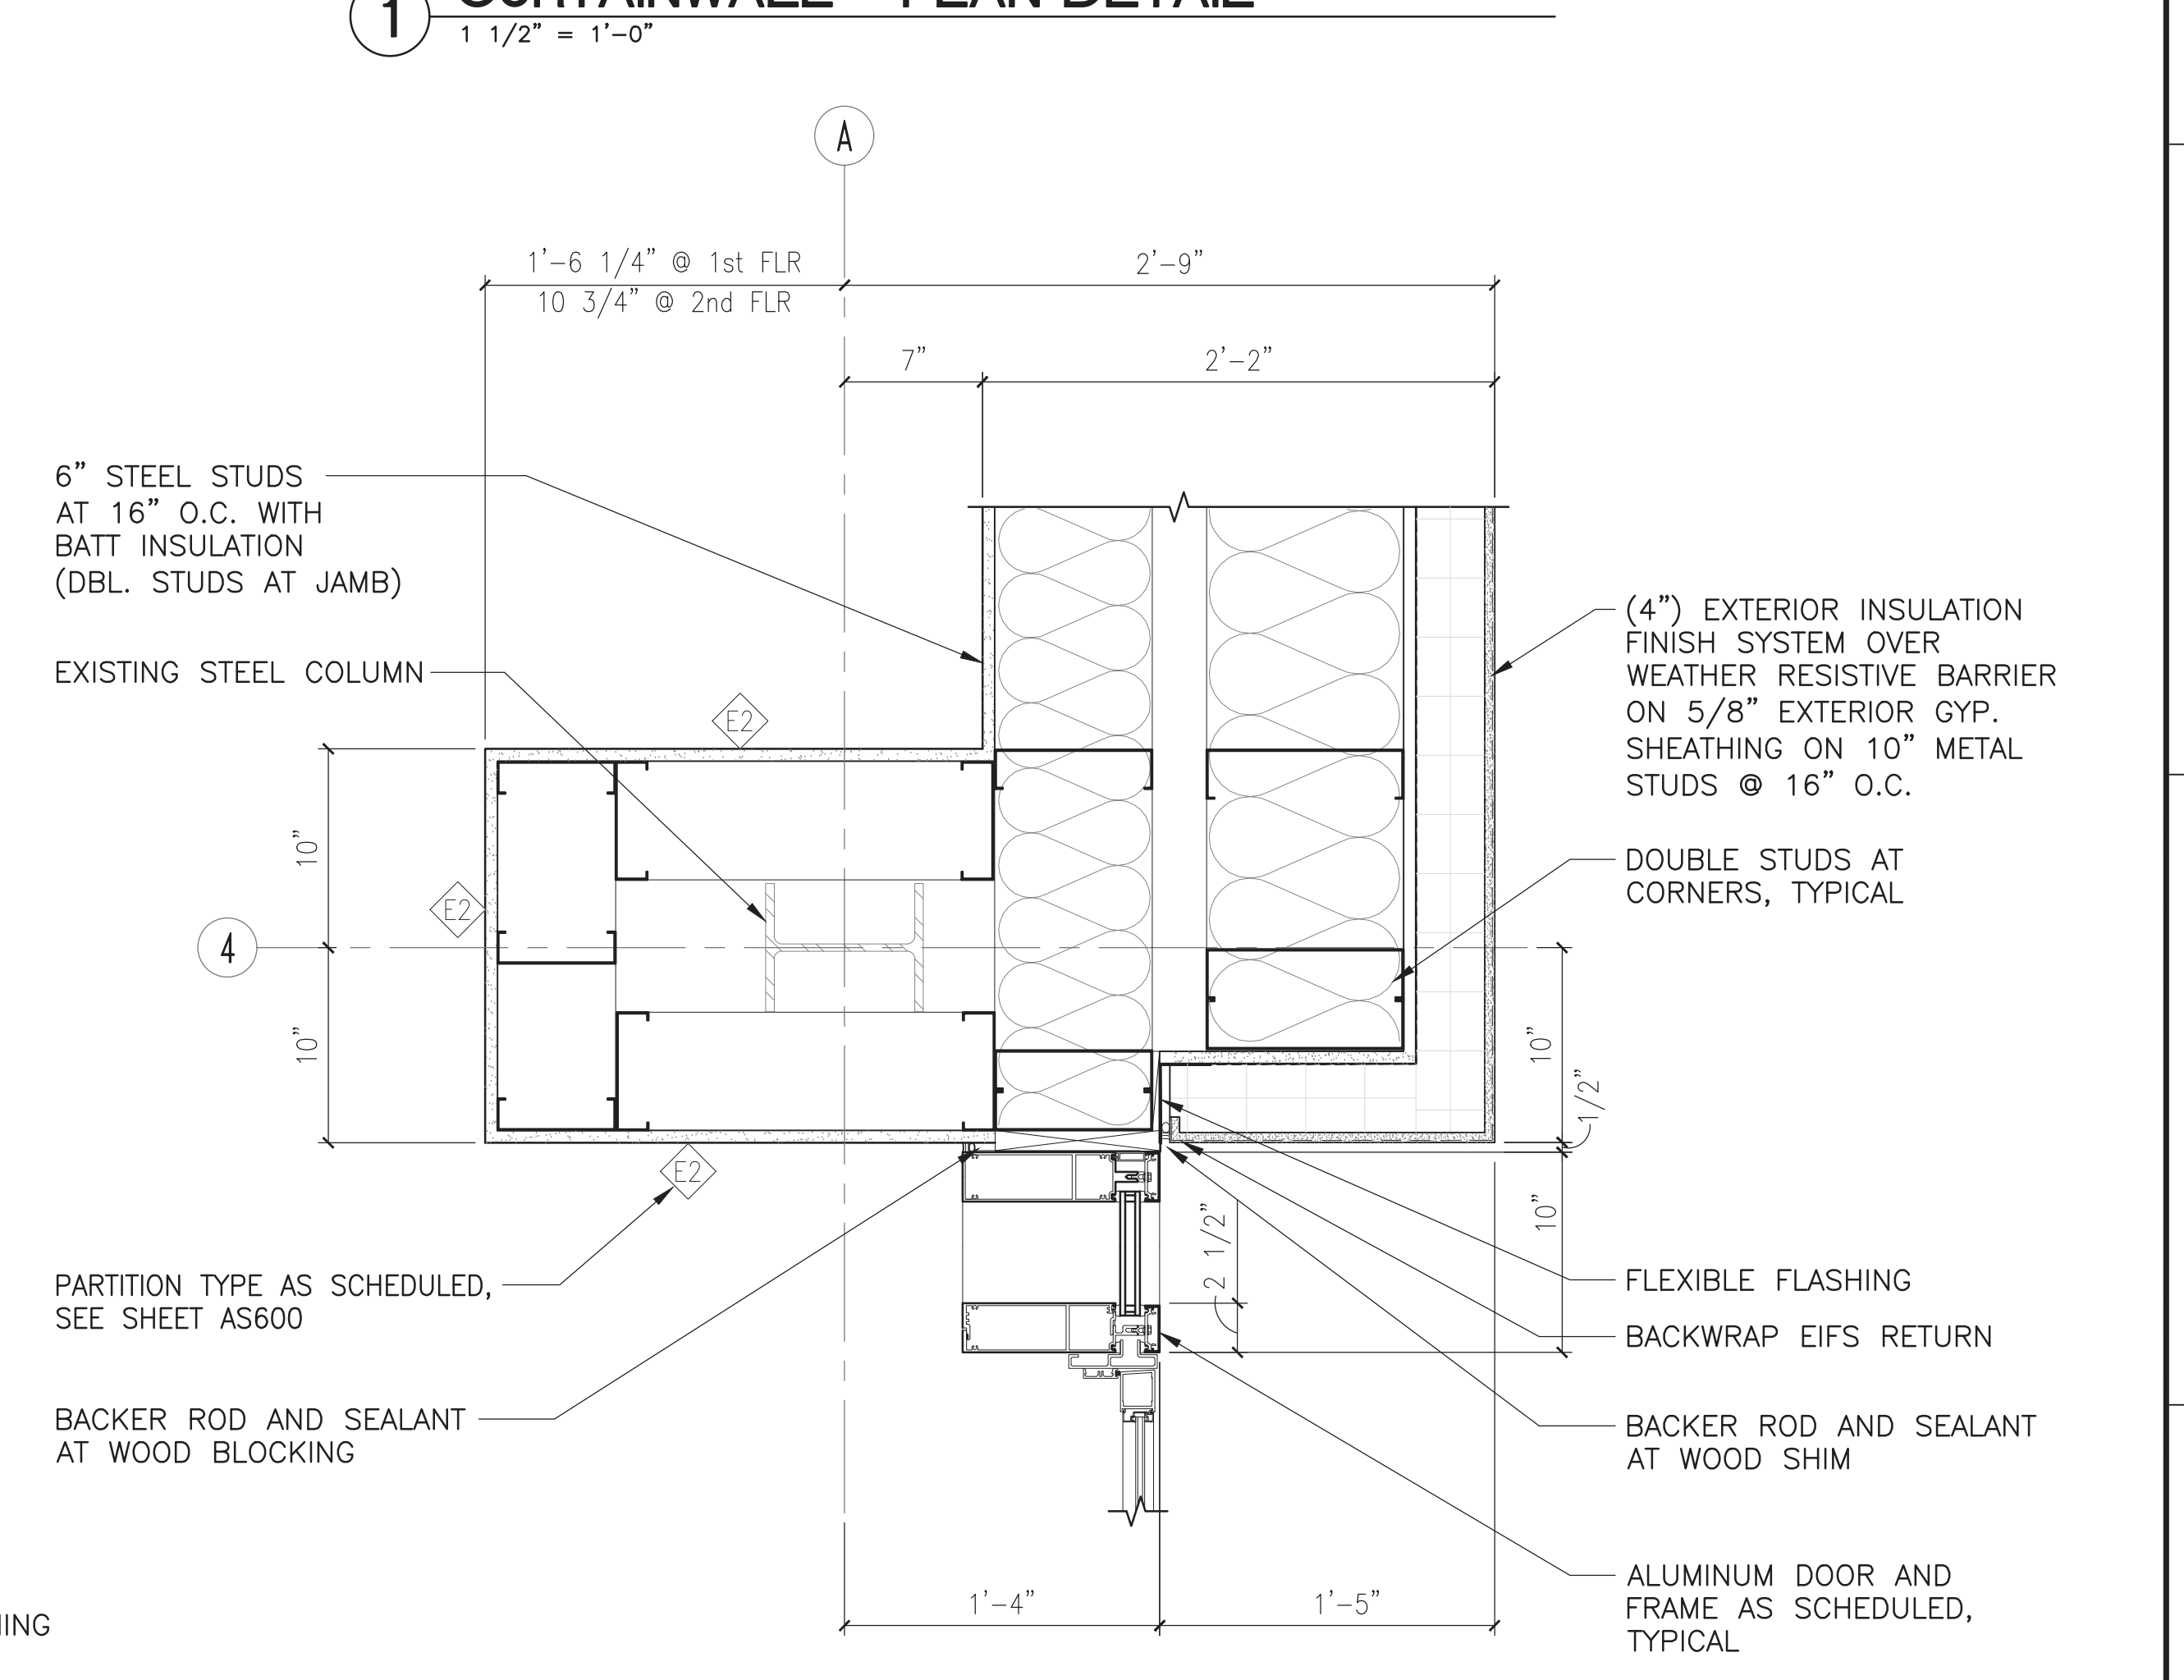

2 CURTAINWALL - PLAN DETAIL
1 1/2" = 1'-0"

ADDENDUM 01	07/18/2017
Revisions	Date


CONSULTANTS:	
BRYAN BENNO BRAUER, P.E. CONSULTING ENGINEER PO BOX 2586, TRUCKEE, CA 96160 (530)582-8883 BRYAN@BBBRAUER.COM	ARSENIO ORTEGA, P.E. CONSULTING ENGINEER 5 Third Street, Suite 716 San Francisco, CA 94103 (415) 546-0490 tel -0491 fax

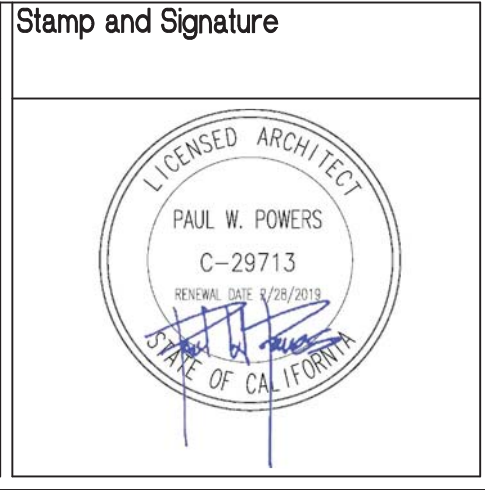

ARCHITECT/ENGINEERS:	
KPA ENGINEERS ARCHITECTS 6700 KOLL CENTER PARKWAY SUITE 125 PLEASANTON, CALIFORNIA 94566 Tel. 925.223.8217 www.thekpagroup.com	THE KPA GROUP ©THE KPA GROUP 2017 KPA Project No. 630.00

Drawing Title	ENLARGED PLAN DETAILS
Approved Project Director	VAPAHCS PLANNING AND ENGINEERING

Project Title	REPLACE SUNNYVALE BLDG. 1 EXTERIOR AND ROOF
Location	1080 INNOVATION WAY, SUNNYVALE, CA 94089
Date	03/03/2017
Checked	PWP
Drawn	KPA TEAM
Project Number	640-16-121
Building Number	1002
Drawing Number	AS812
Dwg. of	

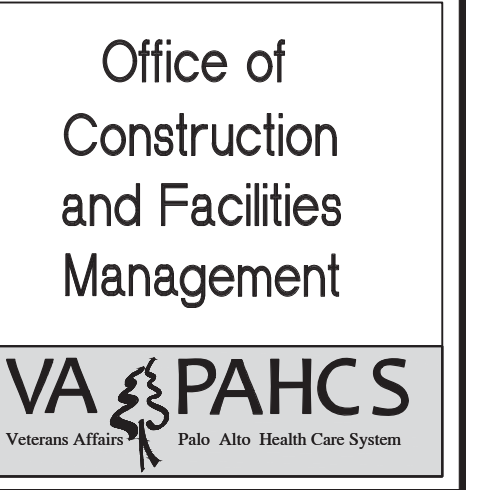

100% CONSTRUCTION DOCUMENTS