




three inches = one foot  
one and one half inches = one foot  
one inch = one foot  
three quarters inch = one foot  
one half inch = one foot  
three eighths inch = one foot  
one quarter inch = one foot  
one eighth inch = one foot

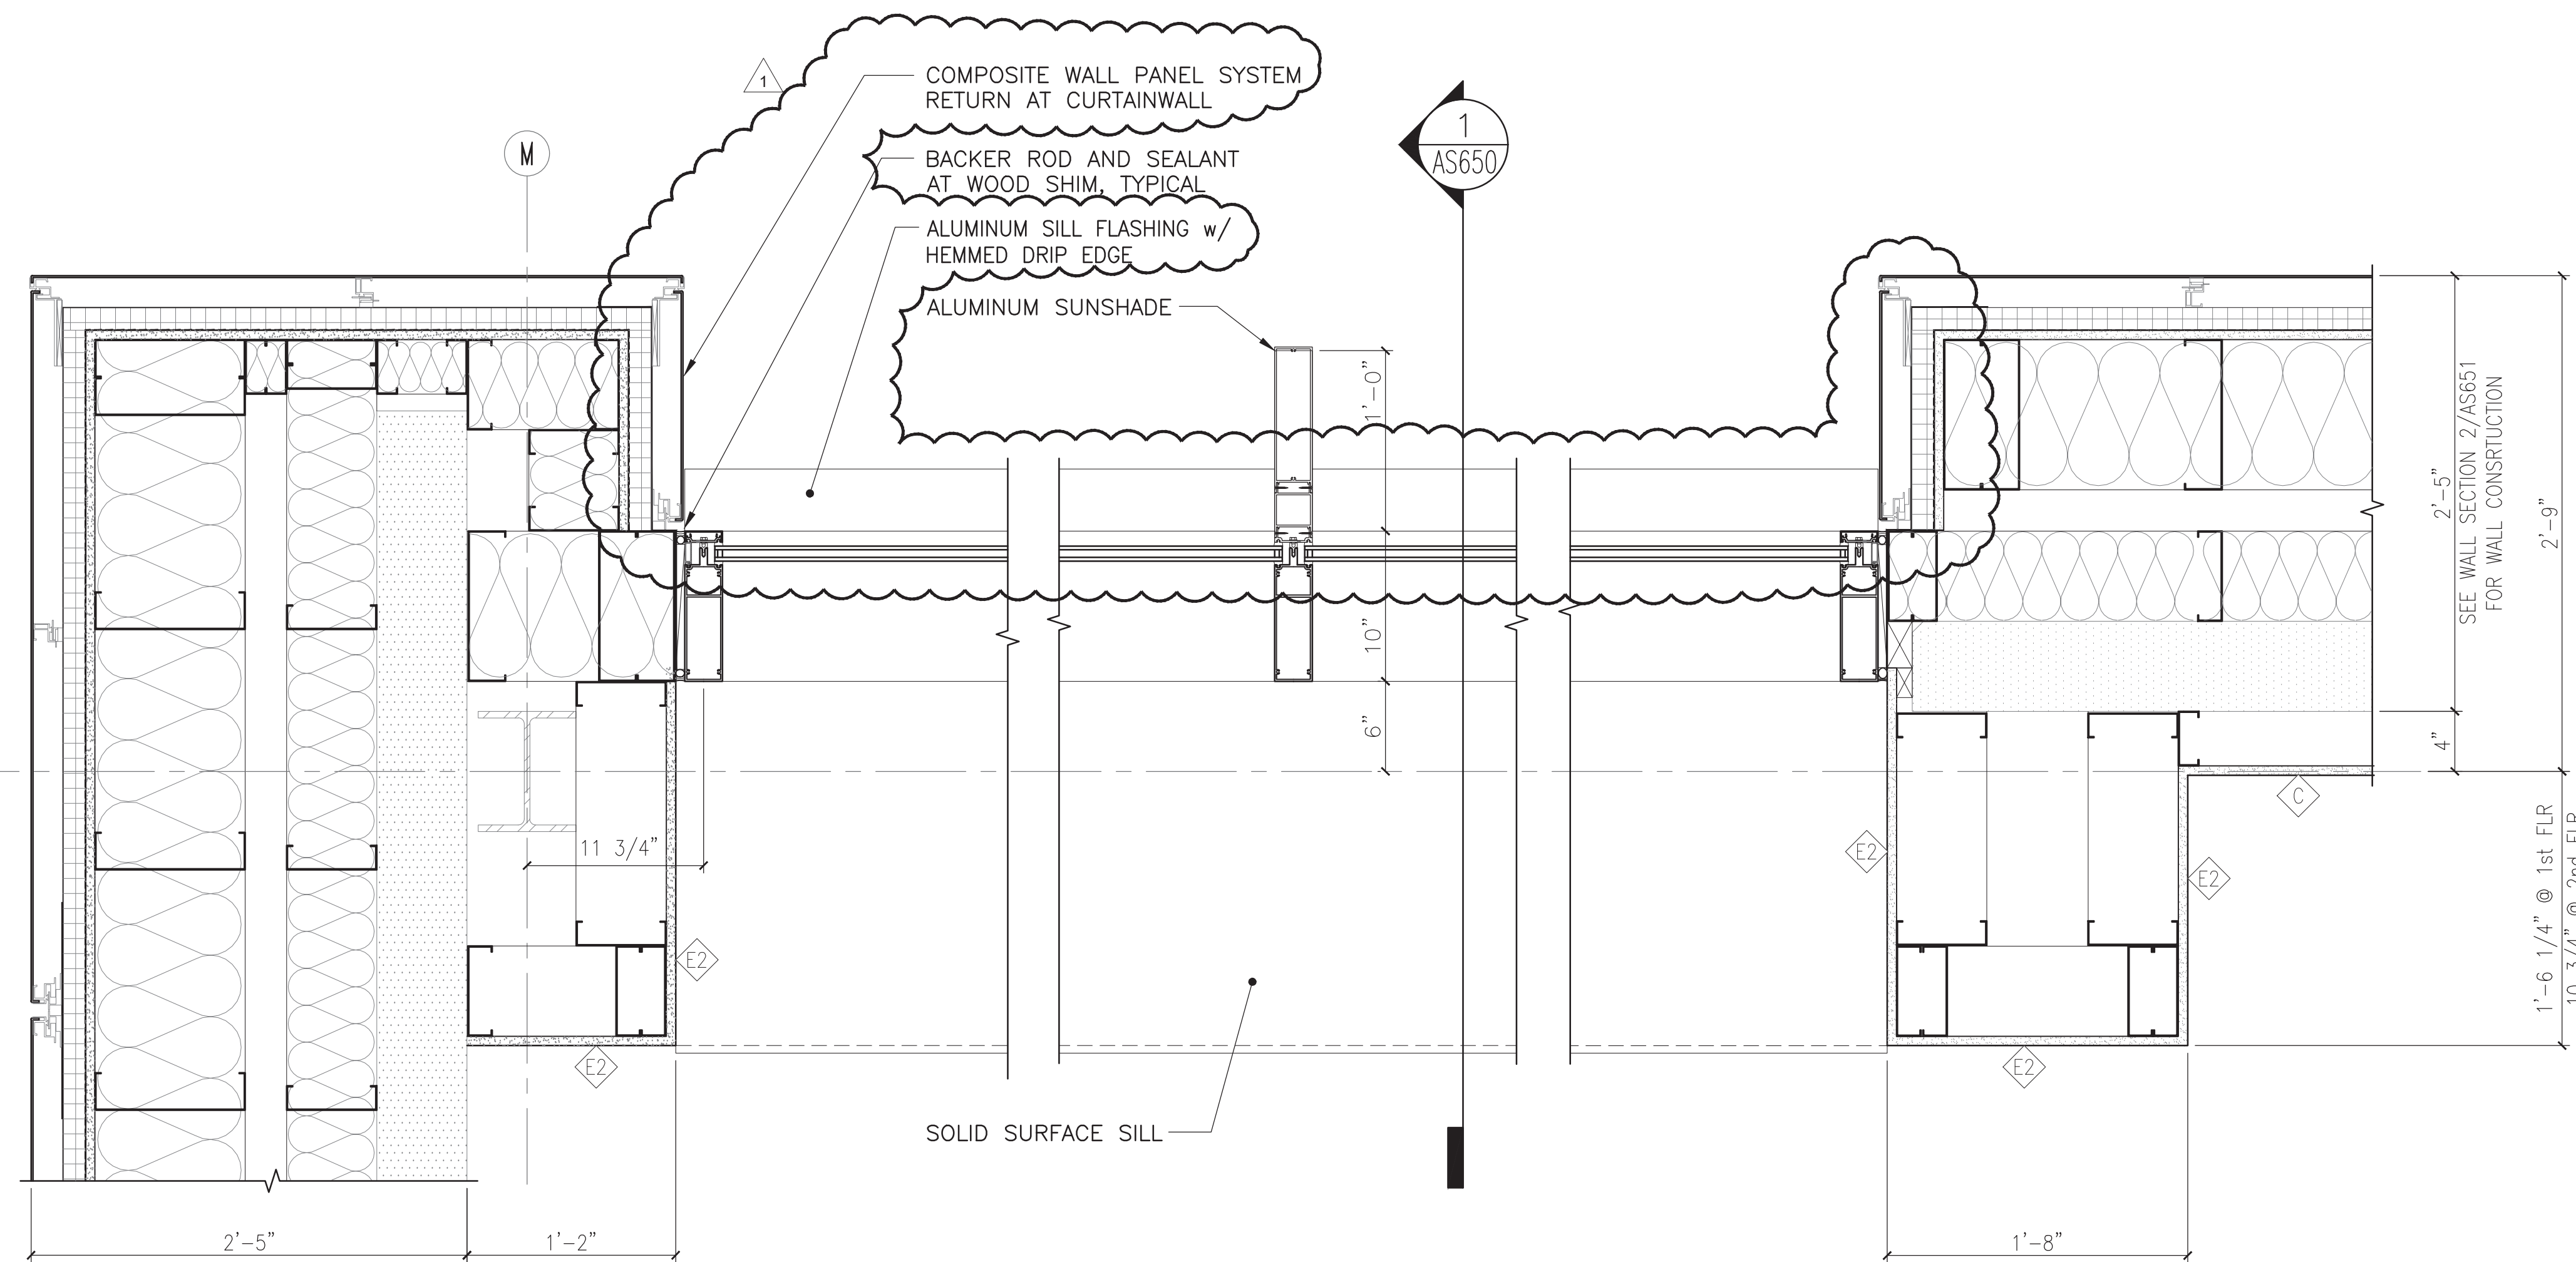


3 CURTAINWALL JAMB - ABOVE SILL  
1 1/2" = 1'-0"

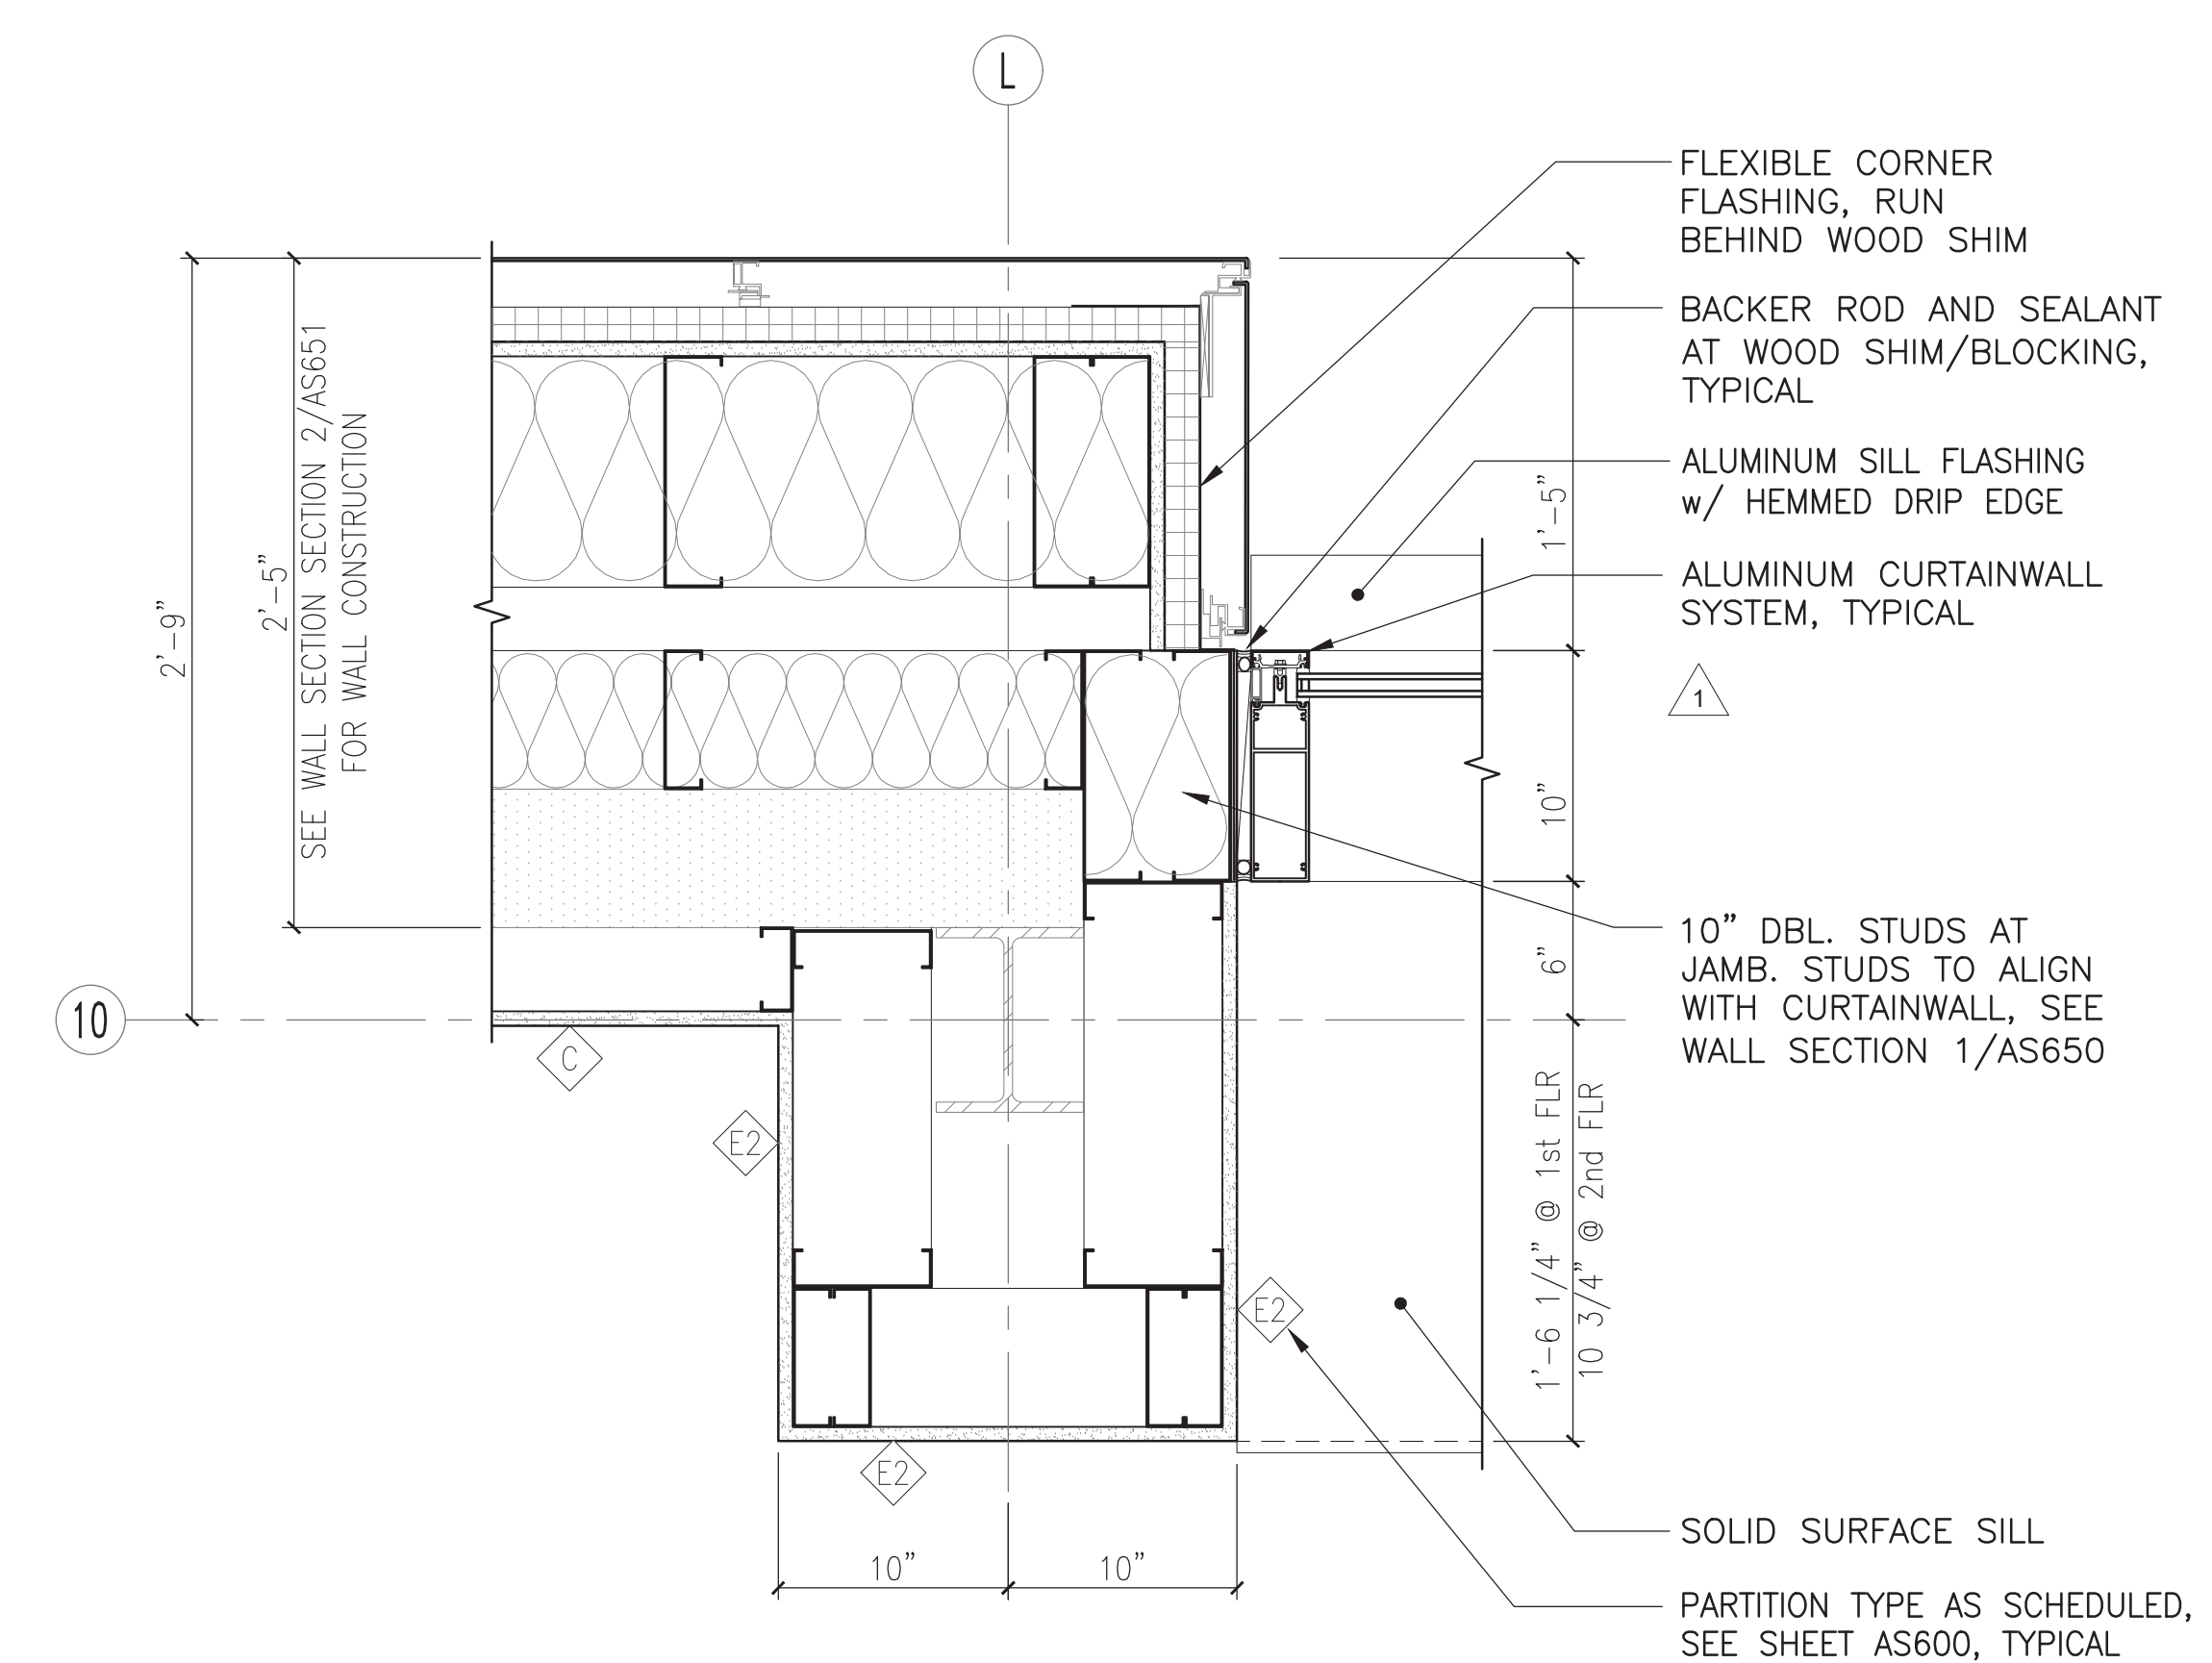

1 CURTAINWALL - PLAN DETAIL  
1 1/2" = 1'-0"

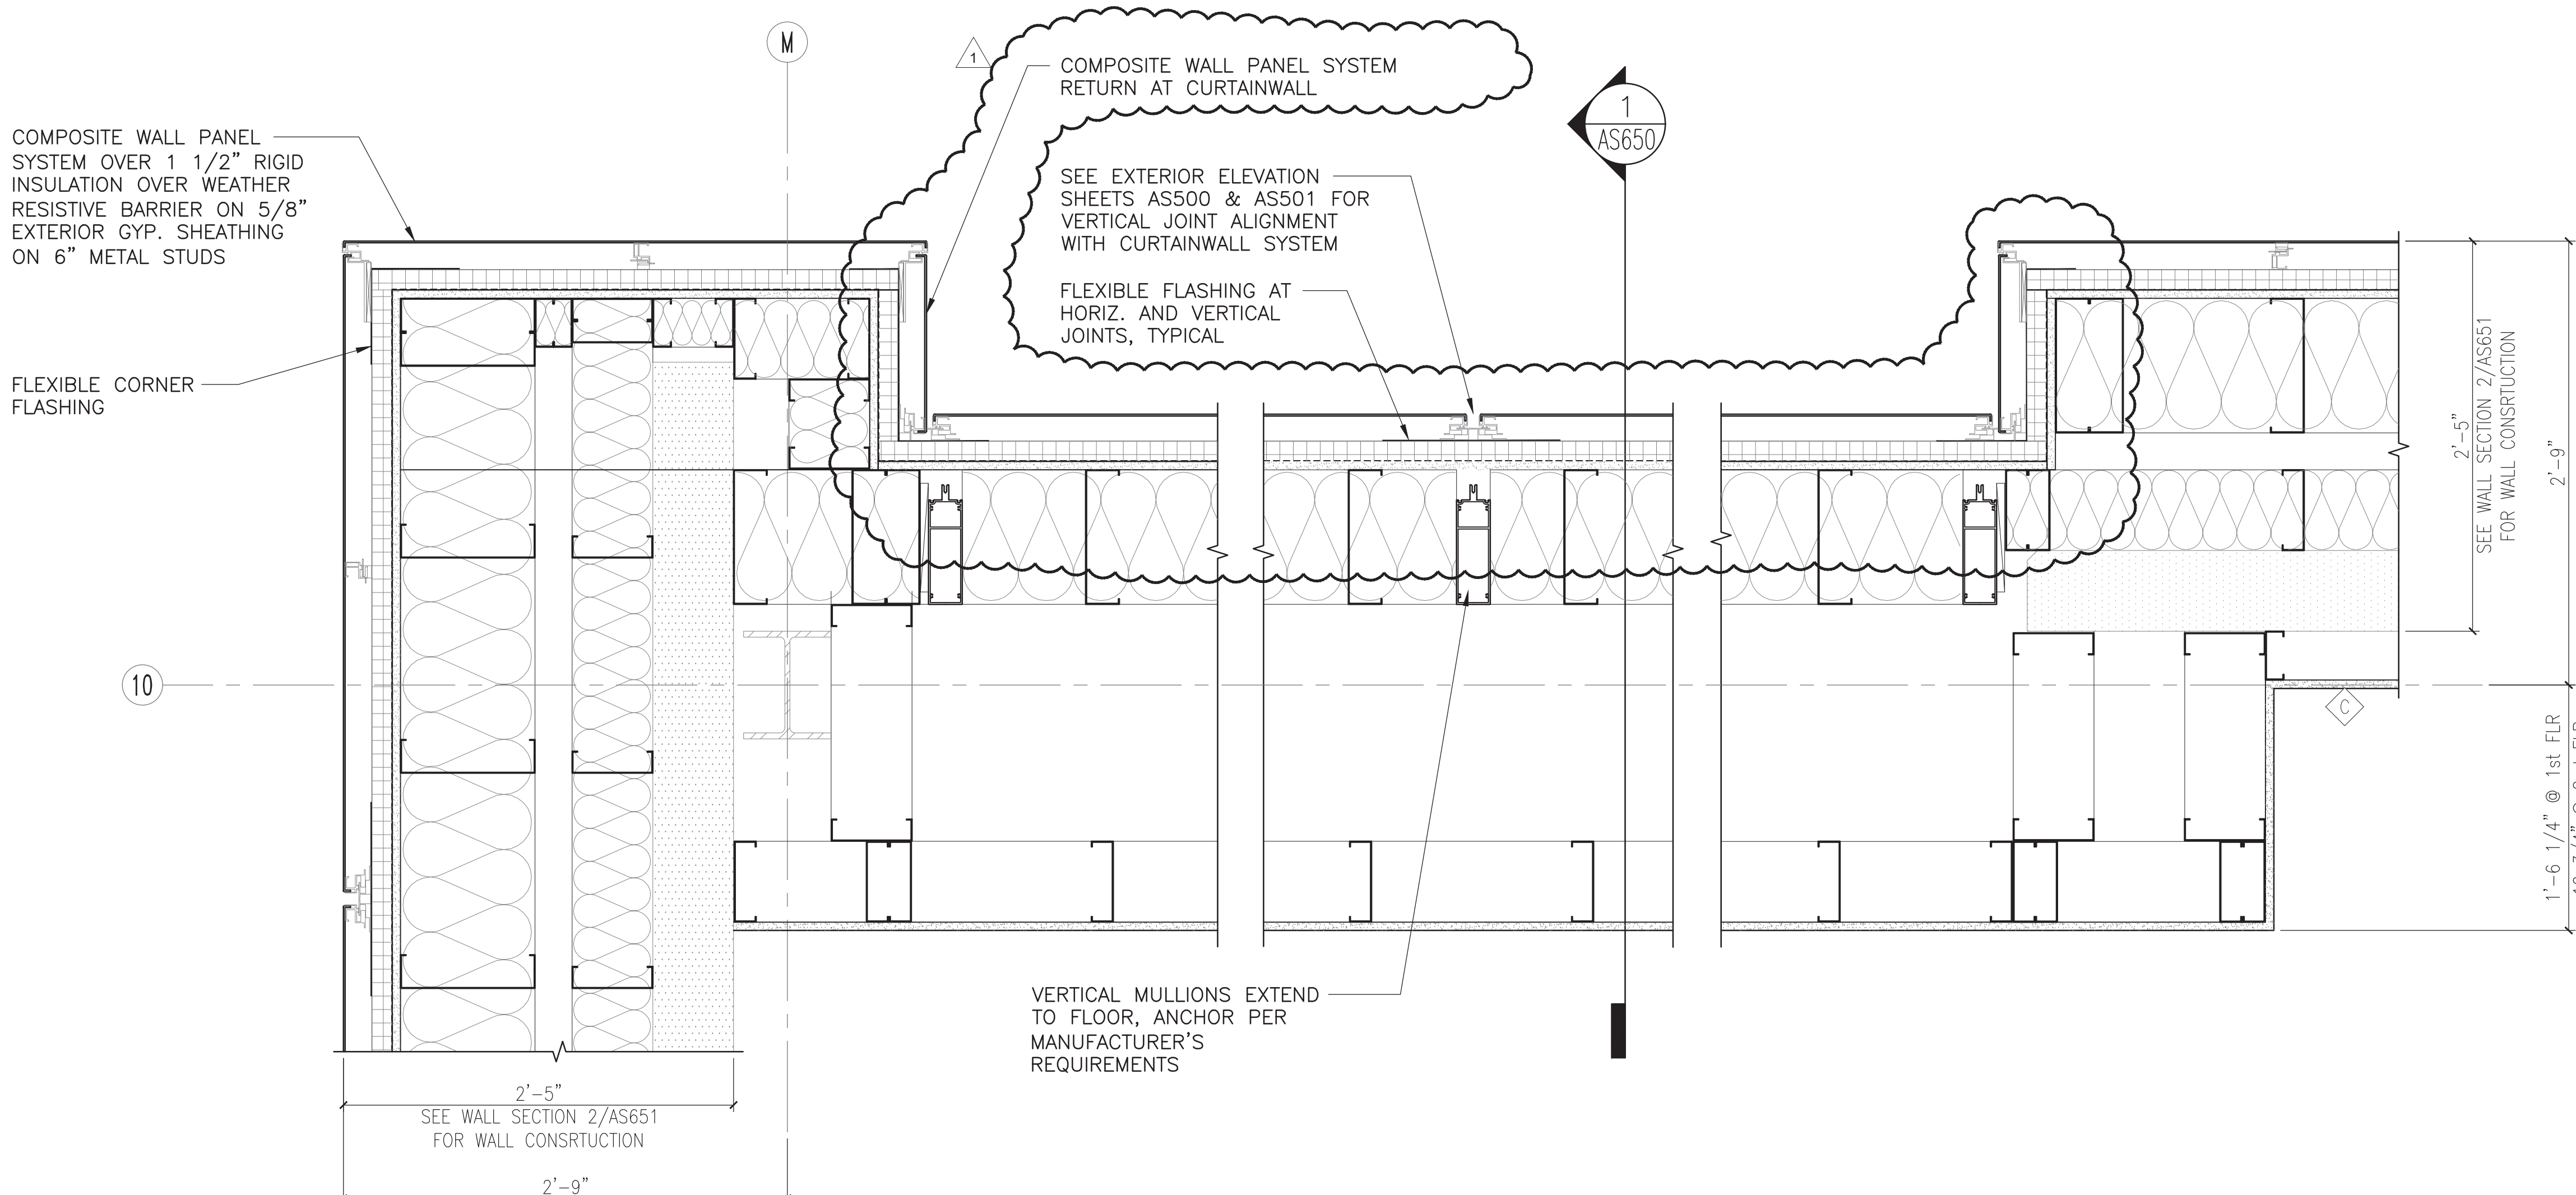

4 CURTAINWALL JAMB - BELOW SILL  
1 1/2" = 1'-0"

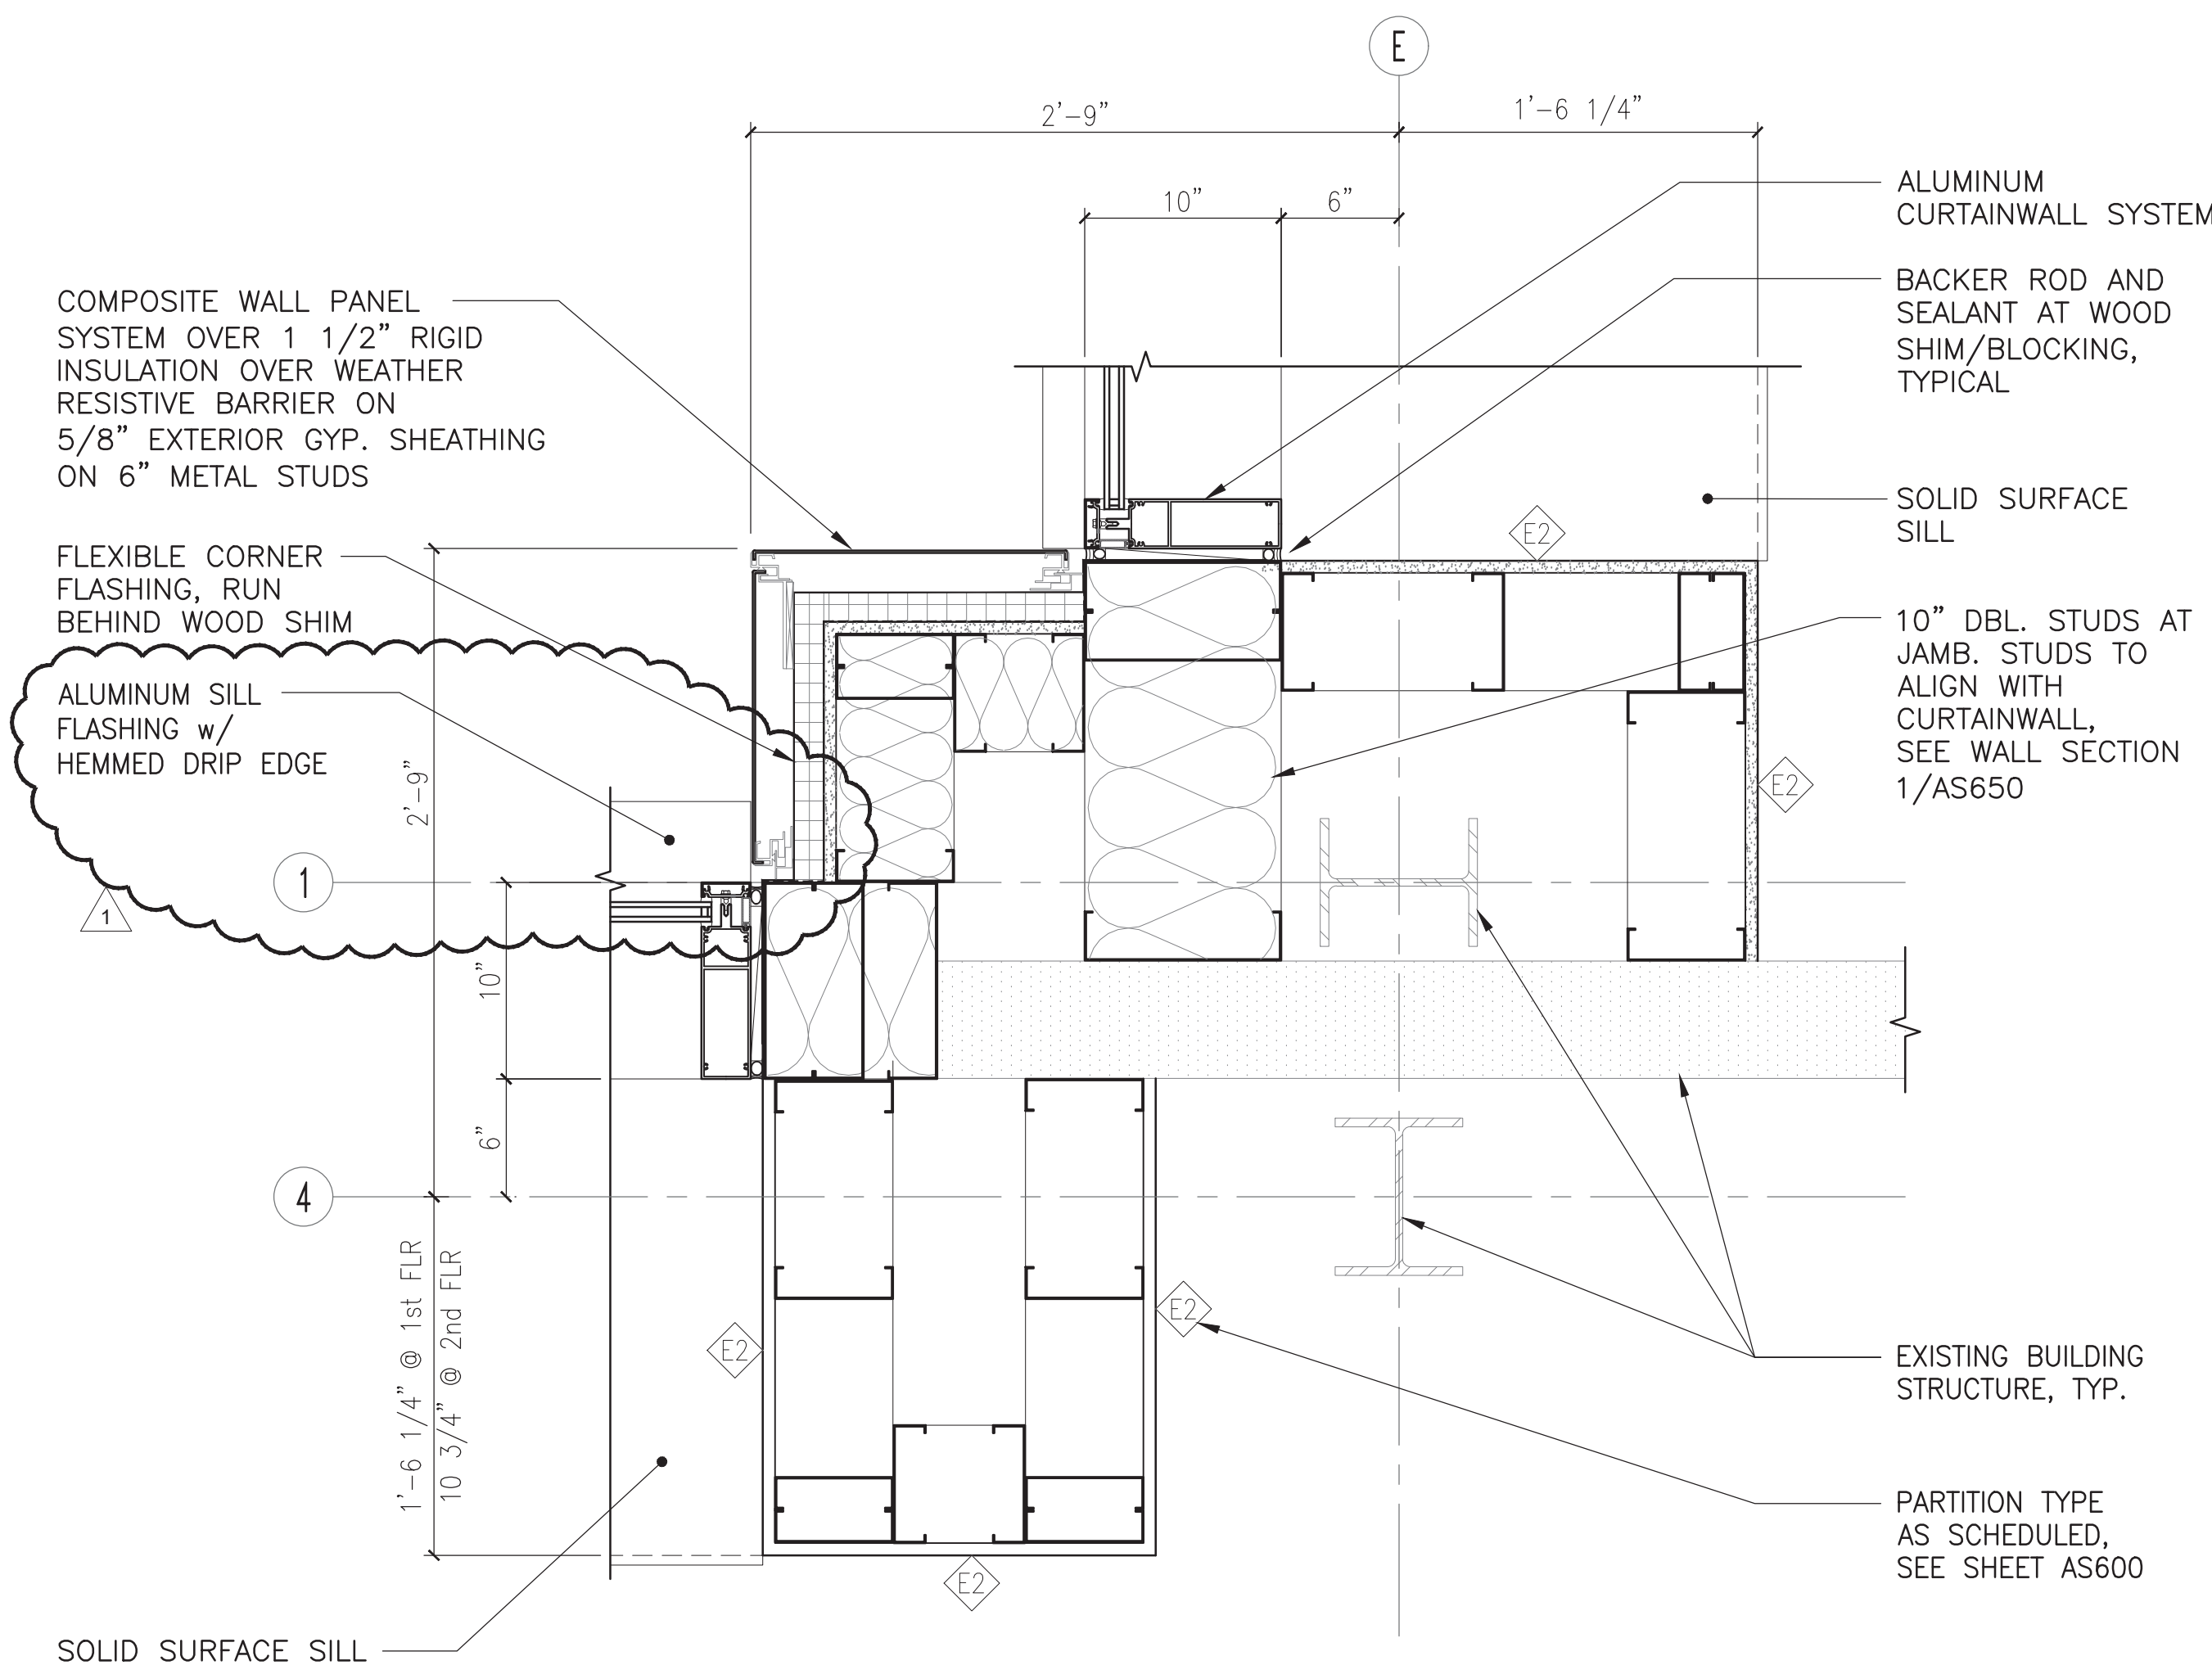

2 CURTAINWALL - PLAN DETAIL  
1 1/2" = 1'-0"

100% CONSTRUCTION DOCUMENTS

CONSULTANTS:		ARCHITECT/ENGINEERS:		Drawing Title		Project Title		Office of Construction and Facilities Management	
BRYAN BENNO BRAUER, P.E. CONSULTING ENGINEER PO BOX 2586, TRUCKEE, CA 96160 (530)582-8883 BRYAN@BBBRAUER.COM		ARSENIO ORTEGA, P.E. CONSULTING ENGINEER 5 Third Street, Suite 716 San Francisco, CA 94103 (415) 546-0490 tel -0491 fax		ENLARGED PLAN DETAILS		REPLACE SUNNYVALE BLDG. 1 EXTERIOR AND ROOF		VA & PAHCS	
ADDENDUM 01 Revisions		Stamp and Signature		Approved Project Director		Location		Drawing Number	
07/18/2017		THE KPA GROUP		VAPAHCS PLANNING AND ENGINEERING		1080 INNOVATION WAY, SUNNYVALE, CA 94089		AS813	
Date		6700 KOLL CENTER PARKWAY SUITE 125 PLEASANTON, CALIFORNIA 94566 Tel 925.223.8217 www.thekpagroup.com		Date		Date		Dwg. of	
		PAUL W. POWERS C-29713 ARCHITECT STATE OF CALIFORNIA		03/03/2017		Checked		Date	
		KPA				PWP		KPA TEAM	
		THE KPA GROUP							
		©THE KPA GROUP 2017 KPA Project No. 630.00							