



3 WALL SECTION
1" = 1'-0"

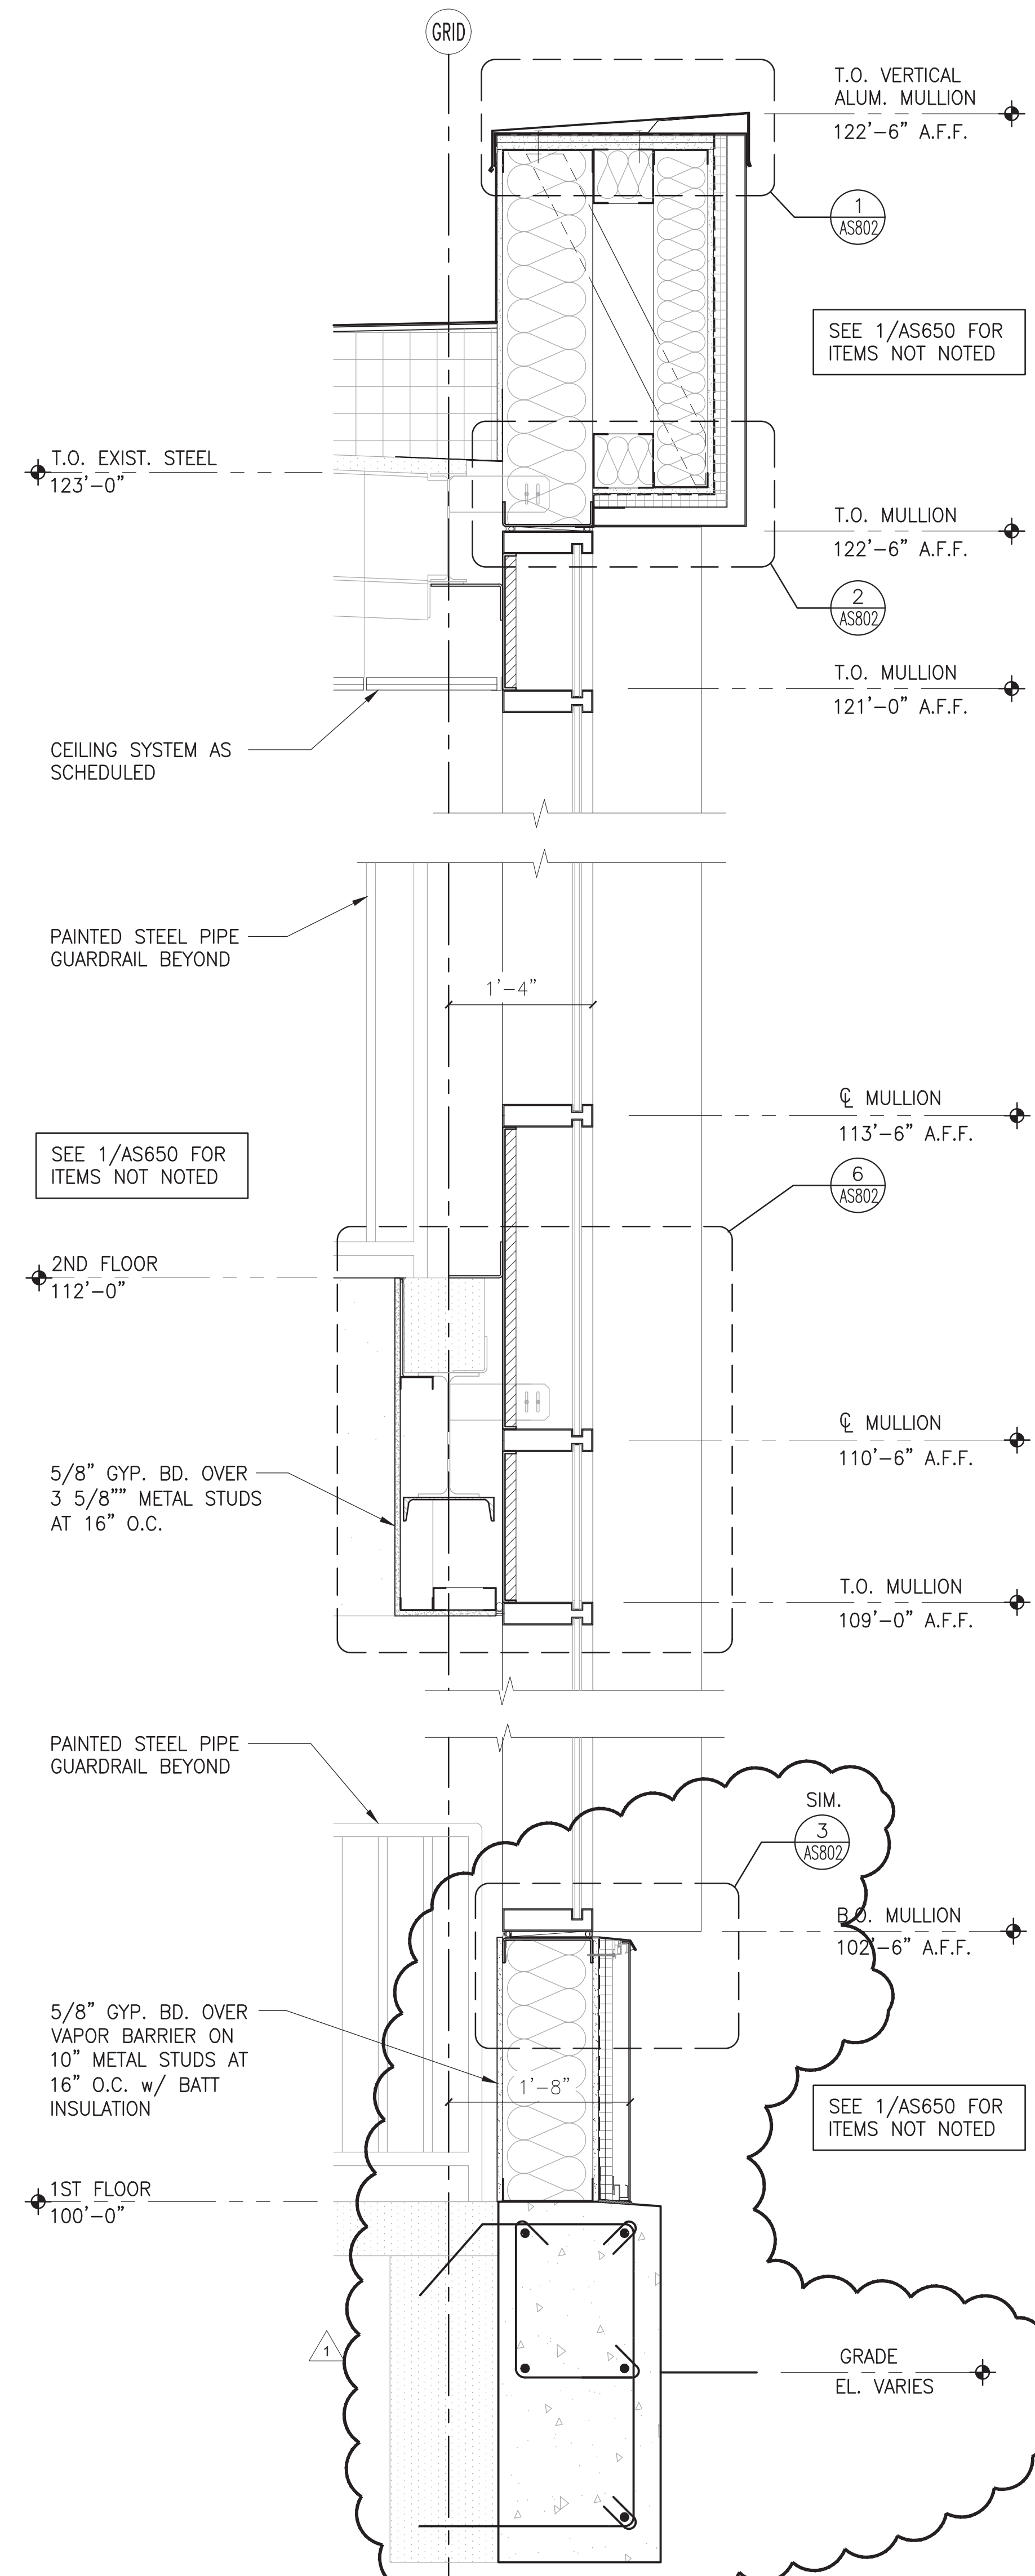


2 WALL SECTION
1" = 1'-0"

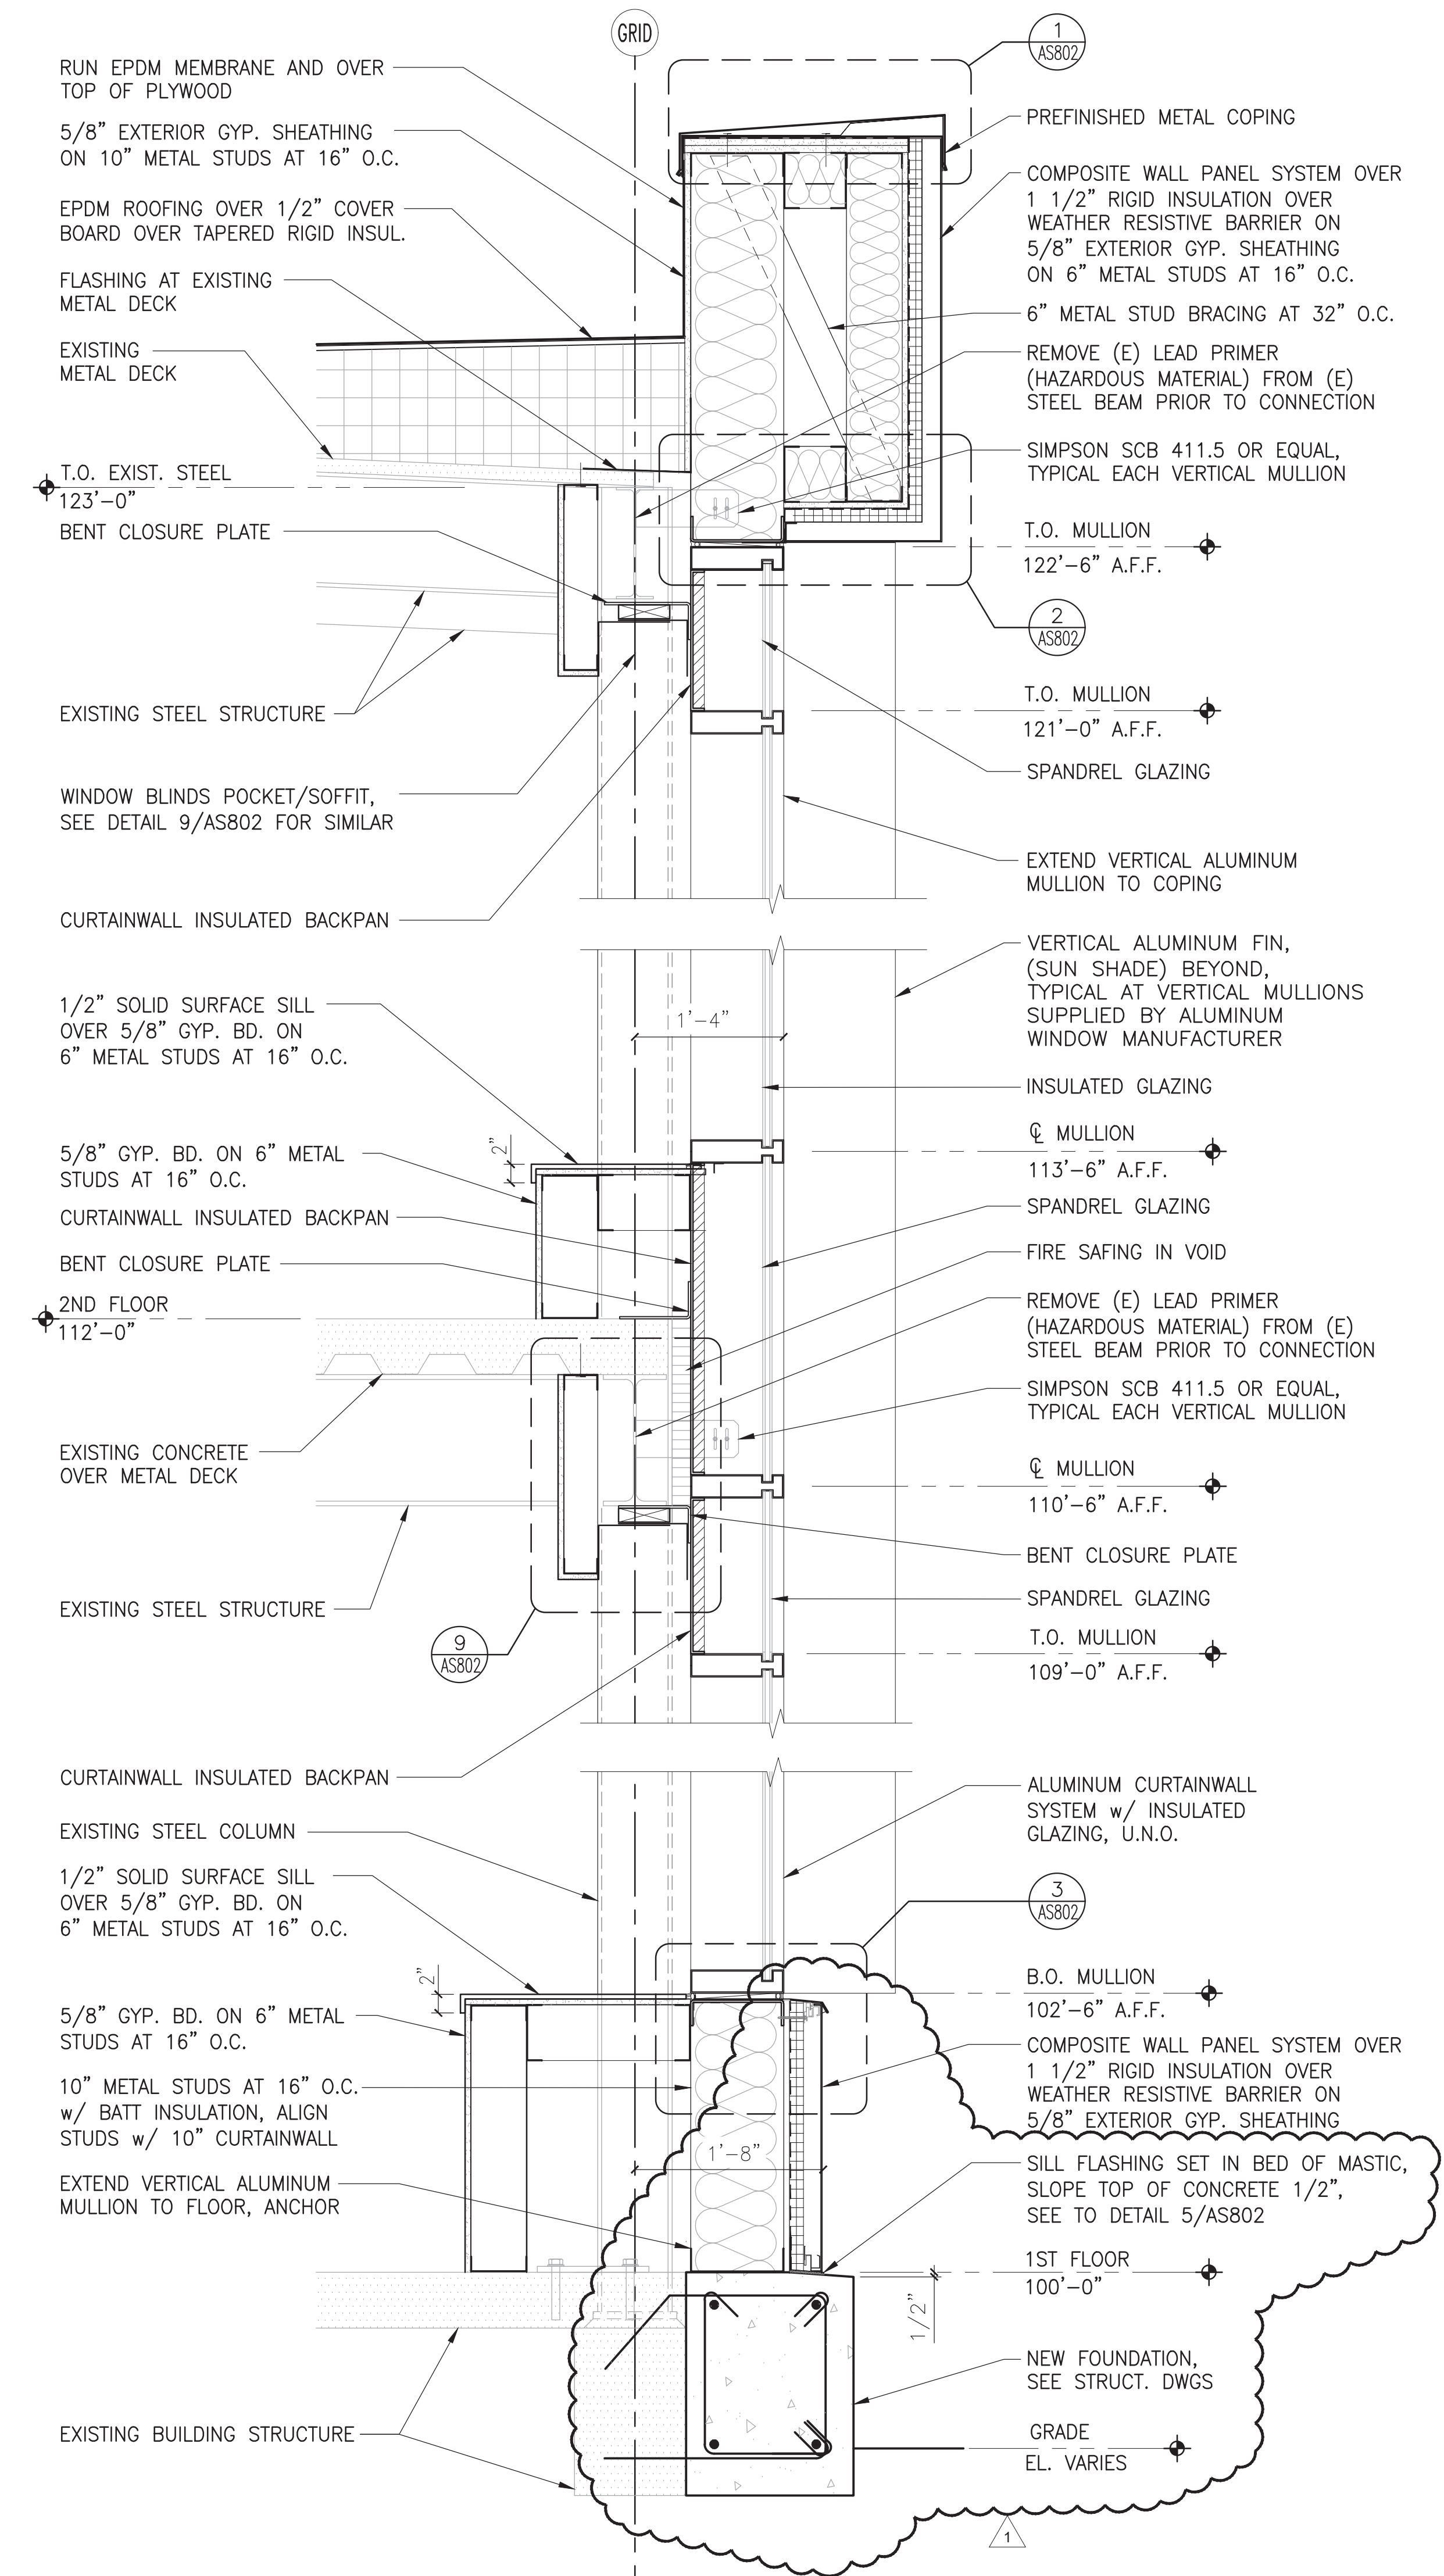

1 WALL SECTION
1" = 1'-0"

100% CONSTRUCTION DOCUMENTS

--	--
--	--
--	--
--	--
--	--
--	--
--	--
--	--
ADDENDUM 01 	07/18/2017
Revisions:	Date

CONSULTANTS:	
<p>BRYAN BENNO BRAUER, P.E. CONSULTING ENGINEER PO BOX 2586, TRUCKEE, CA 96160 (530)582-8683 BRYAN@BBBRAUER.COM</p>	<p>ARSENIO ORTEGA, P.E. CONSULTING ENGINEER 5 Third Street, Suite 716 San Francisco, CA 94103 (415) 546-0490 tel -0491 fax</p>

Stamp and Signature

ARCHITECT/ENGINEERS:



ENGINEERS ARCHITECTS

6700 KOLL CENTER PARKWAY SUITE 125
PLEASANTON, CALIFORNIA 94566

TEL 925.223.8217 www.thekpagroup.com



©THE KPA GROUP 2017

KPA Project No. 630.00

Drawing Title WALL SECTIONS
Approved: Project Director - - VAPAHCS PLANNING AND ENGINEERING

Project Title	REPLACE SUNNYVALE BLDG. 1 EXTERIOR AND ROOF		Project Number 640-16-121
Location	1080 INNOVATION WAY, SUNNYVALE, CA 94089		Drawing Number 1002
Date 03/03/2017	Checked PWP	Drawn KPA TEAM	AS650 Dwg. of

Office of
Construction
and Facilities
Management

VA PAHCS
Veterans Affairs Palo Alto Health Care System