

three inches = one foot
one and one half inches = one foot
one inch = one foot
three quarters inch = one foot
three eighths inch = one foot
one half inch = one foot
one quarter inch = one foot
one eighth inch = one foot
one sixteenth inch = one foot

Text (Rev)

VA FORM 08-6231

Revisions	Date
ADDENDUM 01	07/18/2017

CONSULTANTS:

BRYAN BENNO BRAUER, P.E.
CONSULTING ENGINEER
PO BOX 2586, TRUCKEE, CA 96160 (530)582-8883
BRYAN@BBBRAUER.COM

ARSENIO ORTEGA, P.E.
CONSULTING ENGINEER
5 Third Street, Suite 716
San Francisco, CA 94103
(415) 546-0490 tel -0491 fax

Stamp and Signature



ARCHITECT/ENGINEERS:

KPA
ENGINEERS ARCHITECTS
6700 KOLL CENTER PARKWAY SUITE 125
PLEASANTON, CALIFORNIA 94566
TEL 925.223.8217 www.thekpagroup.com
©THE KPA GROUP 2017
KPA Project No. 630.00

Drawing Title
CONCRETE DETAILS

Approved Project Director
VAPAHCS PLANNING AND ENGINEERING

Project Title
REPLACE SUNNYVALE BLDG. 1
EXTERIOR AND ROOF

Location
1080 INNOVATION WAY, SUNNYVALE, CA 94089
Date
03/03/2017

Checked
PWP
Drawn
KPA TEAM
Dwg. of


Project Number
640-16-121
Building Number
1002

Drawing Number
SS002


Office of
Construction
and Facilities
Management

VAPAHCS
Veterans Affairs Palo Alto Health Care System


Posted 7/24/17

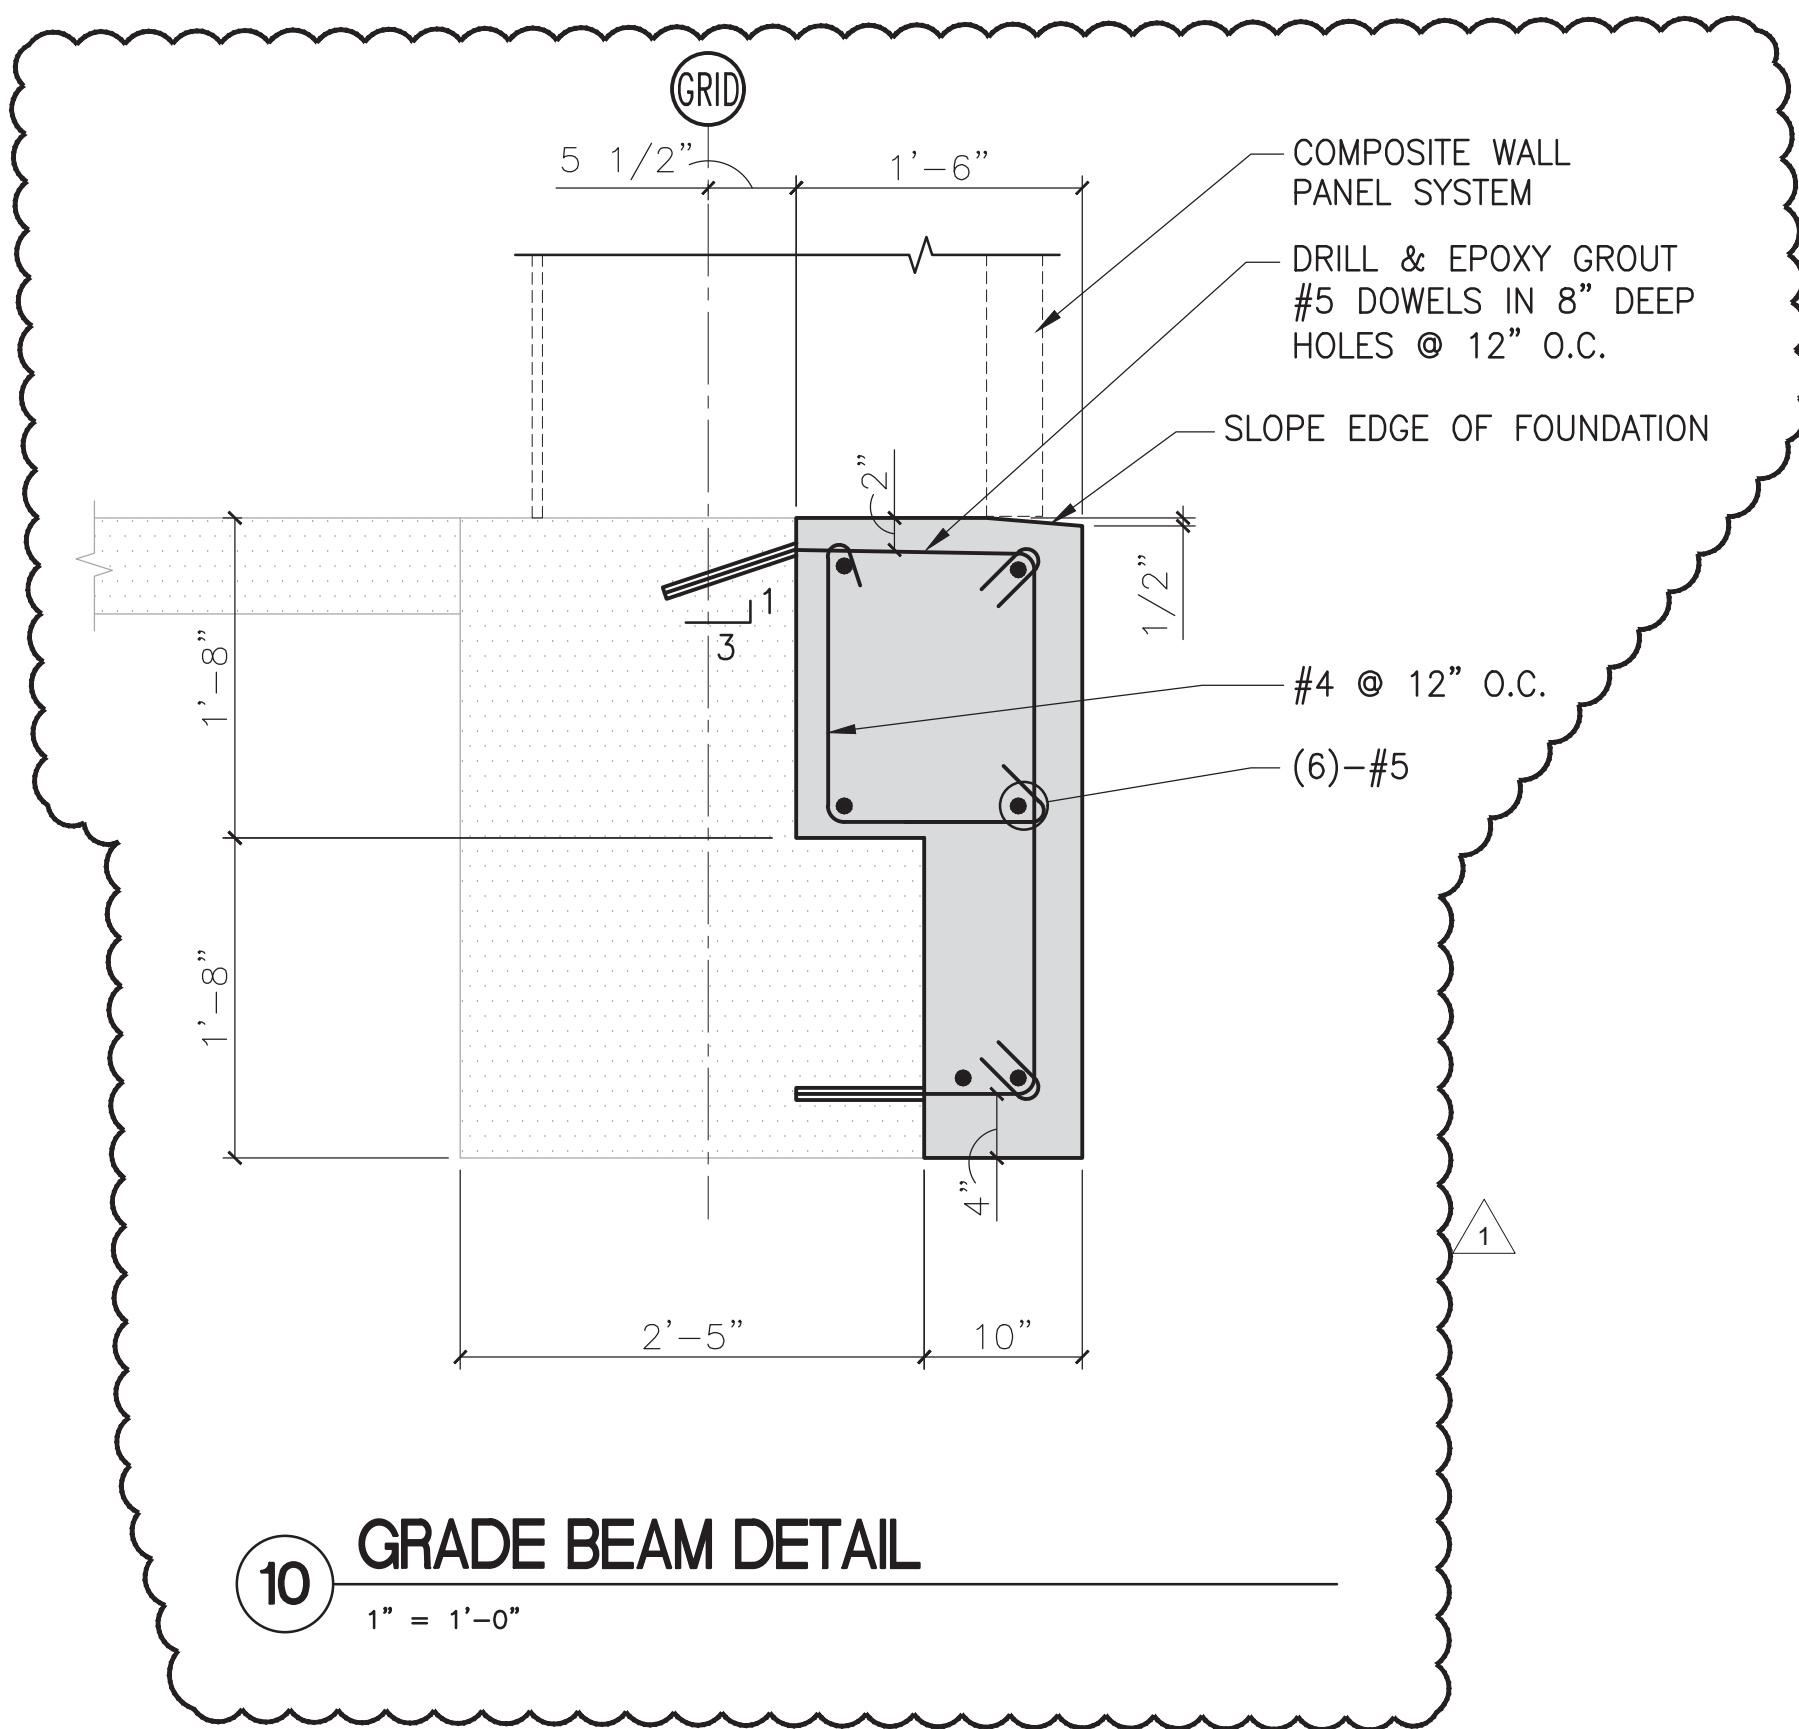


10 GRADE BEAM DETAIL
1" = 1'-0"

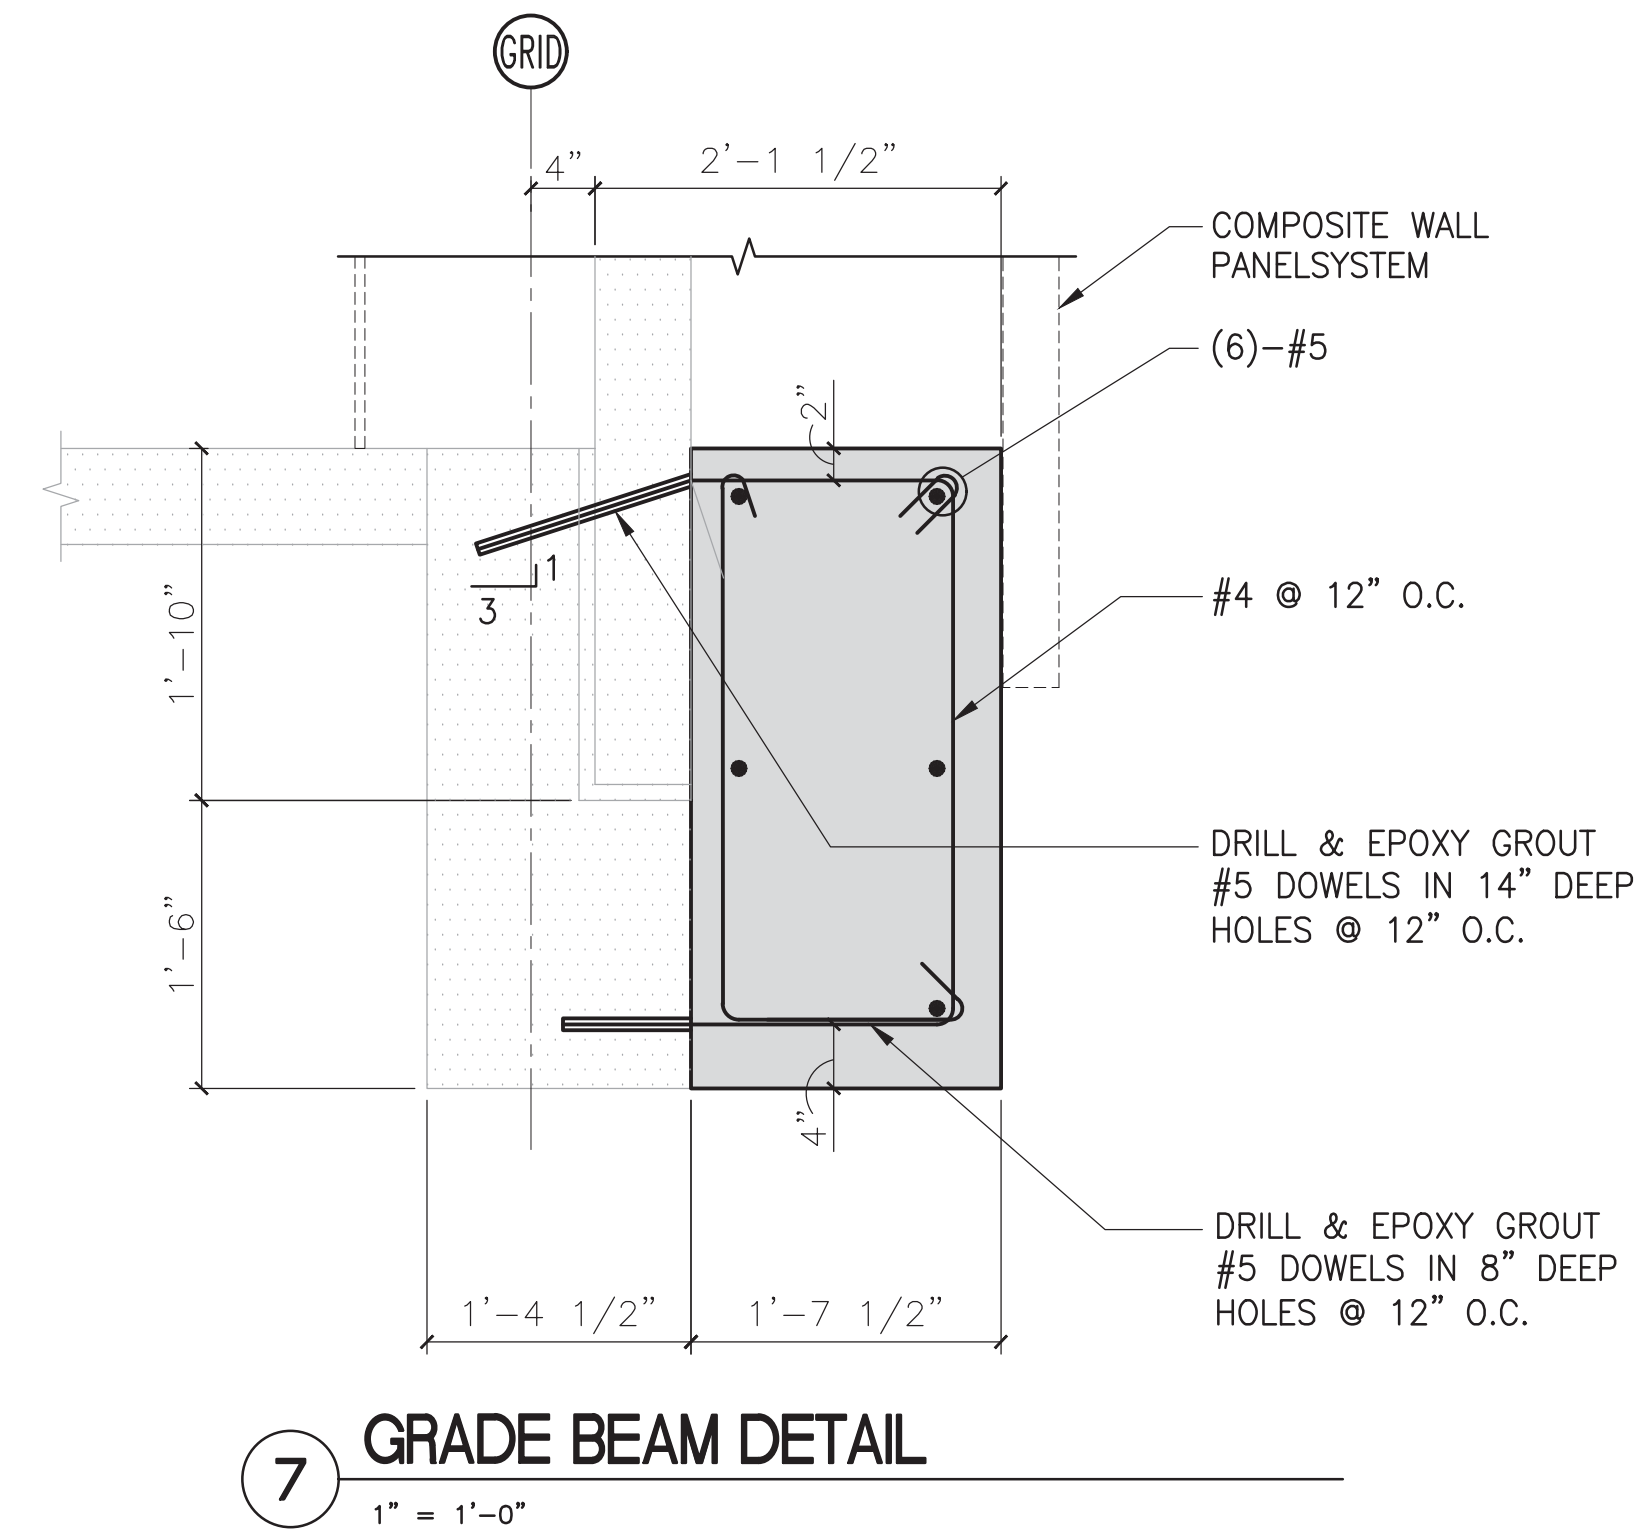


7 GRADE BEAM DETAIL
1" = 1'-0"

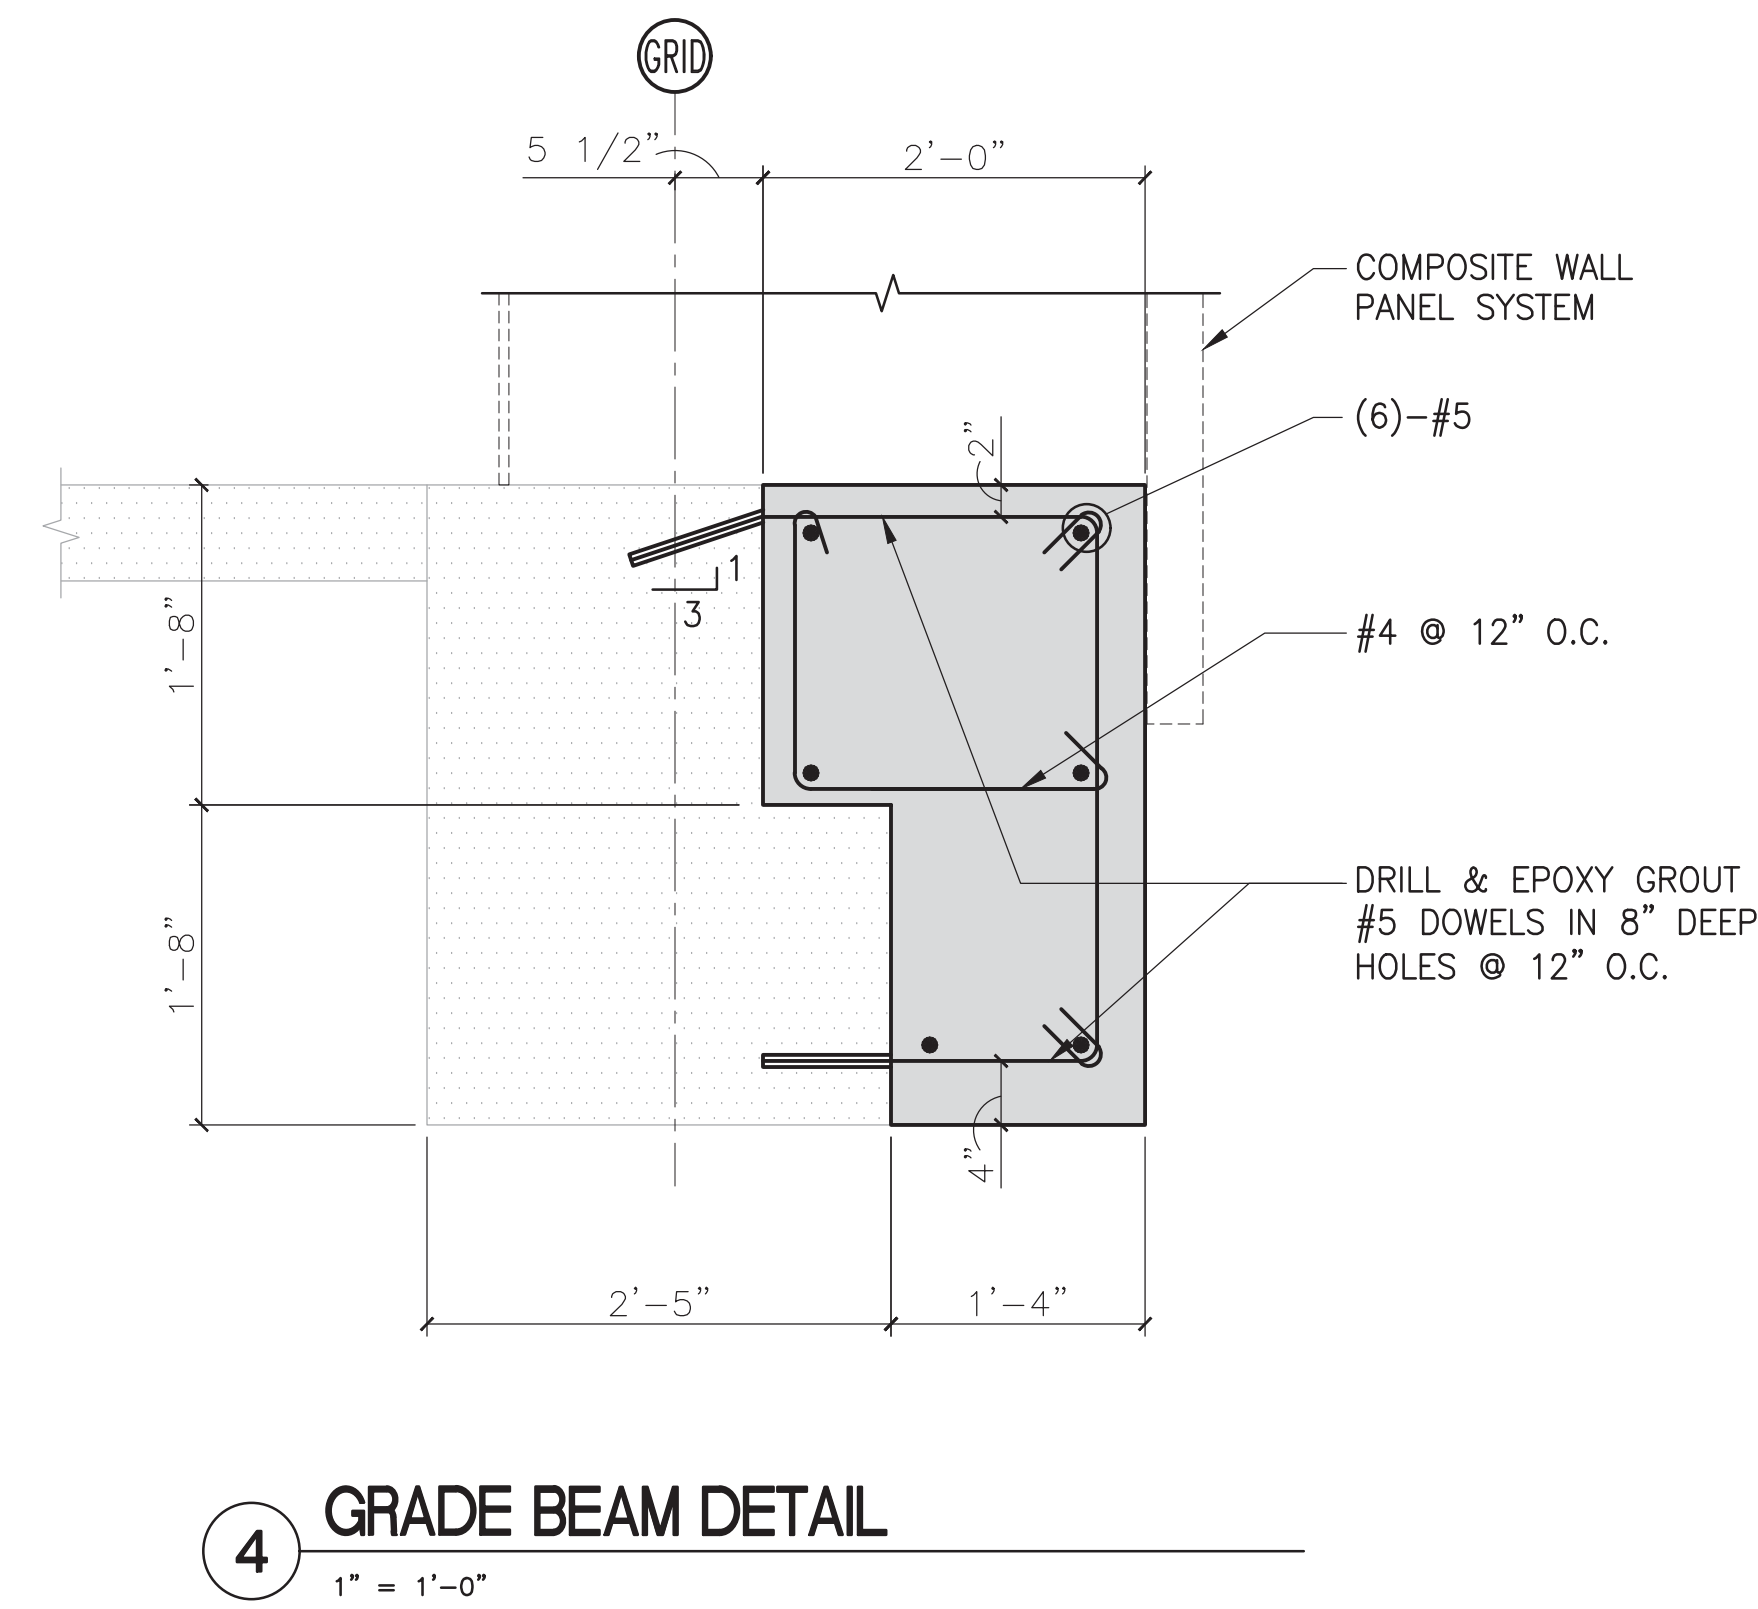


4 GRADE BEAM DETAIL
1" = 1'-0"

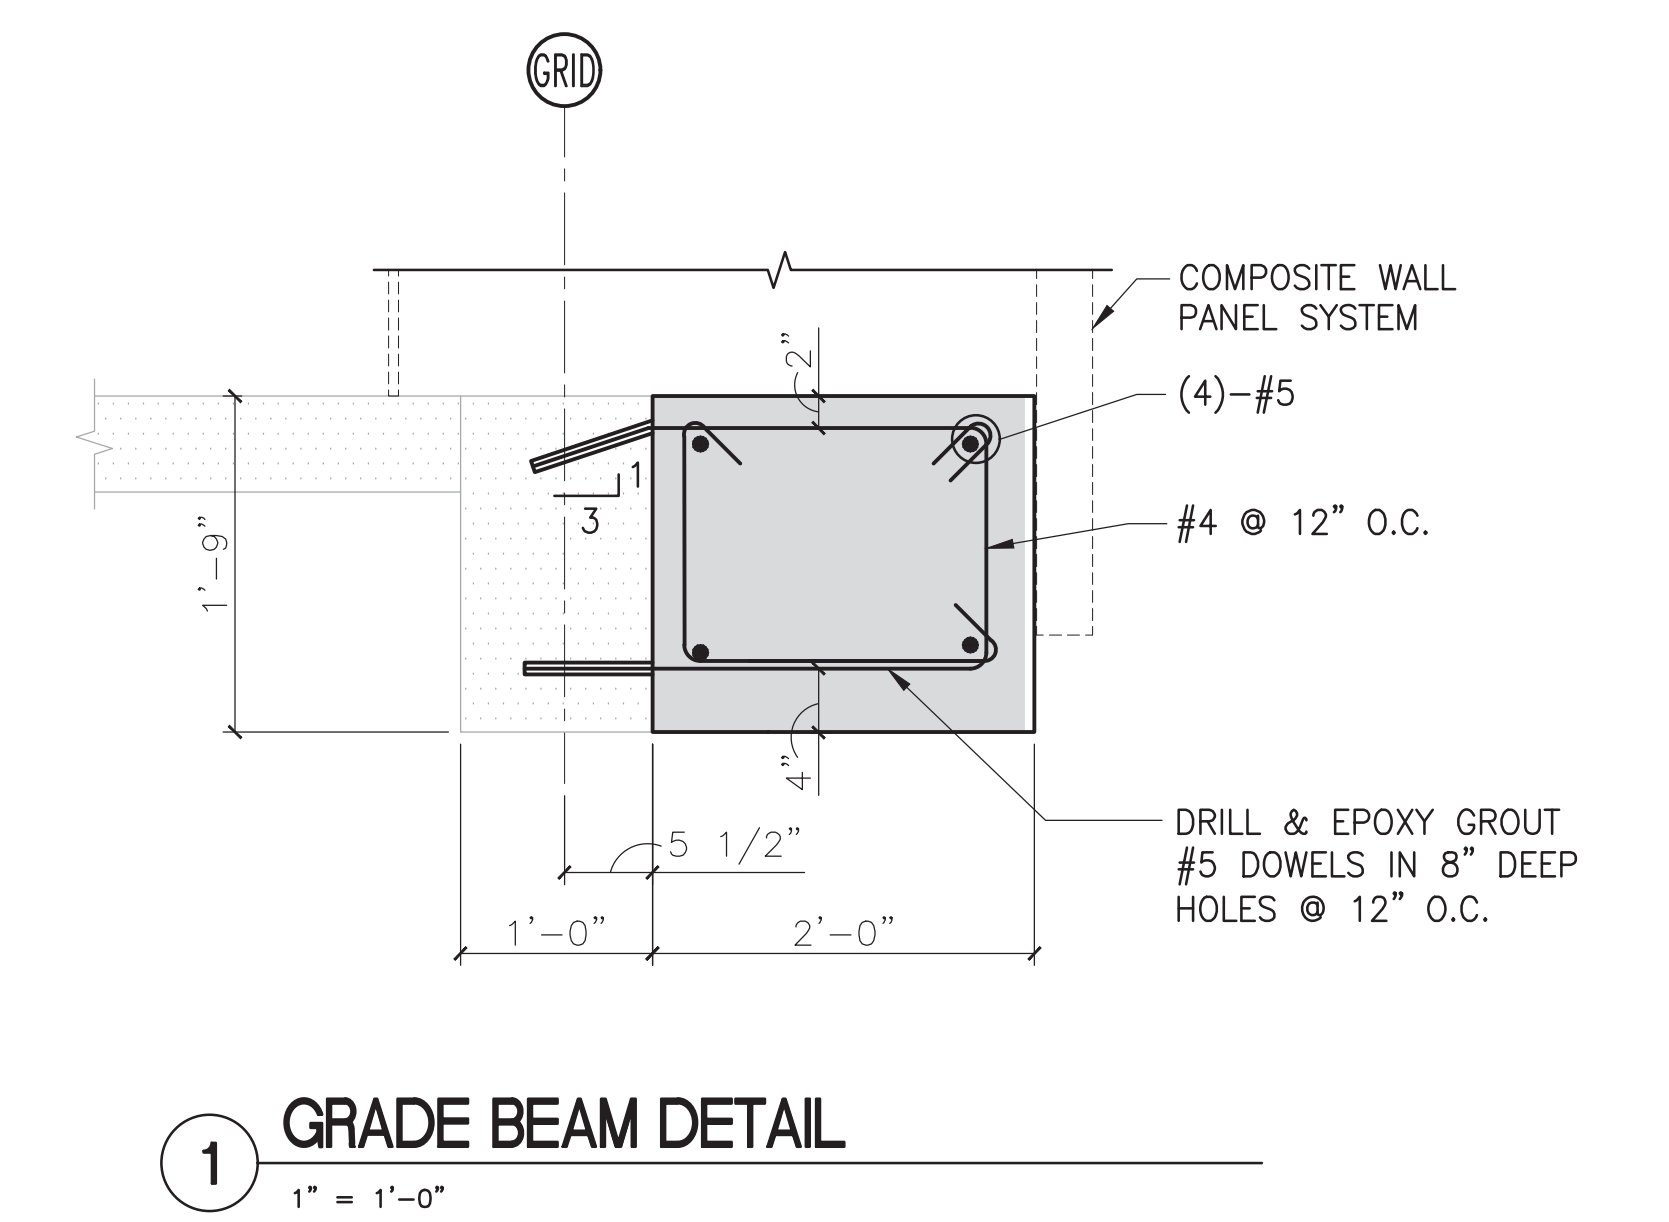


1 GRADE BEAM DETAIL
1" = 1'-0"

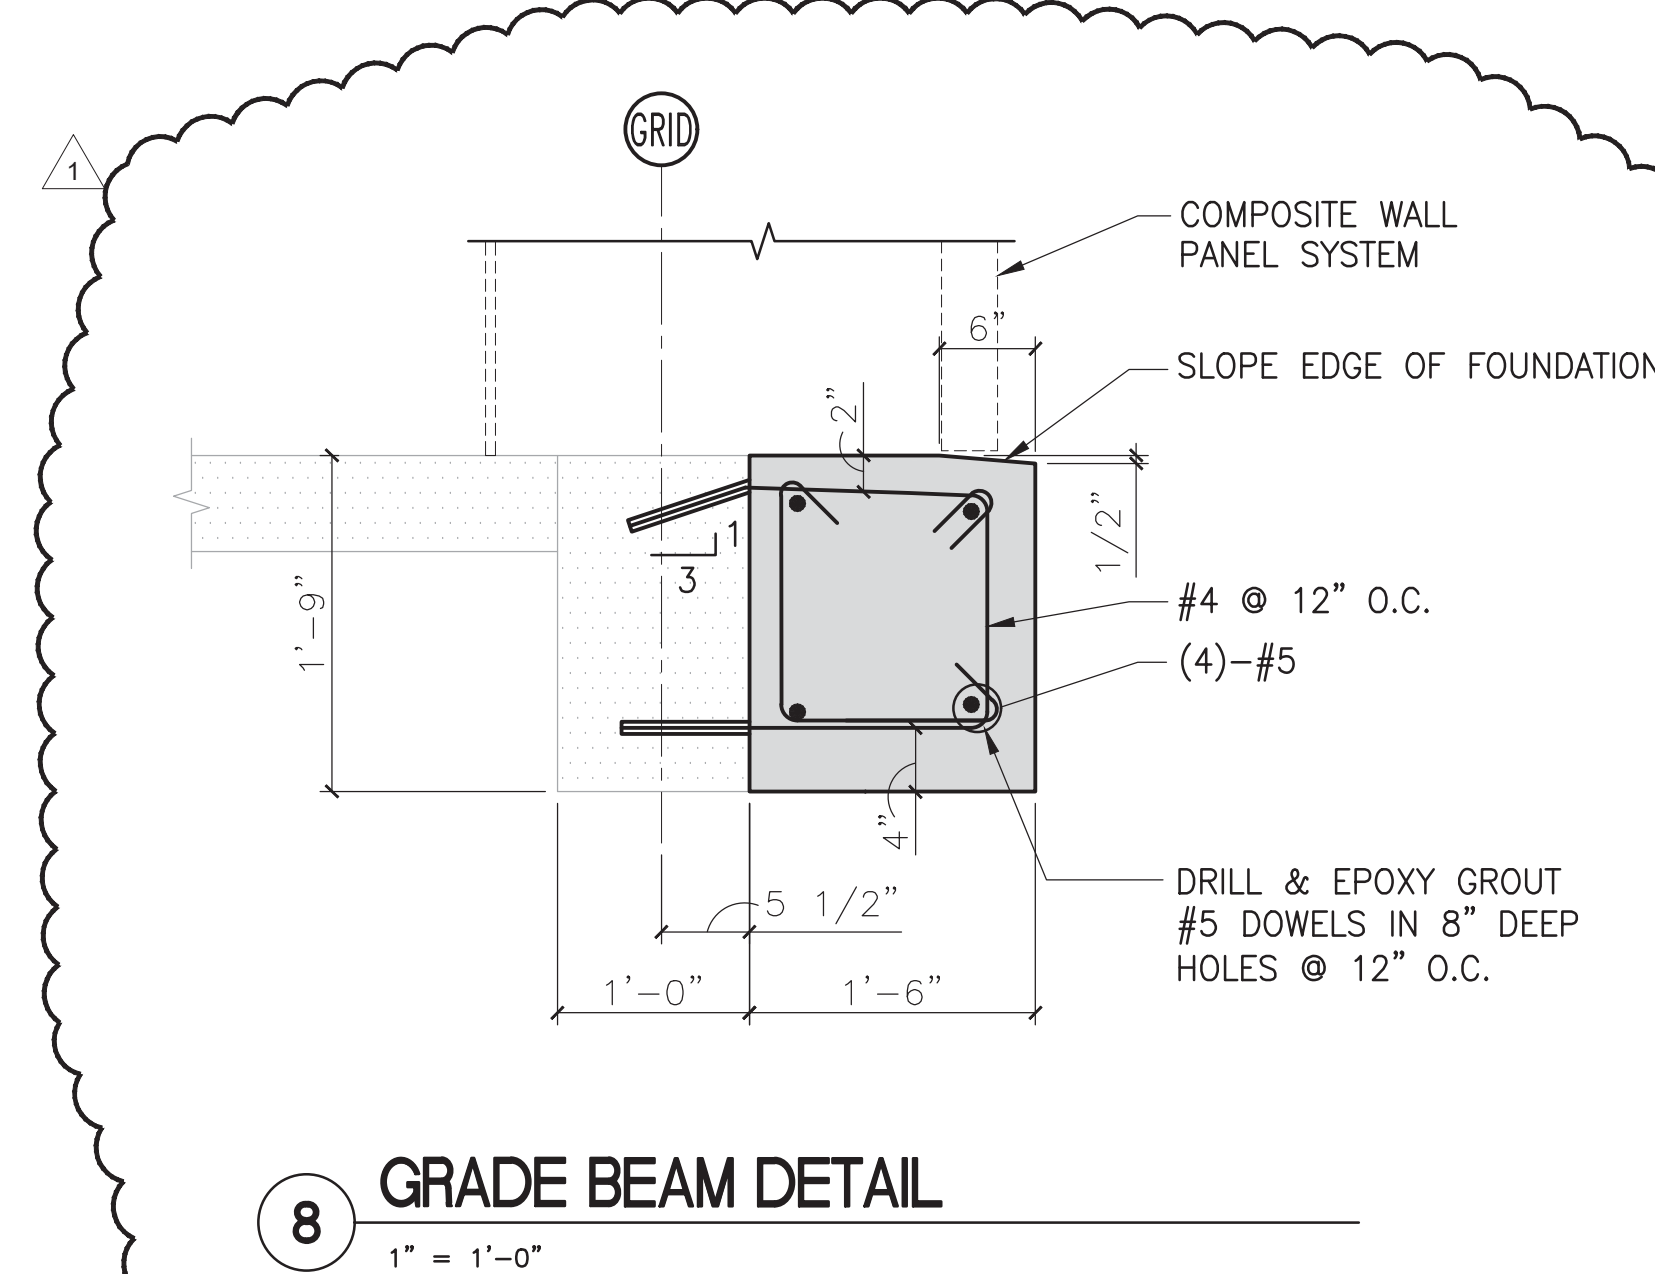


8 GRADE BEAM DETAIL
1" = 1'-0"

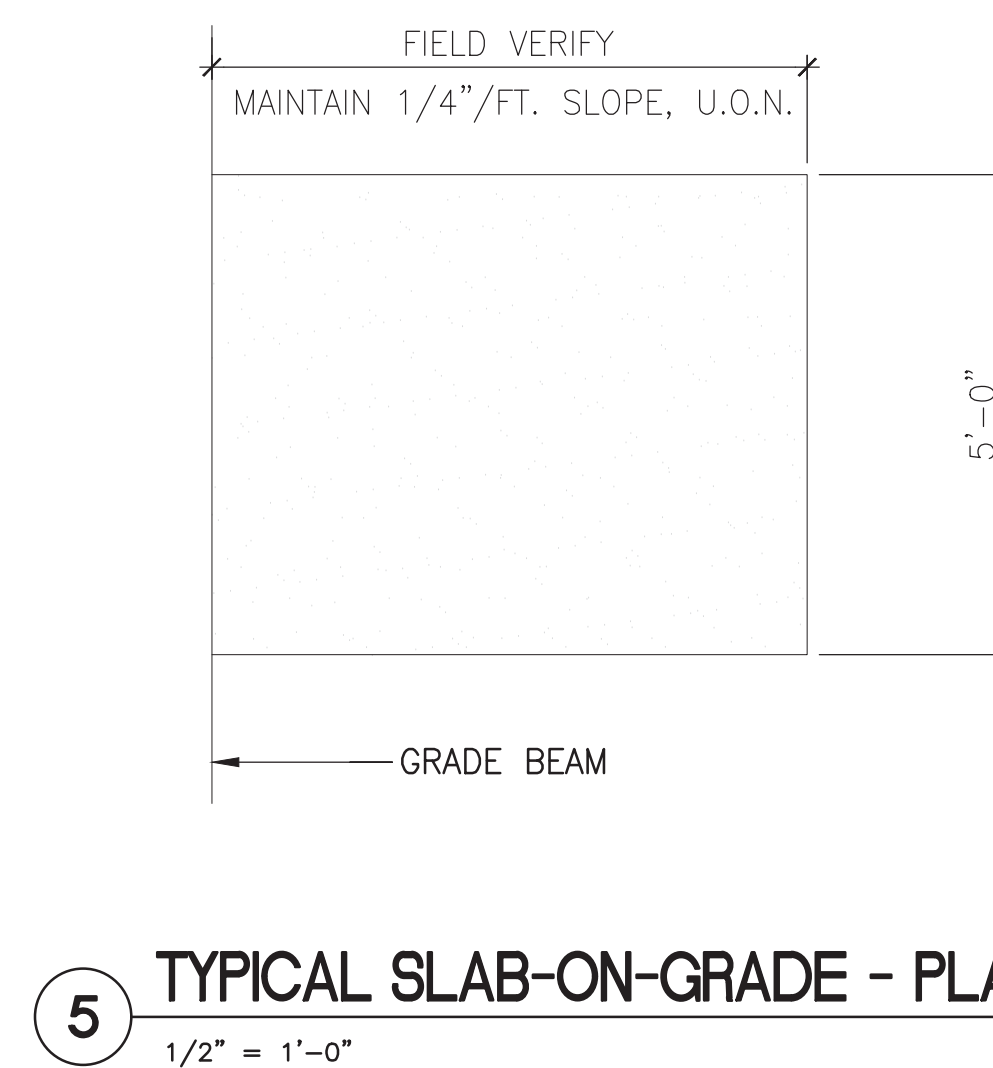


5 TYPICAL SLAB-ON-GRADE - PLAN VIEW
1/2" = 1'-0"

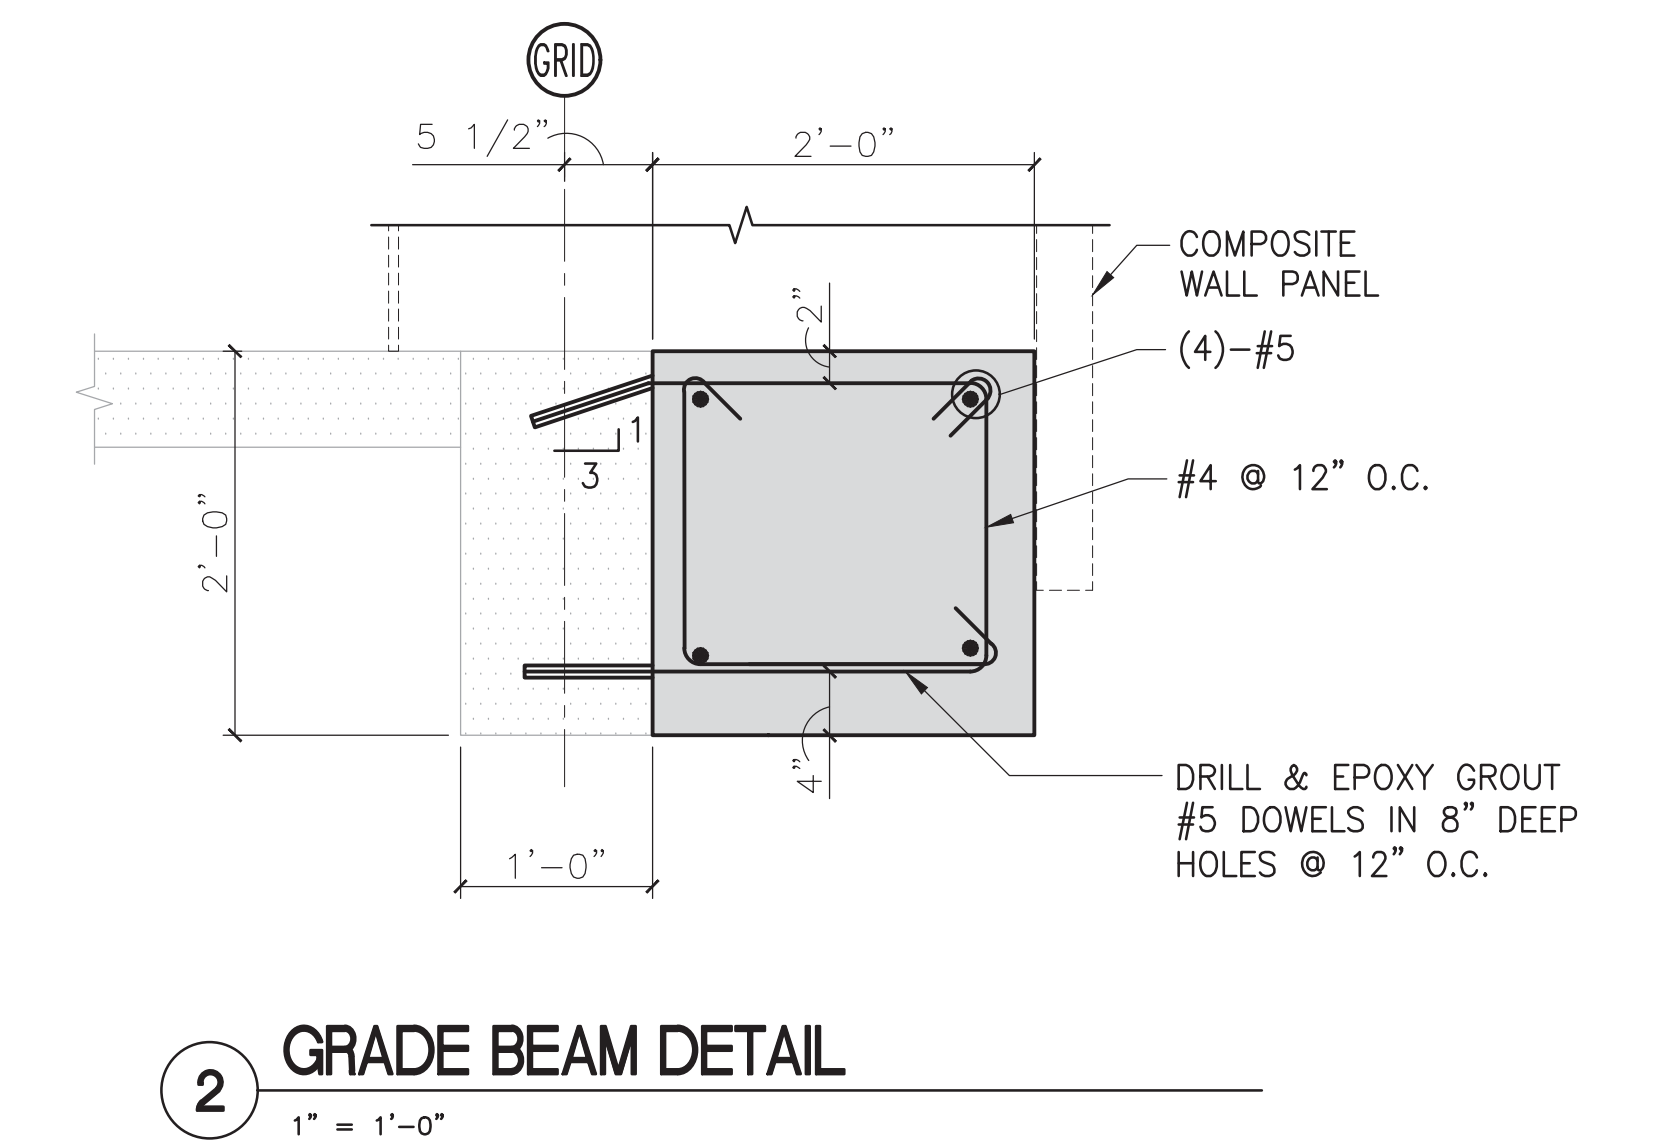


2 GRADE BEAM DETAIL
1" = 1'-0"

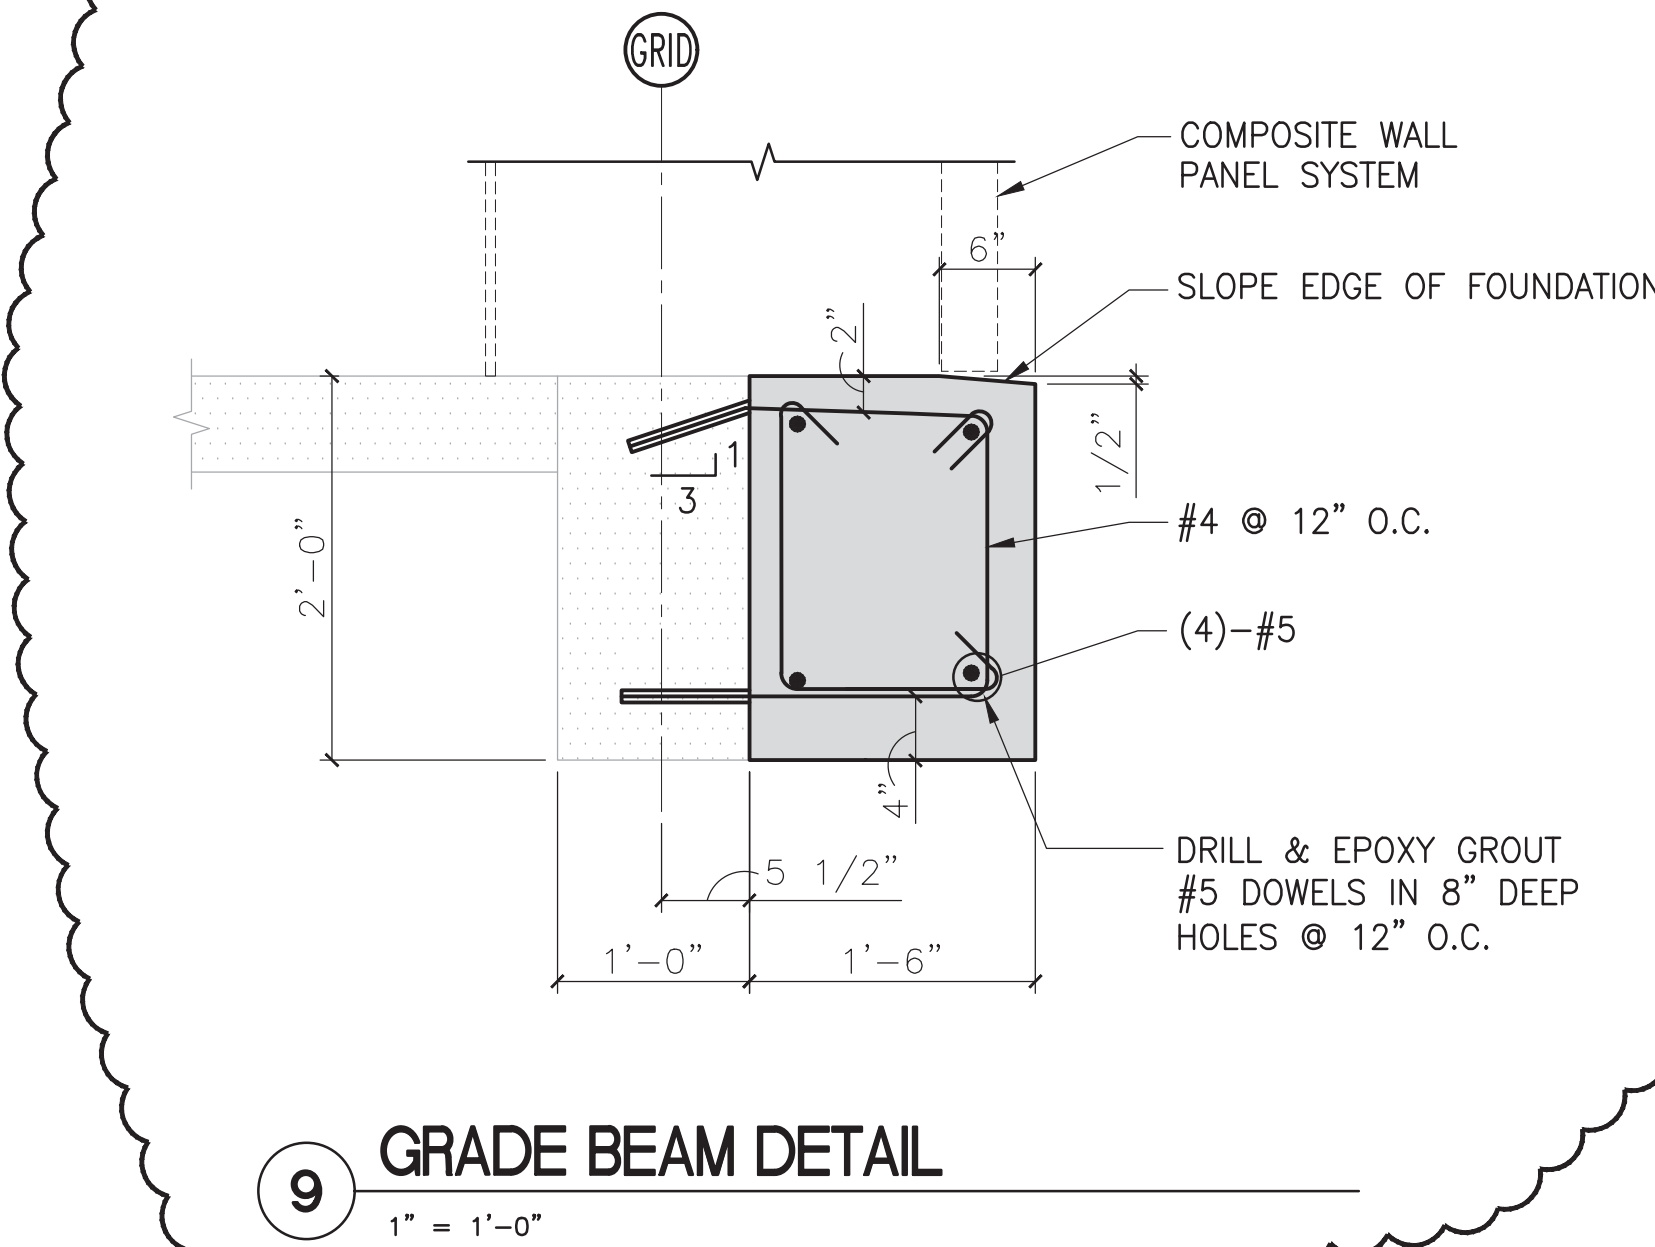

9 GRADE BEAM DETAIL
1" = 1'-0"

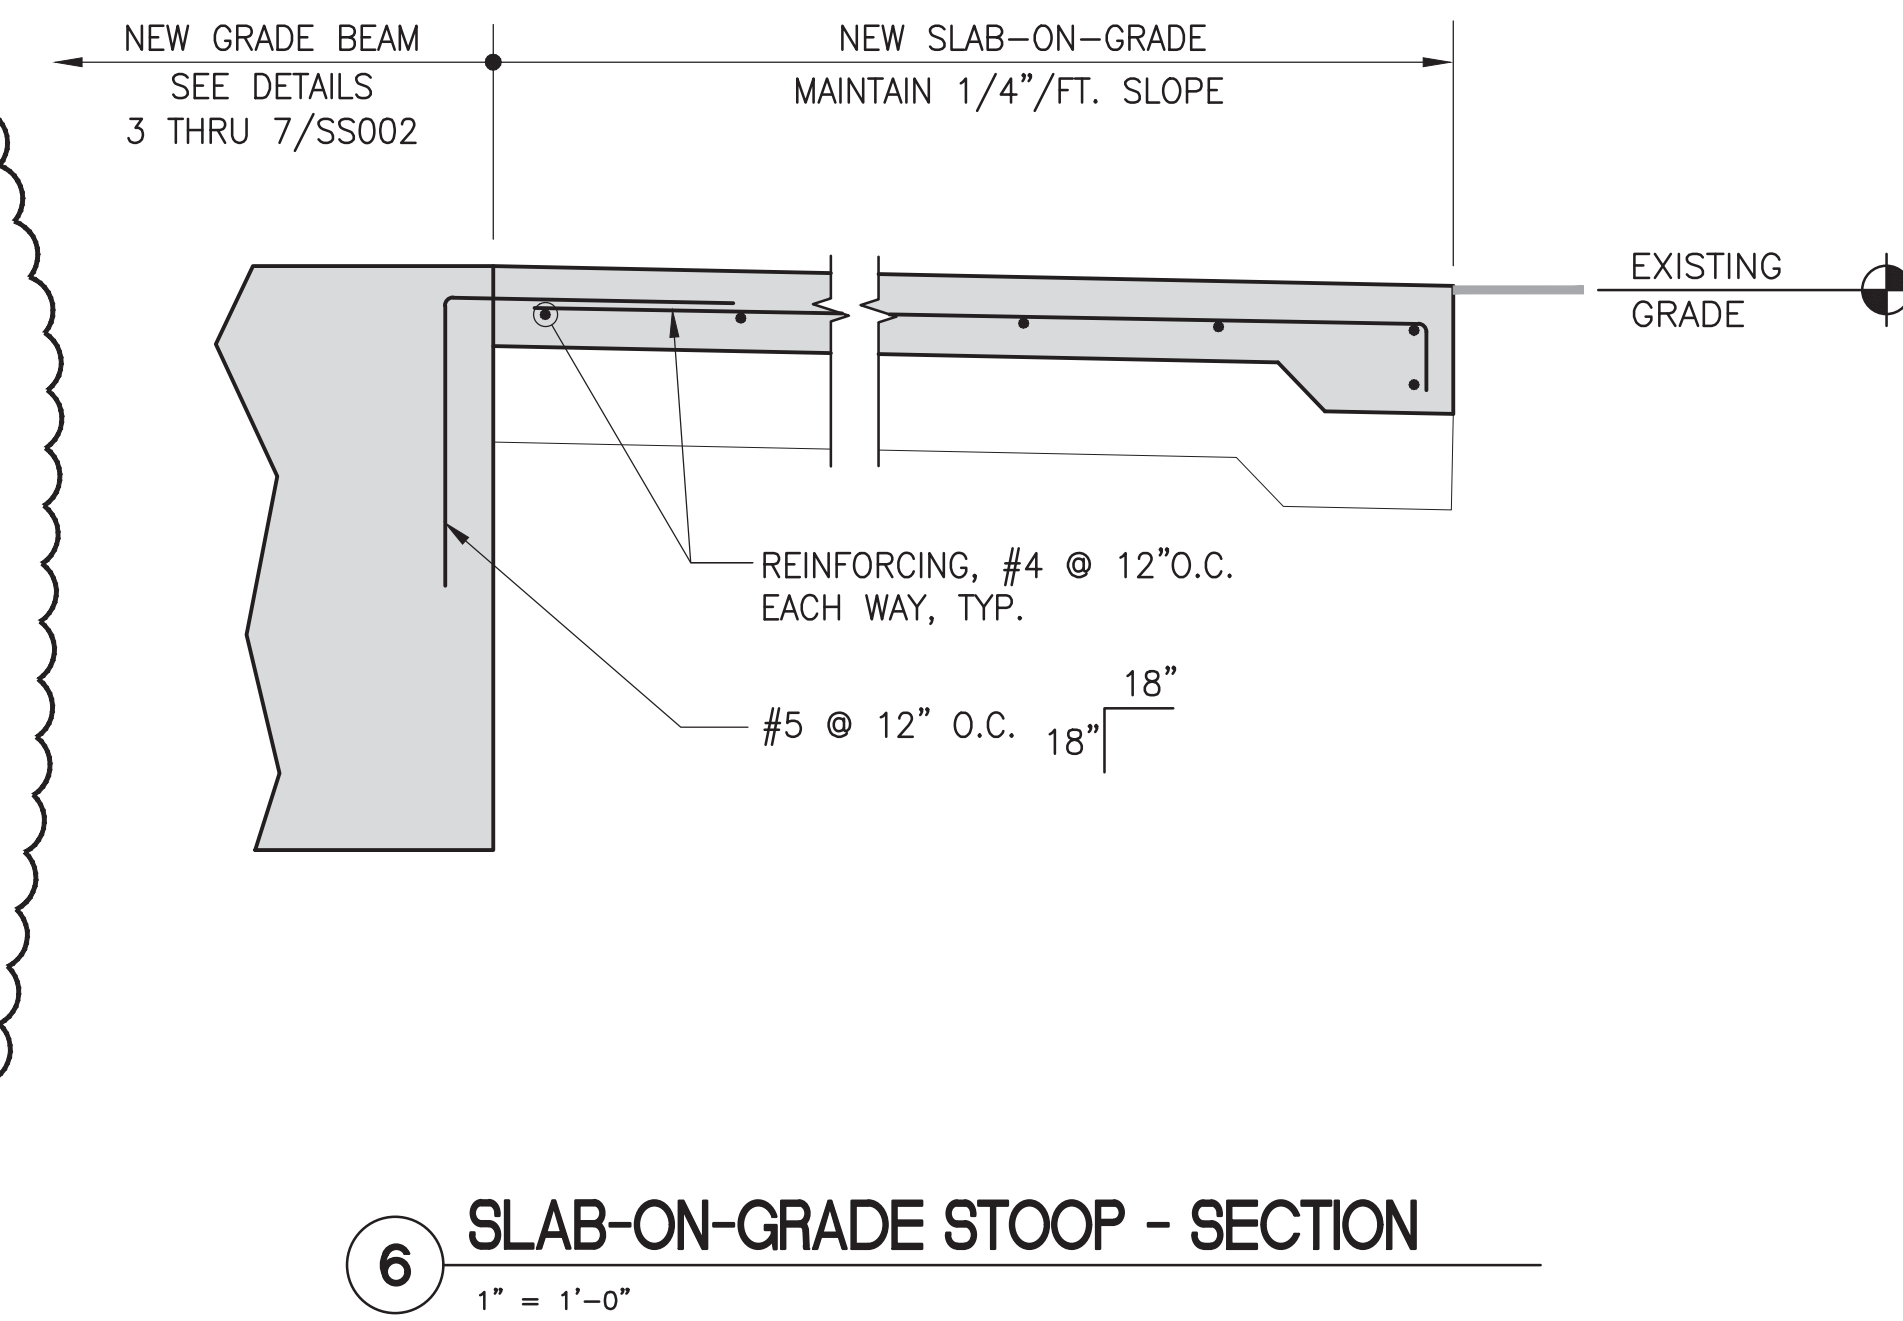

6 SLAB-ON-GRADE STOOP - SECTION
1" = 1'-0"

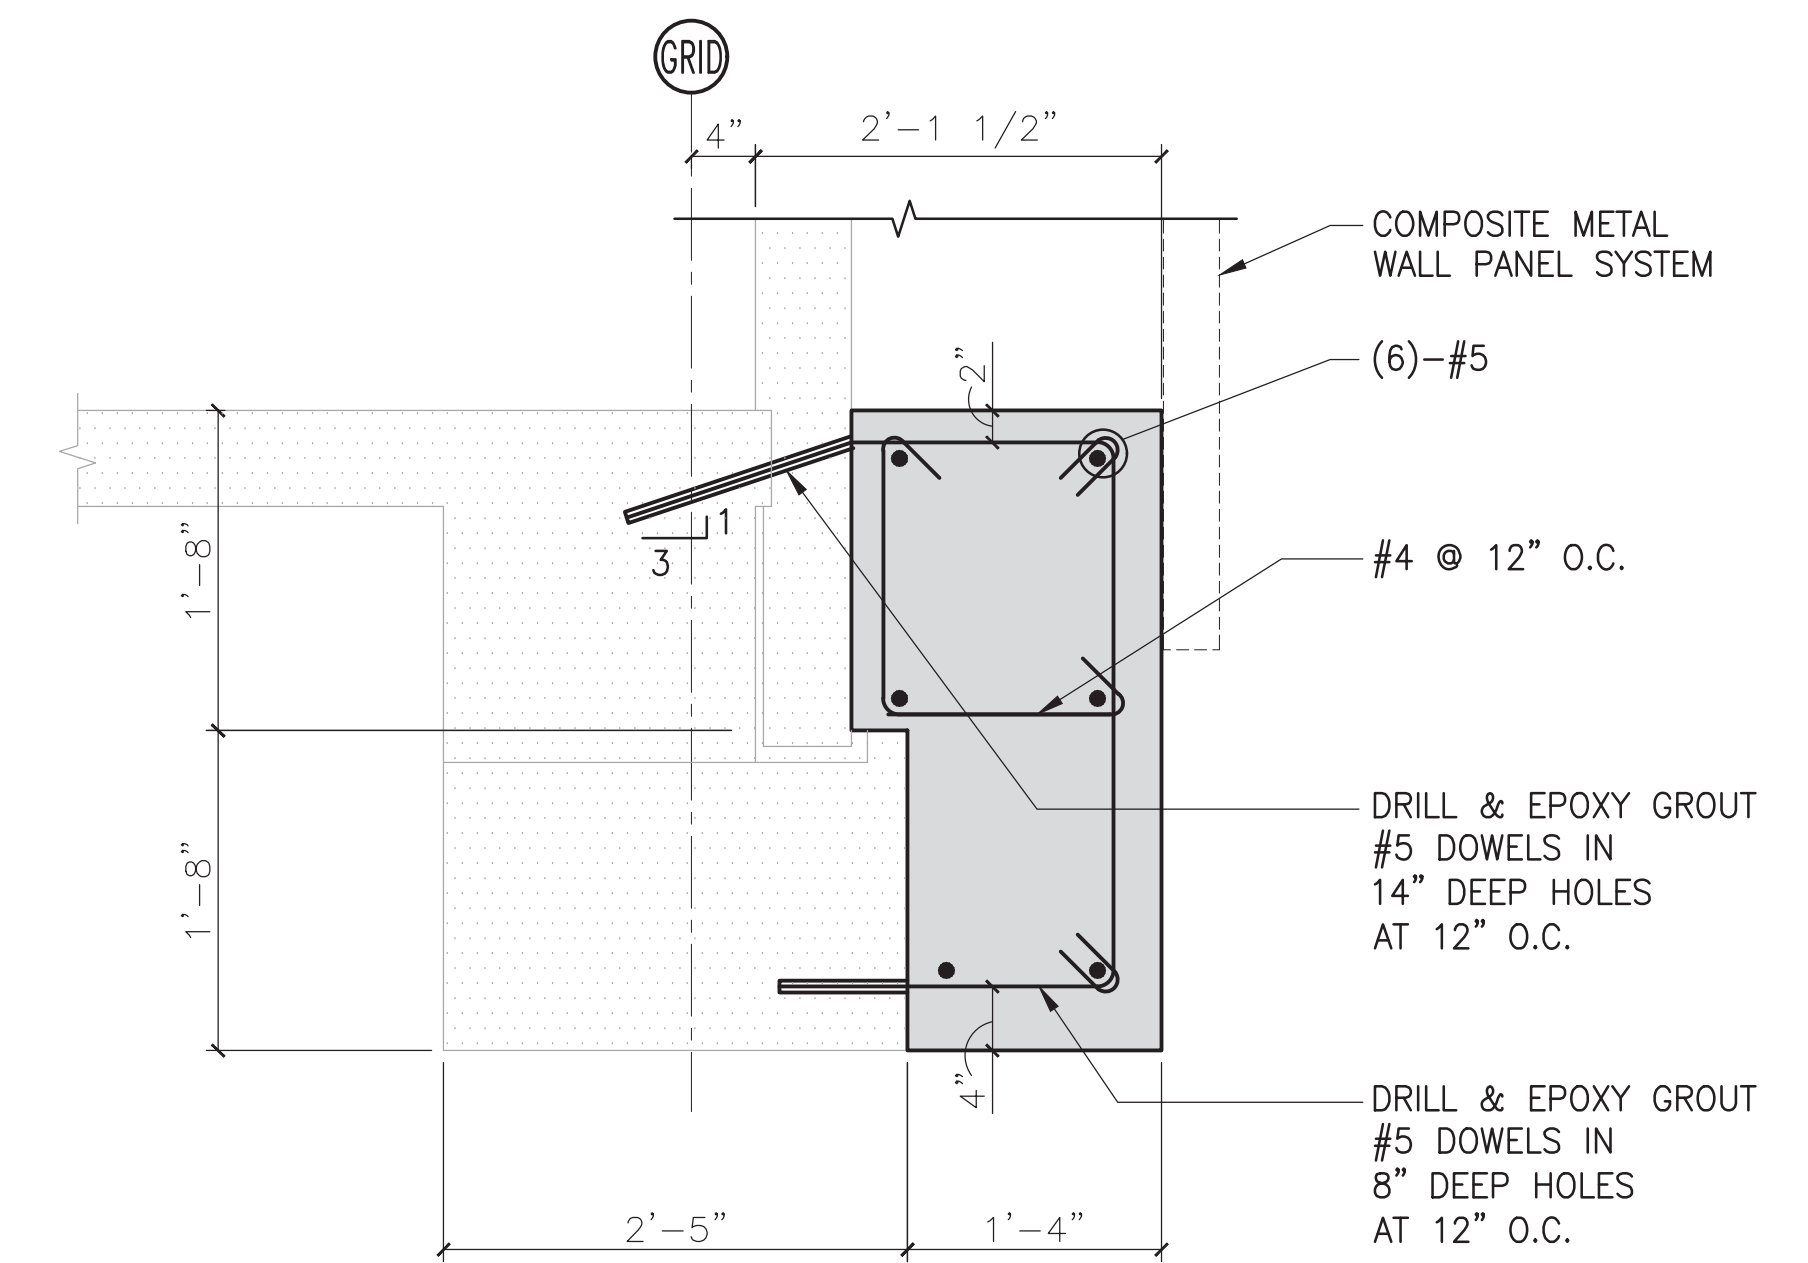

3 GRADE BEAM DETAIL
1" = 1'-0"

100% CONSTRUCTION DOCUMENTS