

SCHEDULE - DOORS


Door	Room		Door				Frame	Frame	Frame	Hardware	Assembly		
Number	#	Room Name	Size	Type	Material	Finish	Glass	Material	Type	Finish	Group	Rating	Notes
BUILDING 401													
1175.1	1175	CANTEEN	3'-4"W x 7'-0"H		STL	PA		STL		PA	5	20 MIN	1
1175.2	1175	CANTEEN	14'-0"W x 7'-8"H		ALUM/GL	PA		ALUM		PA	13		2
BUILDING 403													
1360.0	1360	OPEN OFFICE	3'-6"W x 7'-0"H	A	WD/GL	STAIN		EXIST		PA	3C	20 MIN	3

DOOR SCHEDULE NOTES:

1 TEMPORARY CONSTRUCTION DOOR

2 BY PASS SLIDING AUTOMATIC DOORS - SEE PLAN & ELEVATION DETAILS

3 PHASE 3: NEW DOOR & HARDWARE FINISHES TO MATCH FINISHES OF ADJACENT CORRIDOR DOORS.

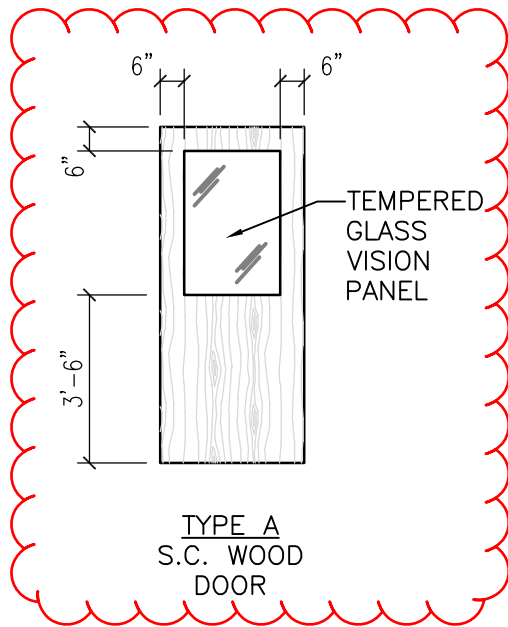

Revisions:	Date:



Dept. of Veterans Affairs
Medical Center
500 East Veterans Street
Tomah, WI, 54660



ELECTRICAL CONSULTANT



231 SOUTH LANSALLE STREET, SUITE 400
O'ROUK, IL 60455
TEL: (708) 444-1100
FAX: (708) 444-1101
WWW.K&JENGINEERING.COM

PROJECT LEADER/ARCHITECT:



ASHLAND, WI
21141 1ST STREET, SUITE 100
ASHLAND, WI 54806
PHONE: (715) 261-1100
FAX: (715) 261-1101
WWW.CHEQUAMEGONBAYENGINEERING.COM

Drawing Title

REVISED DOOR SCHEDULE

Approved: Project Director

Project Title

Renovate Canteen Restaurant

Location: Tomah, Wisconsin

Date: April 13, 2012

Checked By: Drawn By:

100% CONSTRUCTION DOCS

Project Number: 676-12-114
Building Number: 401
Drawing Number: RFI-1

Office of
Facilities
Management