


Revised 02-13-2017

- Fence
- Access Roads
- Gates
- Pedestrian Access/
NON PPE

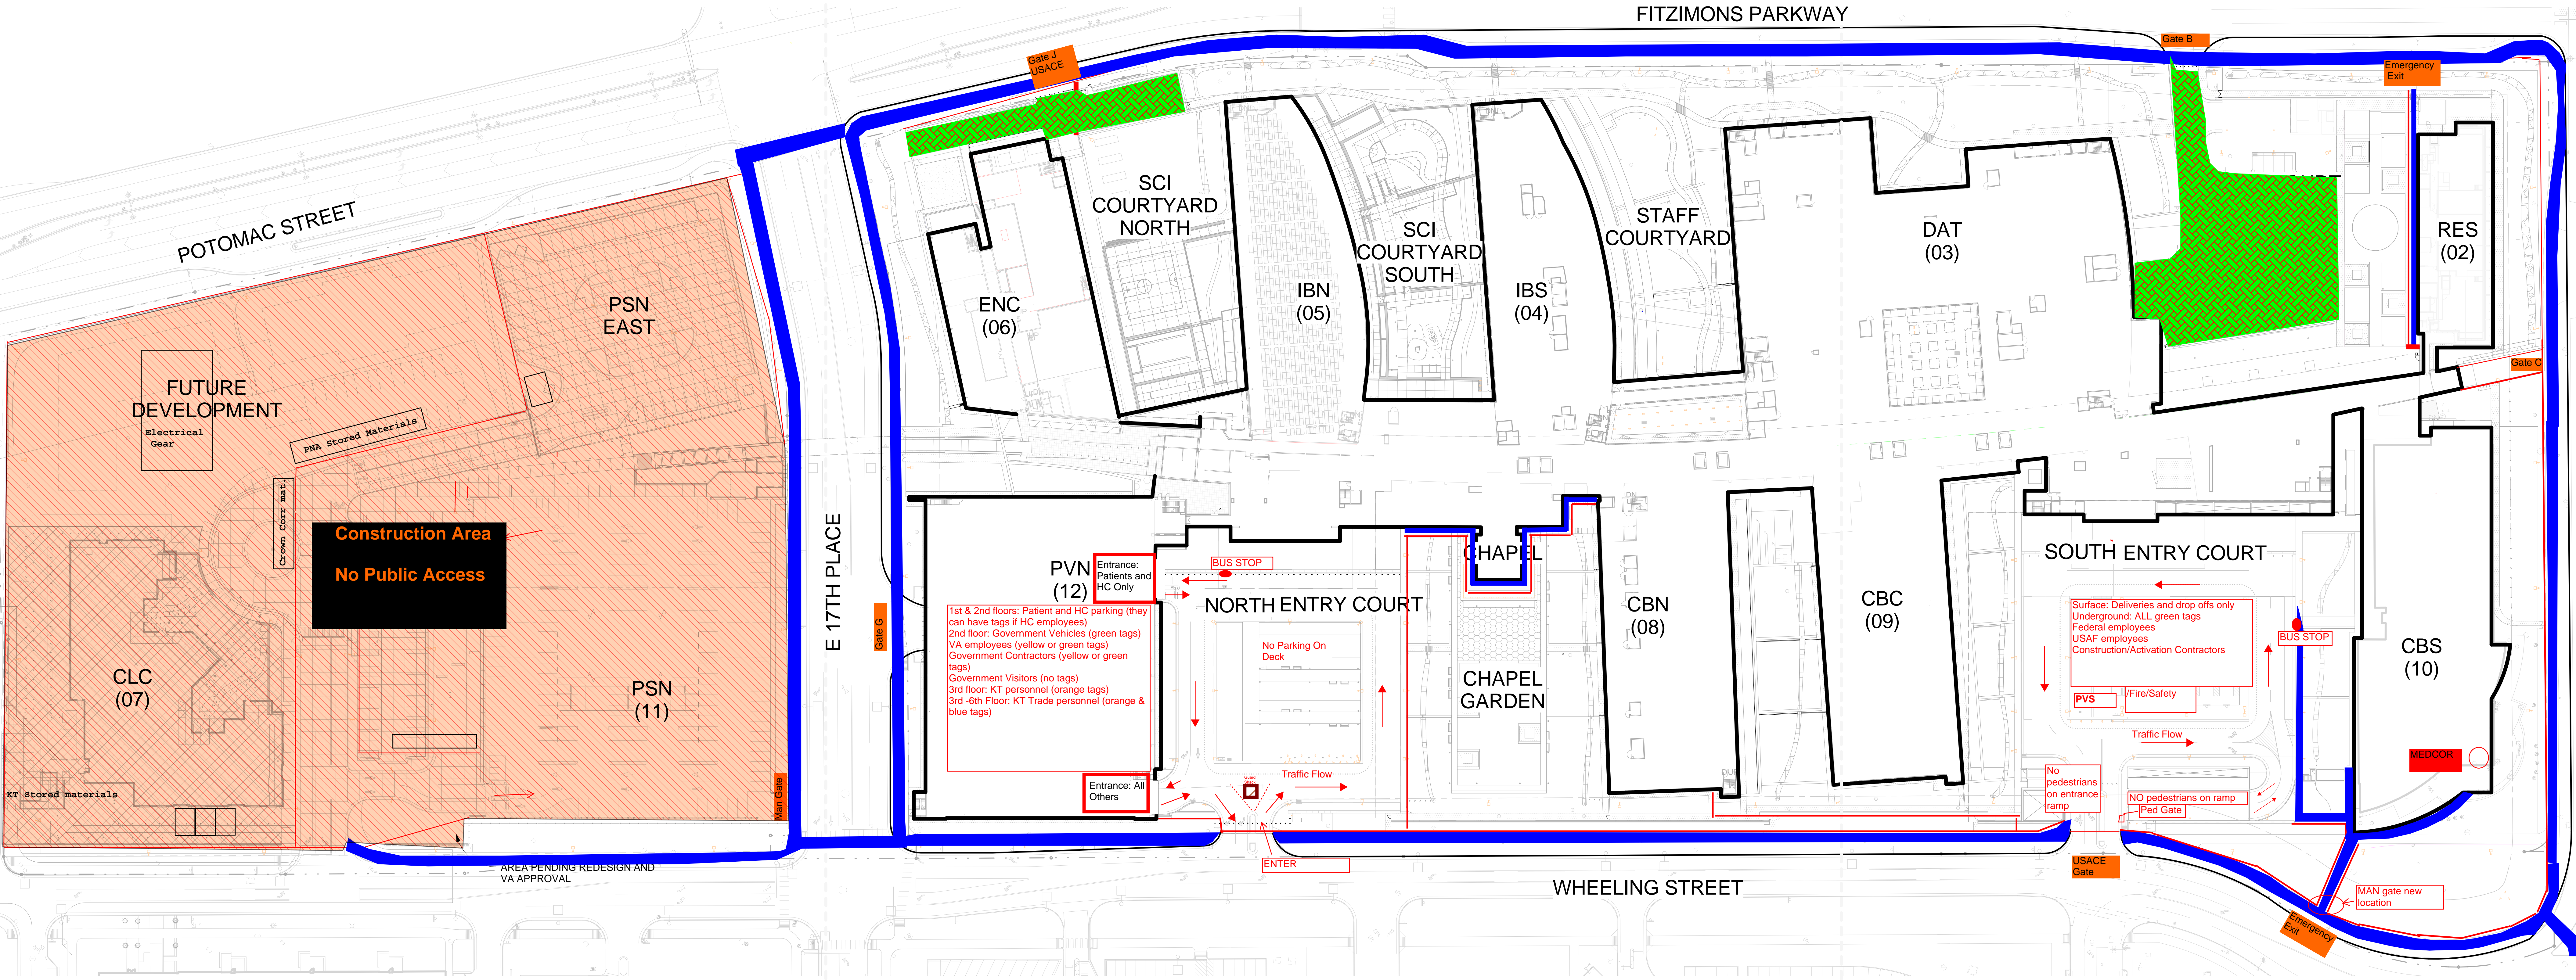

1 OVERALL SITE PLAN
1"=50'-0"

CONSULTANTS:		ARCHITECT/ENGINEERS:		Drawing Title		Project Title		Project Number		Office of Construction and Facilities Management	
TOM LEADER STUDIO		H+L SOM CRA SAM		OVERALL SITE PLAN		REPLACEMENT MEDICAL CENTER FACILITY, EASTERN COLORADO HEALTH CARE SYSTEM		554-501		Department of Veterans Affairs	
1015 Camelia Street, Berkeley, CA 94710 Tel: 510.524.3363		H+L Architecture 1755 Blake Street, Denver, CO 80202		S. A. Miro, Inc. 4582 South Ulster Street Pkwy. Suite 300 Denver, CO 80237		AURORA, COLORADO		Building Number		Drawing Number	
08/31/2012		S. A. Miro, Inc.		Approved: Project Director		Date		00.LS.100		00.LS.100	
Date		Checked		Drawn		08/31/12		Checked		Drawn	