


0
6
three inches = one foot
0
6
one and one-half inches = one foot
2
6
one inch = one foot
2
6
three-quarters inch = one foot
4
6
one-half inch = one foot
4
6
three-eighths inch = one foot
8
6
one-quarter inch = one foot
16
6
one-eighth inch = one foot

NOTE: ROOF STRUCTURE TO BE SLOPED FOR MIN. 1/4" PER FOOT ROOF SLOPE EXCEPT FOR SLOPE OF CRICKETS WHICH ARE ACHIEVED WITH TAPERED ROOF INSULATION; 1/8" FT. MIN. SLOPE AT VALLEYS OF ROOF CRICKETS.

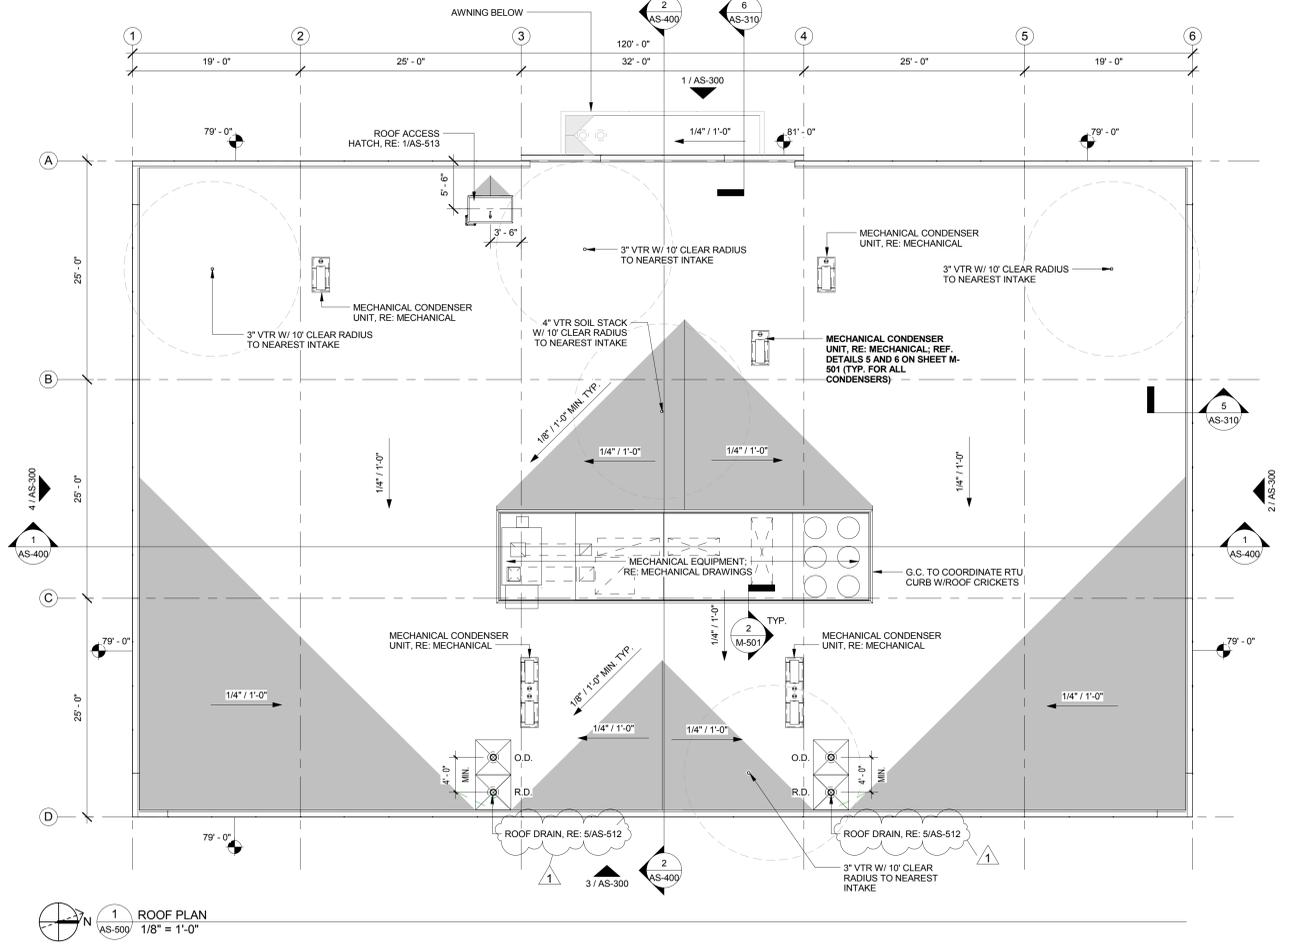

FULLY SPRINKLERED

BID DOCUMENTS

CONSULTANTS STRUCTURAL / CIVIL ENGINEER H2B, INC. 1225 N. LOOP WEST, SUITE 900 HOUSTON, TX 77008 (713) 864-2900		FIRE PROTECTION / TELECOM ENGINEER PAGE 400 W. CESAR CHAVEZ STREET, SUITE 500 AUSTIN, TX 78701 (512) 472-6721		ARCHITECT & M.E.P. ENGINEER  130 8th Street, Suite 303 Austin, TX 78701 (512) 472-6721 spur@spurdesign.com		 27 JUNE 2017		APPROVED: DIRECTOR APPROVED: ASSOCIATE DIRECTOR APPROVED: ASSISTANT DIRECTOR APPROVED: CHIEF ENGINEER		SHEET TITLE ROOF PLAN APPROVED: CHIEF ENGINEER		PROJECT TITLE NEW ADMINISTRATION BUILDING PROJECT LOCATION 2002 HOLCOMBE BOULEVARD HOUSTON, TX 77030		VA PROJECT NUMBER 580-CSI-110 BUILDING NUMBER DRAWING NUMBER AS-500 Dwg. 46 OF 95		 Office of Construction and Facilities Management  U.S. Department of Veterans Affairs	
1 Revision # Date 7/27/17		TX ARCH REGISTRATION NO. BR 2171 TX ENGR REGISTRATION NO. F-17591		DATE 06-27-17		CHECKED SAC		DRAWN MEB		VA FORM 08-6231							