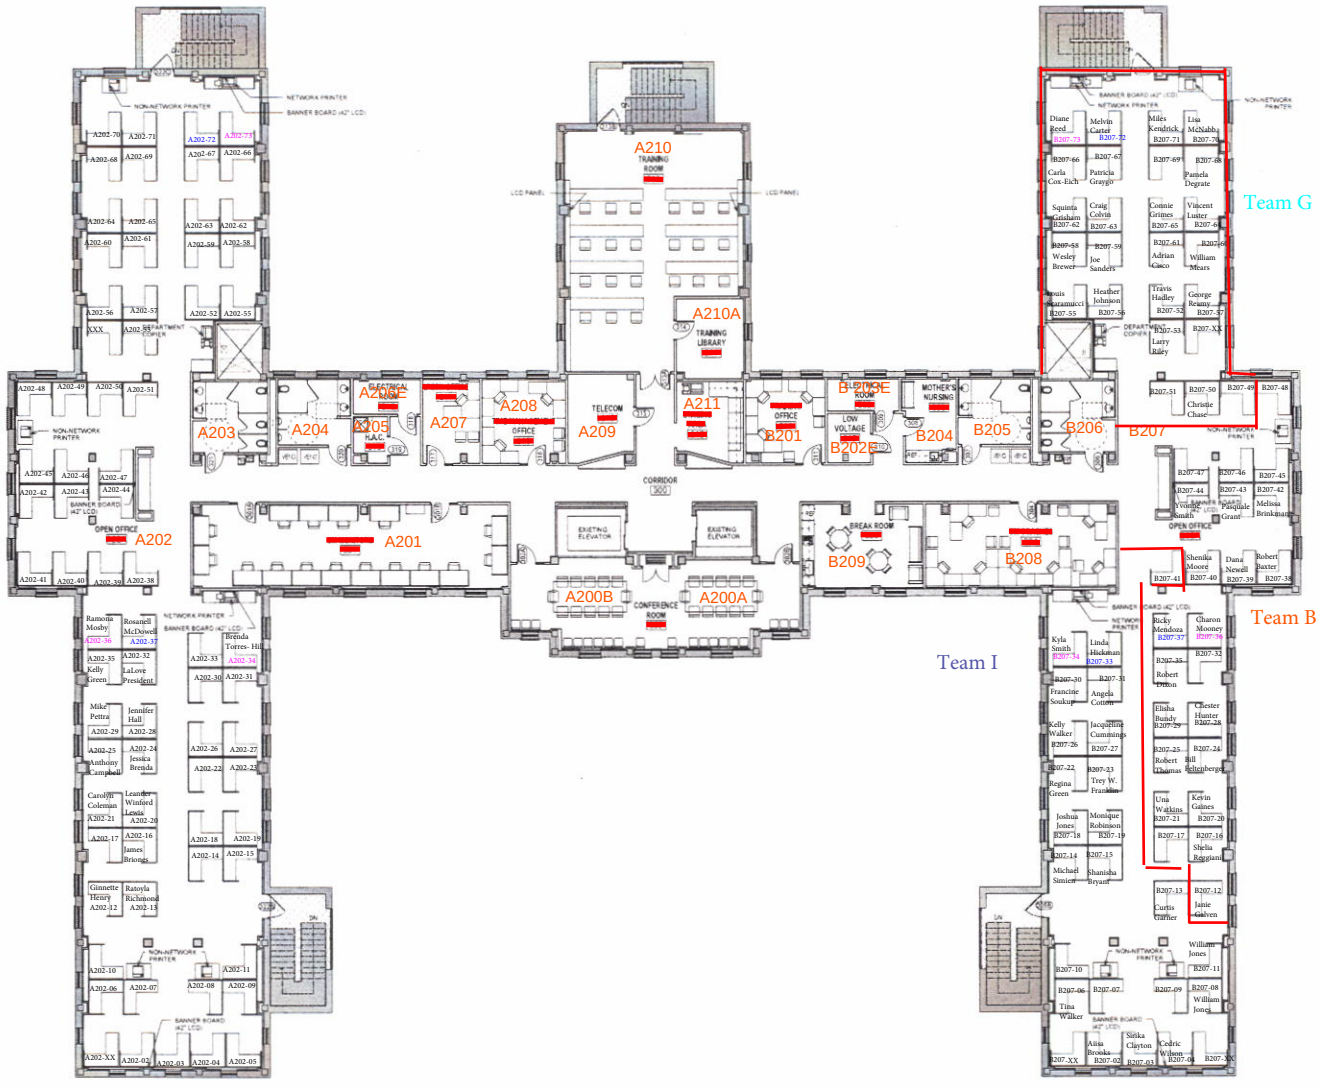

1 FURNITURE PLAN - SECOND FLOOR (REFERENCE ONLY)

NOTE: FURNITURE PLANS INCLUDED FOR REFERENCE ONLY - FF&E NOT IN CONTRACT

TRUE NORTH PLAN NORTH

Revisions / Date	CONSULTANTS:	March 31, 2010	ARCHITECT/ ENGINEERS PFLUGER WIGINTON HOOKER, PLLC ARCHITECTS / PLANNING CONSULTANTS 500 N. Central Expressway Suite 300, Plano, Texas 75074 P: 972.665.0657 F: 972.665.0656	DRAWING TITLE: FURNITURE PLAN - SECOND FLOOR PROJECT MANAGER	Project Title: HRC PHARMACY CUSTOMER CARE CENTER TASK ORDER NO. 0001 Location: 4800 MEMORIAL DRIVE WACO, TEXAS 76710 Date: MARCH 31, 2010	Project Number: 674A4-10-222 Building Number: 90 Drawing Number: AF1.02	CENTRAL TEXAS VETERANS HEALTHCARE SYSTEM Department of Veterans Affairs