FRAME KEYNOTES

NUMBER	DESCRIPTION
1	DOOR - SEE DOOR SCHEDULE
2	HOLLOW METAL FRAME
3	GYPSUM WALLBOARD
4	METAL STUD - SEE PARTITION TYPES
5	BATT INSULATION
6	SEALANT
7	JAMB ANCHOR - 3 PER FRAME
8	CONCRETE MASONRY UNIT (CMU)
9	STEEL LINTEL - REFER TO STRUCTURAL DRAWINGS
10	WINDOW GLAZING
11	HOLLOW METAL STOP
12	FLASHING TIE INTO AIR/VAPOR BARRIER
13	CMU BOND BEAM
14	AIR/VAPOR BARRIER - TIE INTO OPENINGS
15	DRAINABLE 4" EXTERIOR INSULATION FINISHING SYSTEM
16	SHIM AS REQUIRED
17	SEALANT AND BACKER ROD
18	BRICK VENEER
19	RIGID INSULATION

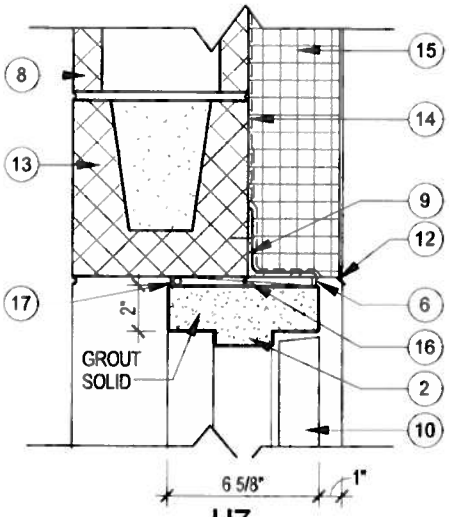

H7

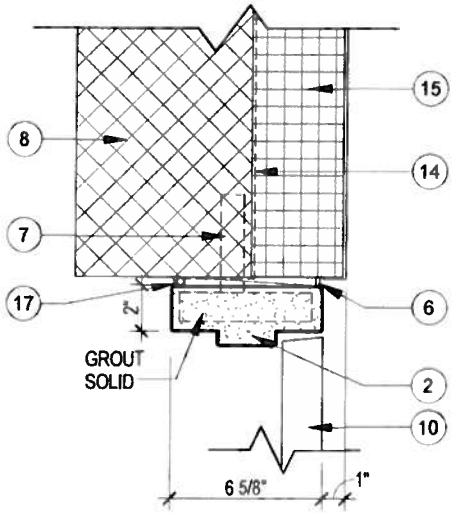

J7

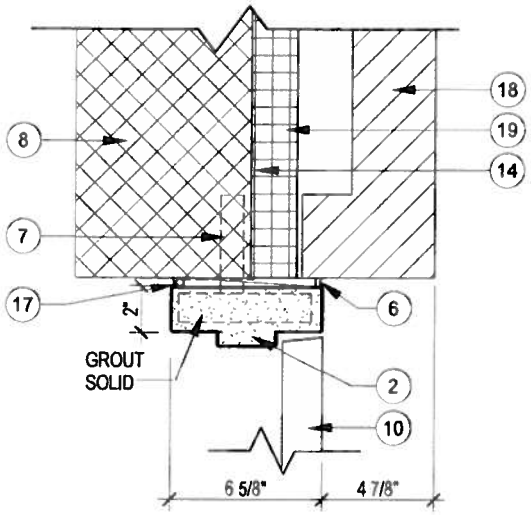

J8

4 HOLLOW METAL DETAILS-SD1

1 1/2" = 1'-0"

ADD DETAILS TO 4/A601

PROJECT:
Construct a New Residential Rehabilitation Treatment Program (RRTP) Building

PROJECT # 512-531

AE WORKS
6587 HAMILTON AVENUE
PITTSBURGH, PA 15206
PH: 412.287.7333 www.ae-works.com

DRW / CHK: SB / RW
SCALE: AS NOTED

SUPPLEMENTAL DRAWING
SD-A01

© AE Works Ltd. 07/26/17