

**IMAGE**  
**Group**  
Architecture  
& Interiors

June 15, 2012

**AMENDMENT NO. 1**

VA Medical Center  
Replace Utility Mains and Asphalt  
Phase 1 & 7  
Fargo, ND

Richard  
Moorhead  
AIA, NCARB

A. Refer to the DRAWINGS of the above project and make the following additions, deletions, corrections and/or interpretations.

1. Refer to Phase 7 Utility Plan C7.2 and Paving Plan C7.4 and REVISE the east access road water main connection and paving as indicated on attached Civil Revision Drawings R1/C7.2 and R2/C7.4.

Carter  
Sharff  
RA, NCARB

- END OF AMENDMENT NO. 1 -





Marcia  
Pulczynski  
AIA, NCARB,  
LEED AP

403 Center  
Avenue  
Suite 300  
Moorhead  
Minnesota  
56560

Telephone  
218.233.2062

Facsimile  
218.233.2575

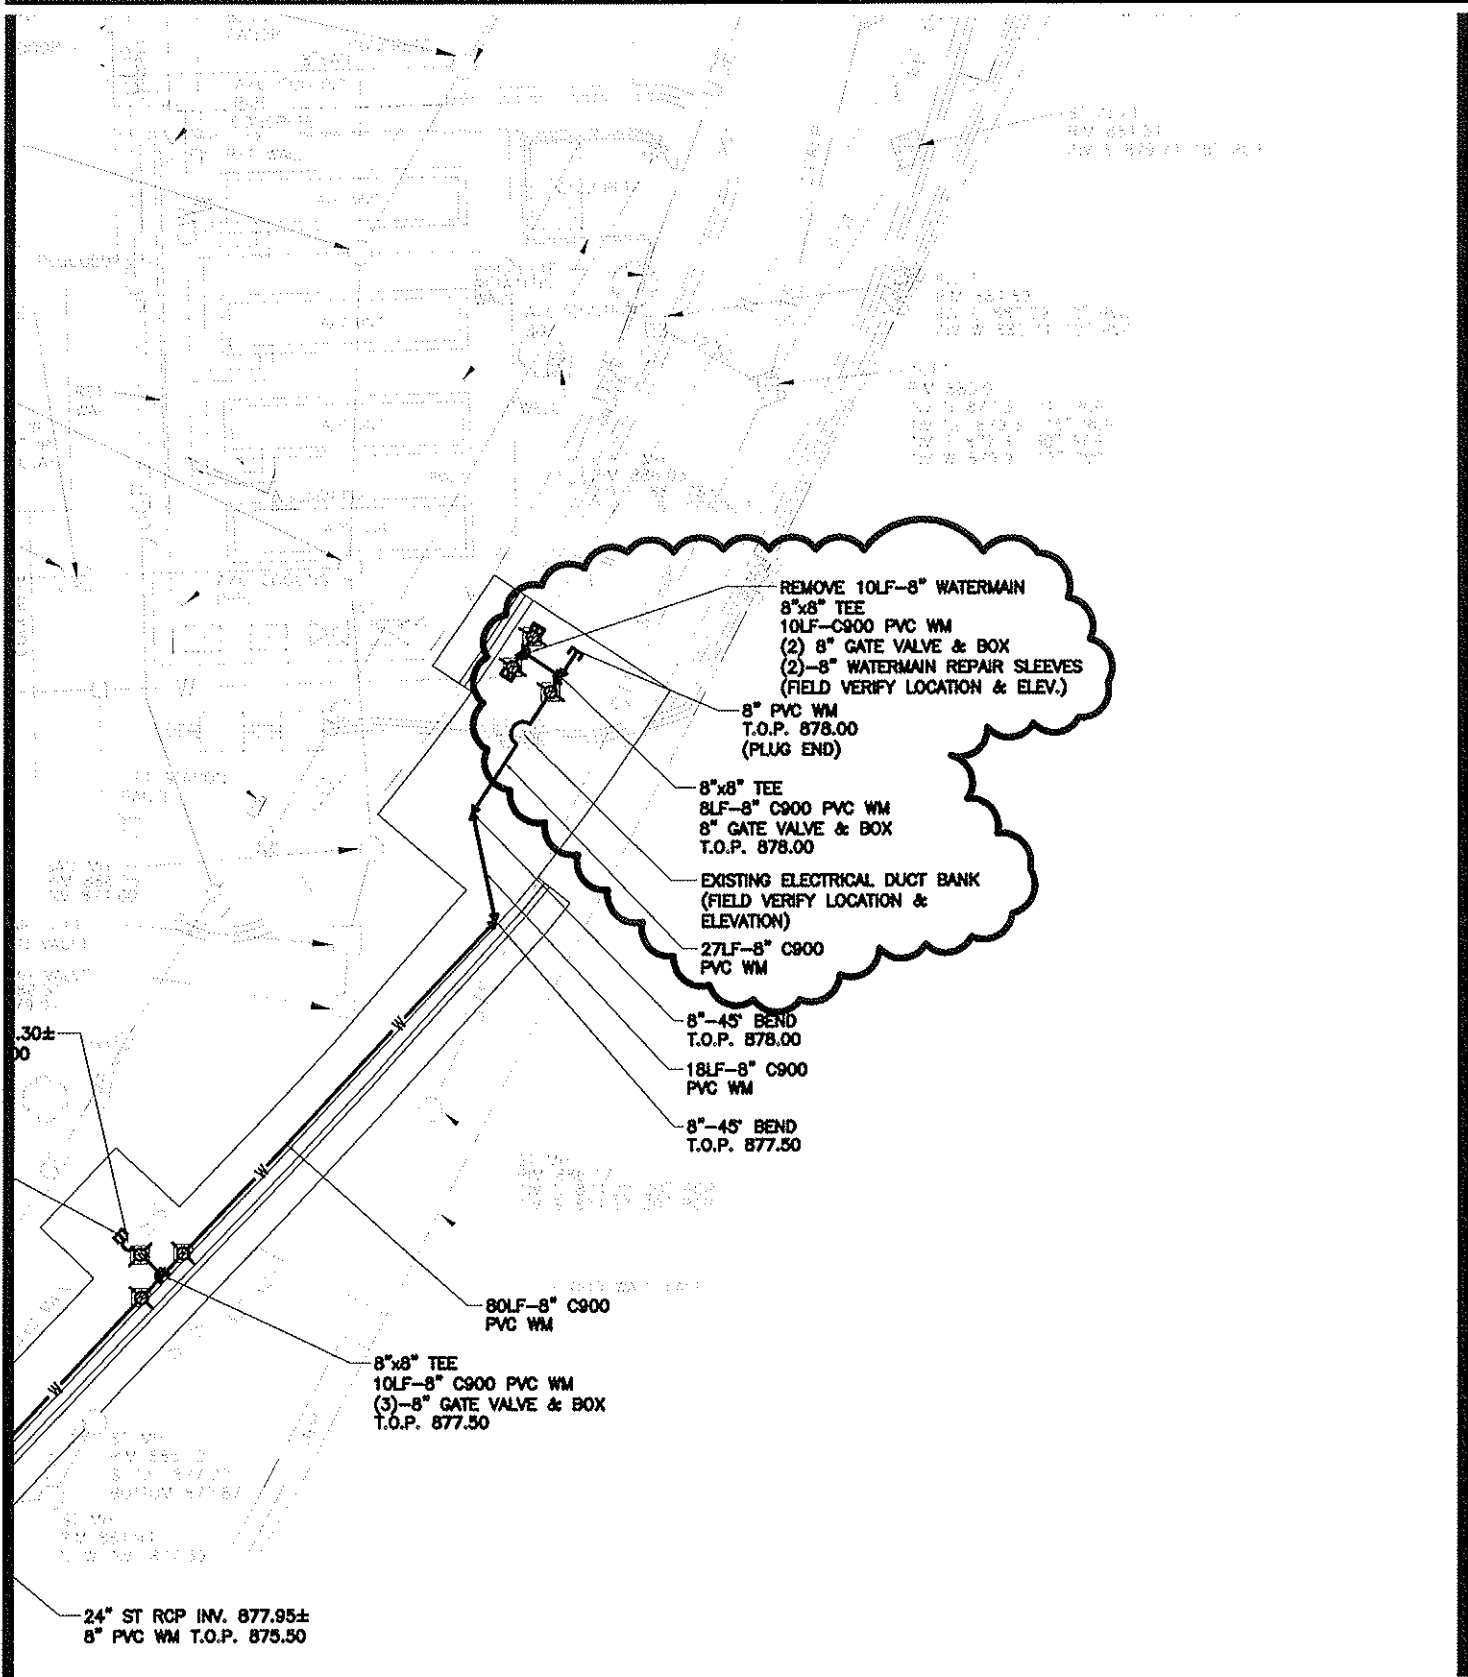

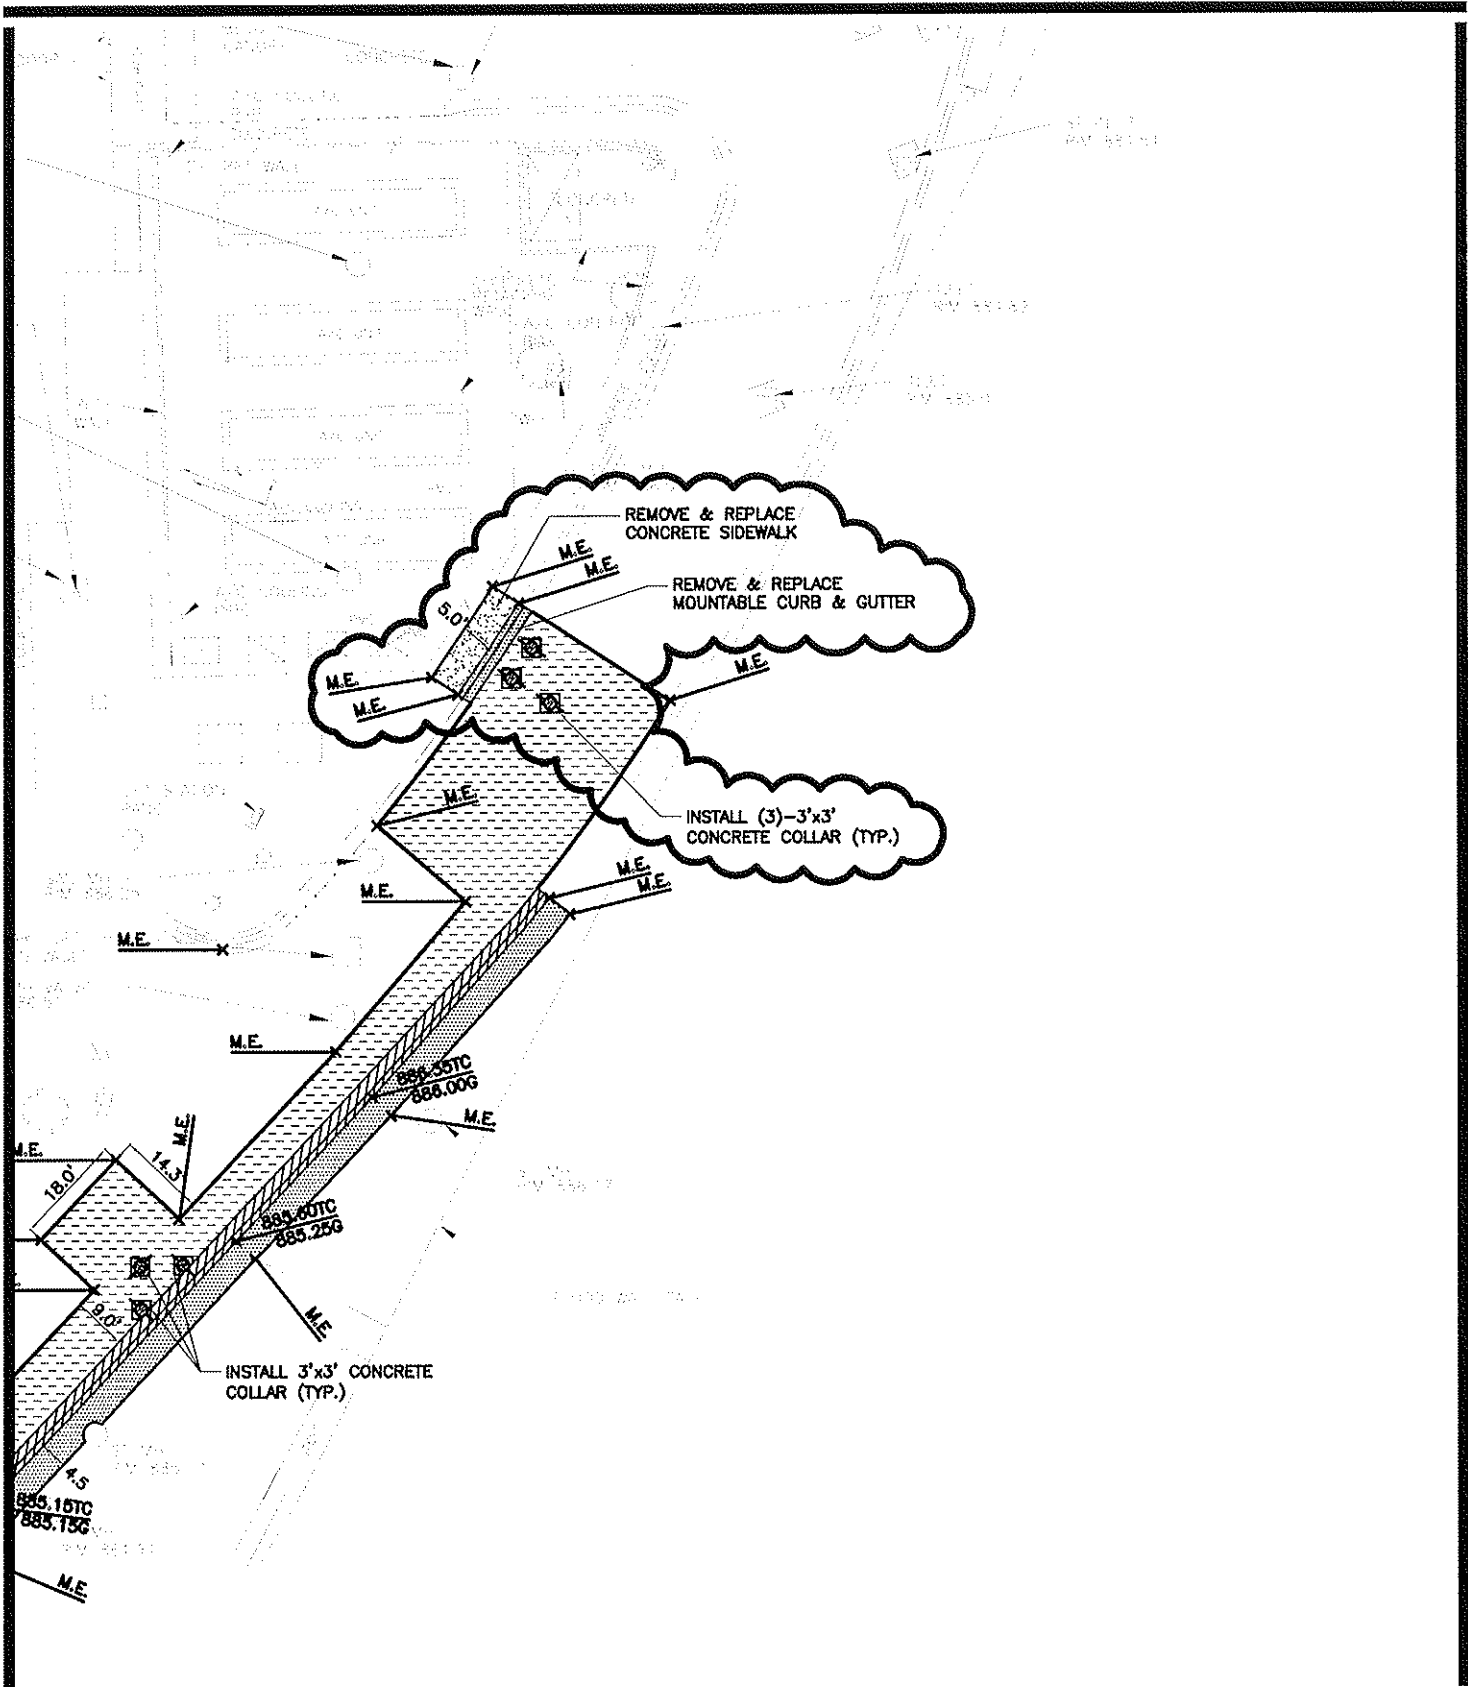

VA MEDICAL CENTER  
 REPLACE UTILITY MAINS AND ASPHALT  
 REVISIONS TO PHASE 7 PAVING  
 FARGO, NORTH DAKOTA

MBN JOB #: 11-110  
 REVISION DATE: 6-13-12

R2  
 C7.4

**MBN**  
 ENGINEERING  
 MECHANICAL • ELECTRICAL • CIVIL  
 503 7TH ST. N  
 SUITE 200  
 FARGO, ND 58103  
 PHONE: 701.476.6336  
 FAX: 701.476.6340