





## 12/30/16



**2016.12.December / Basement / Area A -**

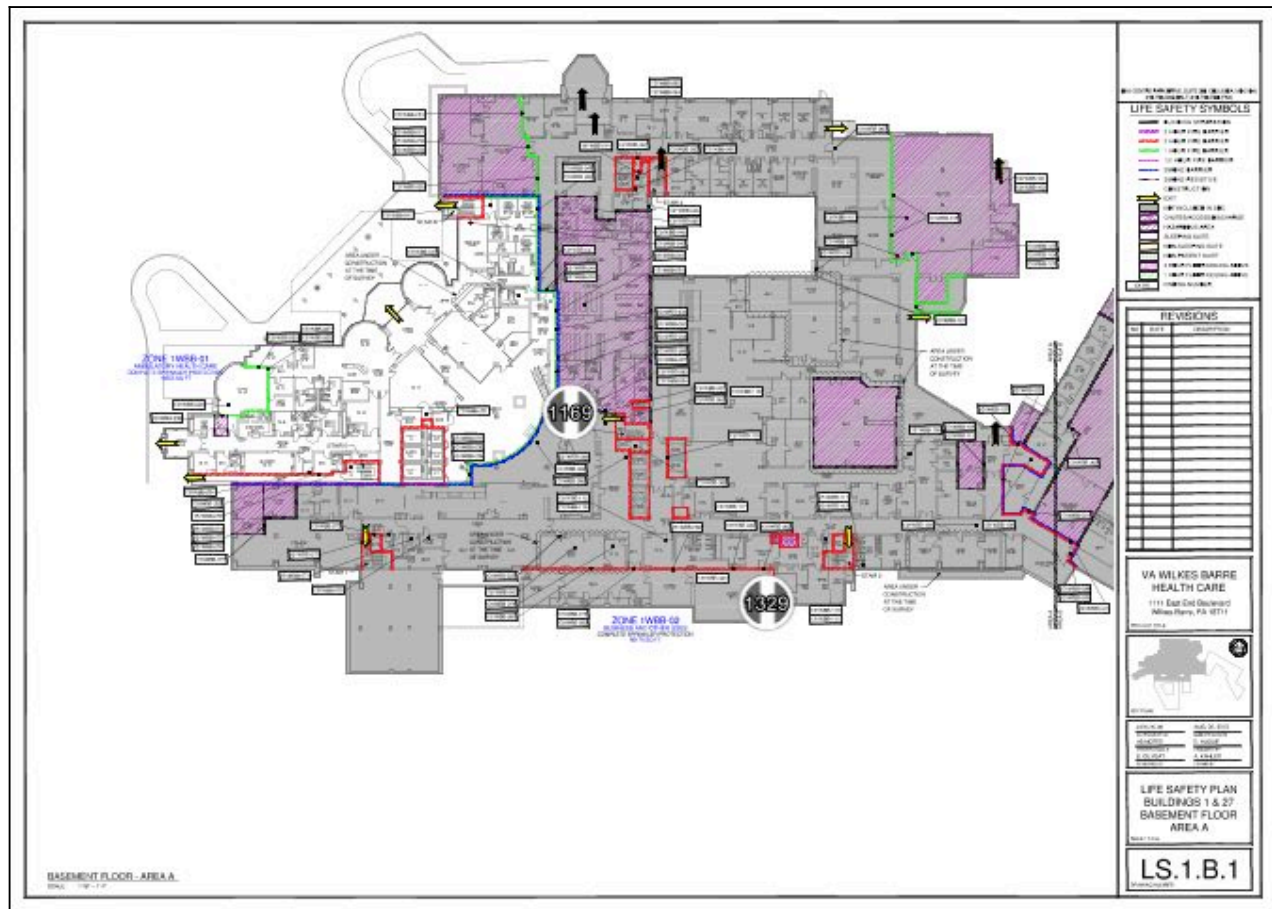



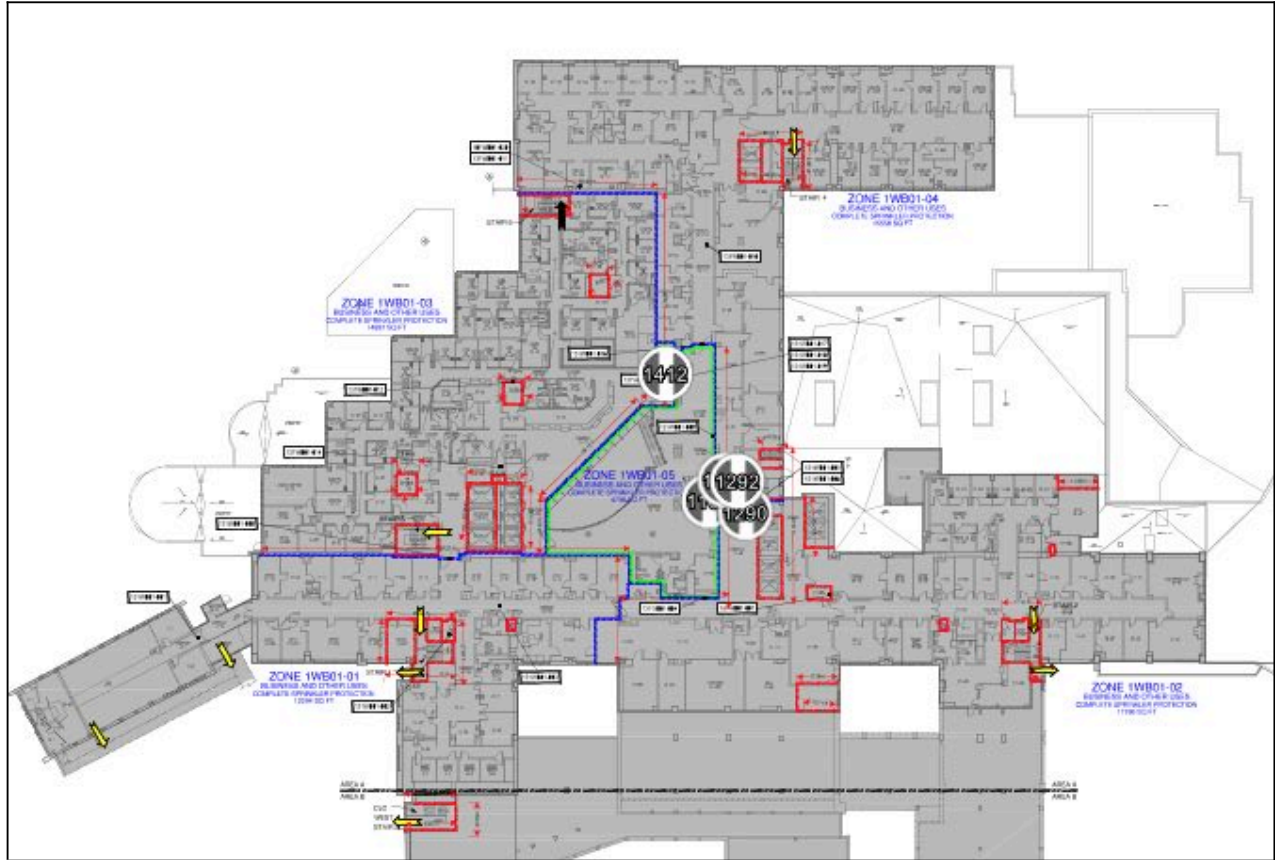


Date Created	EOCS ID #	Punch #	Full Plan View	Room Number	Item	Type	Wall Material	Fire Rating	Comments
3/28/16	304579	1169	2016.12.December / Basement / Area A	Double Door	Large Opening	Joints	Gypsum	1 Hour	Previously under construction last inspection. 12 ft HOW
<div>  </div> <div> <div>3/28/16 10:50 AM</div> <div>3/28/16 10:50 AM</div> </div>									
9/1/16	343255	1329	2016.12.December / Basement / Area A	CB11	Large Opening	Sections of walls missing	Gypsum	2 Hour	2.5X1.5 section of sheet rock missing DOD-3
<div>  </div> <div>9/1/16 01:19 PM</div>									

## 2016.12.December / Floor 01 / Area A -







Date Created	EOCS ID #	Punch #	Full Plan View	Room Number	Item	Type	Wall Material	Fire Rating	Comments
3/28/16	306125	1168	2016.12.December / Floor 01 / Area A	N1-144	Large Opening	Large wall with penetrations	Concrete	1 Hour Smoke Zone Barrier	7'x2' gypsum repair, studs already in place, dod:2 previously under construction last inspection
<div>   </div> <div> <div>3/28/16 07:18 AM</div> <div>10/3/16 09:00 AM</div> </div>									
6/10/16	325101	1290	2016.12.December / Floor 01 / Area A	Electrical room next to elevator lobby	Large Opening	Large wall with penetrations	Concrete	2 Hour	Deteriorating block with penetrations. 4ft x 2ft. DOD 10 due to mechanicals interfering. previously under renovation

Date Created	EOCS ID #	Punch #	Full Plan View	Room Number	Item	Type	Wall Material	Fire Rating	Comments
<div>   </div> <div> <div>6/10/16 09:08 AM</div> <div>6/10/16 09:09 AM</div> </div> <div>   </div> <div> <div>6/10/16 09:11 AM</div> <div>6/10/16 09:12 AM</div> </div>									
6/10/16	325130	1291	2016.12.December / Floor 01 / Area A	C1-77	Large Opening	Large wall with penetrations	Concrete	Smoke Barrier Zone	1.5ft x 1.5ft DOD 5. previously under renovation
<div>  </div> <div> <div>6/10/16 09:32 AM</div> </div>									
6/10/16	325133	1292	2016.12.December / Floor 01 / Area A	C1-77	Large Opening	Large wall with penetrations	Concrete	Smoke Barrier Zone	1.5ft x 1.5ft. DOD 5. previously under renovation

Date Created	EOCS ID #	Punch #	Full Plan View	Room Number	Item	Type	Wall Material	Fire Rating	Comments
<div></div> <div>6/10/16 09:34 AM</div>									
9/8/16	343846	1412	2016.12.December / Floor 01 / Area A	A1-31B	Large Opening	Sections of walls missing	Gypsum	1 Hour	1'x1' section of drywall missings, DOD4
<div></div> <div>9/8/16 12:43 AM</div>									

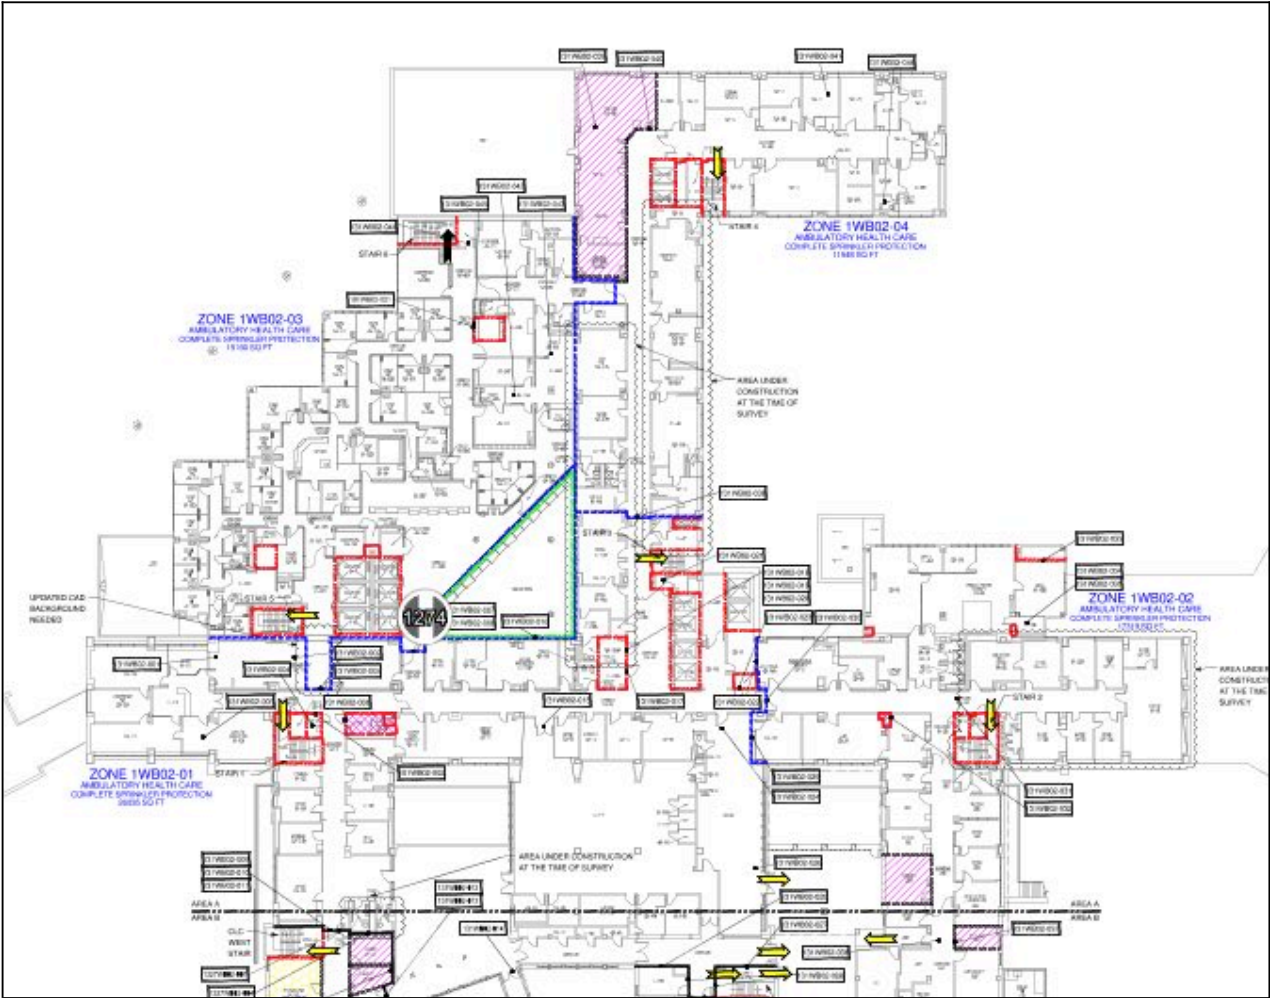


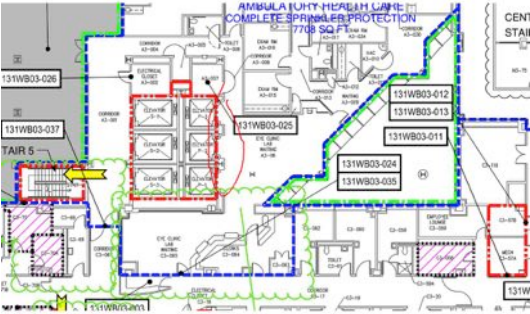


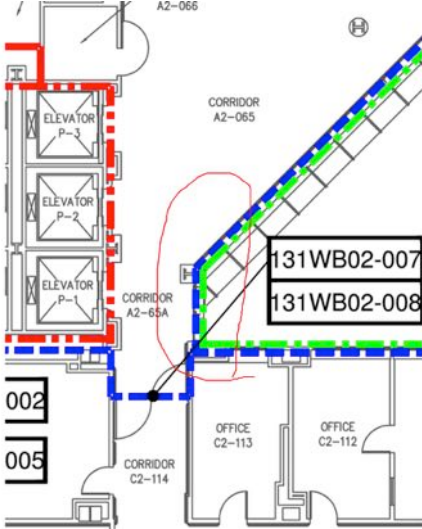
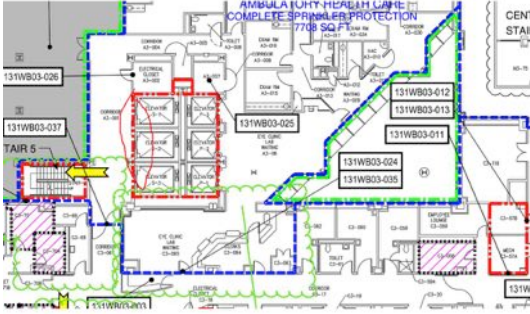






Date Created	EOCS ID #	Punch #	Full Plan View	Room Number	Item	Type	Wall Material	Fire Rating	Comments
6/8/16	324722	1274	2016.12.December / Floor 02 / Area A	Near double door. Atrium side.	Large Opening	Large wall with penetrations	Gypsum	1 Hour Smoke Zone Barrier	Section of drywall missing. Not built of to deck. DOD 4
<div><div><p>6/8/16 09:43 AM</p></div><div><p>6/8/16 09:44 AM</p></div><div><p>6/8/16 02:50 PM</p></div></div>									






Date Created	EOCS ID #	Punch #	Full Plan View	Room Number	Item	Type	Wall Material	Fire Rating	Comments
			 <p>6/7/16 09:01 AM</p>						
6/7/16	324702	1266	2016.12.December / Floor 03 / Area A-Reno 5/31/16	Blue Elevator Lobby	Large Opening	Joints	Gypsum	2 Hour	HOW 26ft x 1inch Needs Stuffed and Sprayed
			<div>   </div> <div> <p>6/7/16 01:28 PM</p> <p>6/7/16 01:28 PM</p> </div> <div>  <p>6/7/16 01:32 PM</p> </div>						
6/7/16	324705	1267	2016.12.December / Floor 03 / Area A-Reno 5/31/16	A3-001	Large Opening	Joints	Gypsum	2 Hour	HOW 30ft x 3inches Already Stuffed Needs Sprayed

Date Created	EOCS ID #	Punch #	Full Plan View	Room Number	Item	Type	Wall Material	Fire Rating	Comments
<div>   </div> <div> <div>6/7/16 01:34 PM</div> <div>6/7/16 01:35 PM</div> </div>									
6/7/16	324706	1268	2016.12.December / Floor 03 / Area A-Reno 5/31/16	C3-17A	Large Opening	Joints	Gypsum	2 Hour	HOW 20ft x 1inch. previously under renovation
<div>   </div> <div> <div>6/7/16 01:39 PM</div> <div>6/7/16 01:39 PM</div> </div>									
9/2/16	343356	1375	2016.12.December / Floor 03 / Area A-Reno 5/31/16	C3-119 and C3-61	Large Opening	Joints	Concrete	Smoke Barrier Zone	30' HOW DOD-4
<div>   </div> <div> <div>9/2/16 04:25 PM</div> <div>9/2/16 04:27 PM</div> </div>									
9/3/16	343441	1394	2016.12.December / Floor 03 / Area A-Reno 5/31/16	C3-64	Large Opening	Sections of walls missing	Gypsum	1 Hour	4x3 DOD 5



Date Created	EOCS ID #	Punch #	Full Plan View	Room Number	Item	Type	Wall Material	Fire Rating	Comments
<div>  </div> <div> <div>9/3/16 01:53 PM</div> <div>9/3/16 01:54 PM</div> </div>									
9/3/16	343442	1395	2016.12.December / Floor 03 / Area A-Reno 5/31/16	C3-64	Large Opening	Sections of walls missing	Gypsum	1 Hour	2x2 DOD 1
<div>  </div> <div>9/3/16 01:59 PM</div>									
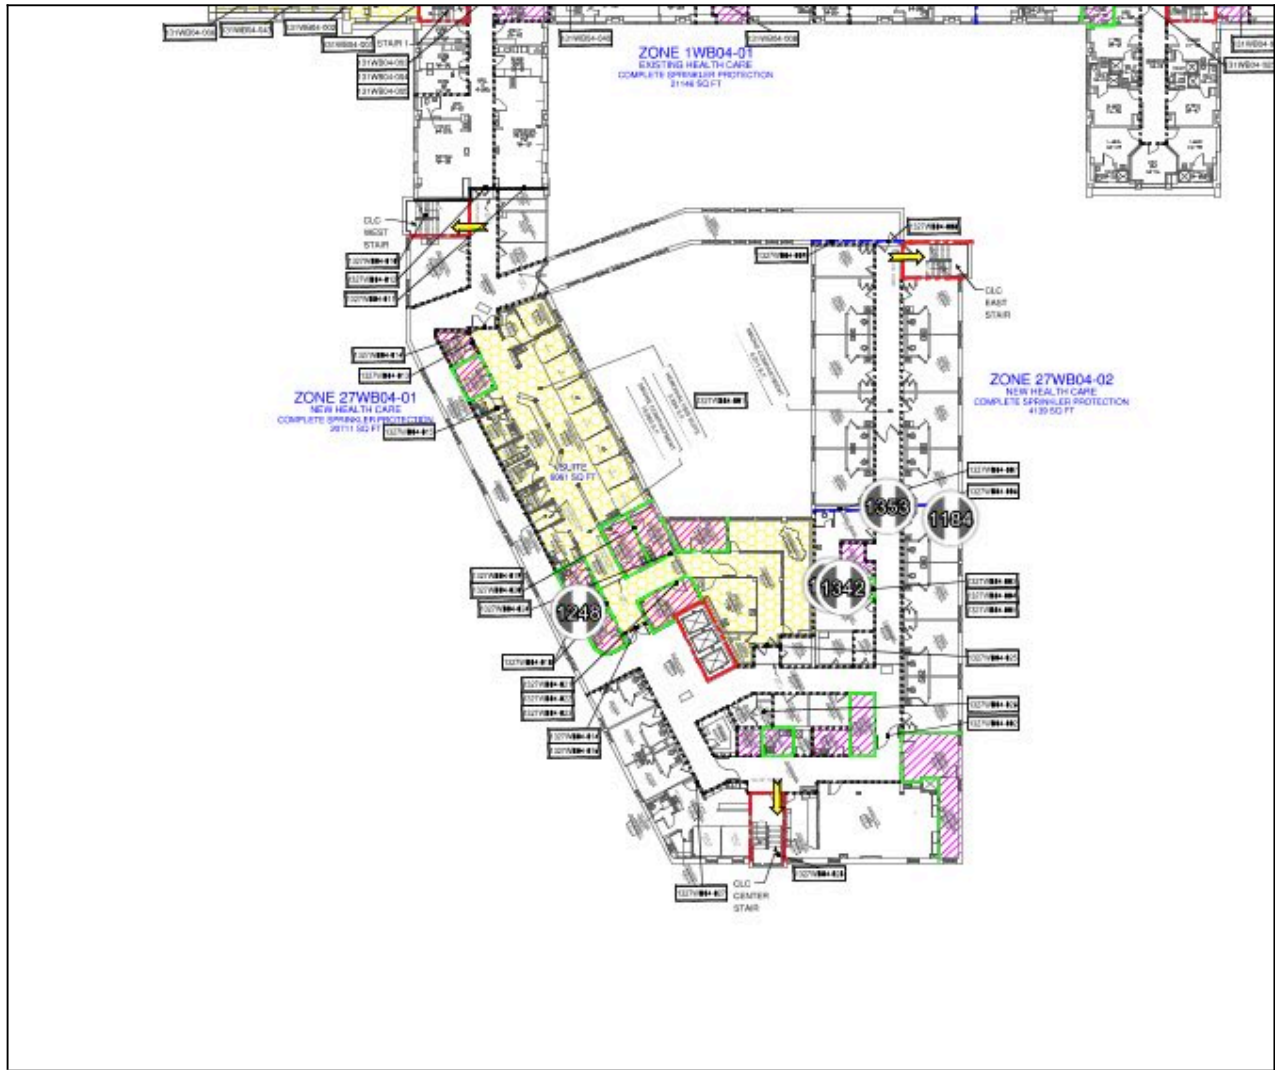
## 2016.12.December / Floor 04 / Area B -






Date Created	EOCS ID #	Punch #	Full Plan View	Room Number	Item	Type	Wall Material	Fire Rating	Comments
3/31/16	306557	1181	2016.12.December / Floor 04 / Area B	Break Room	Large Opening	Joints	Gypsum	1 Hour	10' HOW With multiple penetrations dod 2 Recently rentivated
 <p>3/31/16 09:26 AM</p>									
3/31/16	306560	1184	2016.12.December / Floor 04 / Area B	Family Lounge- 4-158	Large Opening	Joints	Gypsum	1 Hour	20' HOW with multiple penetrations DOD 4 recently rentivated




Date Created	EOCS ID #	Punch #	Full Plan View	Room Number	Item	Type	Wall Material	Fire Rating	Comments
									
3/31/16 09:36 AM									
6/6/16	324253	1248	2016.12.December / Floor 04 / Area B	4-122	Large Opening	Joints	Gypsum	1 Hour	4ft x 3inches DOD 2 Needs Stuffed and Sealed
									
6/6/16 12:58 PM					6/6/16 12:58 PM				
9/1/16	343181	1342	2016.12.December / Floor 04 / Area B	Storage left of 4-139	Large Opening	Sections of walls missing	Gypsum	1 Hour	10ft x 3ft DOD 10 Very difficult to install drywall due to mechanicals in the way

Date Created	EOCS ID #	Punch #	Full Plan View	Room Number	Item	Type	Wall Material	Fire Rating	Comments
									
			9/1/16 08:50 AM	9/1/16 08:51 AM					
									
			9/1/16 08:51 AM	9/1/16 08:52 AM					
9/1/16	343204	1353	2016.12.December / Floor 04 / Area B	Double Door by 4-141	Large Opening	Sections of walls missing	Gypsum	Smoke Barrier Zone	Smoke Barrier wall is not built to deck 8ft x 4ftft DOD 8 Very Difficult due to mechanicals

Date Created	EOCS ID #	Punch #	Full Plan View	Room Number	Item	Type	Wall Material	Fire Rating	Comments
									
									
			9/1/16 10:44 AM						
									
			9/1/16 10:44 AM						

2016.12.December / Floor 07 -

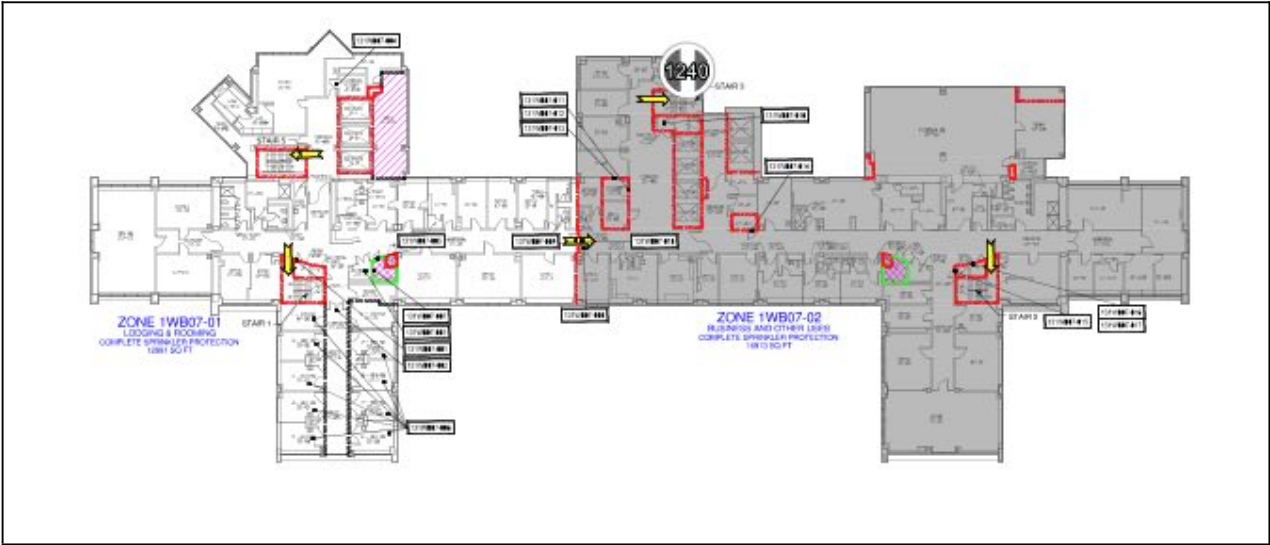

Date Created	EOCS ID #	Punch #	Full Plan View	Room Number	Item	Type	Wall Material	Fire Rating	Comments
6/3/16	324412	1240	2016.12.December / Floor 07	C7-49	Large Opening	Sections of walls missing	Concrete	2 Hour	(2) 3ft x 4ft openings. Old elevator shaft. Needs sealed.



6/3/16 08:06 AM




6/3/16 08:07 AM



6/3/16 08:08 AM



2016.12.December / Floor 08 -

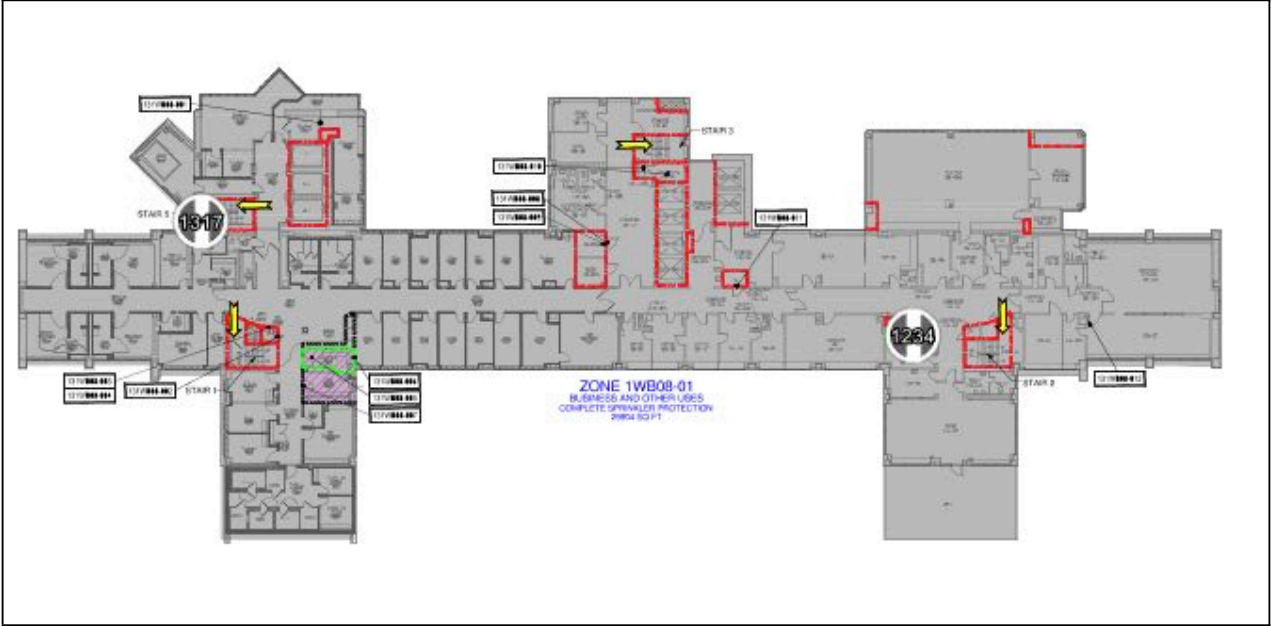

Date Created	EOCS ID #	Punch #	Full Plan View	Room Number	Item	Type	Wall Material	Fire Rating	Comments
6/2/16	323775	1234	2016.12.December / Floor 08	C8-33	Large Opening	Joints	Concrete	1 Hour	HOW 10ft x 4inches



6/2/16 03:23 AM



6/2/16 03:24 AM




6/2/16 03:24 AM




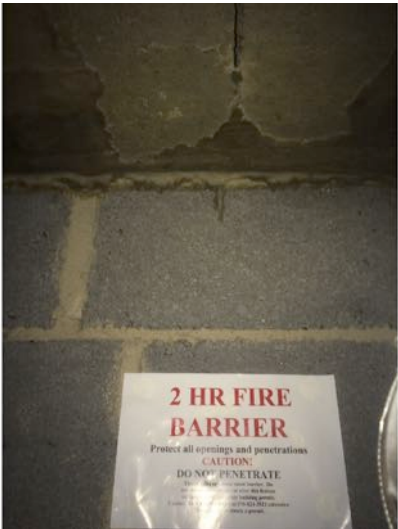
8/30/16	341247	1317	2016.12.December / Floor 08	C8-21	Large Opening	Joints	Gypsum	2 Hour	8ft x 3inches Needs Stuffed and Sealed
---------	--------	------	-----------------------------	-------	---------------	--------	--------	--------	--



8/30/16 03:09 PM

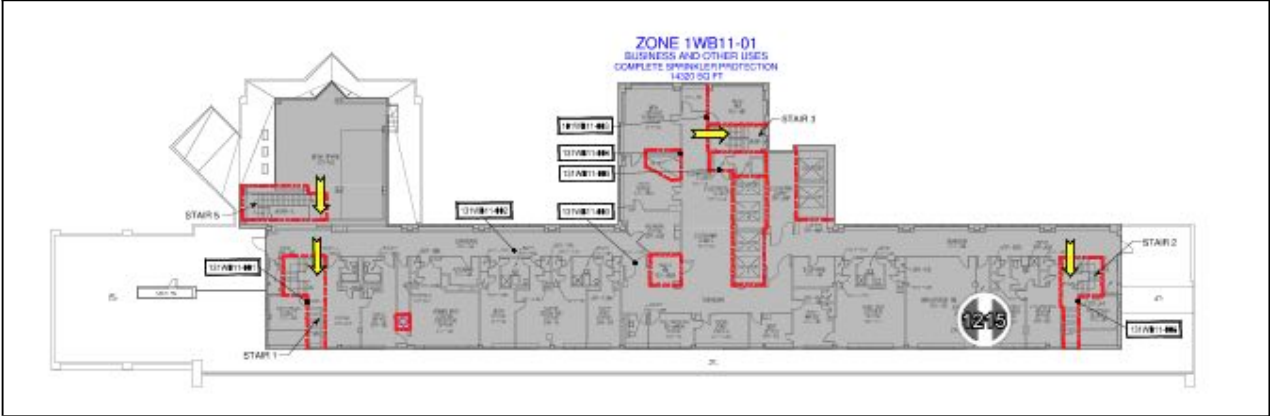2016.12.December / Floor 11 -



Date Created	EOCS ID #	Punch #	Full Plan View	Room Number	Item	Type	Wall Material	Fire Rating	Comments
6/1/16	323712	1215	2016.12.December / Floor 11	C11-22	Large Opening	Sections of walls missing	Concrete	2 Hour	Section of block missing. Not sealed up to deck. Needs block and mortar on all sides. DOD 4.
<div><div><p>6/1/16 11:47 AM</p></div><div><p>6/1/16 11:47 AM</p></div><div><p>6/1/16 11:52 AM</p></div><div><p>6/1/16 11:52 AM</p></div></div>									