




1 2 3 4 5 6 7 8 9

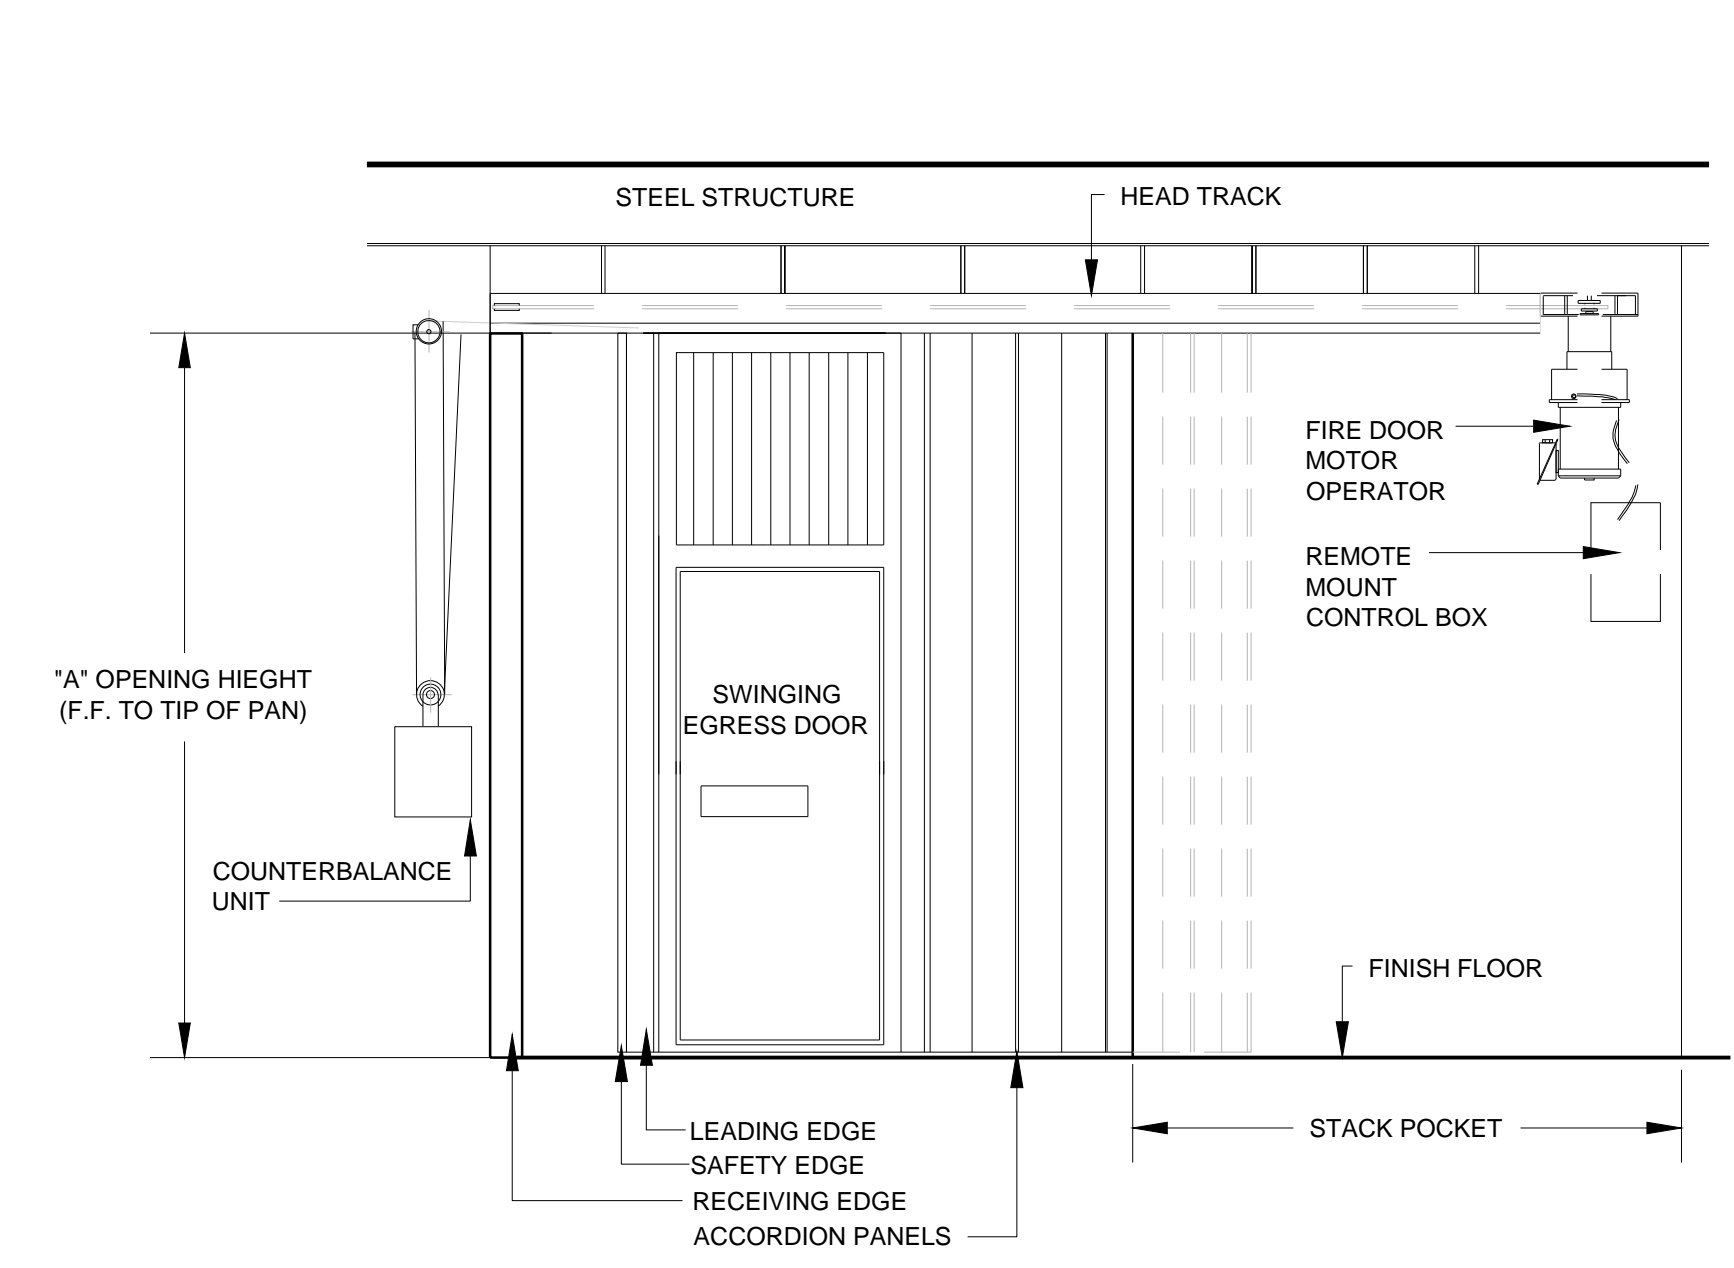


1 D3 ACCORDION DOOR WITH EGRESS - SECTION VIEW

NOT TO SCALE

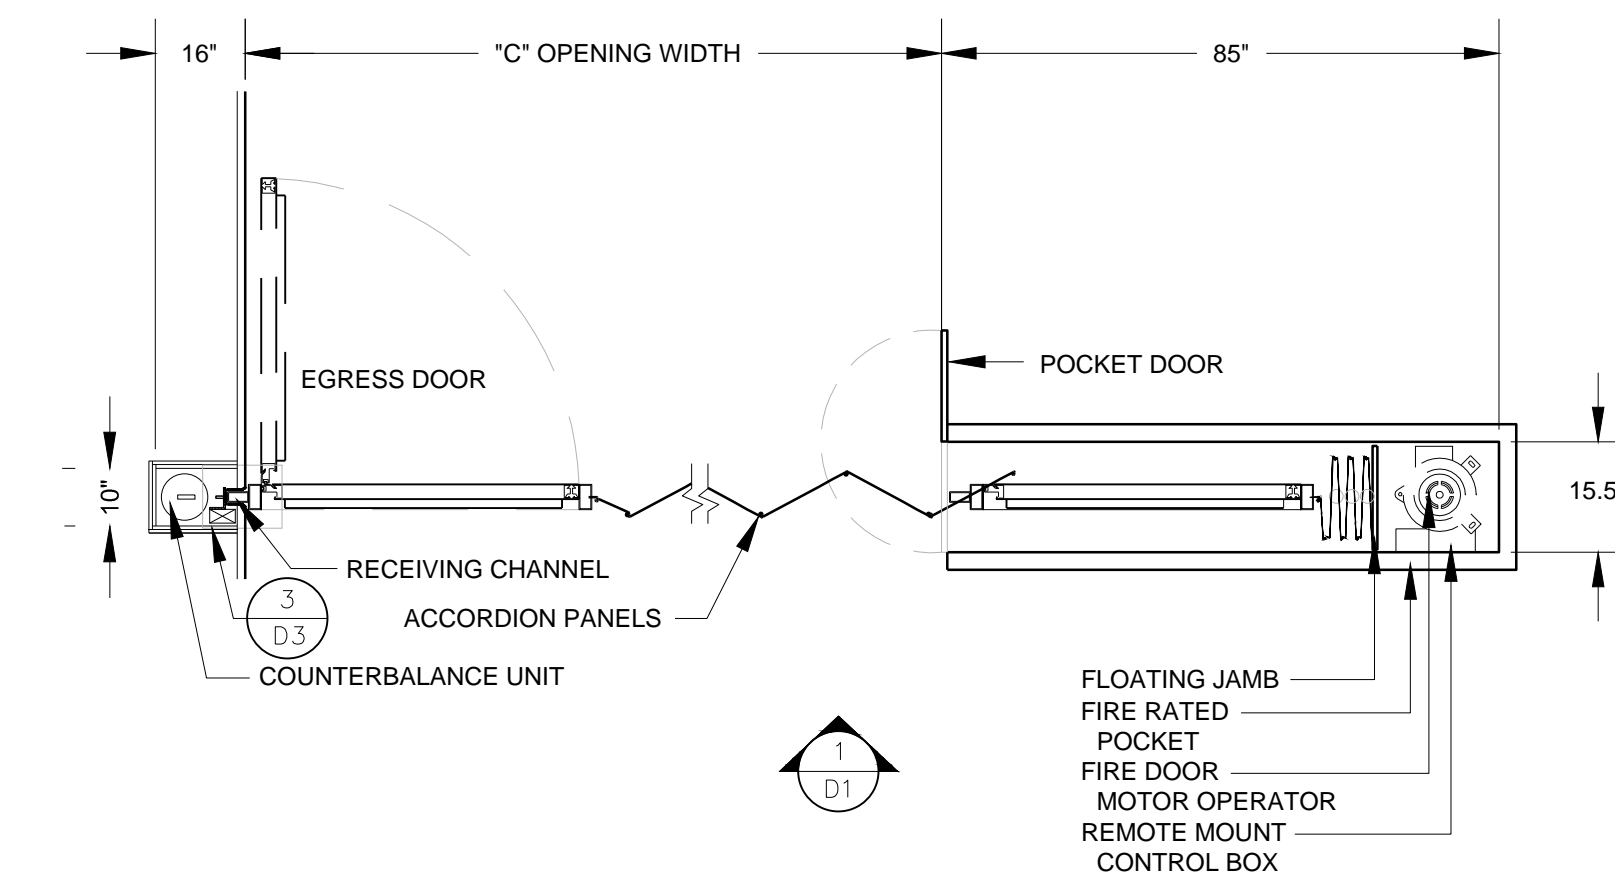


2 D3 ACCORDION DOOR WITH EGRESS - PLAN VIEW

NOT TO SCALE

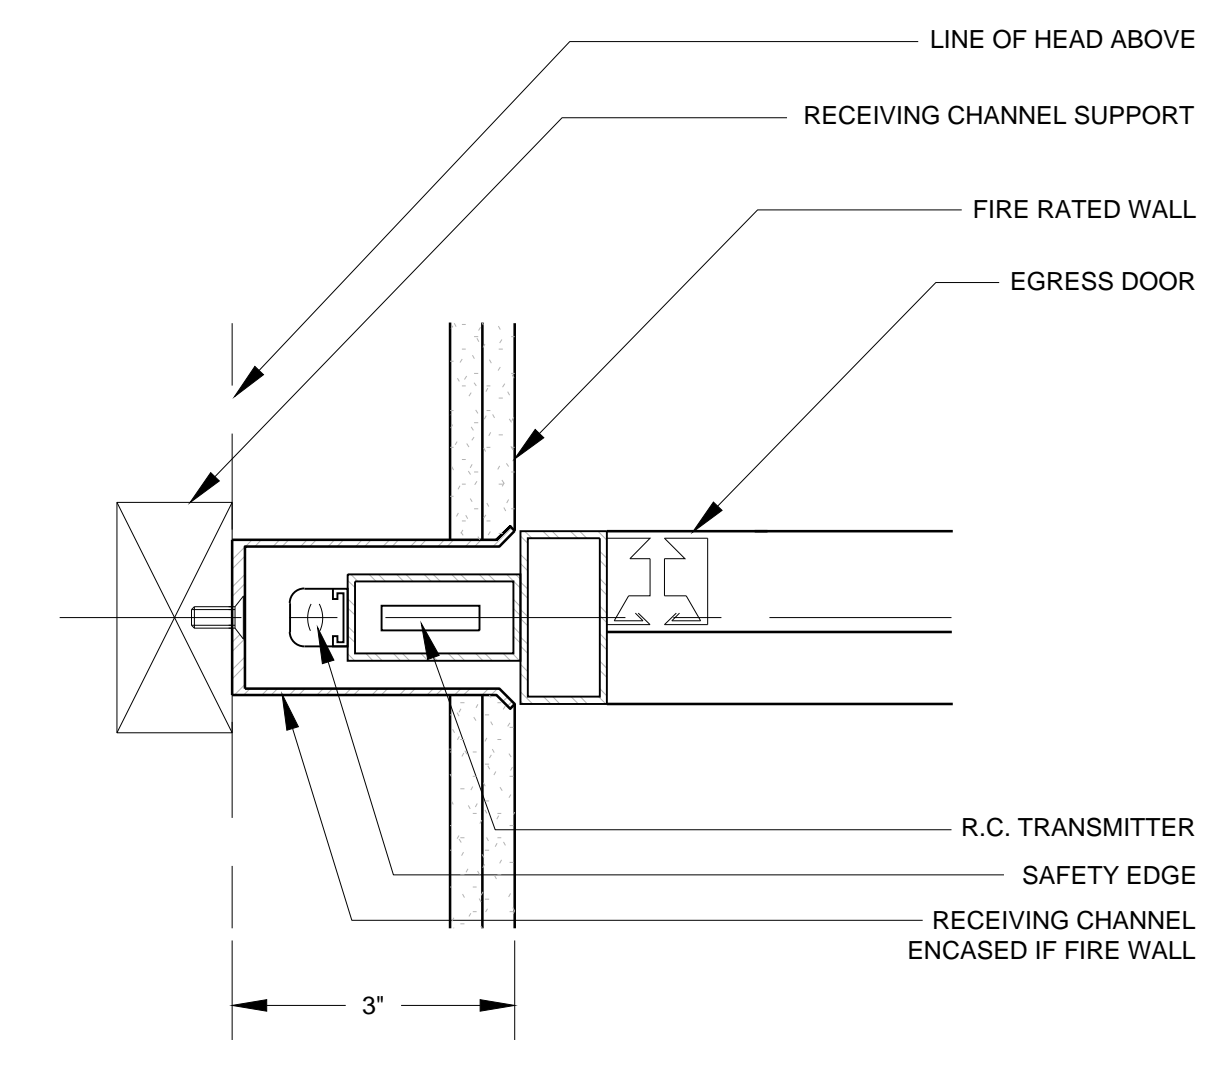


3 D3 ACCORDION DOOR RECEIVING EDGE POCKET

NOT TO SCALE

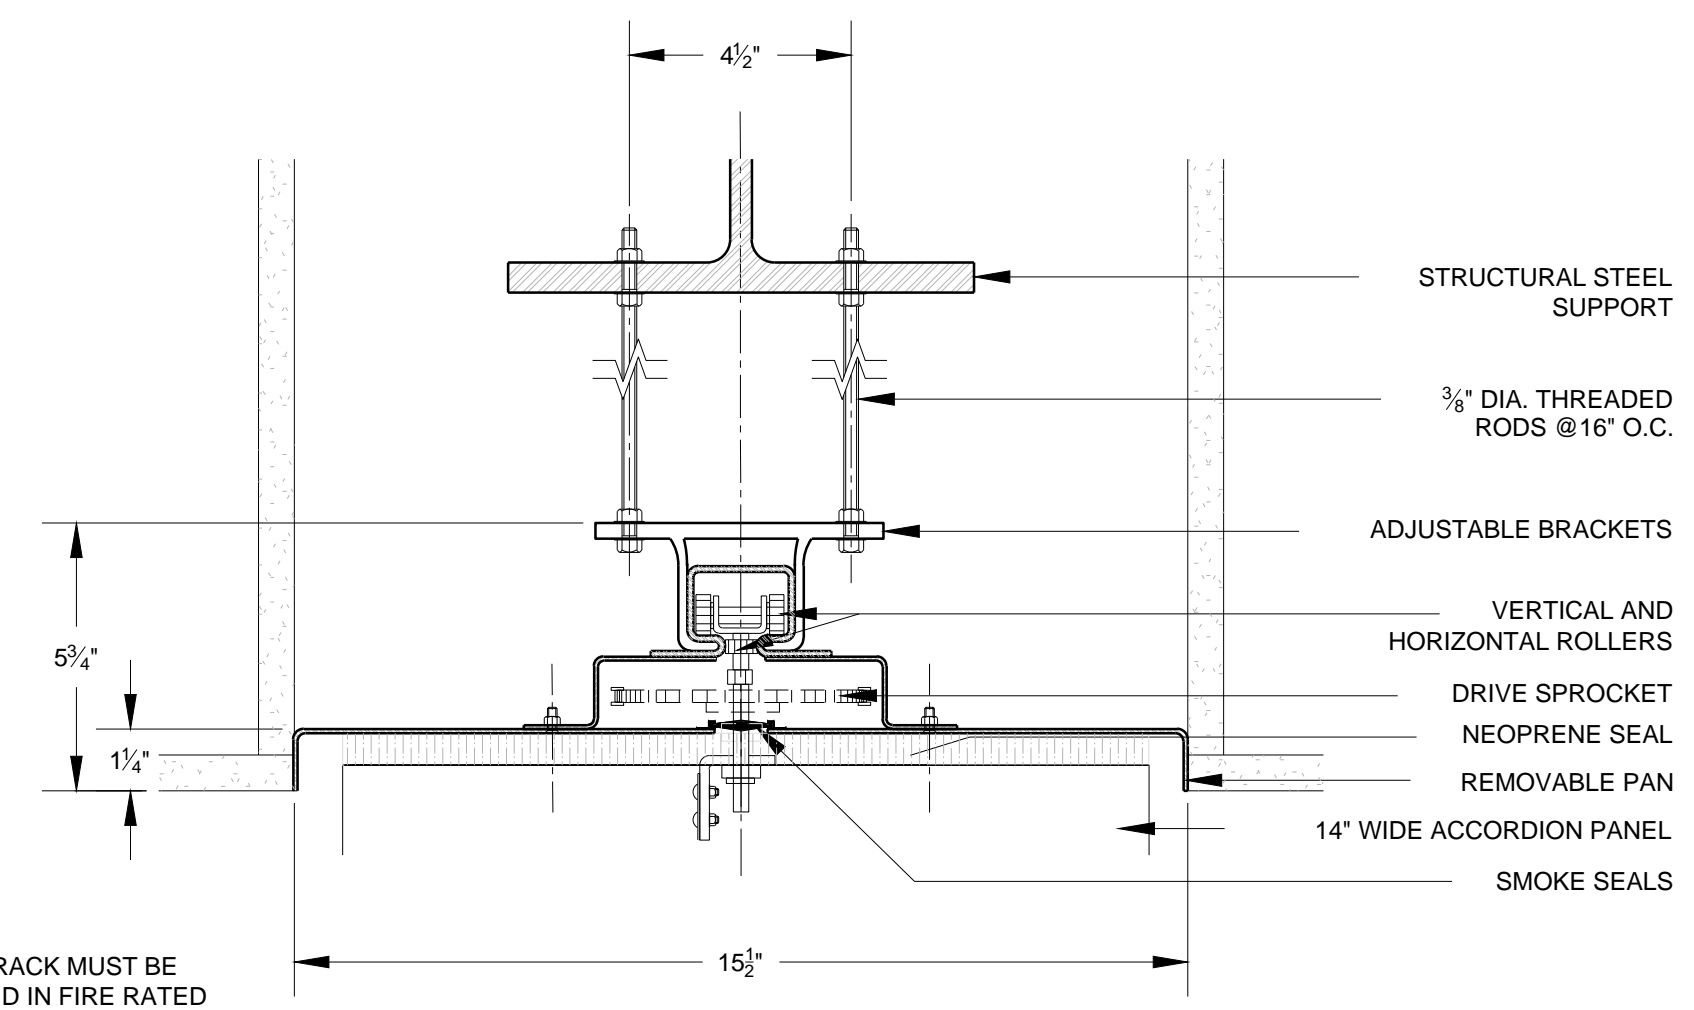

4 D3 ACCORDION FIRE DOOR SOFFIT CHANNEL

NOT TO SCALE

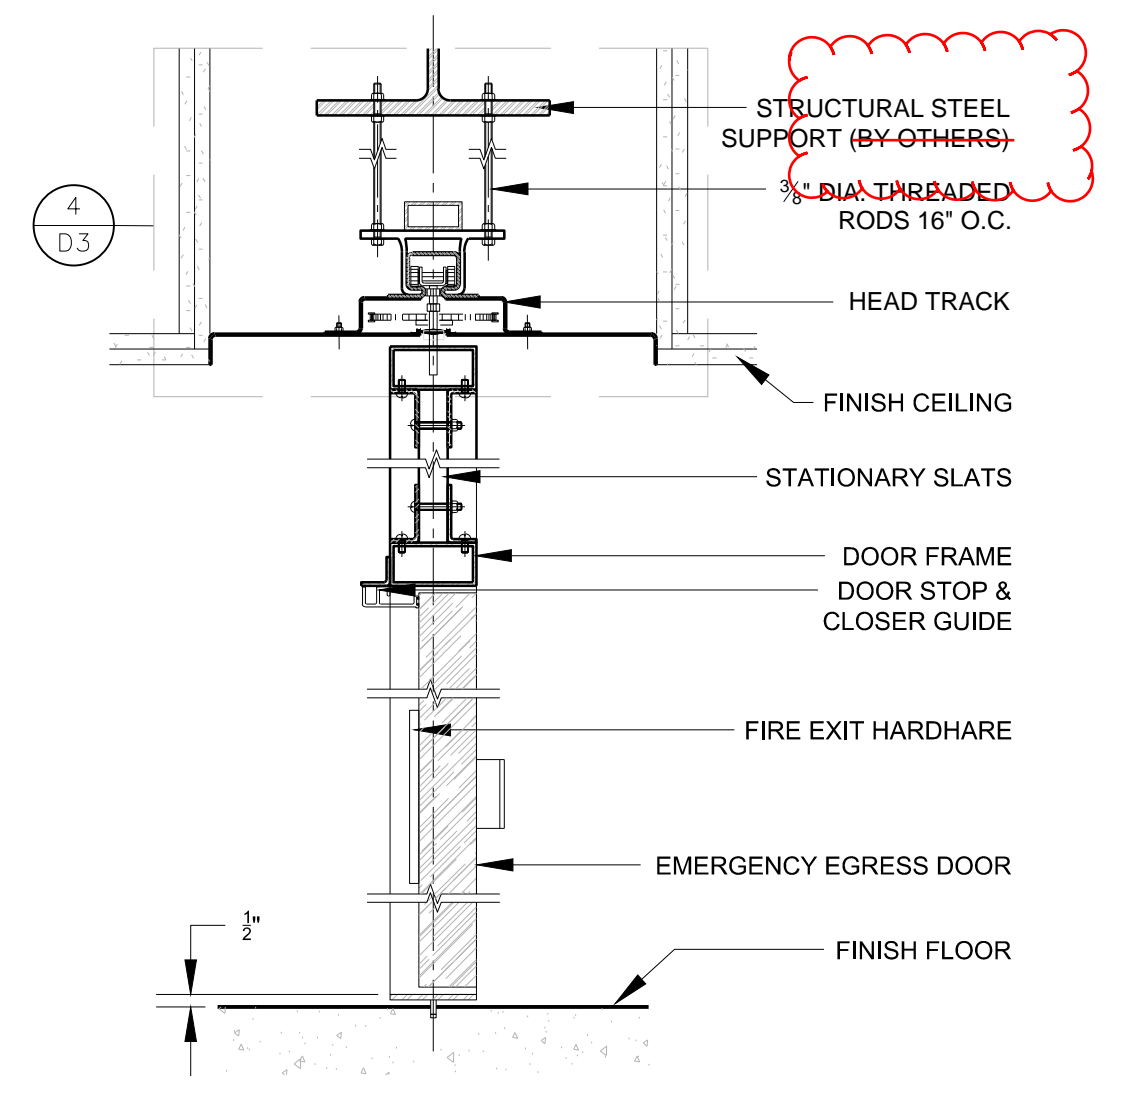

5 D3 ACCORDIAN FIRE DOOR SECTION VIEWS

NOT TO SCALE

CONSULTANTS:		ARCHITECT/ENGINEERS:		Drawing Title ACCORDIAN FIRE DOOR DETAILS	Project Title BUILDING 1 LIFE SAFETY IMPROVEMENTS	Project Number 595-17-103	Office of Construction and Facilities Management	
				Approved Project Director THADDIUS KOCUBA CHIEF ENGINEER VAPAHCS PLANNING AND ENGINEERING	Location LEBANON VAMC LEBANON, PA	Building Number 001		
Revisions:				Date OCTOBER 12, 2016	Checked DCS	Drawn MPT	D3	Department of Veterans Affairs
1. Words by others deleted from detail 5							Dwg 13 of 13	
Date 8/3/2017								

1 2 3 4 5 6 7 8 9