


**Guidelines: Security Focus**

- A. Base line offset from boundary is 2' to account for curved top overhang, with street lights spaced 100'.
- B. Eastside between Prospect and E-85 yard will require a portion to be a retaining wall for Containers [450' Fence, 200' Retaining area]
- C. Eastside Between Prospect and Barton will incorporate a dumpster holding area. [550' fence]
- D. NE entrance will be modified to include a guard shack (Provided) and traffic control measures.

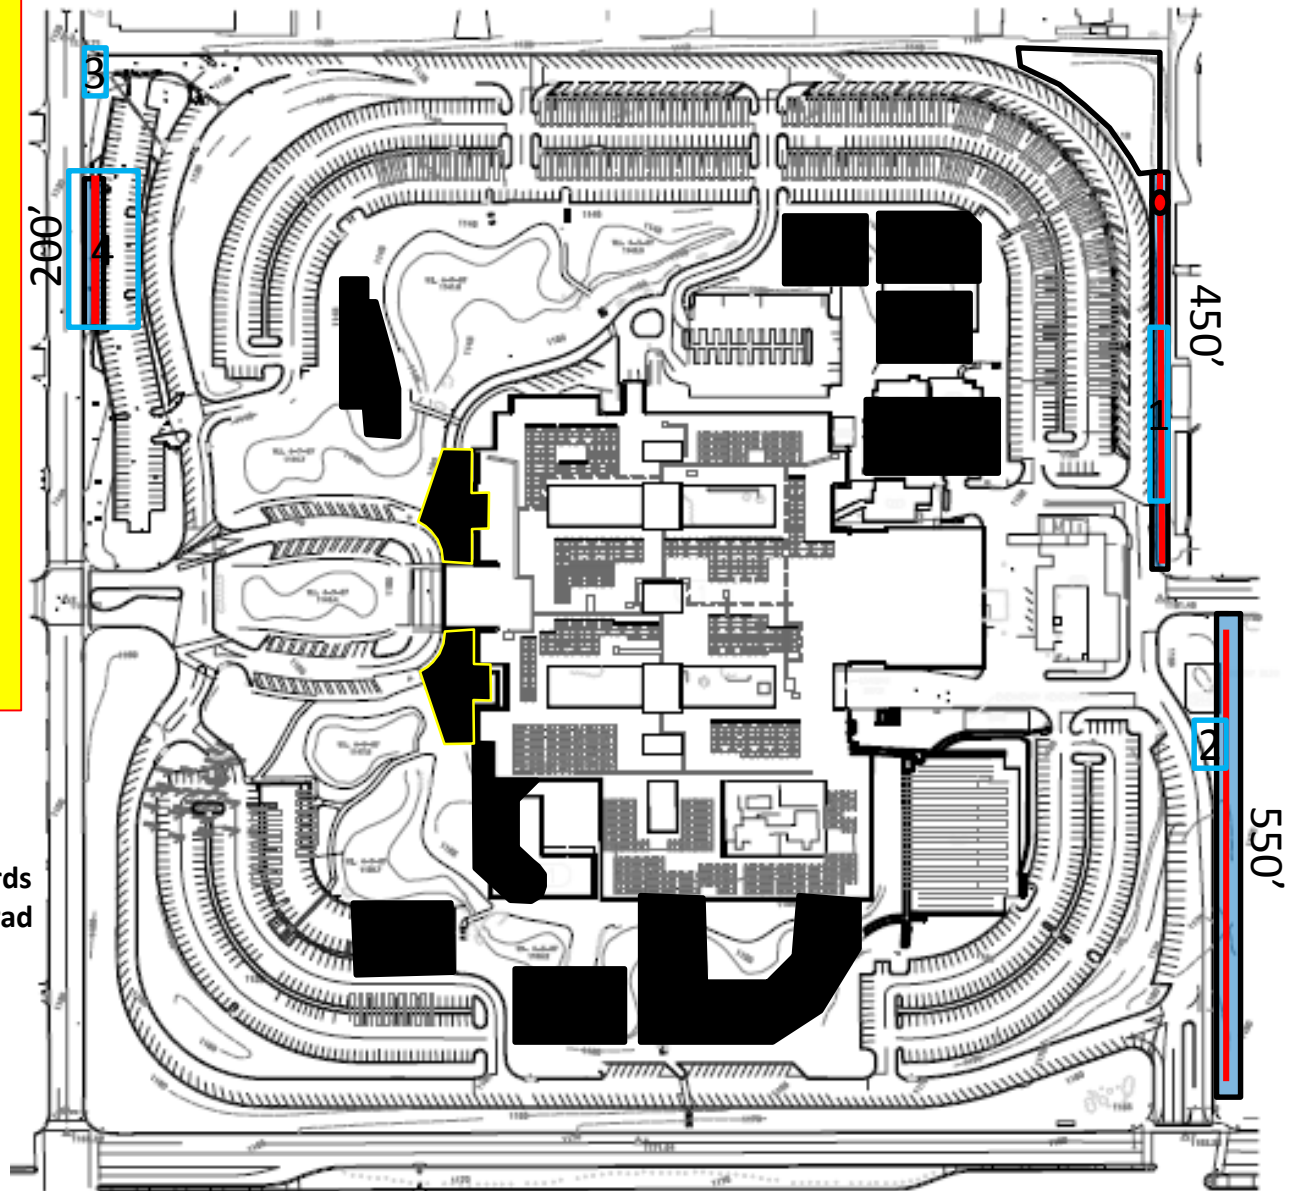

- 1. Retaining Wall area w/ curb removal and Road extension/Bollards
- 2. Dumpster holding Pad
- 3. NE Entrance
- 4. West wall fence

Fence Right-of-Way

Area of Installation

10' double gate for Grounds personnel only