


QC	
INI	%

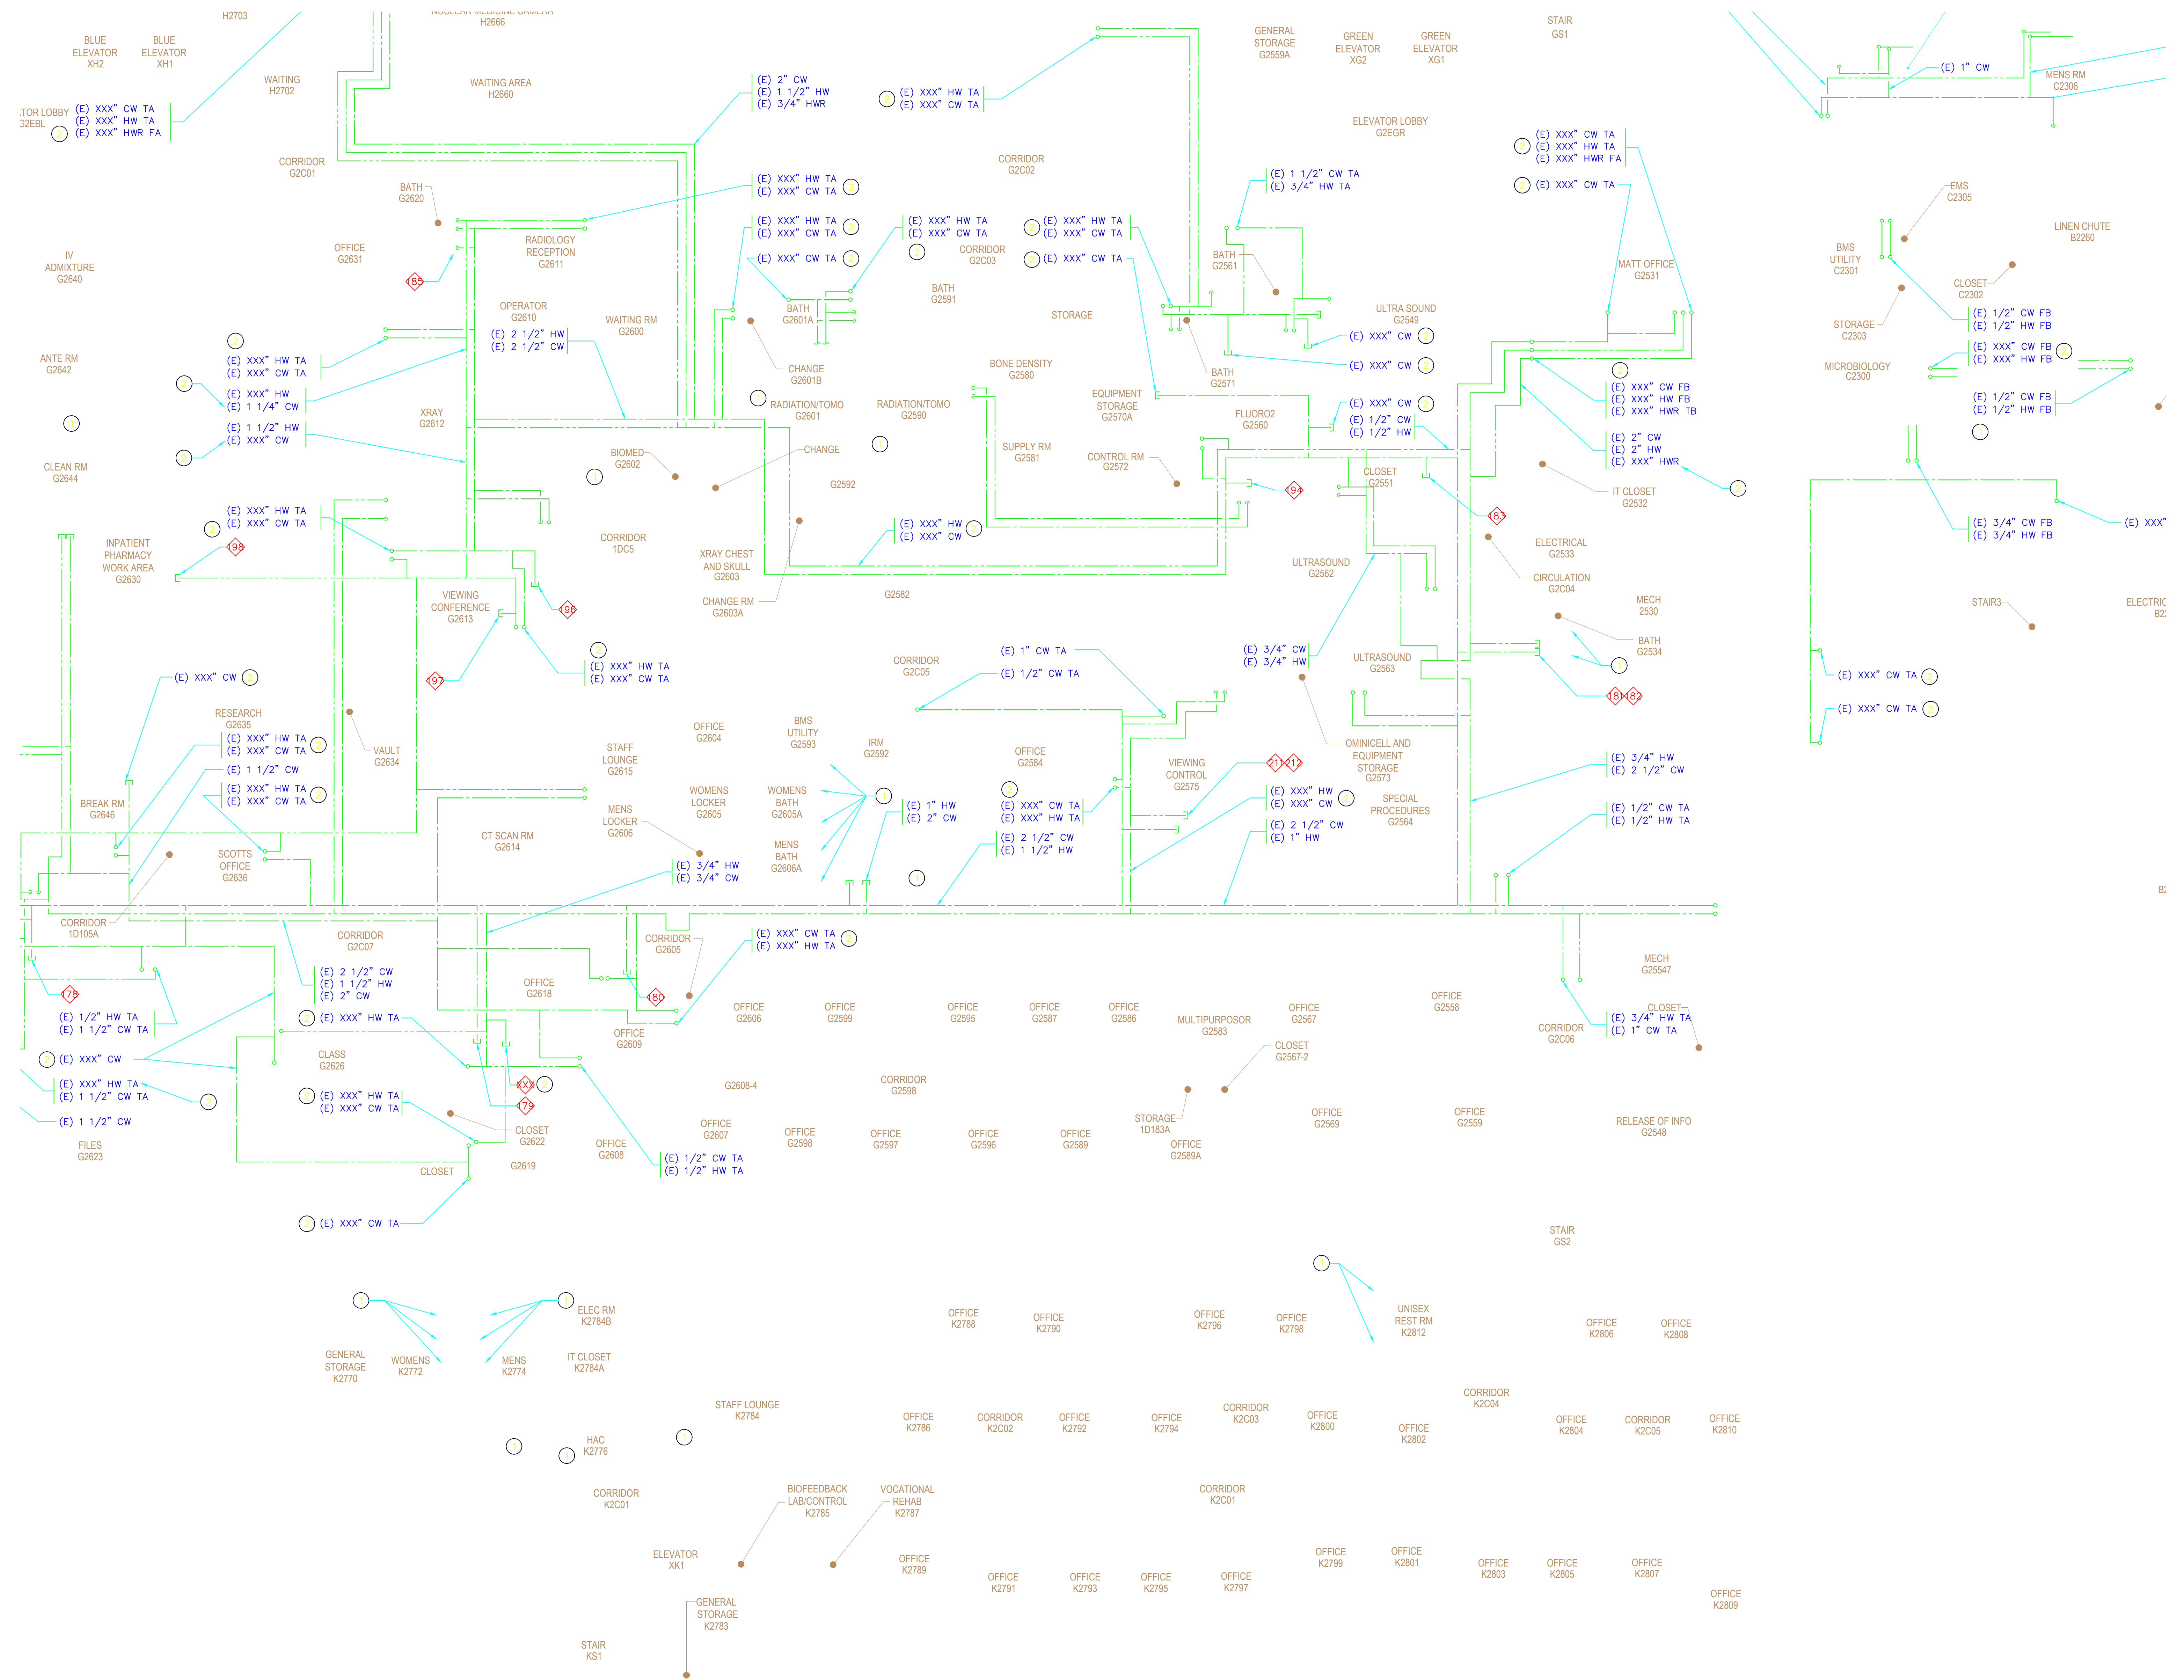

SHEET NOTES:  
 ① PLUMBING FIXTURES NOT SHOWN TO HAVE RUNS TO IT.  
 ② PIPE SIZES NOT KNOWN.

DEAD LEG LOCATIONS:  
 (E) 3/4" CW COPPER VALVED OFF ABOVE CEILING  
 (E) 1/2" CW COPPER CAPPED ABOVE CEILING  
 (E) 1 1/4" CW COPPER CAPPED ABOVE CEILING  
 (E) 1/2" CW COPPER CAPPED ABOVE CEILING  
 (E) 3/4" CW COPPER CAPPED ABOVE CEILING  
 (E) 1/2" HW COPPER CAPPED ABOVE CEILING  
 (E) 1" CW COPPER CAPPED IN WALL BEHIND TOILET  
 (E) 3/4" CW COPPER VALVED AND CAPPED ABOVE CEILING  
 (E) 3/4" HW COPPER VALVED AND CAPPED ABOVE CEILING  
 (E) 3/4" CW COPPER CAPPED ABOVE CEILING  
 (E) 1 1/2" HW COPPER VALVED AND CAPPED ABOVE CEILING  
 (E) 3/4" HW COPPER VALVED AND CAPPED ABOVE CEILING  
 (E) 1/2" CW CXC PIPE ABOVE CEILING  
 (E) 1/2" HW CXC PIPE ABOVE CEILING

SECOND FLOOR EXISTING PLUMBING FLOOR PLANS

M1.2C