QC	
INI	%

DEAD LEG LOCATIONS:

1. (E) 1 1/2" CW COPPER CAPPED AT 9' AFF
2. (E) 1" HW COPPER VALVED OFF, NO CAPPED AT 8' AFF
3. (E) 3/4" CW COPPER BULL HEAD TEE
4. (E) 3/4" HW COPPER BULL HEAD TEE
5. (E) 1/2" CW COPPER CAPPED
6. (E) 1/2" HW COPPER CAPPED
7. (E) 1/2" CW COPPER CAPPED
8. (E) 1/2" HW COPPER CAPPED
9. (E) 1/2" CW COPPER VALVED AND CAPPED
10. (E) 1/2" HW COPPER VALVED AND CAPPED
11. (E) 3/4" HW COPPER VALVED
12. (E) 3/4" HW COPPER VALVED (REMOVE MIXING VALVE)
13. (E) 3/4" CW COPPER VALVED
14. (E) 3/4" CW COPPER CAPPED
15. (E) 3/4" HW COPPER CAPPED
16. (E) 3/4" CW COPPER CAPPED
17. (E) 3/4" CW COPPER CAPPED
18. (E) 3/4" HW COPPER CAPPED
19. (E) 1" CW COPPER CAPPED
20. (E) 3/4" CW COPPER VALVED AND CAPPED
21. (E) 1/2" CW COPPER VALVED AND CAPPED
22. (E) 1/2" HW COPPER VALVED AND CAPPED
23. (E) 1/2" CW COPPER VALVED AND CAPPED DOWNSTREAM OF TRAP PRIMER
24. (E) 1/2" HW COPPER VALVED
25. (E) 1/2" CW COPPER VALVED AND CAPPED
26. (E) 1/2" HW COPPER CAPPED
27. (E) 1/2" HW COPPER VALVED AND CAPPED
28. (E) 1/2" HW COPPER CAPPED
29. (E) 1/2" CW COPPER VALVED AND CAPPED
30. (E) 1/2" HW COPPER VALVED AND CAPPED
31. (E) 2" CW COPPER VALVED
32. (E) 3/4" HW COPPER CAPPED
33. (E) 1/2" CW COPPER CAPPED
34. (E) 3/4" CW COPPER REDUCED TO 1/2" AND CAPPED
35. (E) 3/4" HW COPPER REDUCED TO 1/2" AND CAPPED
36. (E) 1/2" CW COPPER CAPPED
37. (E) 1" CW COPPER WITH 1" TEE REDUCED TO 1/2" CAPPED
38. (E) 1 1/4" CW COPPER REDUCE TO 1/2" TUBING (OLD HOSE BIB)
39. (E) 1/2" HW COPPER CAPPED
40. (E) 1 1/2" CW COPPER CAPPED
41. (E) 1/2" CW COPPER CAPPED
42. (E) 1/2" HW COPPER CAPPED
43. (E) 1/2" CW COPPER CAPPED
44. (E) 1 1/4" CW COPPER VALVED AND CAPPED OFF
45. (E) 1/2" CW COPPER CAPPED
46. (E) 1/2" CW COPPER CAPPED
47. (E) 1/2" HW COPPER CAPPED
48. (E) 1/2" CW COPPER CAPPED
49. (E) 1/2" HW COPPER CAPPED
50. (E) 1/2" HW COPPER CAPPED
51. (E) 1/2" CW COPPER CAPPED
52. (E) 1/2" HW COPPER CAPPED
53. (E) 1/2" CW COPPER CAPPED
54. (E) 1/2" HW COPPER CAPPED
55. (E) 1/2" CW COPPER CAPPED
56. (E) 1/2" HW COPPER CAPPED
57. (E) 1/2" HW COPPER CAPPED
58. (E) 1/2" HW COPPER CAPPED
59. (E) 1/2" CW COPPER CAPPED
60. (E) 2" CW COPPER CAPPED

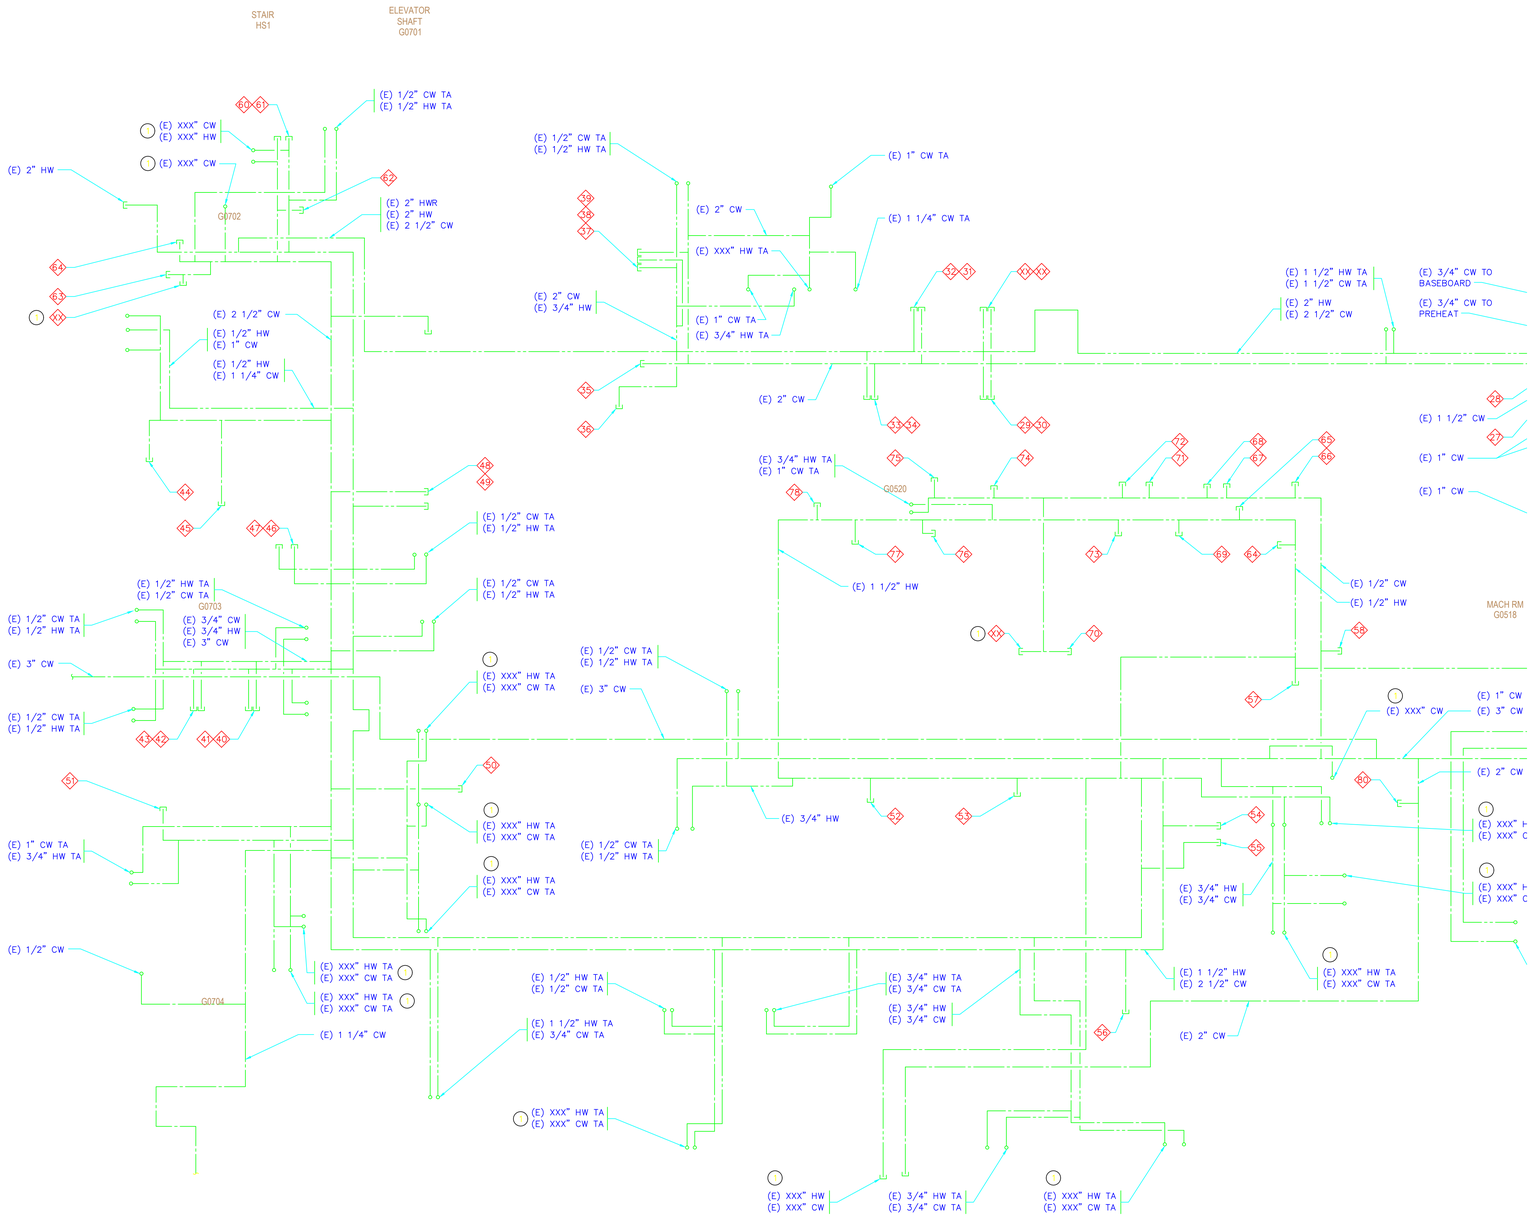

SHEET NOTES:

1. PIPE SIZES NOT KNOWN.

BASEMENT EXISTING
PLUMBING FLOOR PLAN

M1.0B