


QC
INI
%

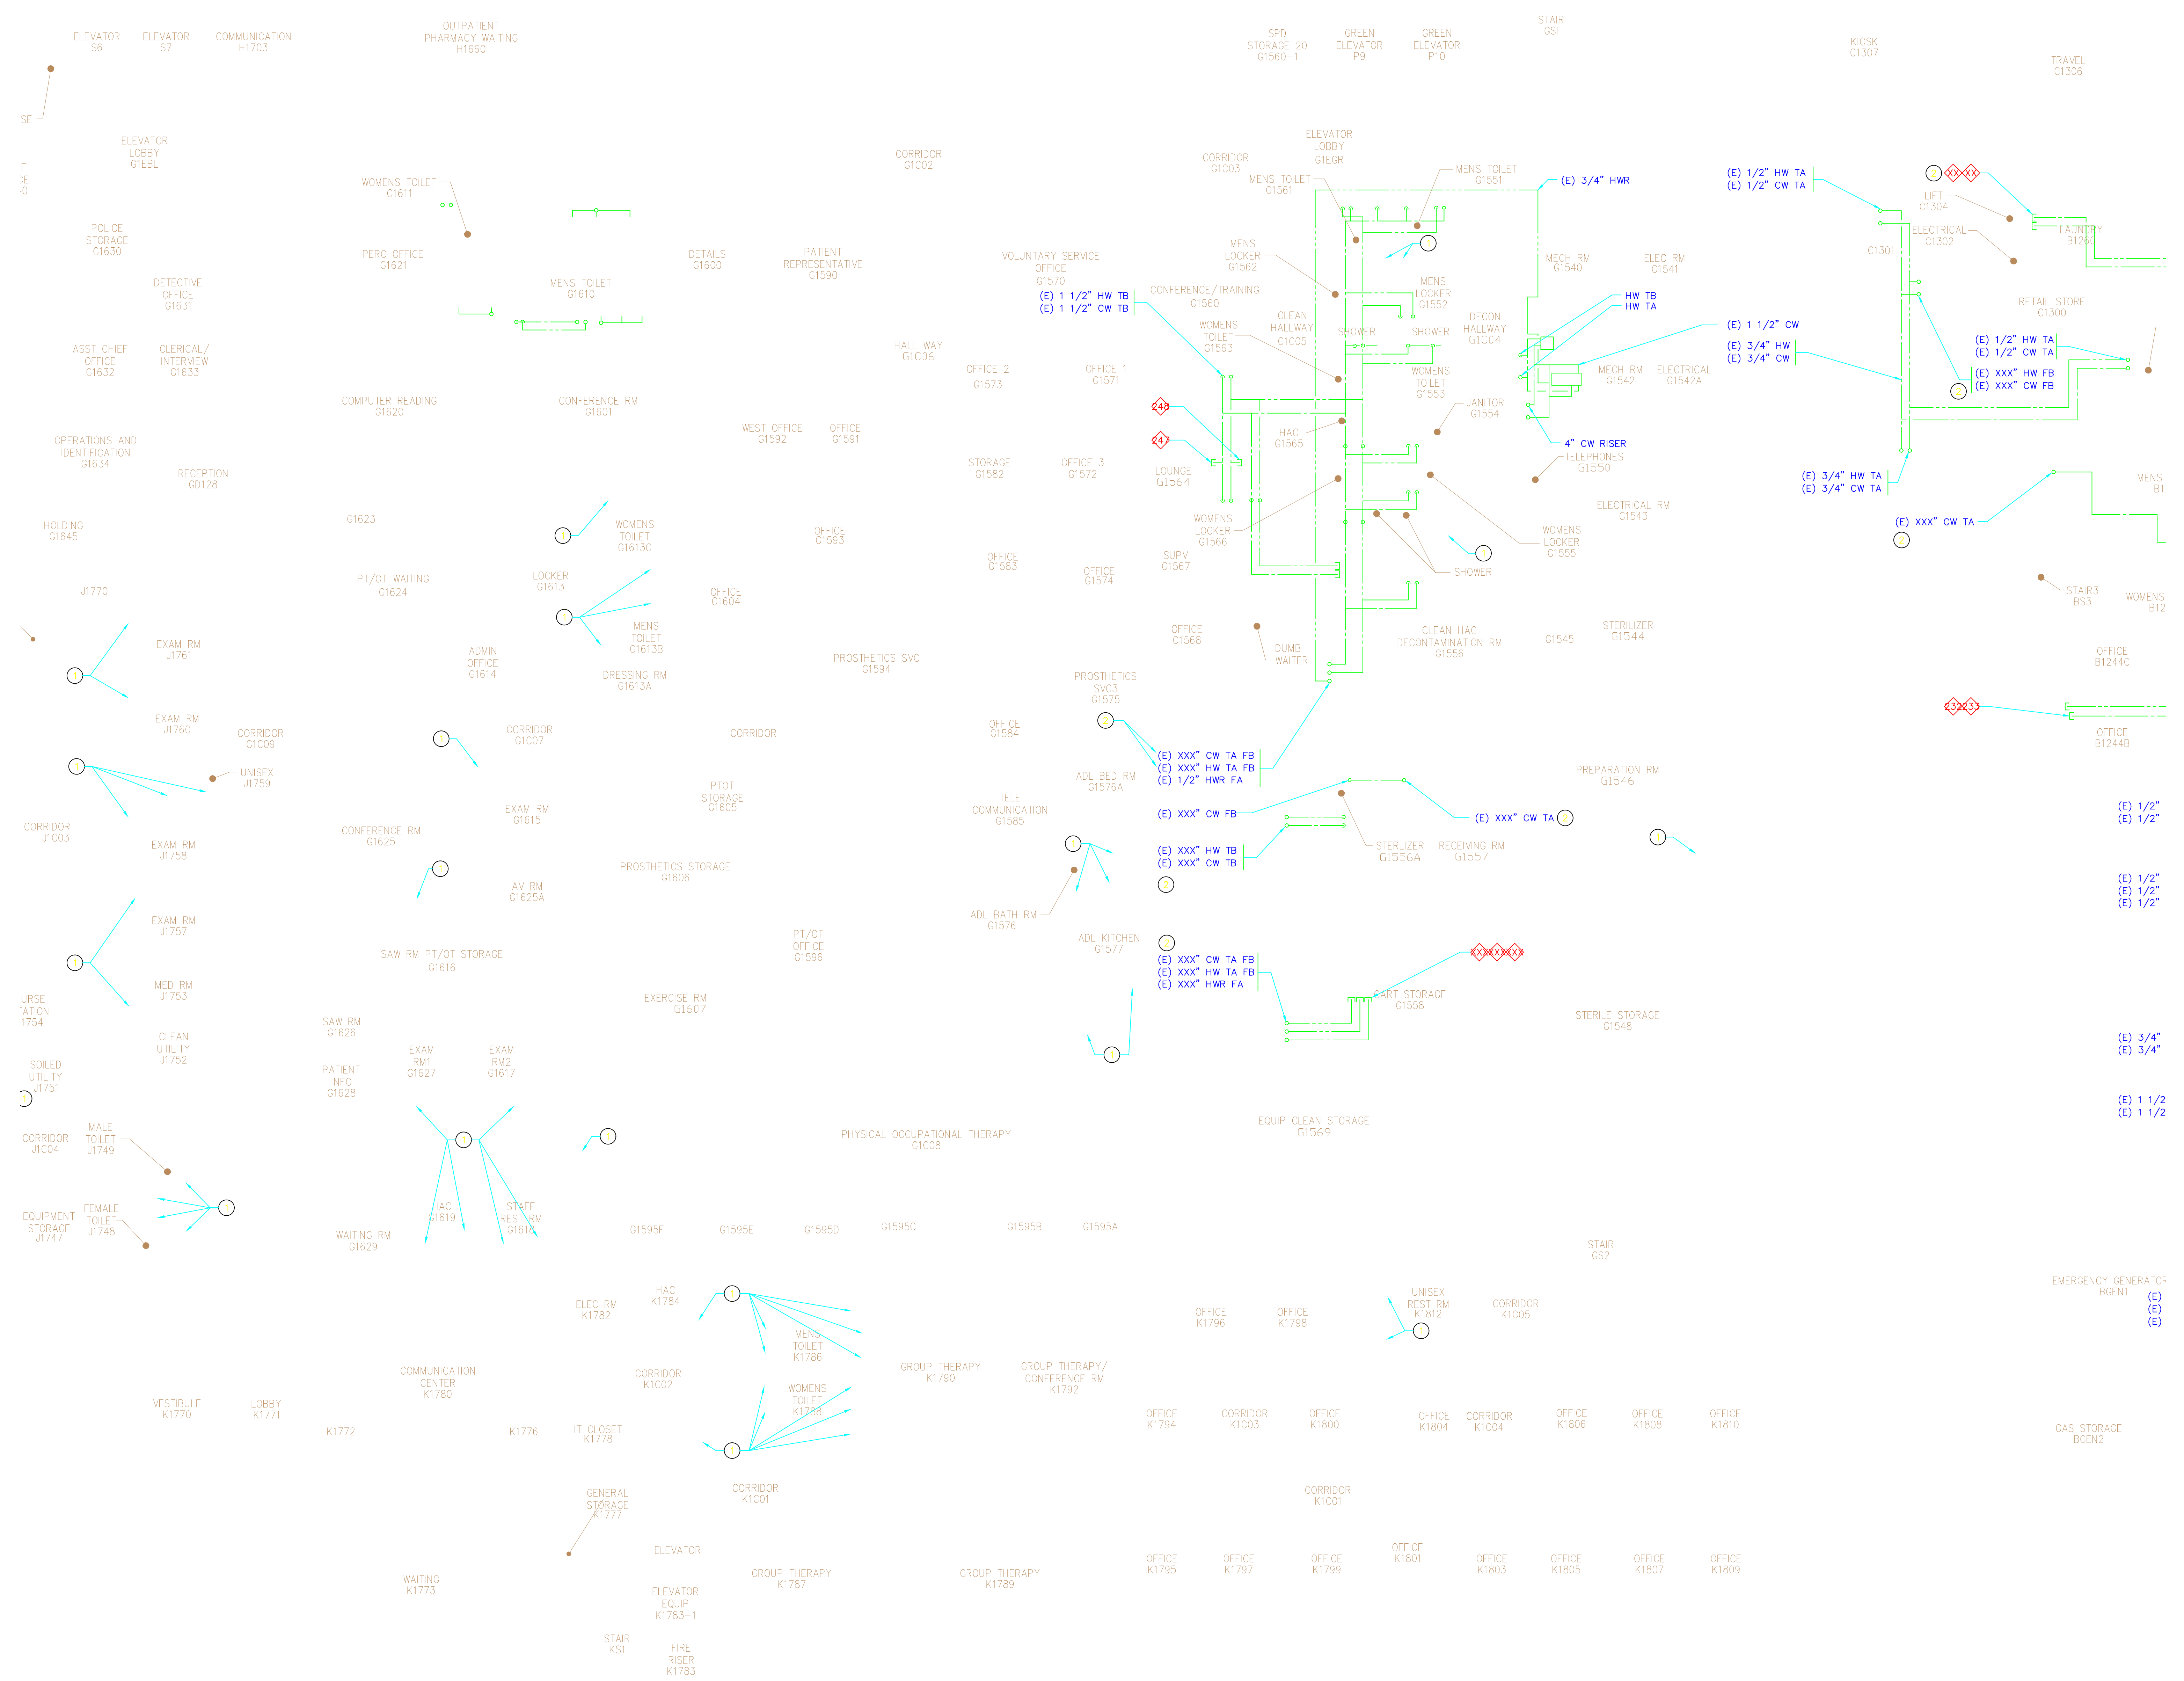

- SHEET NOTES:
- ① PLUMBING FIXTURES NOT SHOWN TO HAVE RUNS TO IT.
  - ② PIPE SIZES NOT KNOWN.

- DEAD LEG LOCATIONS:
- ⊠ (E) 1/2" CW COPPER PIPE ABOVE CEILING
  - ⊠ (E) 1/2" HW COPPER PIPE ABOVE CEILING
  - ⊠ (E) 1/2" CW CXC PIPE ABOVE CEILING
  - ⊠ (E) 1/2" HW CXC PIPE ABOVE CEILING

FIRST FLOOR EXISTING PLUMBING FLOOR PLAN

M:\Project\2015\15110202\1500 Drawings\1505 Add\1505 Project Files\M1.1C - March 21, 2015 - 01.mxd - 1