QC	
INI	%

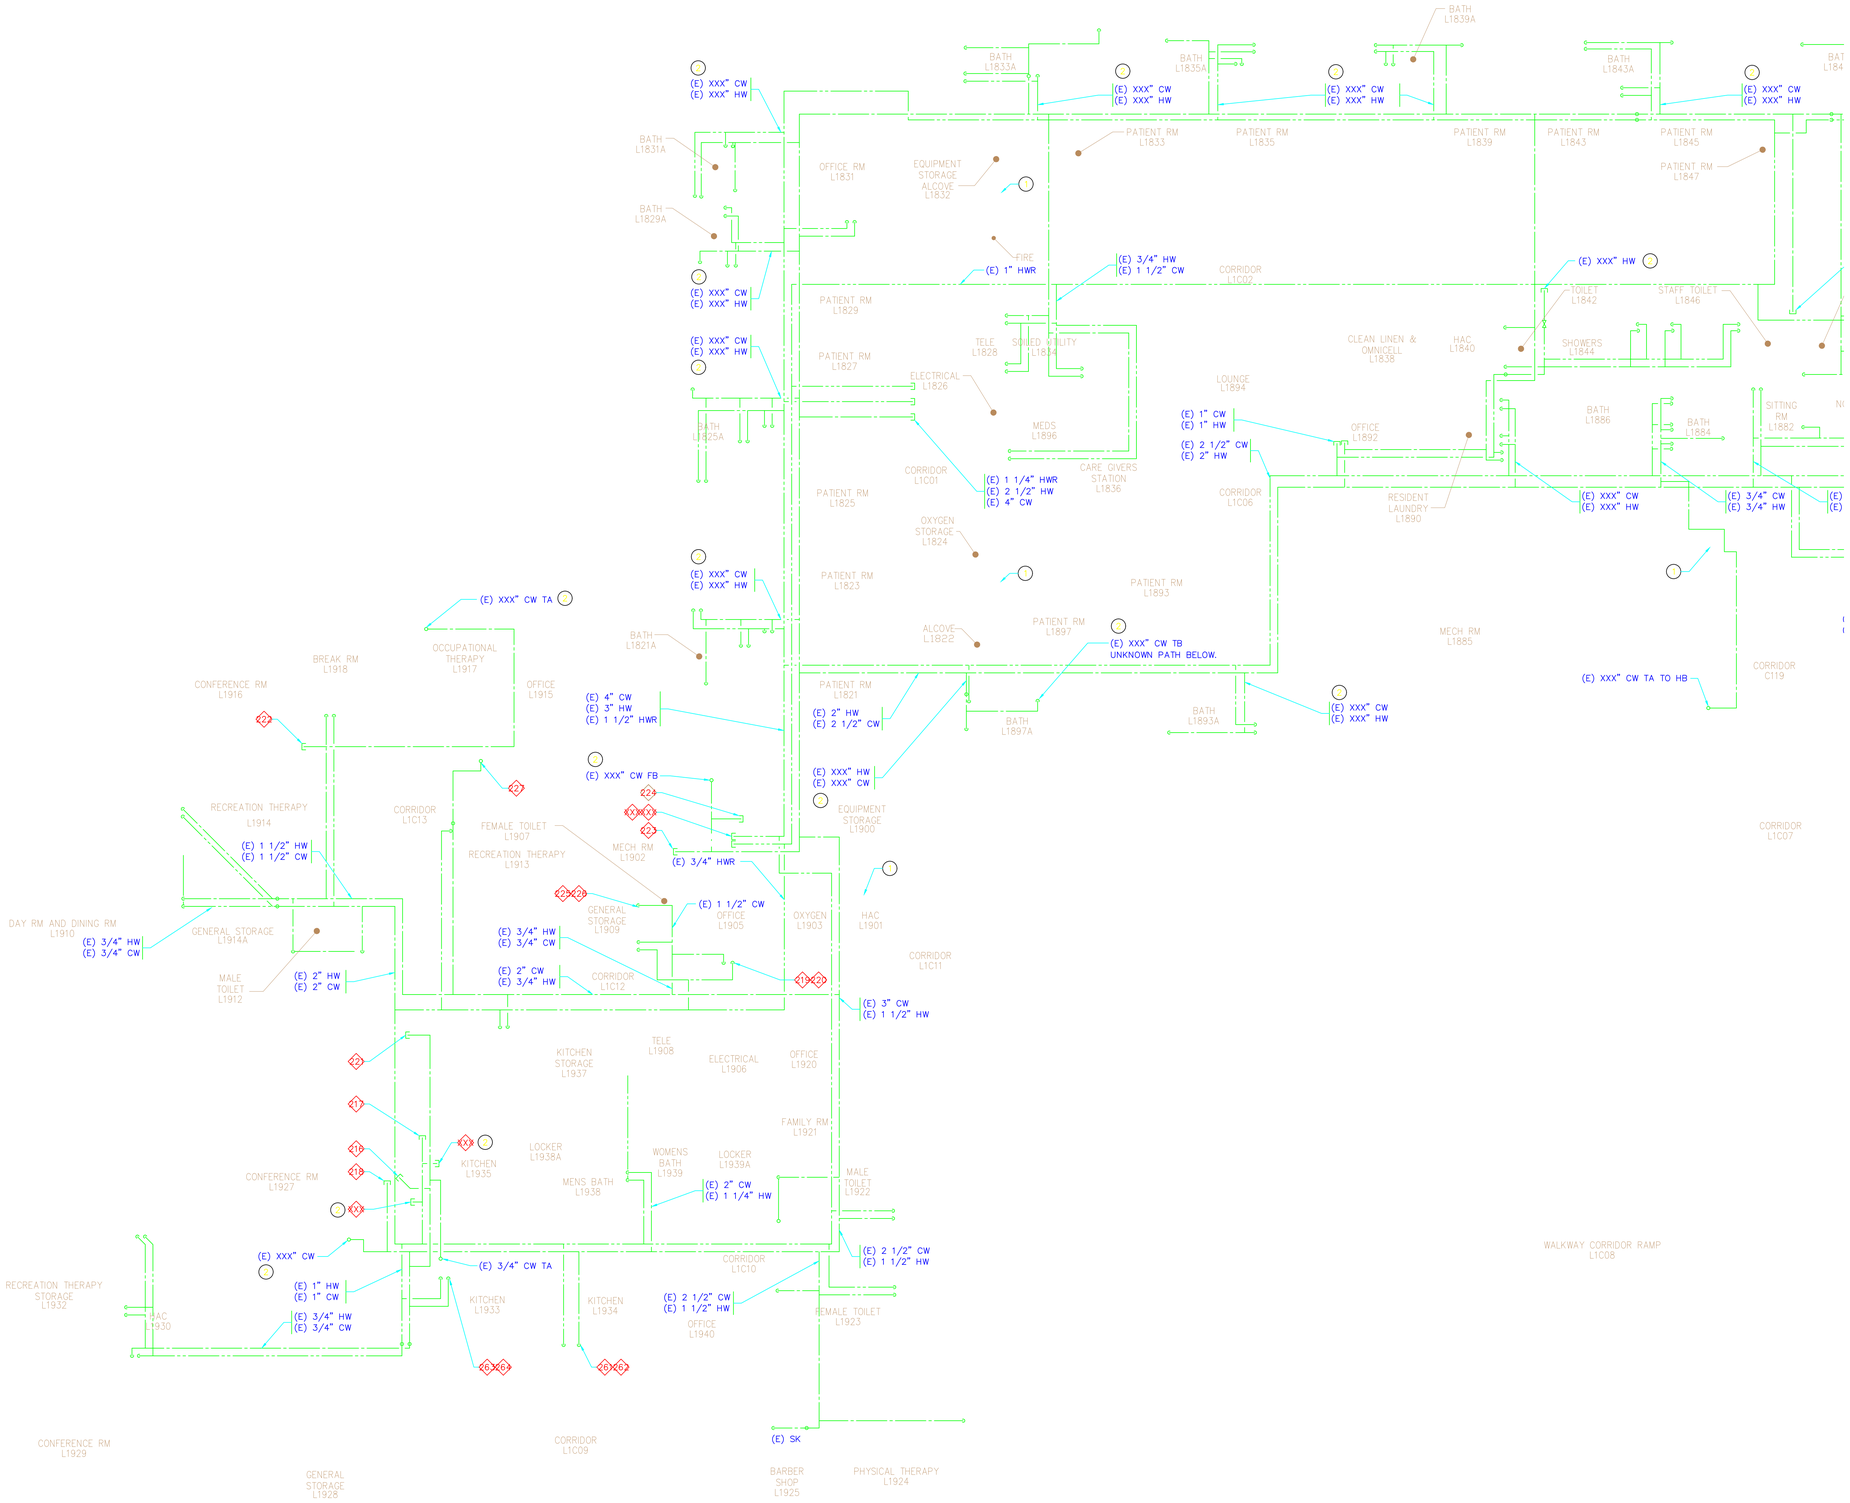

SHEET NOTES:

1. PLUMBING FIXTURES NOT SHOWN TO HAVE RUNS TO IT.
2. PIPE SIZES NOT KNOWN.

DEAD LEG LOCATIONS:

- 1 (E) 1/2" CW CXC PIPE ABOVE CEILING
- 1 (E) 1/2" HW CXC PIPE ABOVE CEILING
- 1 (E) 1/2" CW CXC PIPE ABOVE CEILING
- 1 (E) 1/2" CW CXC PIPE ABOVE CEILING & DROPS DOWN IN WALL
- 2 (E) 1/2" HW CXC PIPE ABOVE CEILING & DROPS DOWN IN WALL
- 2 (E) 1/2" CW CXC PIPE ABOVE CEILING
- 2 (E) 1/2" HW CXC PIPE ABOVE CEILING
- 2 (E) 3" CW CXC PIPE ABOVE CEILING
- 2 (E) 3/4" CW CXC PIPE ABOVE CEILING
- 2 (E) 3/4" HW HB FOR NONEXISTING WASHER
- 2 (E) 3/4" CW HB FOR NONEXISTING WASHER
- 2 (E) 3/4" CW CXC PIPE ABOVE CEILING
- 6 (E) 3/4" HW DOWN WALL AND CAPPED
- 6 (E) 3/4" CW DOWN WALL AND CAPPED
- 6 (E) 1/2" HW DOWN WALL AND CAPPED
- 6 (E) 1/2" CW DOWN WALL AND CAPPED

FIRST FLOOR EXISTING
PLUMBING FLOOR PLAN

M1.1H