


QC	
INI	%

U2442

- SHEET NOTES:
- ① PLUMBING FIXTURES NOT SHOWN TO HAVE RUNS TO IT.
 - ② PIPE SIZES NOT KNOWN.

- DEAD LEG LOCATIONS:
- ⑧ (E) 3/4" CW COPPER CAPPED ABOVE CEILING
 - ⑨ (E) 3/4" CW COPPER VALVED OFF ABOVE CEILING
 - ⑩ (E) 1/2" CW COPPER CAPPED ABOVE CEILING
 - ⑪ (E) 1/2" HW COPPER CAPPED ABOVE CEILING
 - ⑫ (E) 1" CW COPPER CAPPED IN WALL BEHIND TOILET
 - ⑬ (E) 3/4" HW COPPER VALVED AND CAPPED ABOVE CEILING
 - ⑭ (E) 3/4" CW COPPER CAPPED ABOVE CEILING
 - ⑮ (E) 1 1/2" HW COPPER VALVED AND CAPPED ABOVE CEILING
 - ⑯ (E) 3/4" HW COPPER VALVED AND CAPPED ABOVE CEILING

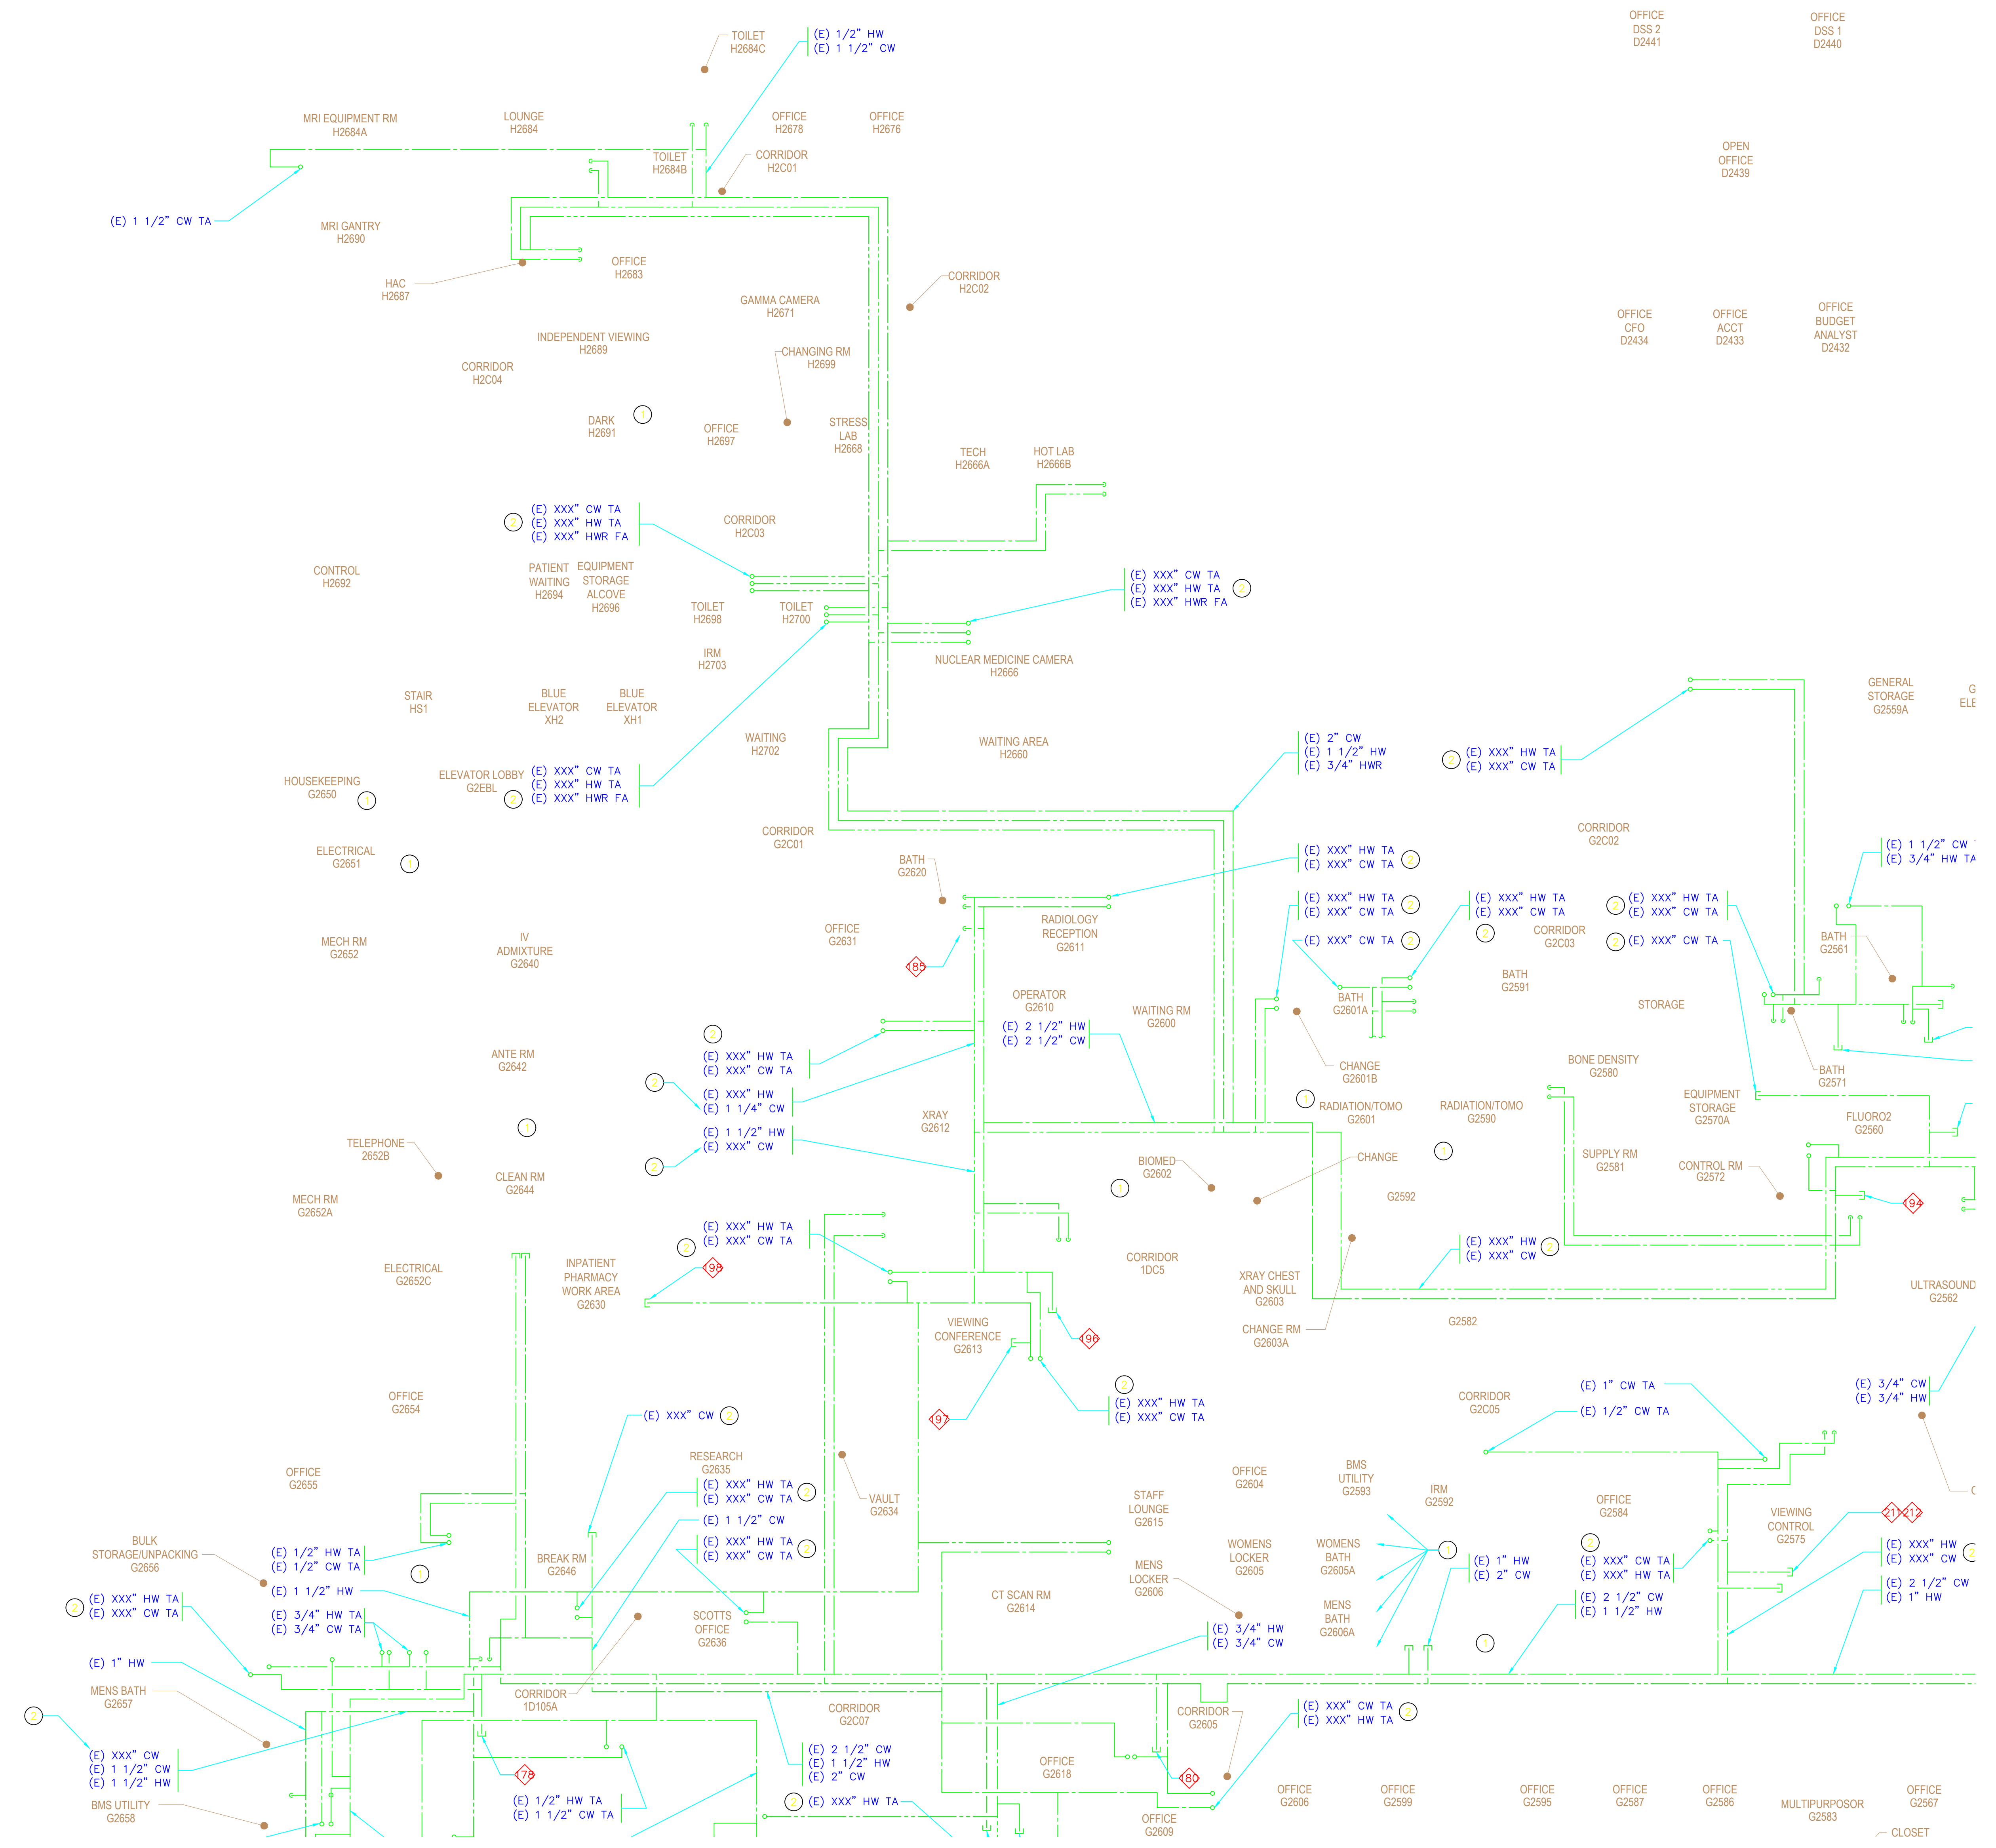

SECOND FLOOR EXISTING
PLUMBING FLOOR PLANS